




FILE NAME: U:\1762\CADD\KSTW\STP_2506\p05b048_Conv.ecst_Plan.dgn
 DATE/TIME: 12/20/2012
 USER: 4866

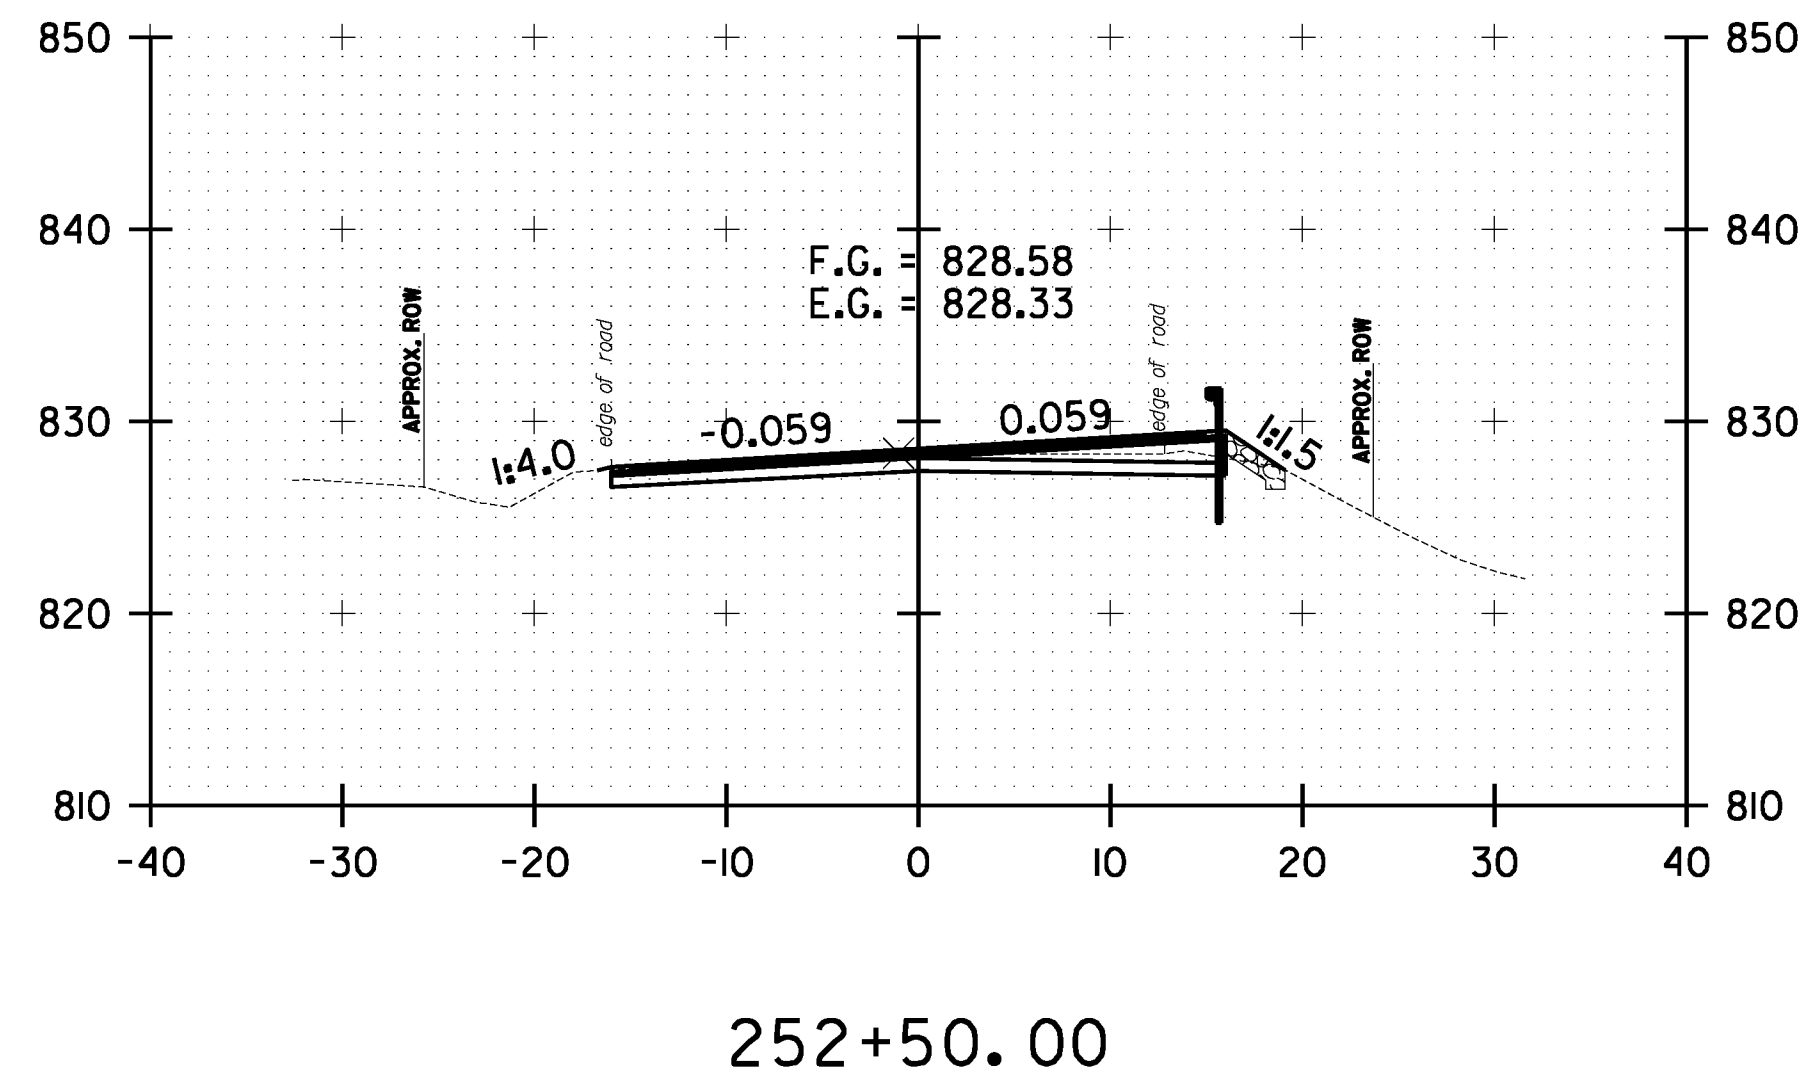


252+50.00

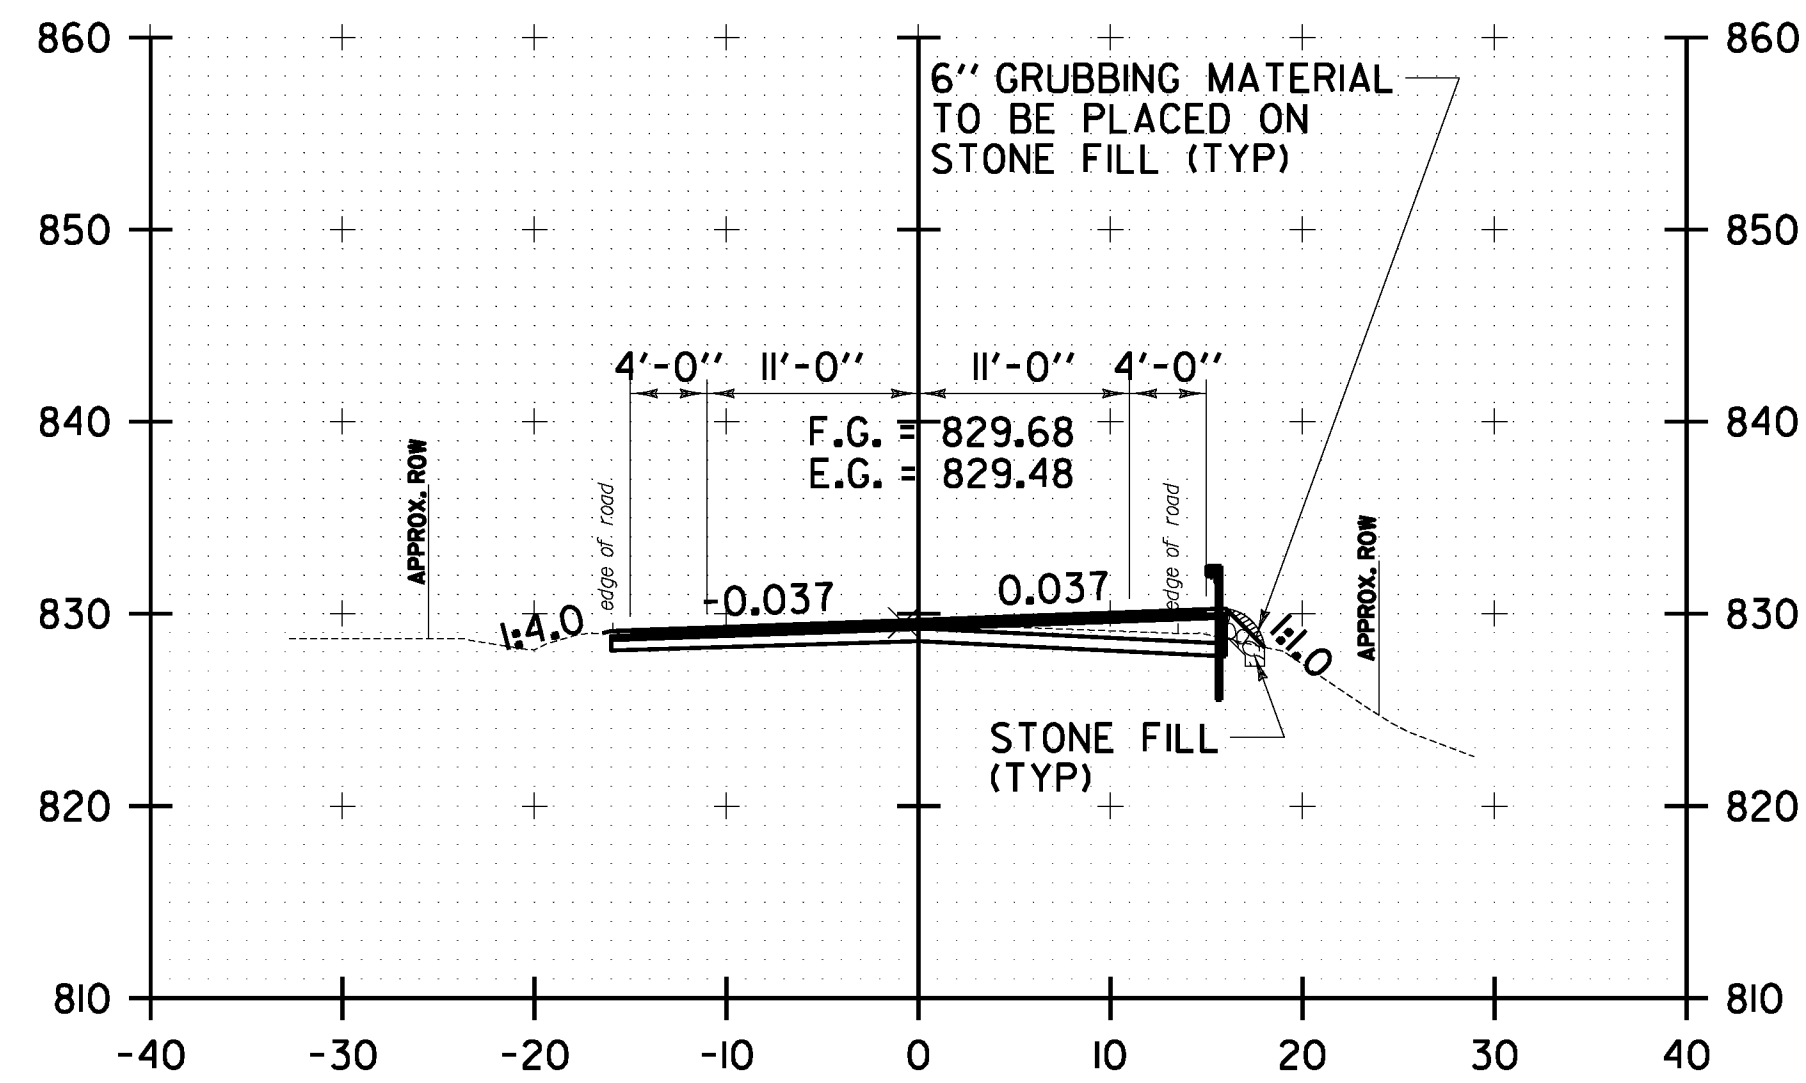


252+00.00

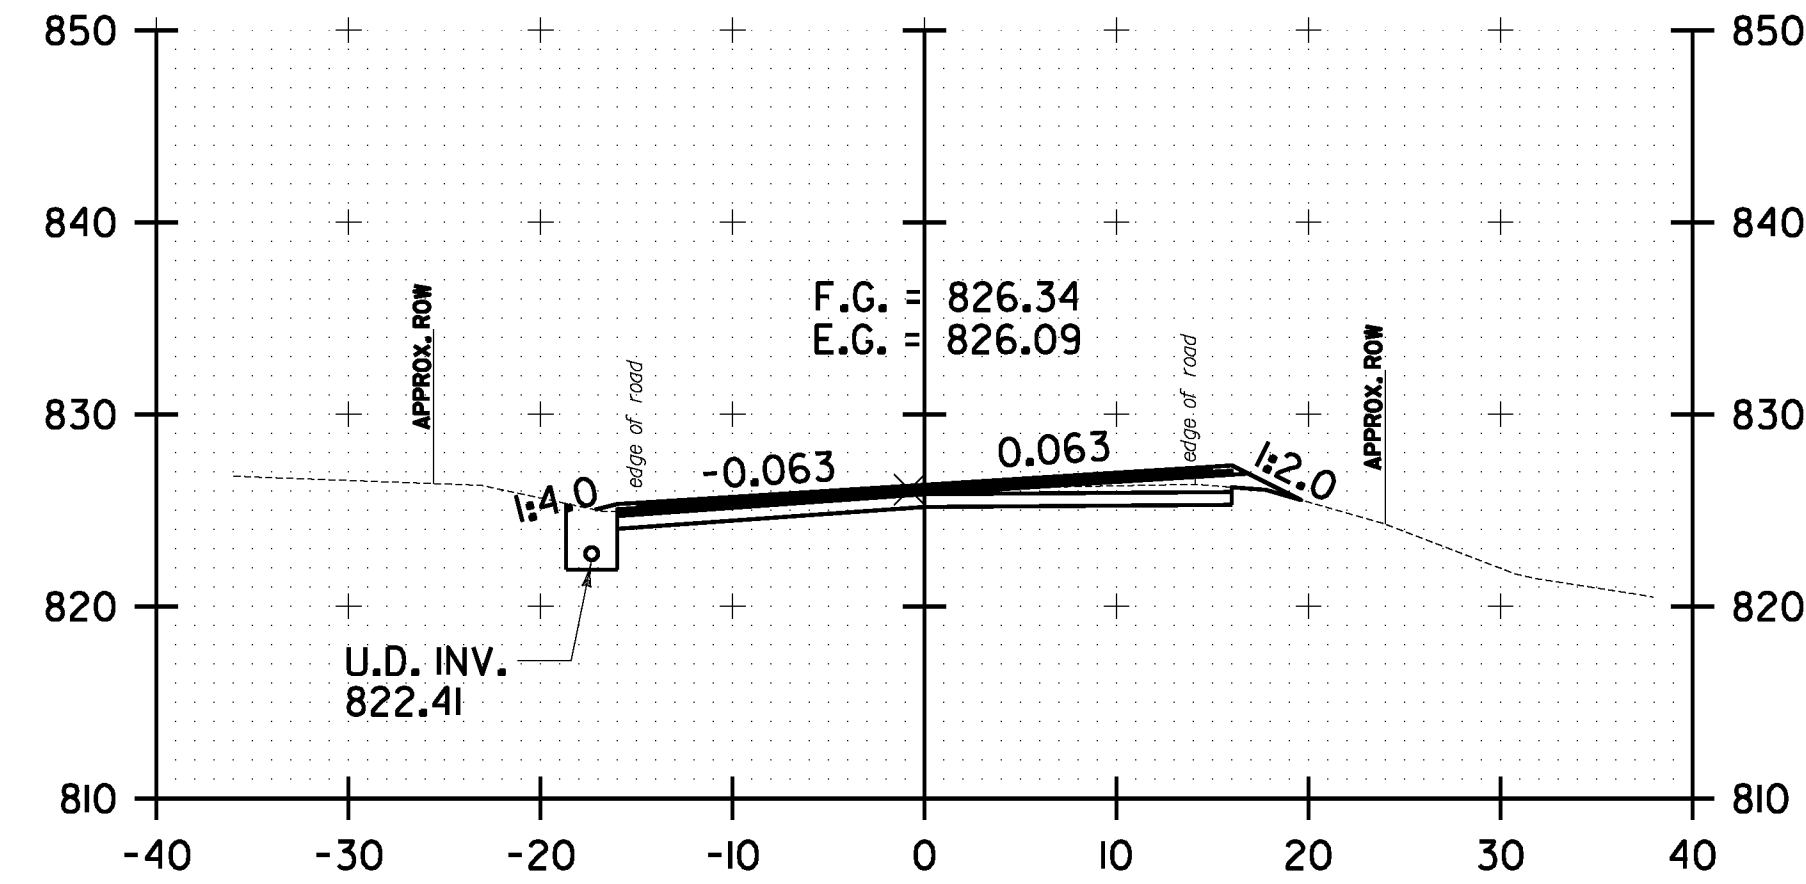


254+00.00

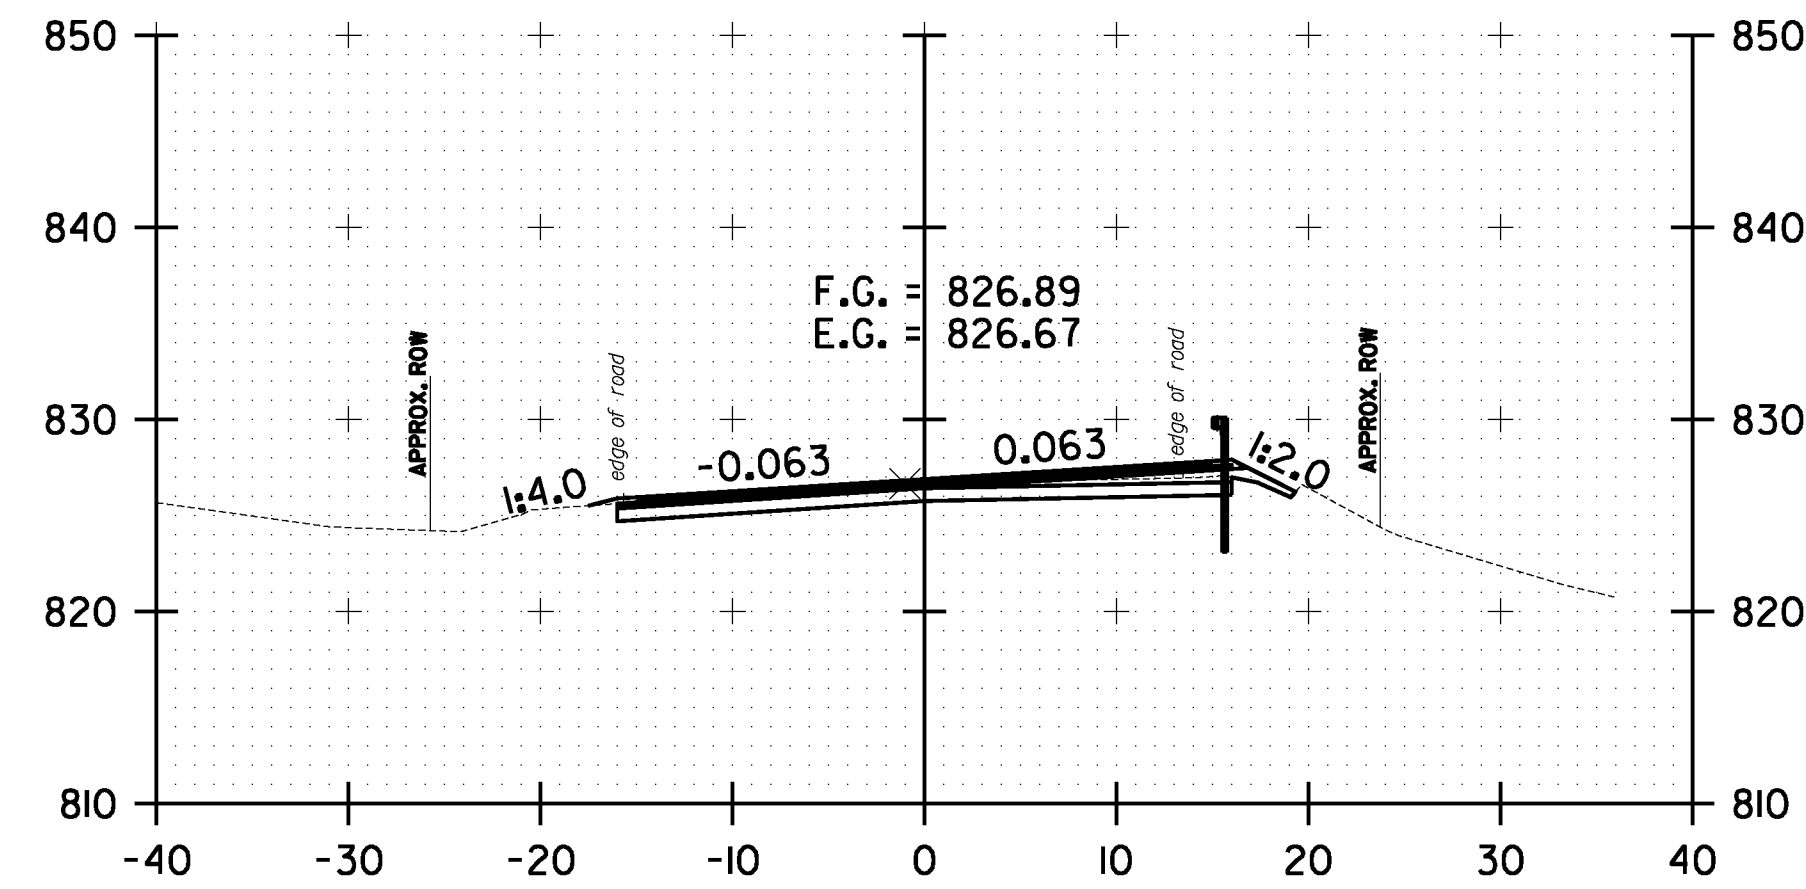


253+50.00

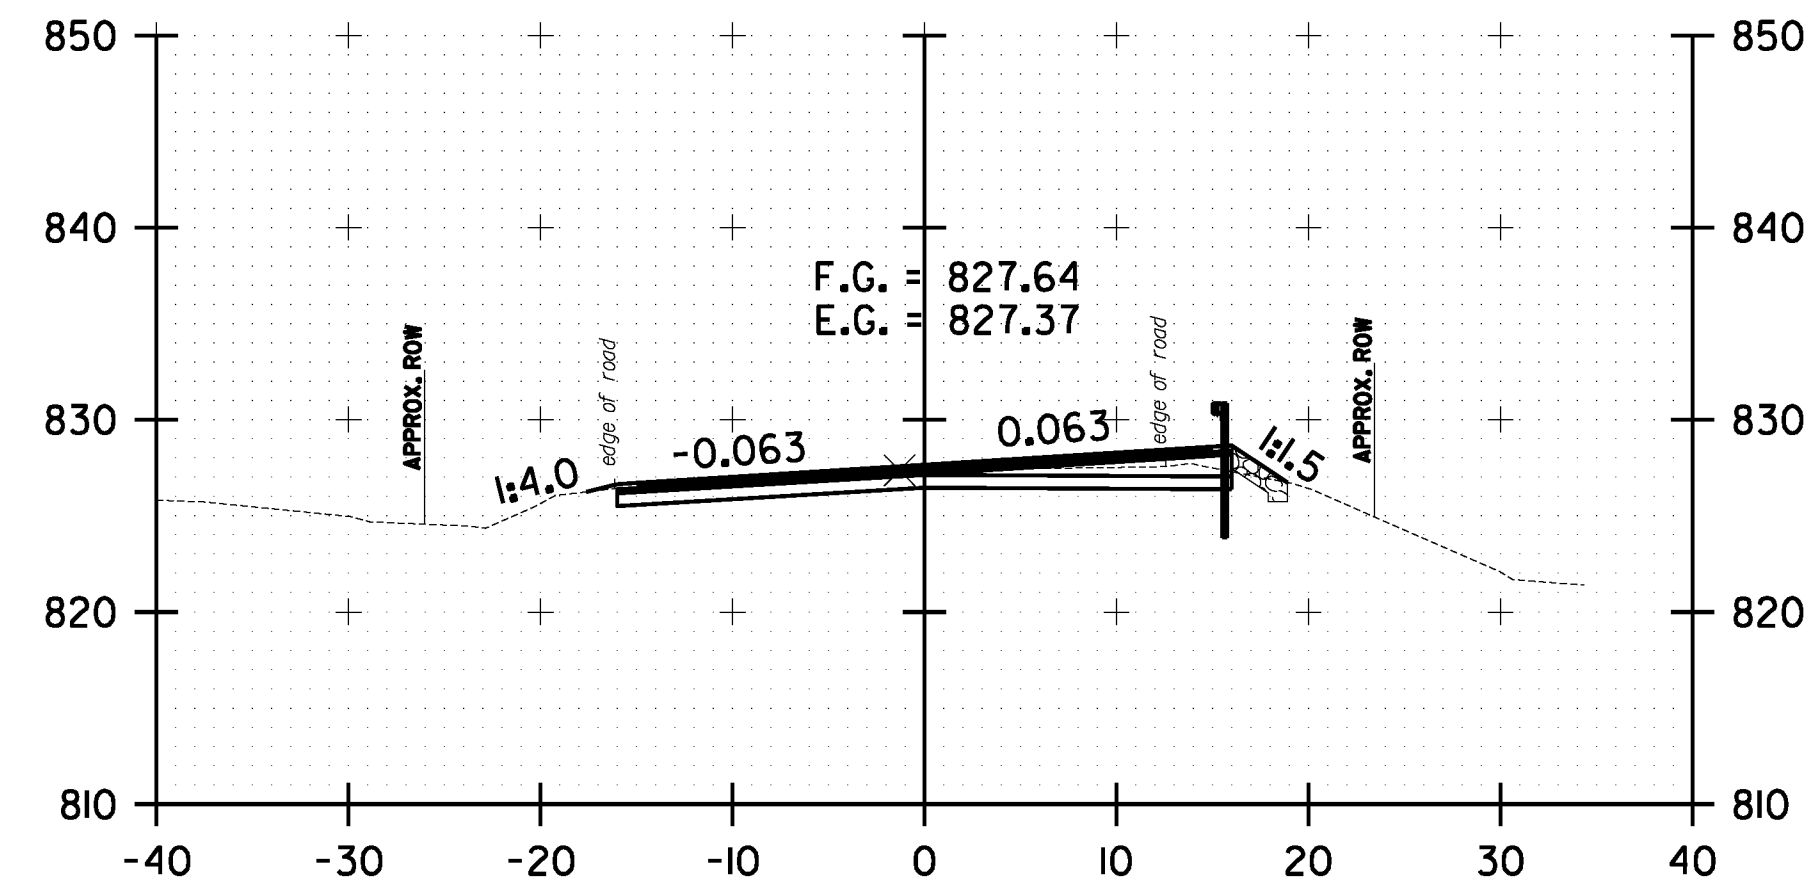


253+00.00

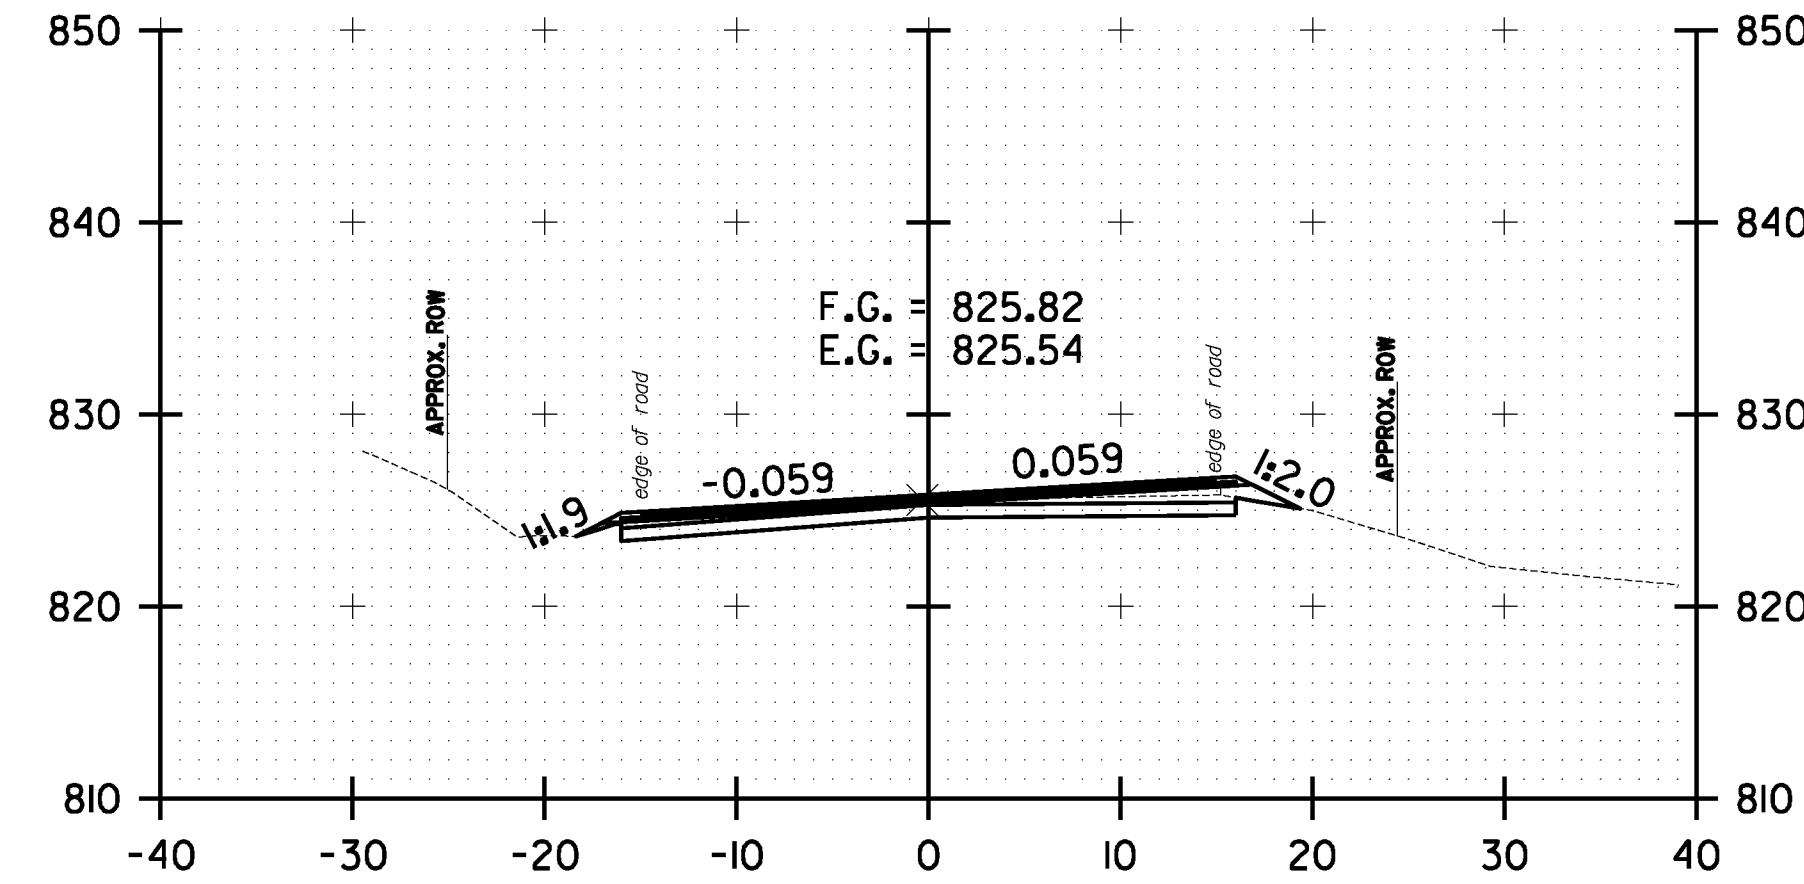


255+50.00

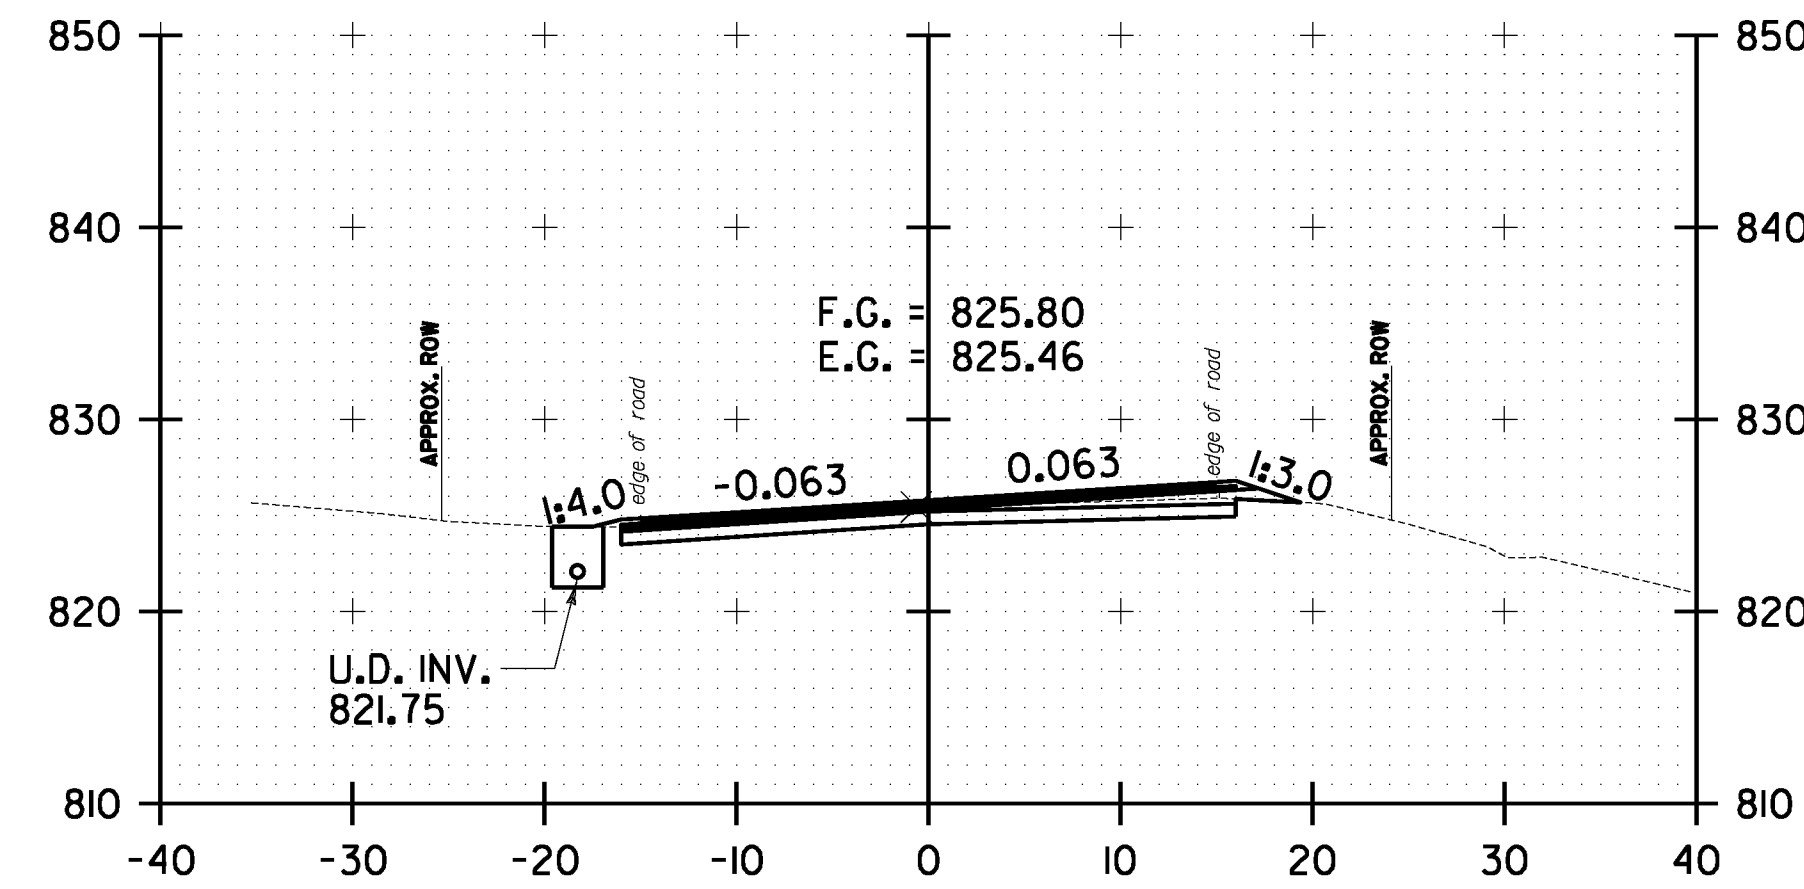

255+00.00

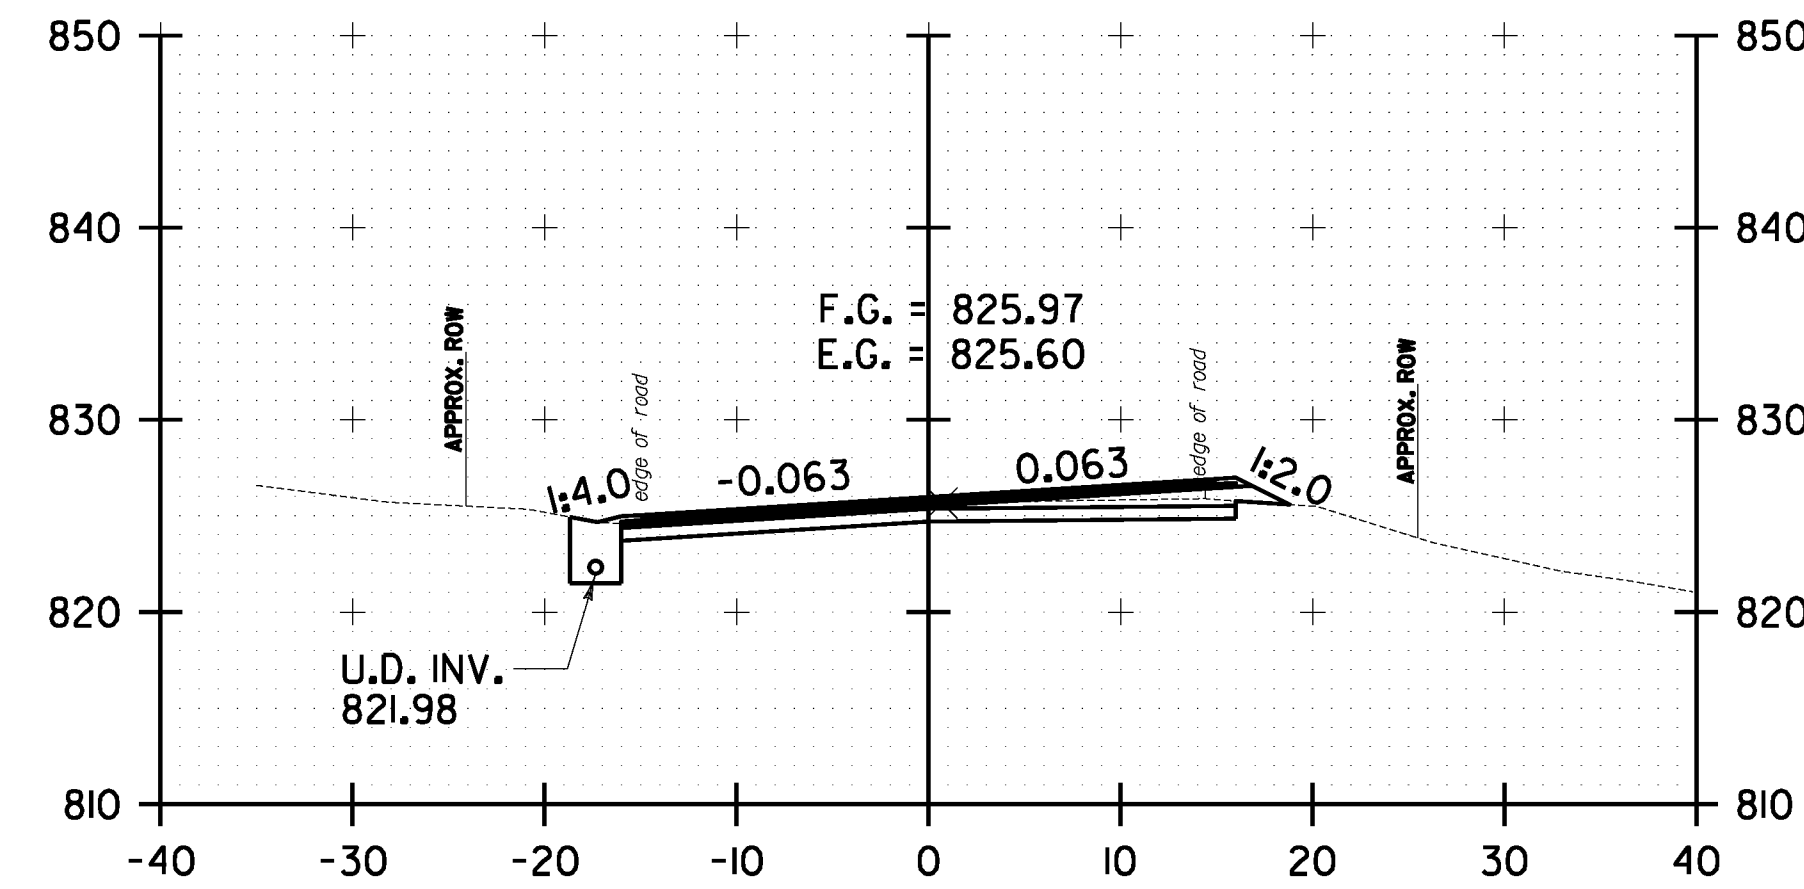

254+50.00

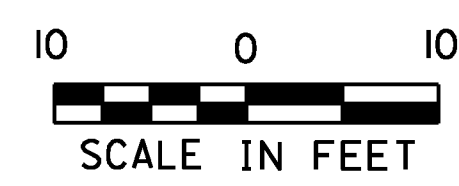

**WARREN
 CROSS SECTION
 SHEET #68**

PROJECT NAME: WARREN-WAITSFIELD

PROJECT NUMBER: STP 2506(1)

FILE NAME: p05b048.dgn

PROJECT LEADER: D.E.G.

DESIGNED BY: M.J.M.

IPARM FILE: p05b048xs68.I

PLOT DATE: 12/20/2012

DRAWN BY: W.G.P.

CHECKED BY: D.E.G.

SHEET 231 OF 310