




FILE NAME: U:\1762\CADD\KSTW\STP_2506\p05b048_Convrest_Plan.dgn
 DATE/TIME: 12/20/2012
 USER: 4866

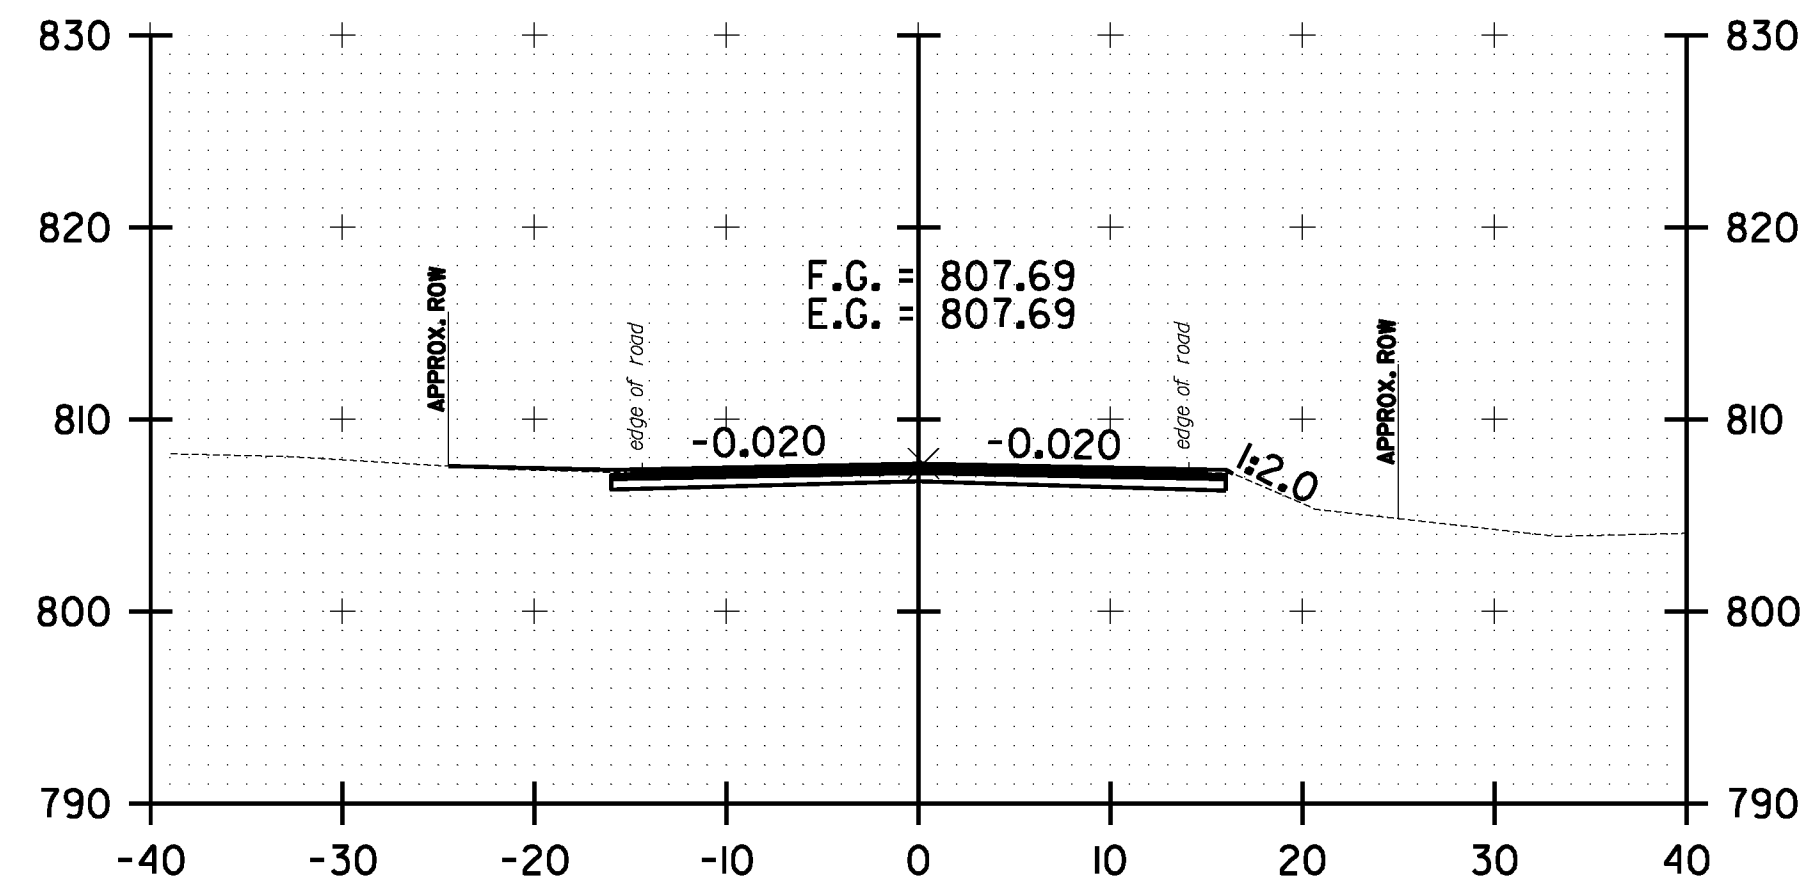


283+50.00

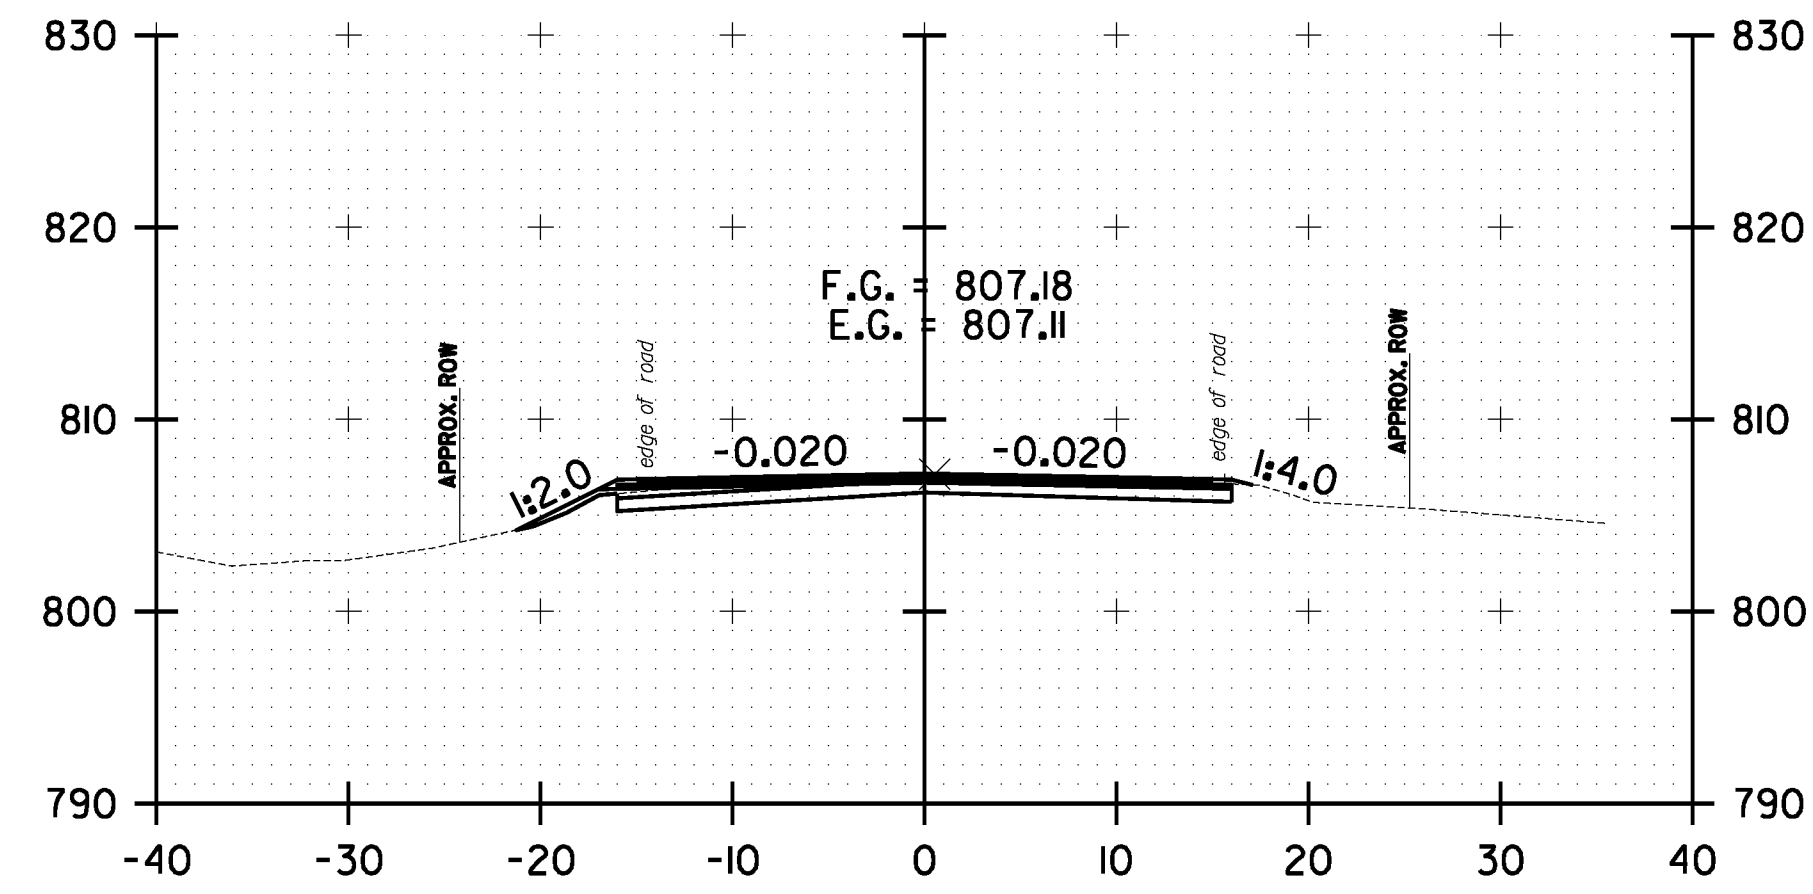


285+00.00

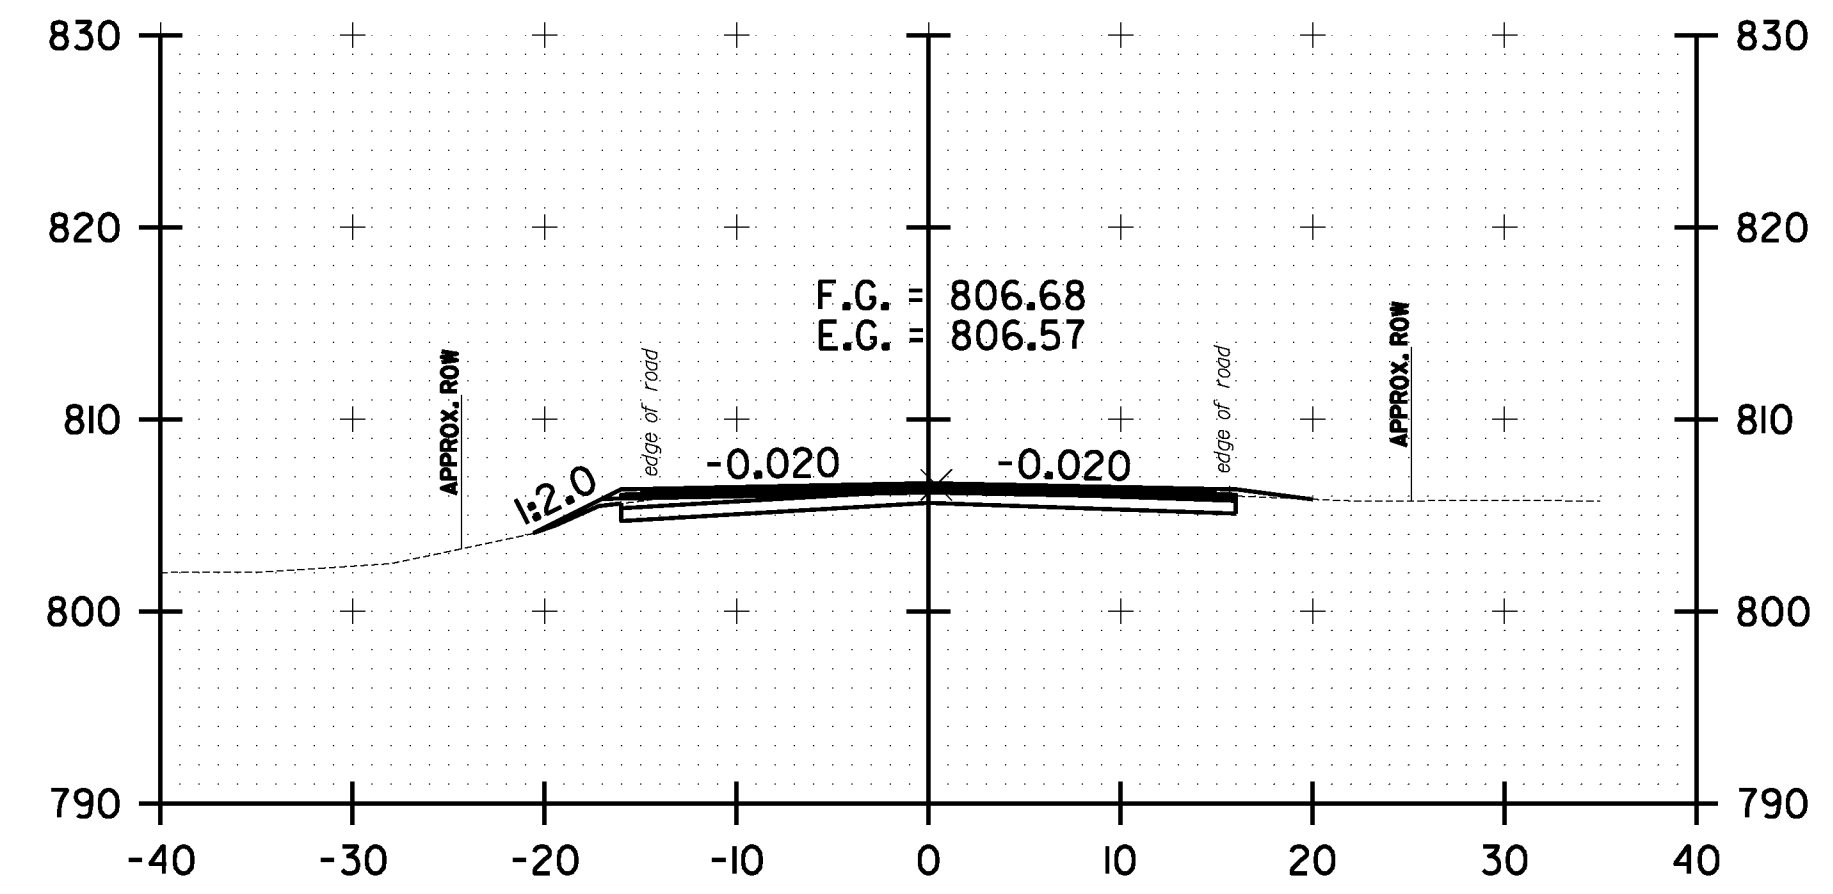


286+50.00

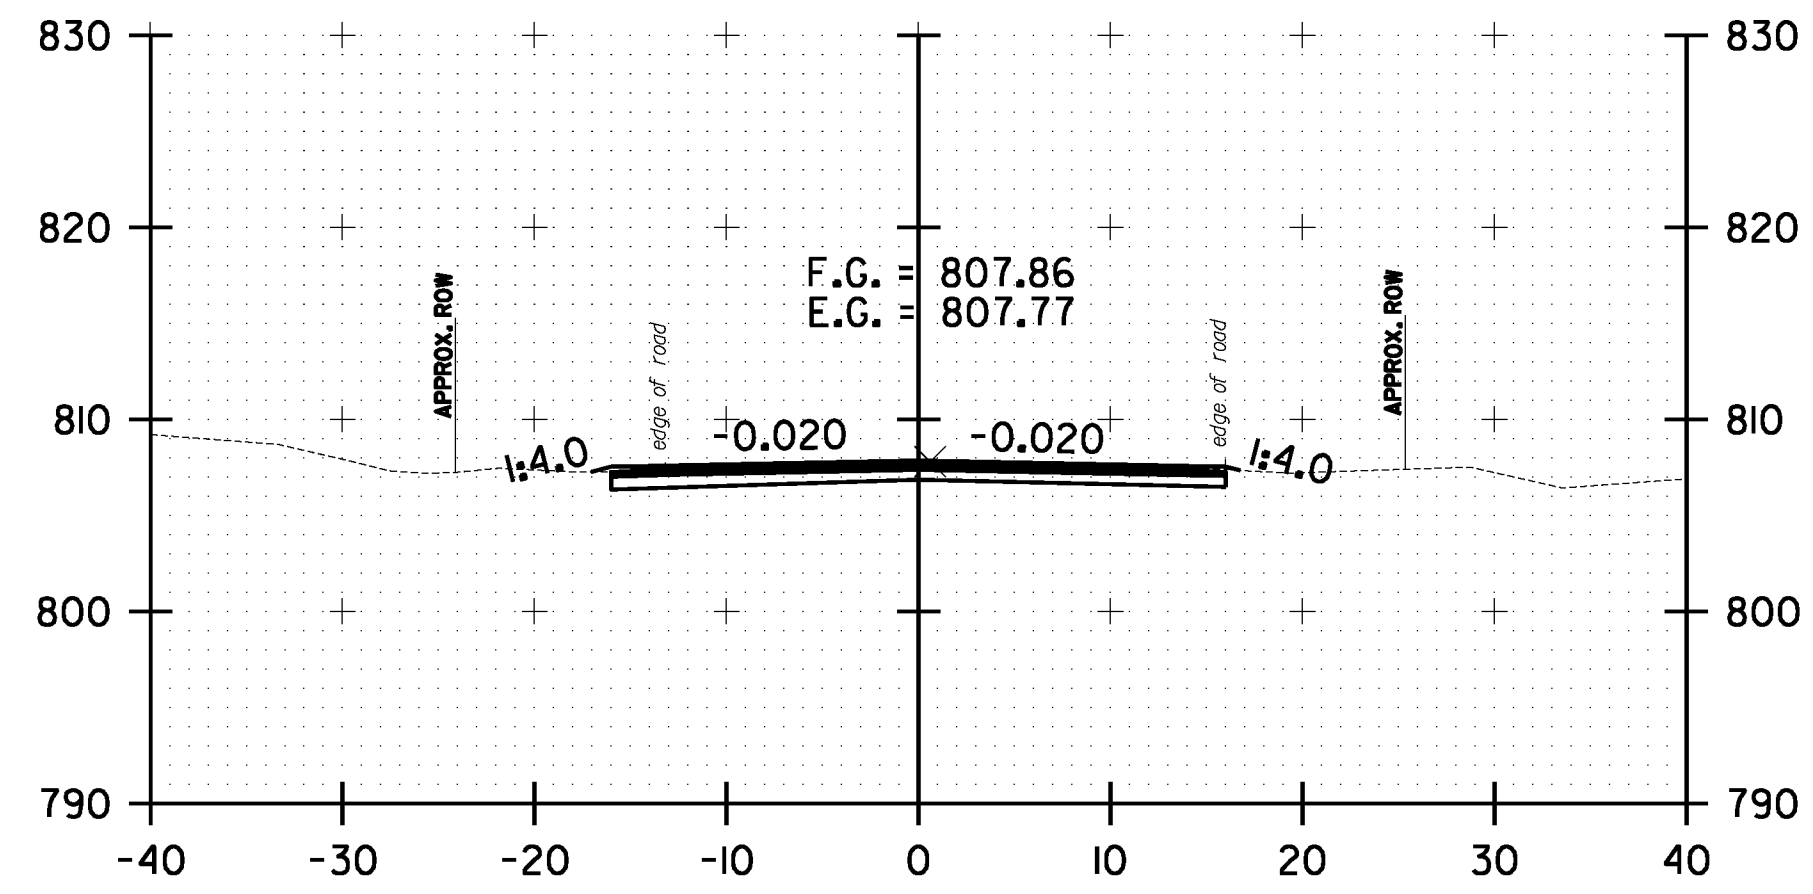


283+00.00

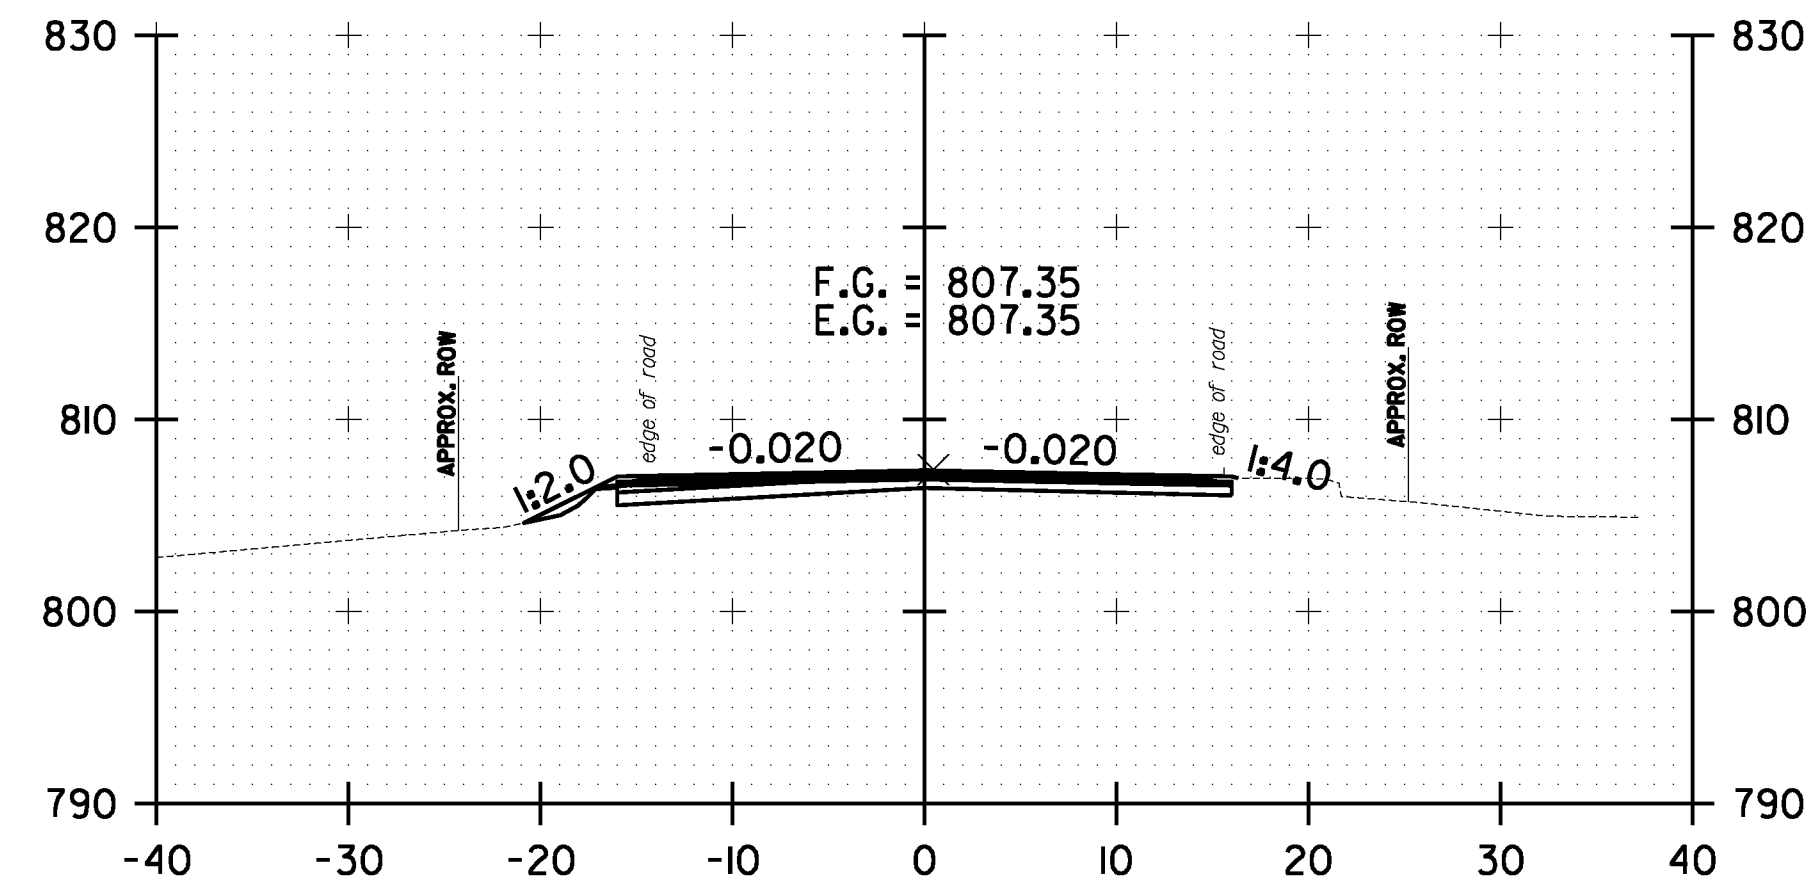


284+50.00

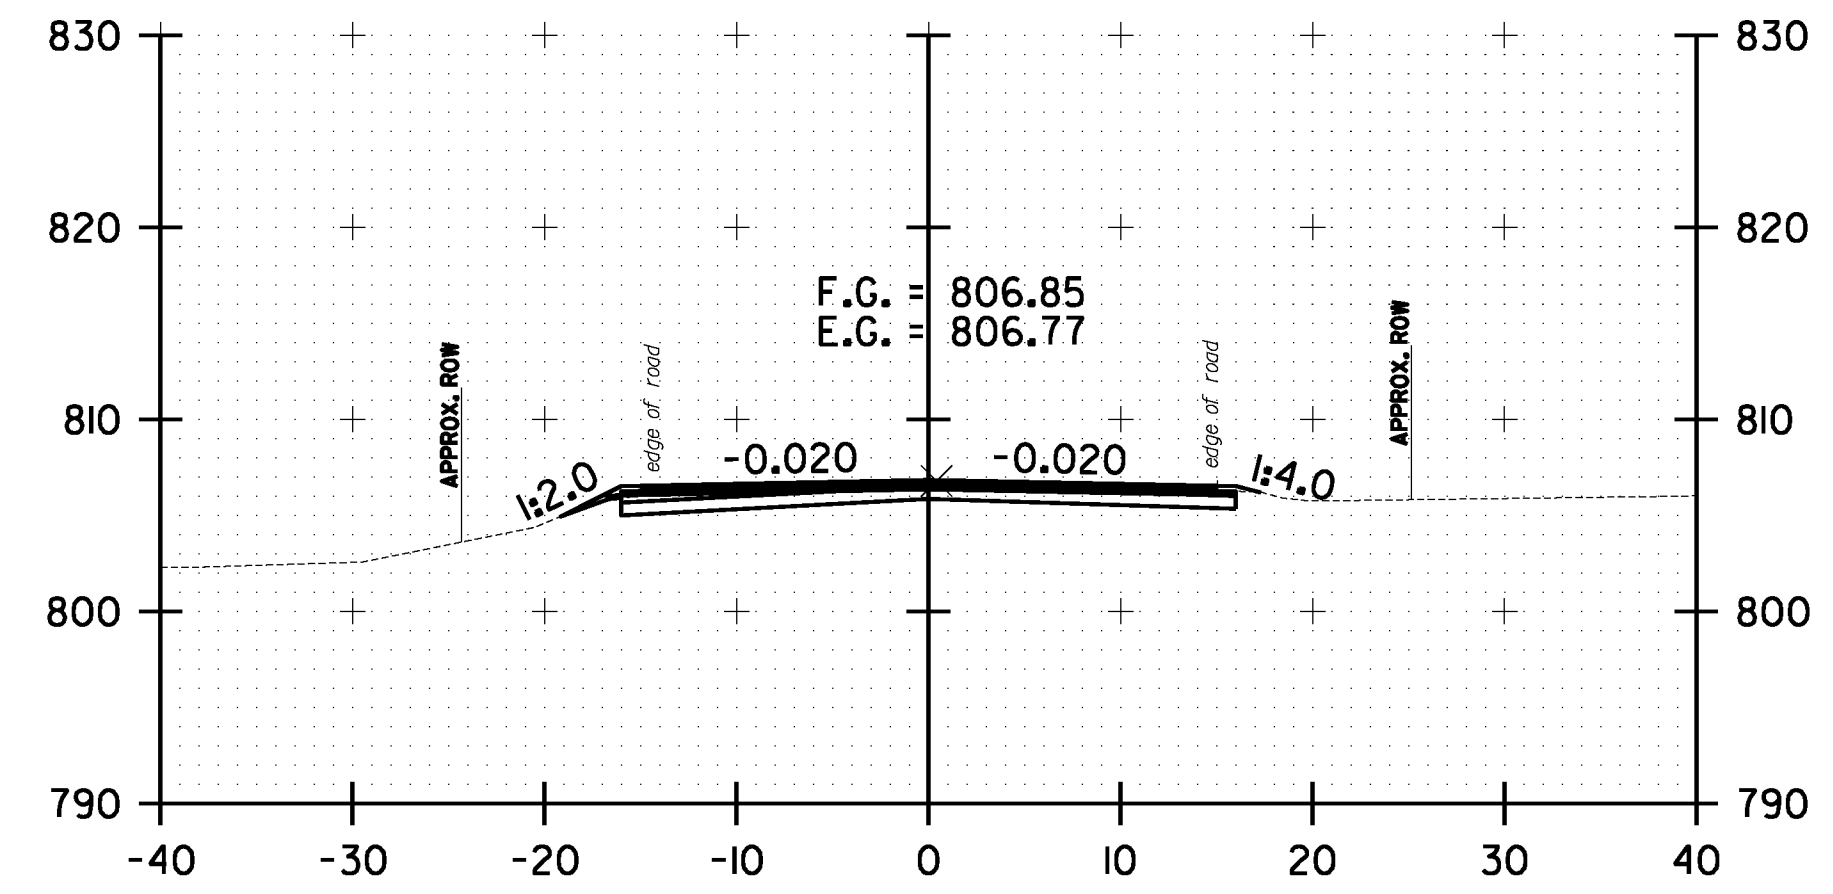


286+00.00

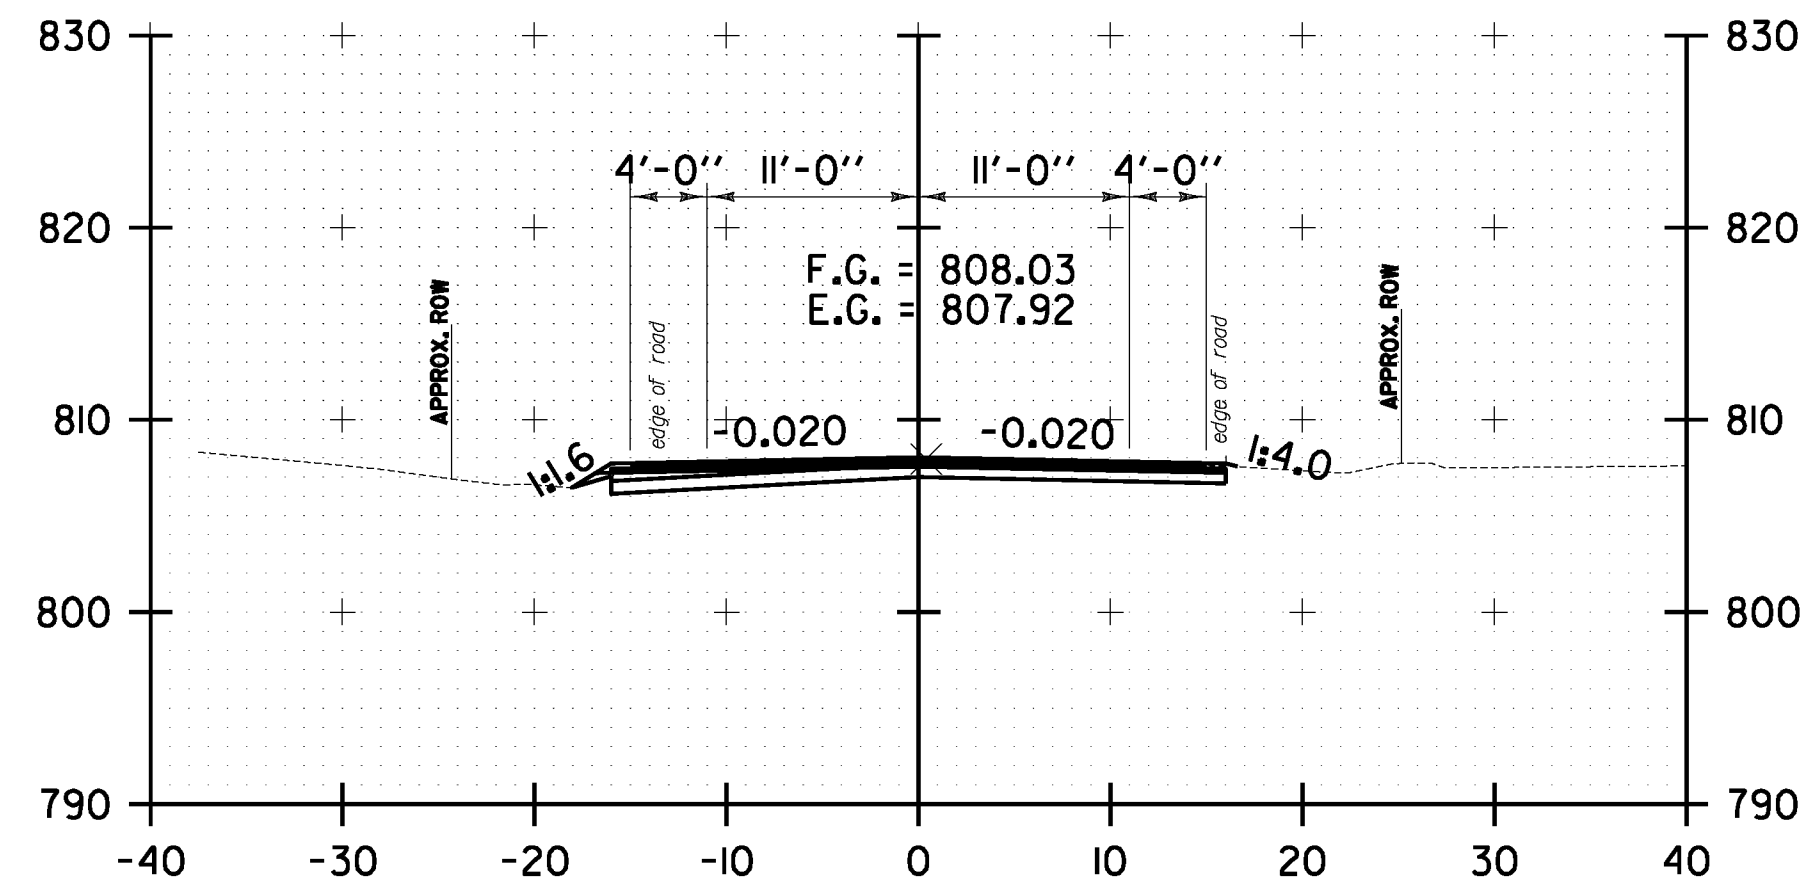


282+50.00

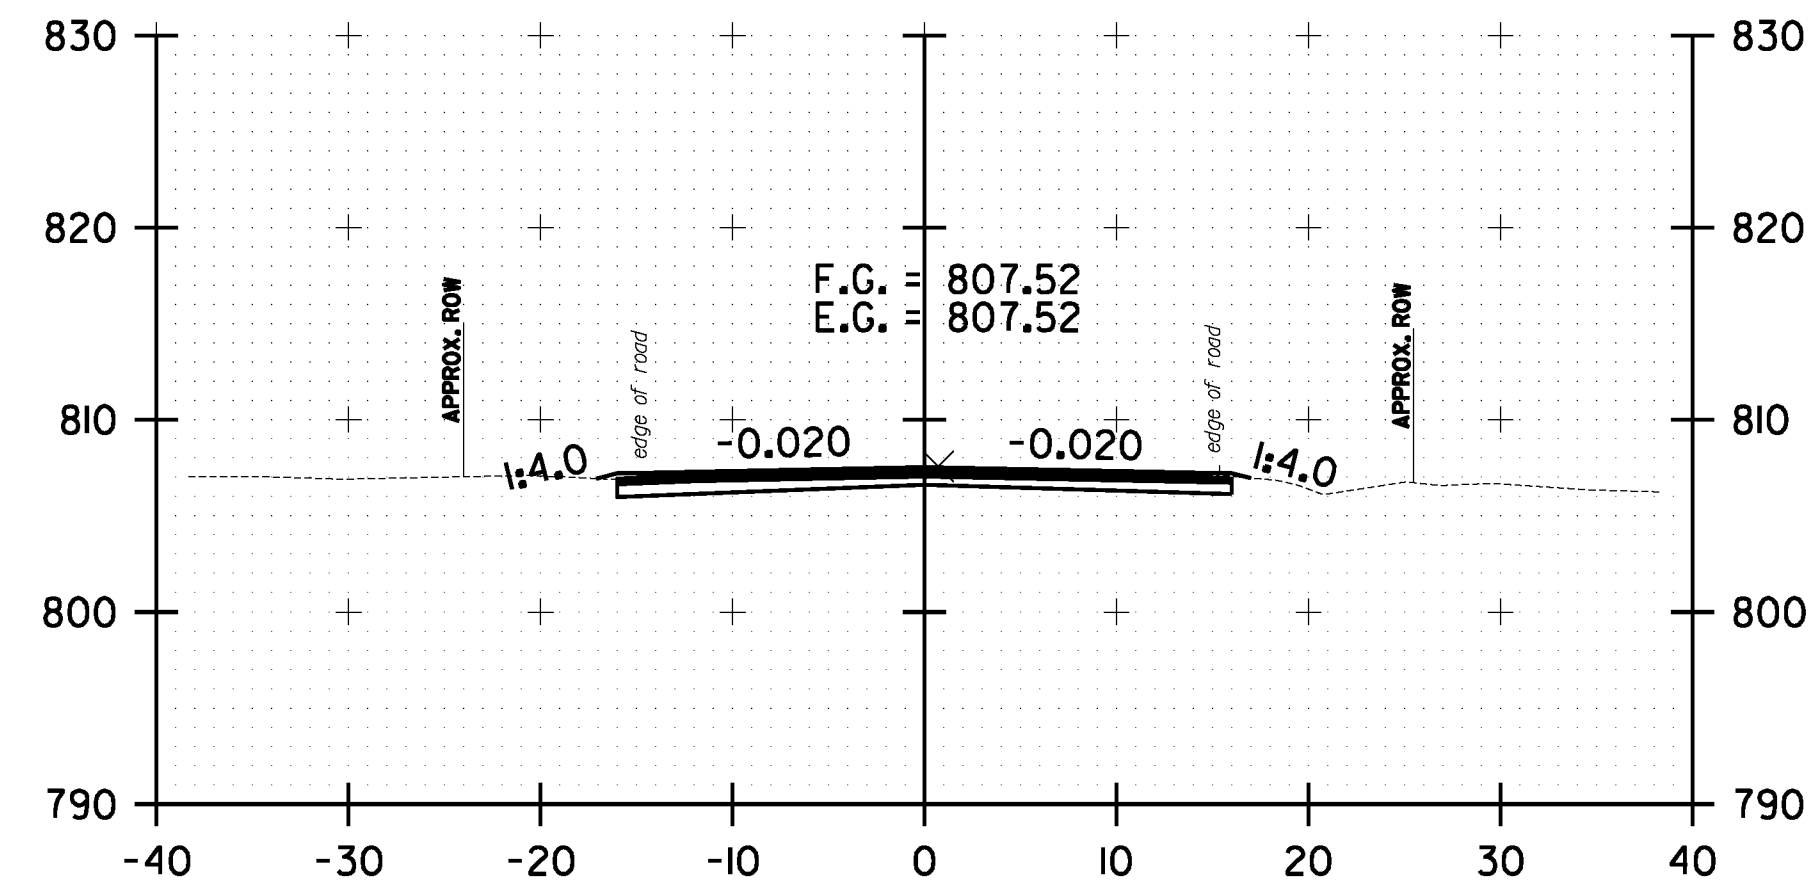

284+00.00

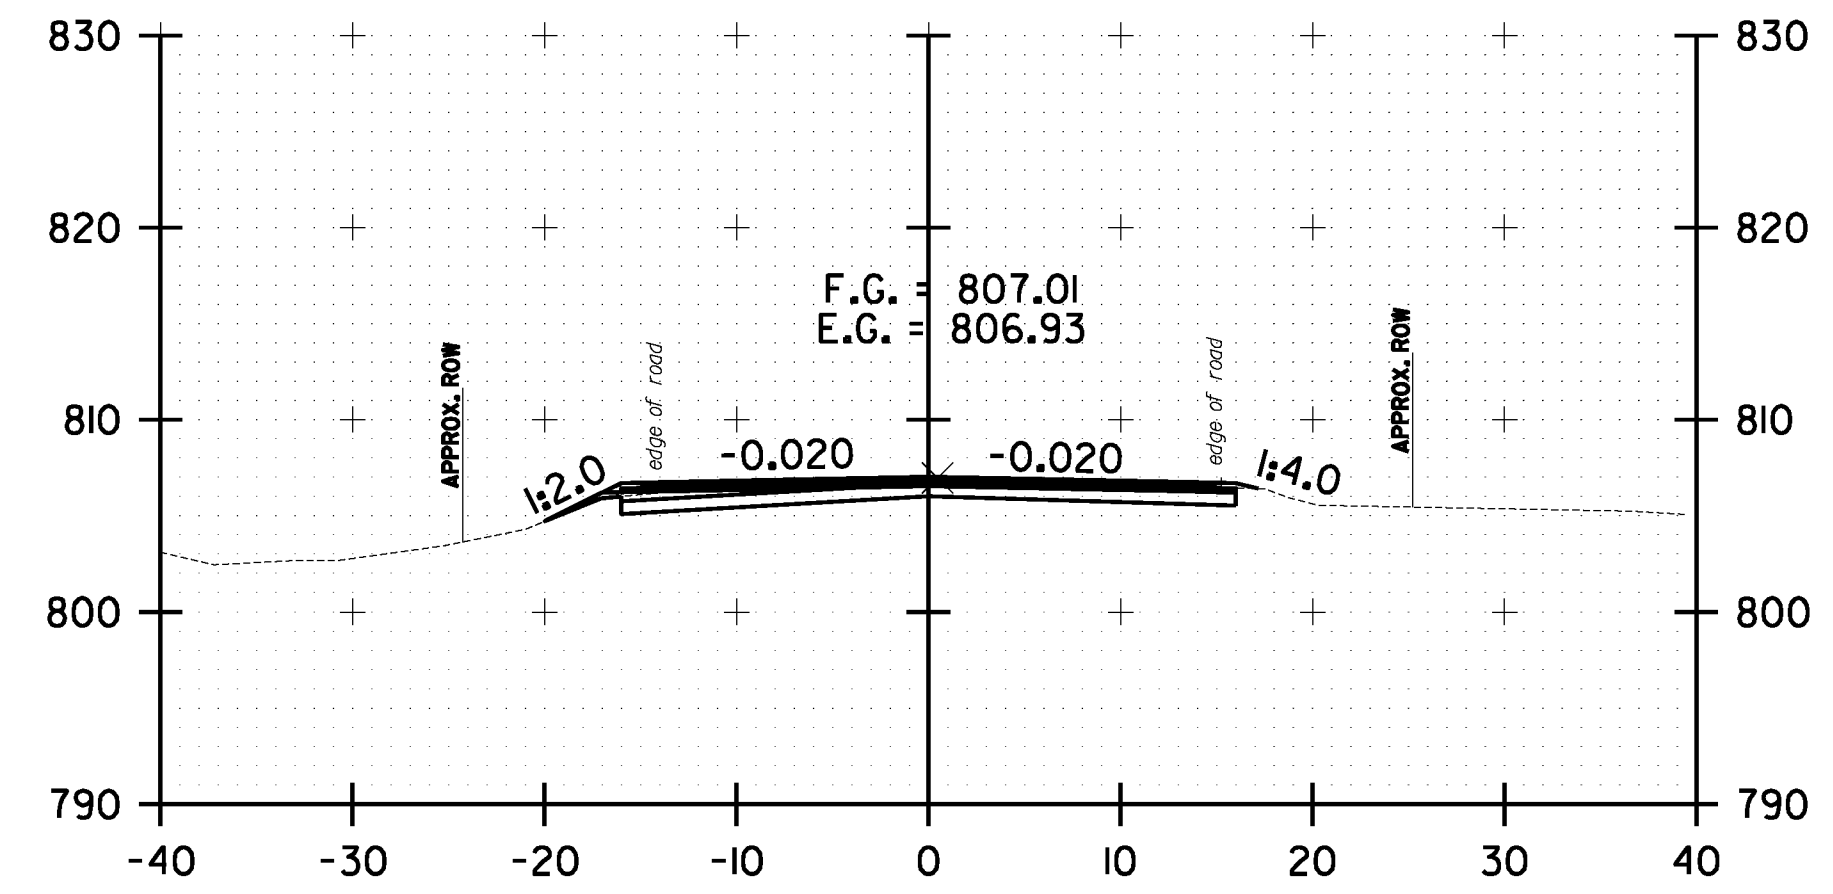

285+50.00

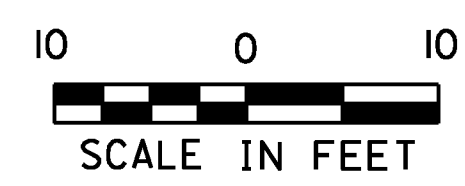

**WARREN
 CROSS SECTION
 SHEET #77**

PROJECT NAME: WARREN-WAITSFIELD	PLOT DATE: 12/20/2012
PROJECT NUMBER: STP 2506(1)	DRAWN BY: W.G.P.
FILE NAME: p05b048.dgn	CHECKED BY: D.E.G.
PROJECT LEADER: D.E.G.	SHEET 240 OF 310
DESIGNED BY: M.J.M.	
IPARM FILE: p05b048xs77.1	