




FILE NAME: U:\1762\CA00\MST\STP\_2506\p05b048\_Conv.eas\_Plan.dgn  
 DATE/TIME: 12/20/2012  
 USER: 4866

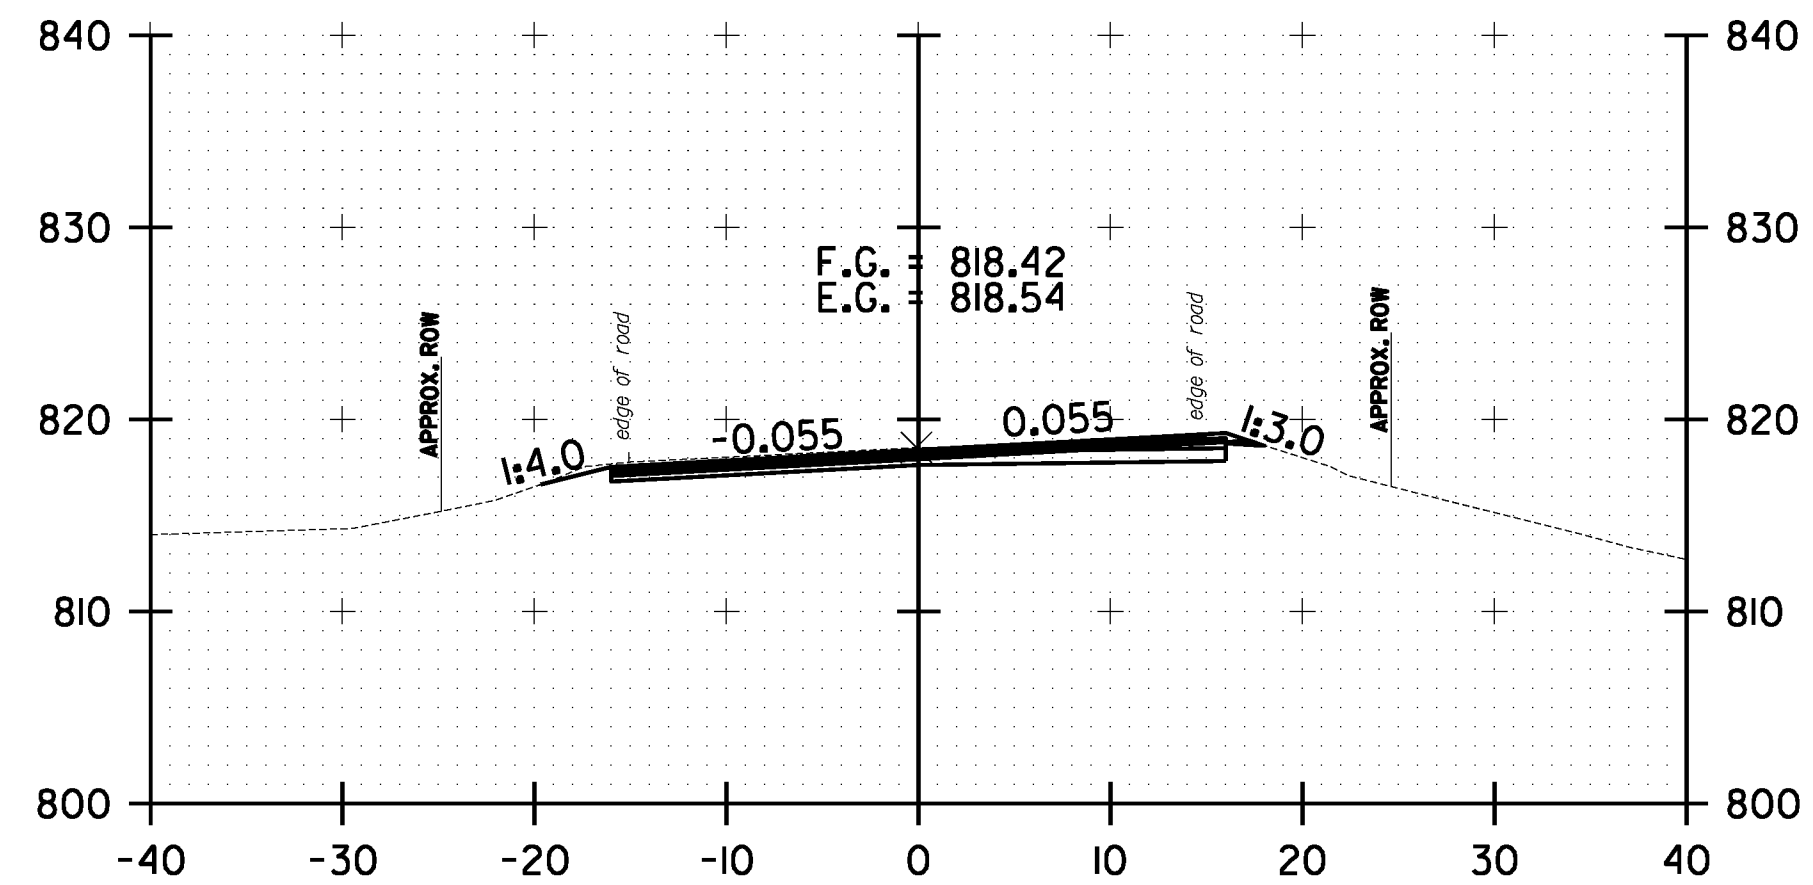


298+50.00

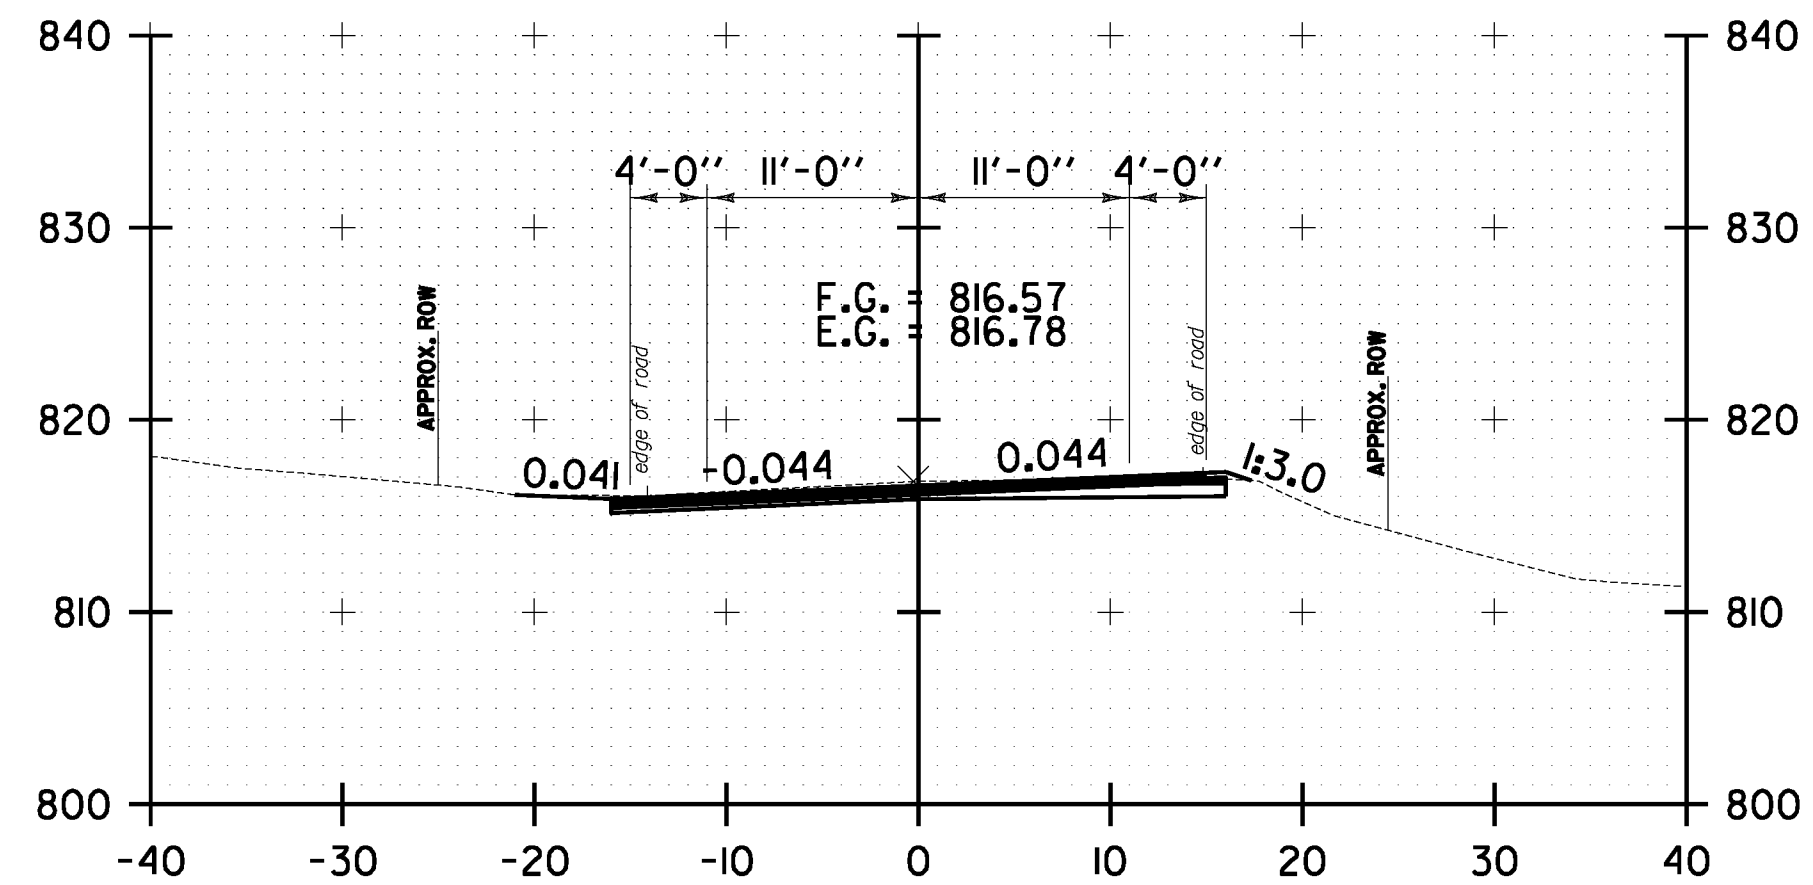


298+00.00

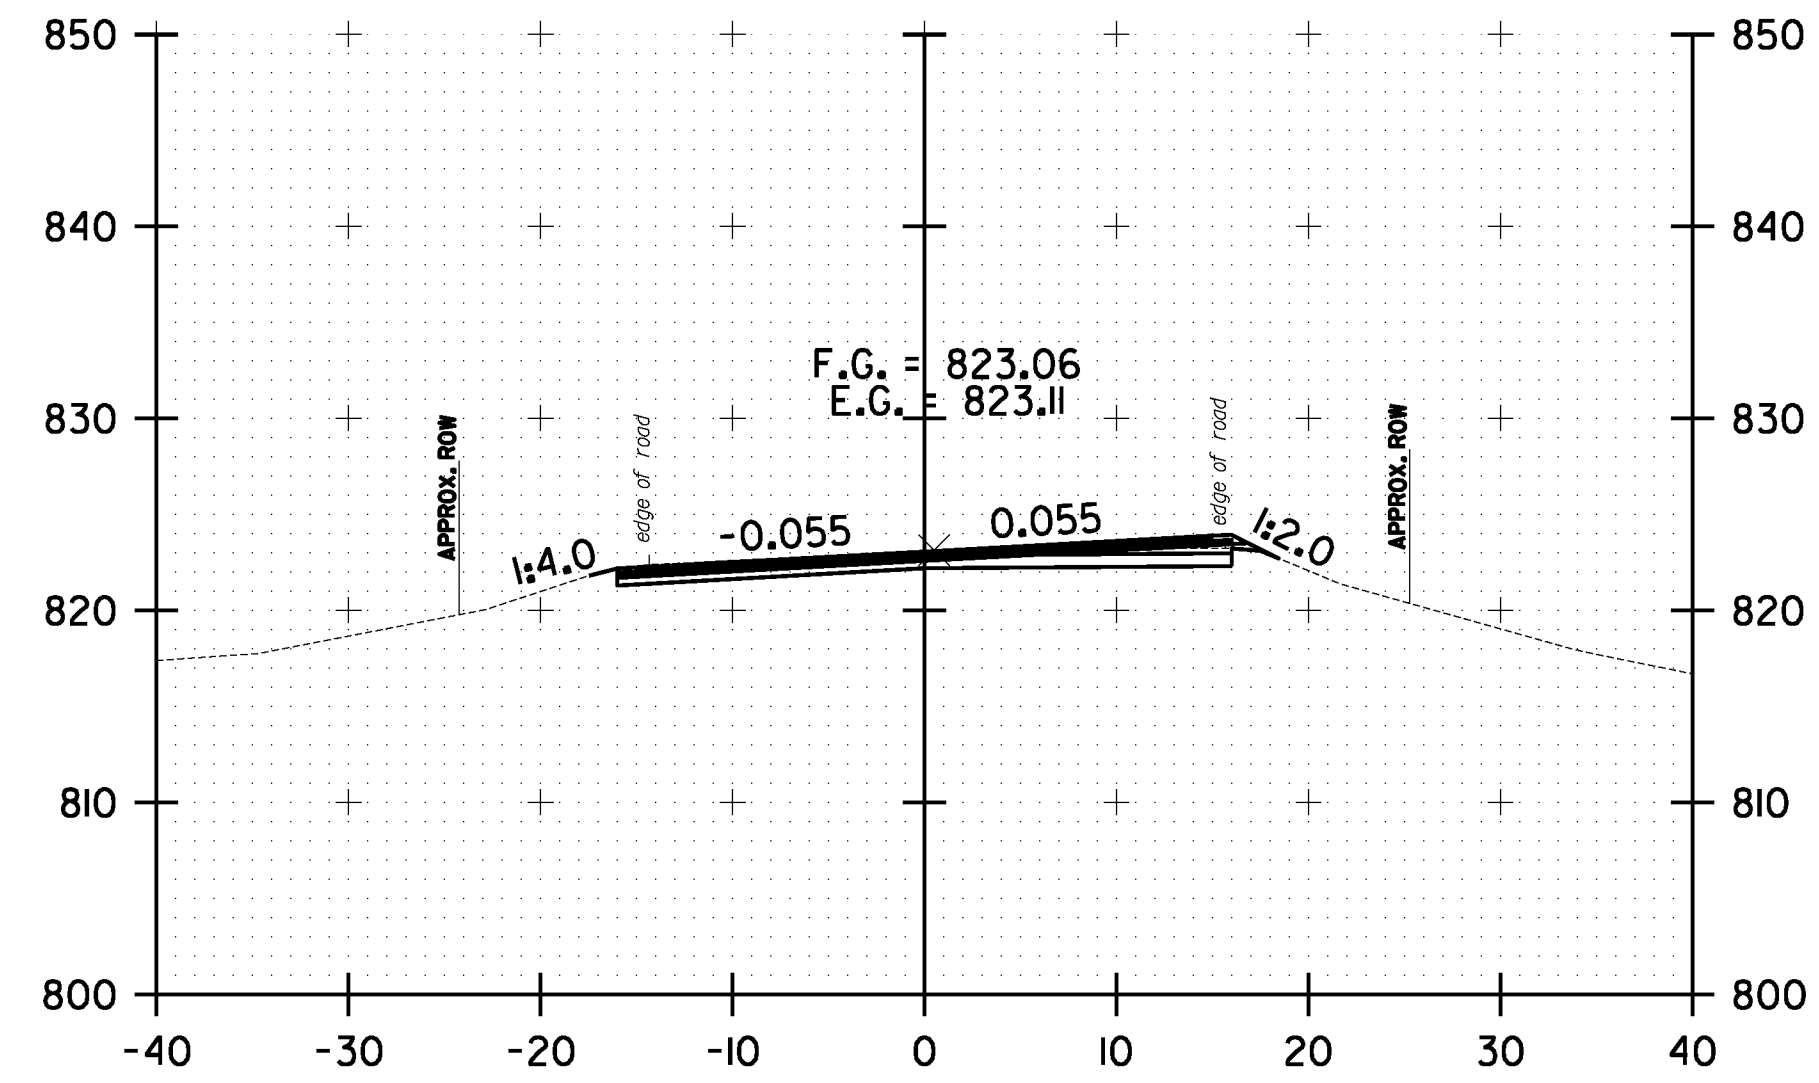


299+50.00

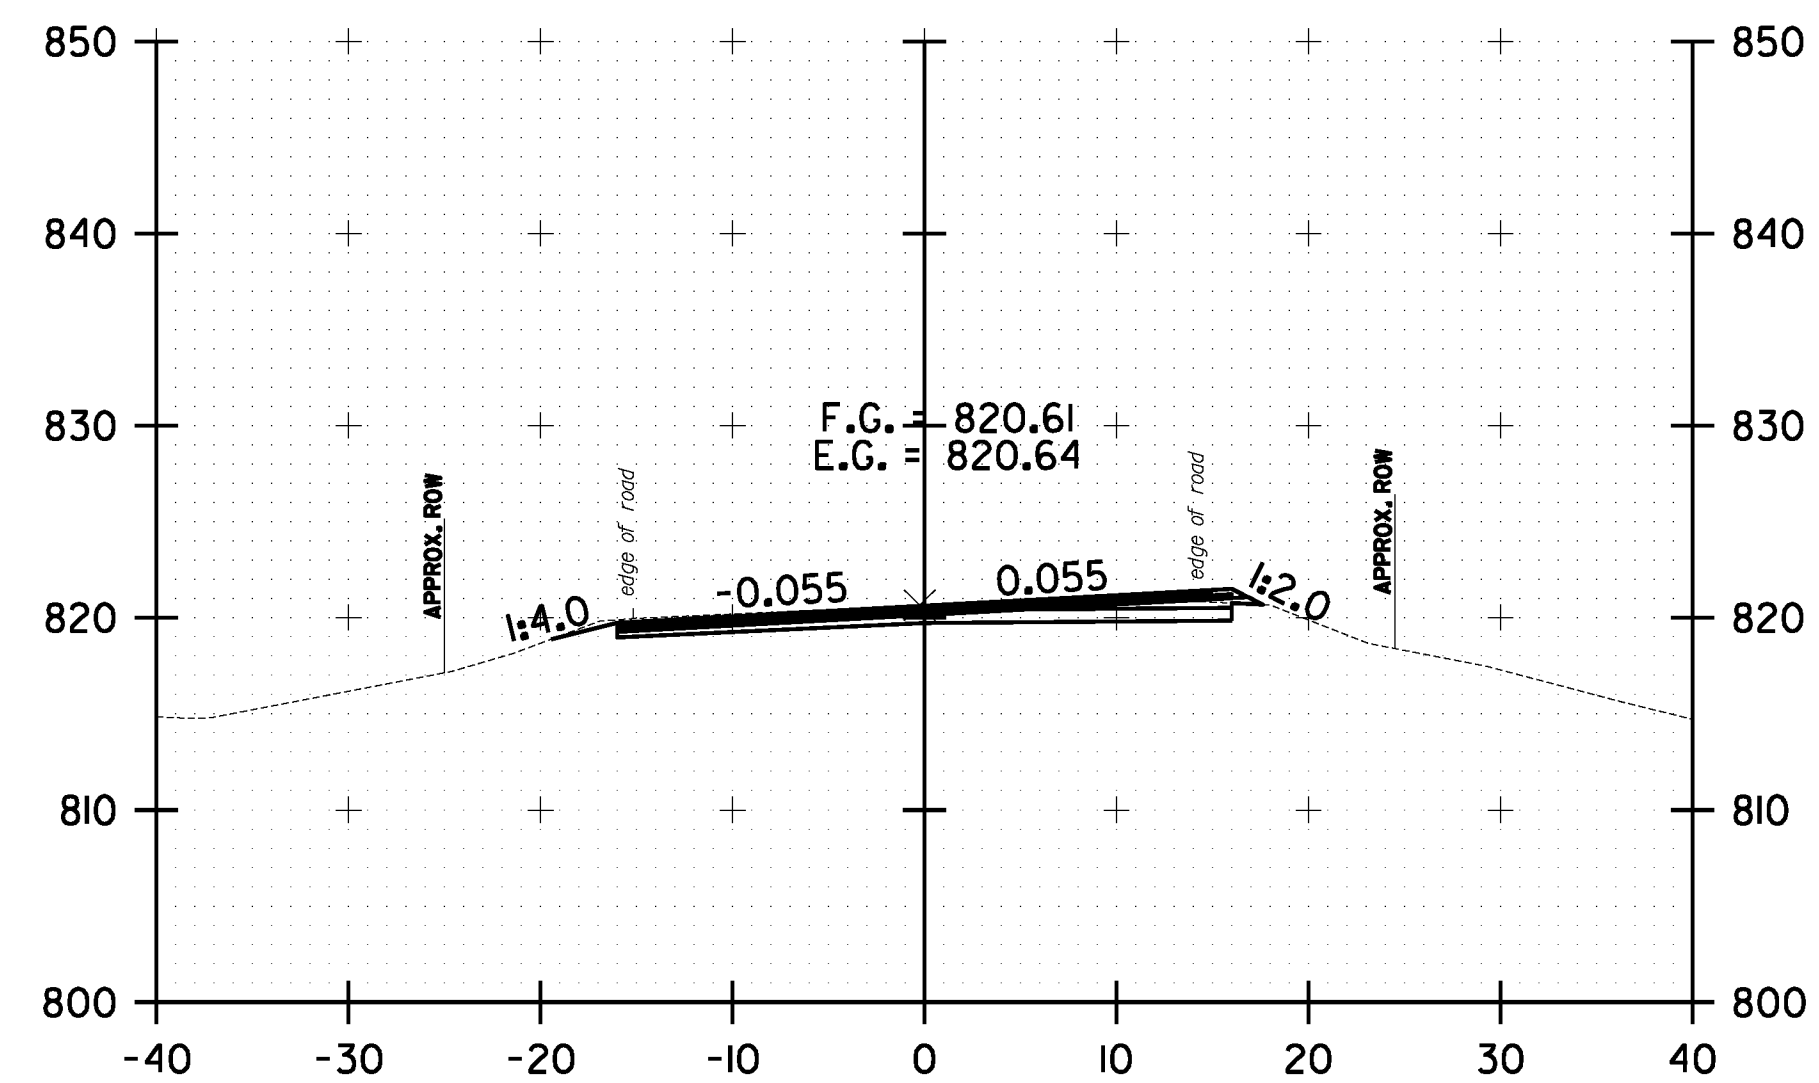


299+00.00

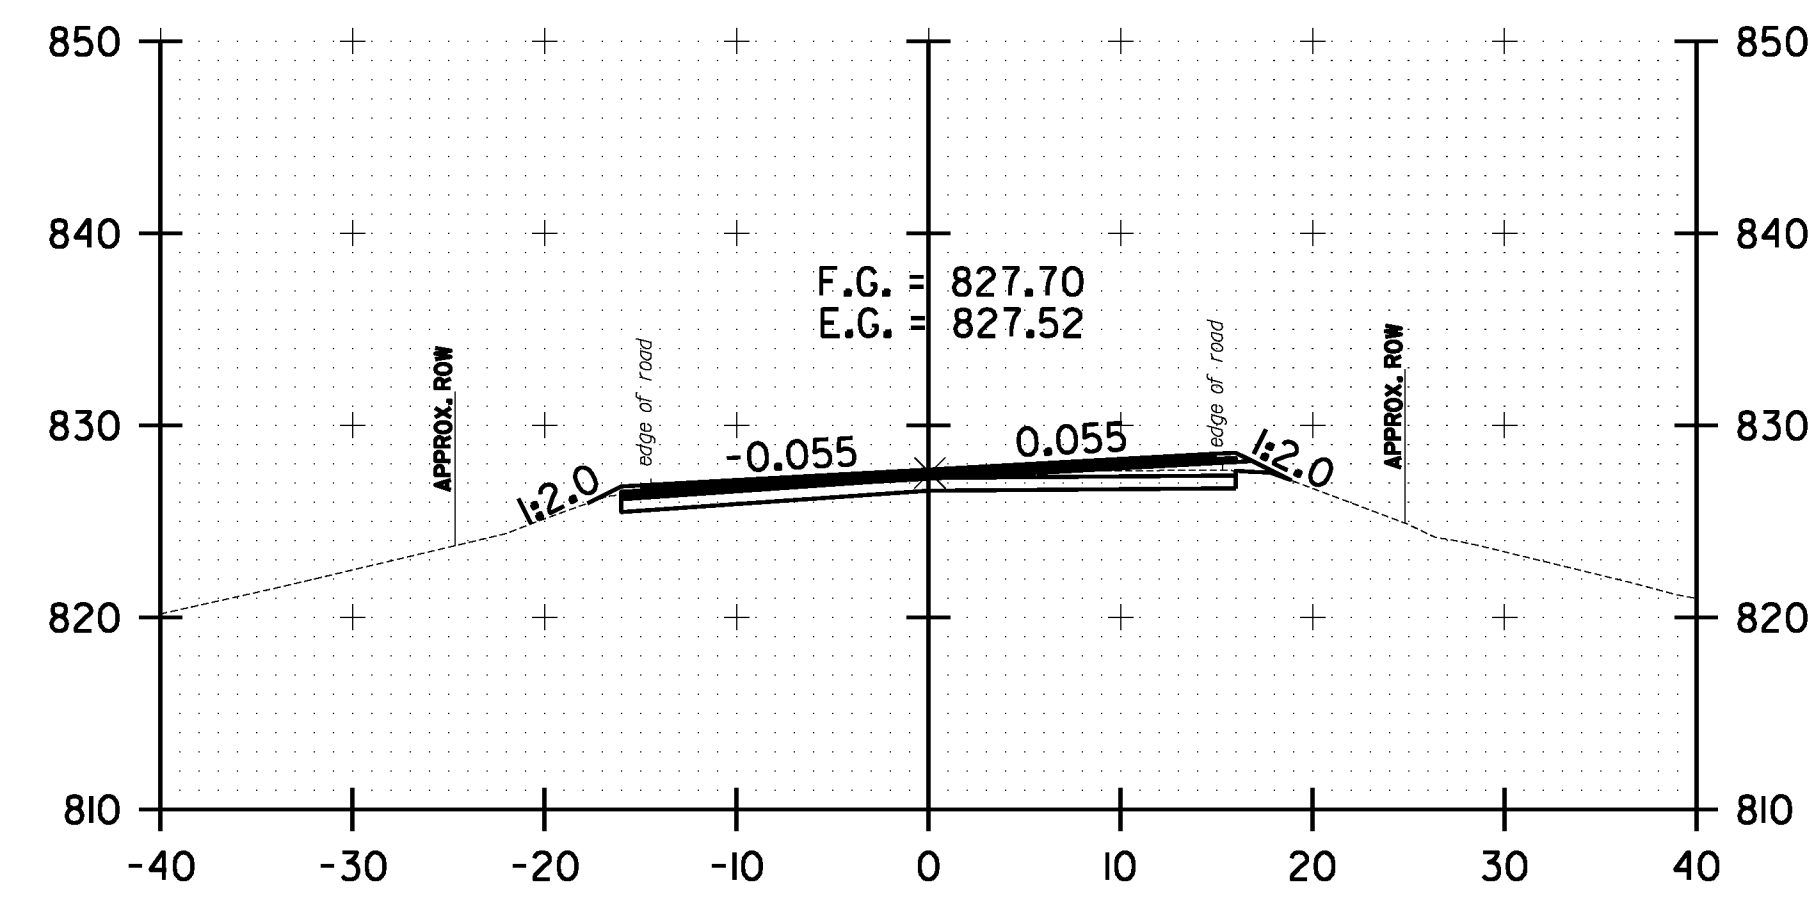

300+50.00

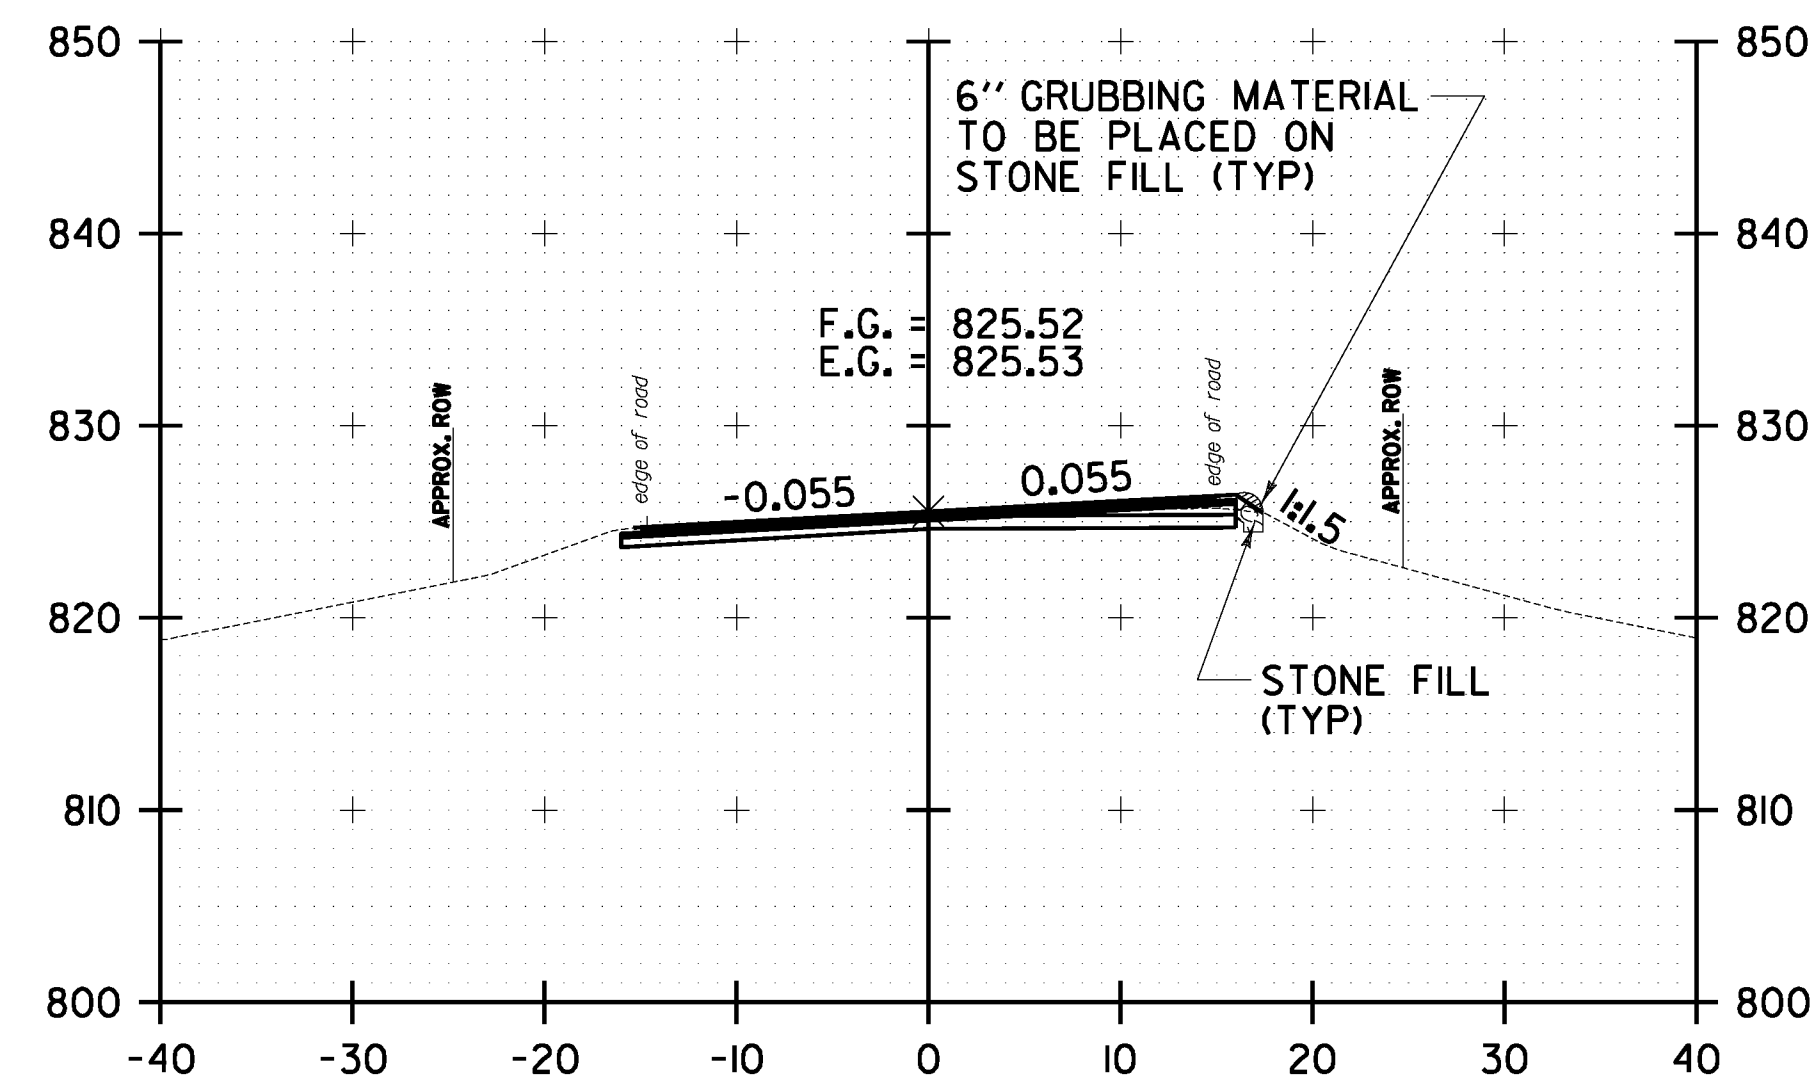

300+00.00

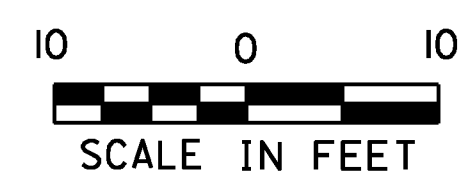

**WARREN  
 CROSS SECTION  
 SHEET #81**

PROJECT NAME: WARREN-WAITSFIELD	PLOT DATE: 12/20/2012
PROJECT NUMBER: STP 2506(1)	DRAWN BY: W.G.P.
FILE NAME: p05b048.dgn	CHECKED BY: D.E.G.
PROJECT LEADER: D.E.G.	SHEET 244 OF 310
DESIGNED BY: M.J.M.	
IPARM FILE: p05b048xs81.l	