




FILE NAME = U:\1762\CAOD\MST\STP_2506\p05b048.Convect.Plan.dgn
 DATE/TIME = 12/20/2012
 USER = 4866

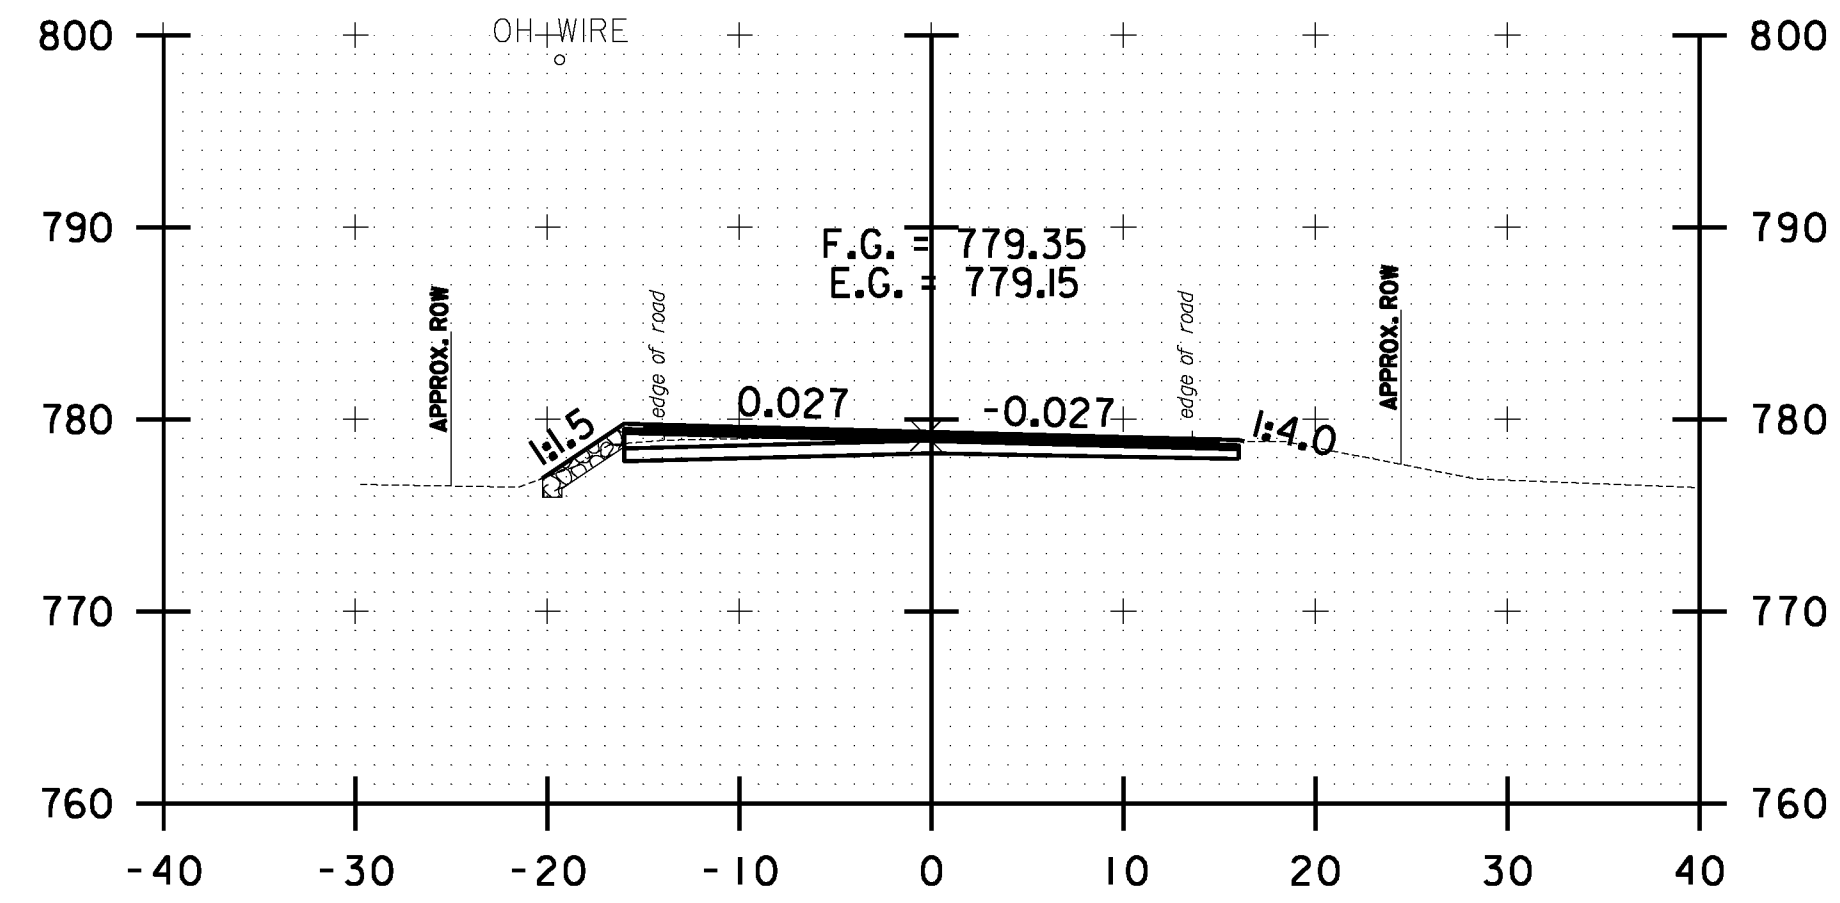


1+00.00

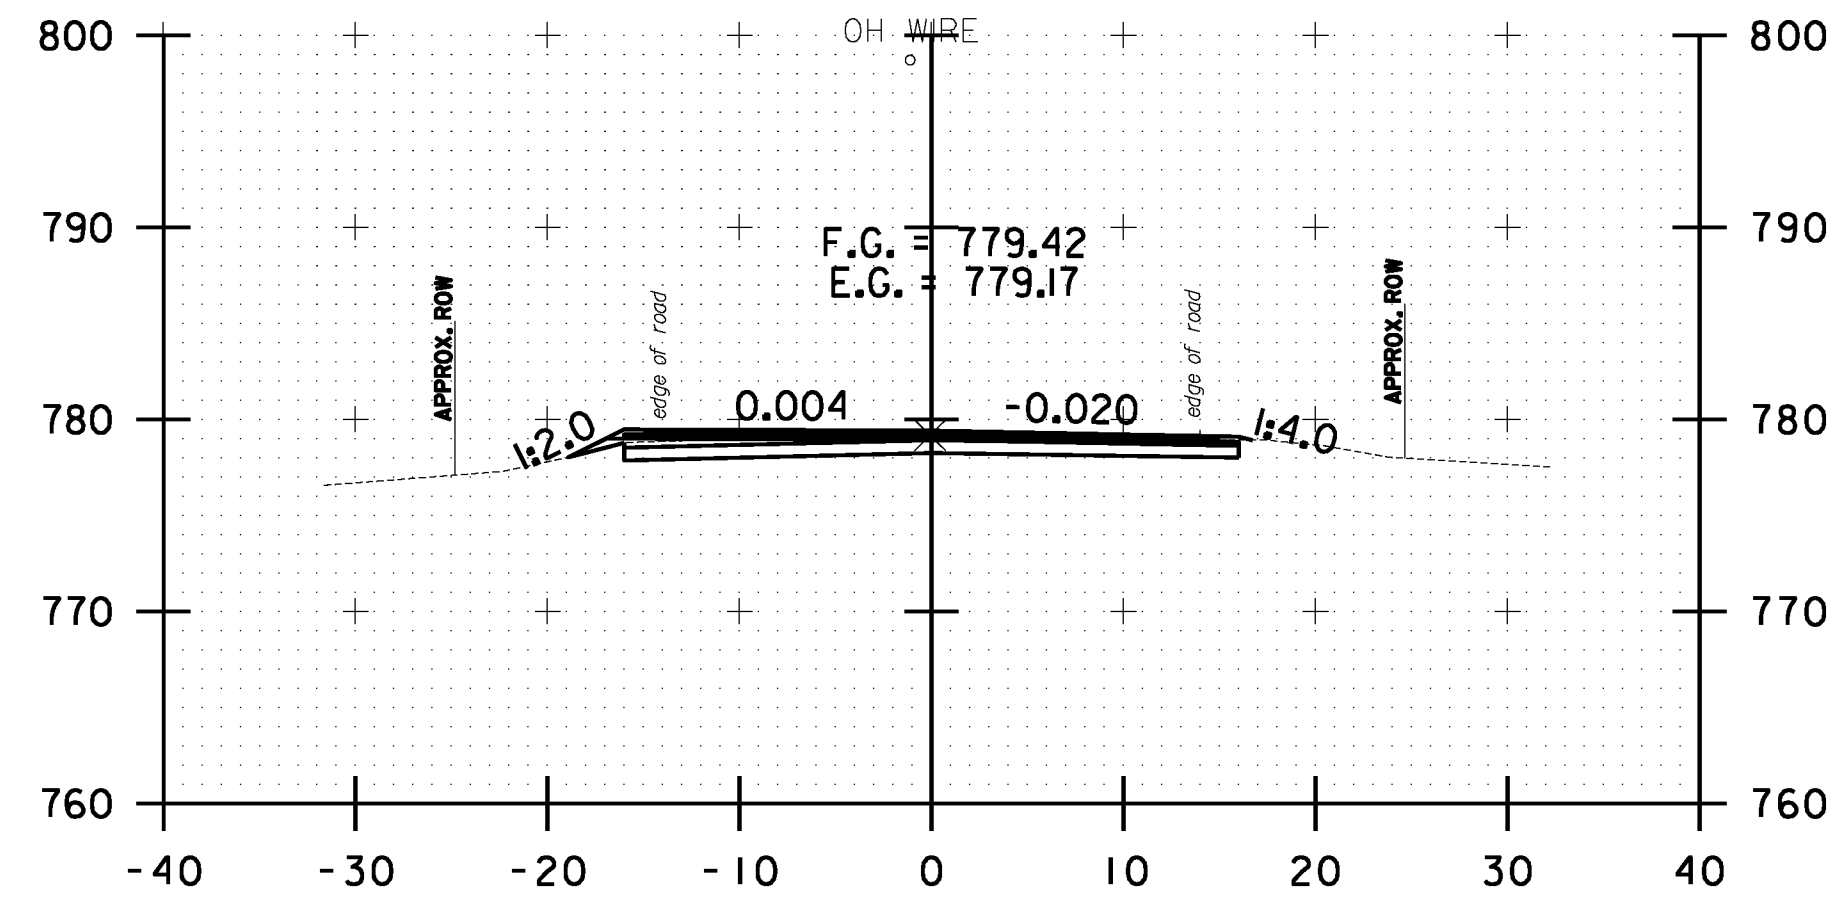


0+50.00

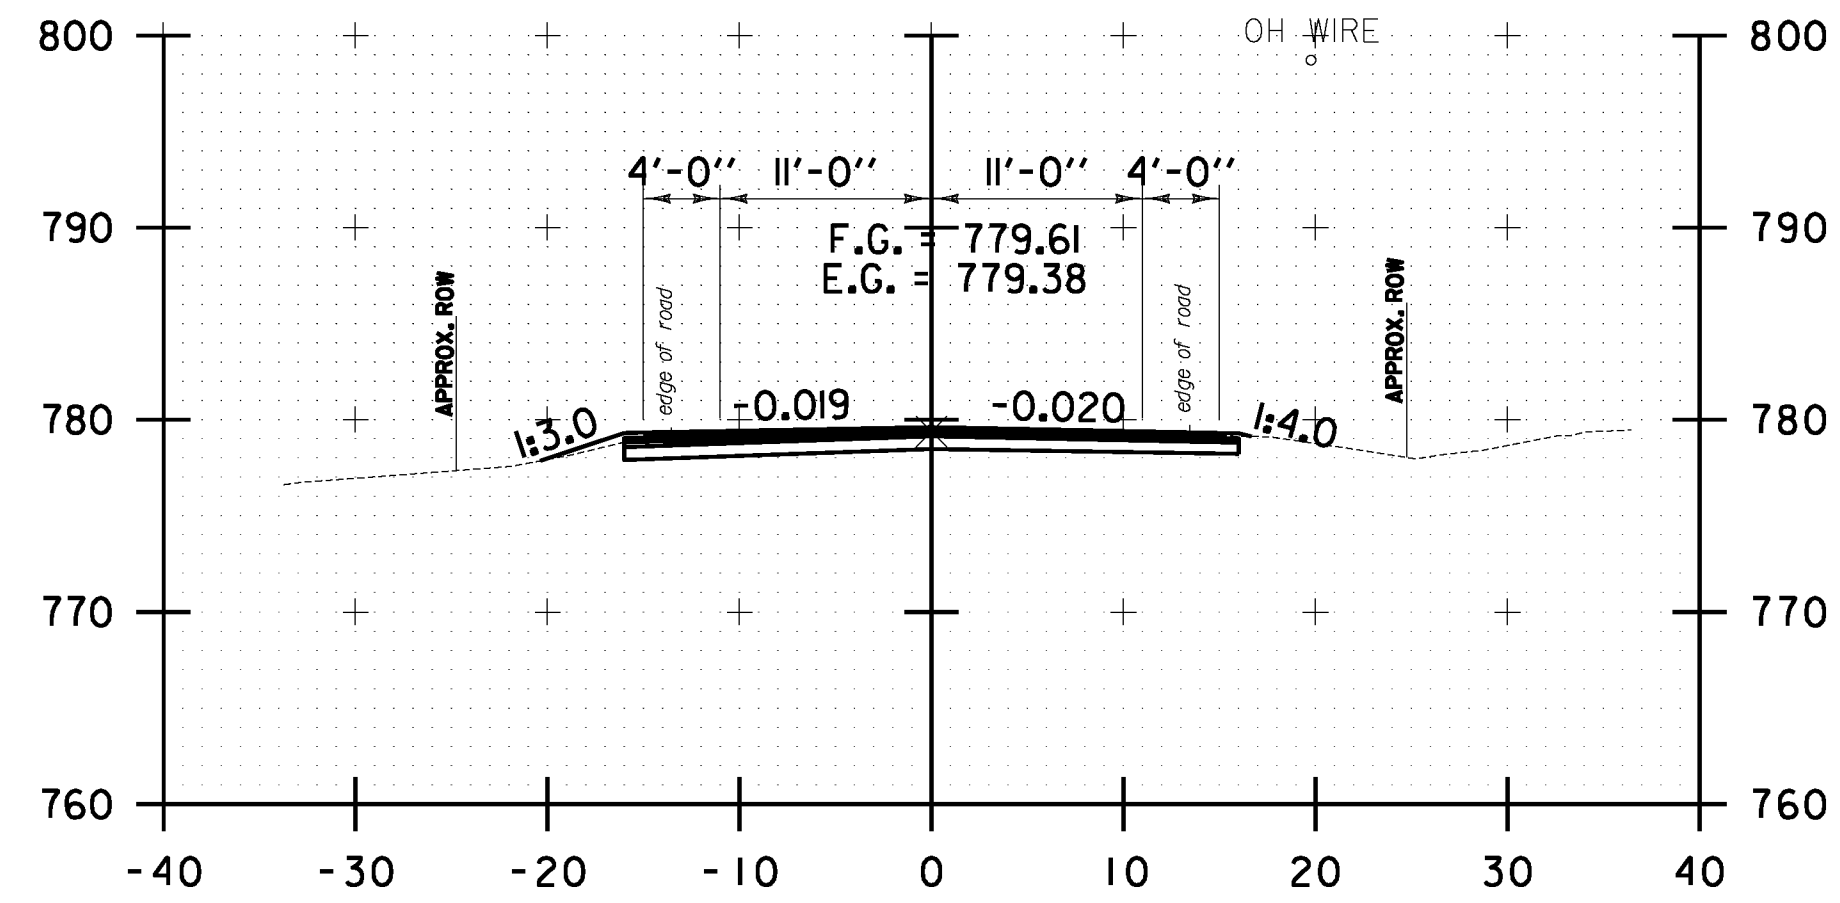


0+00.00

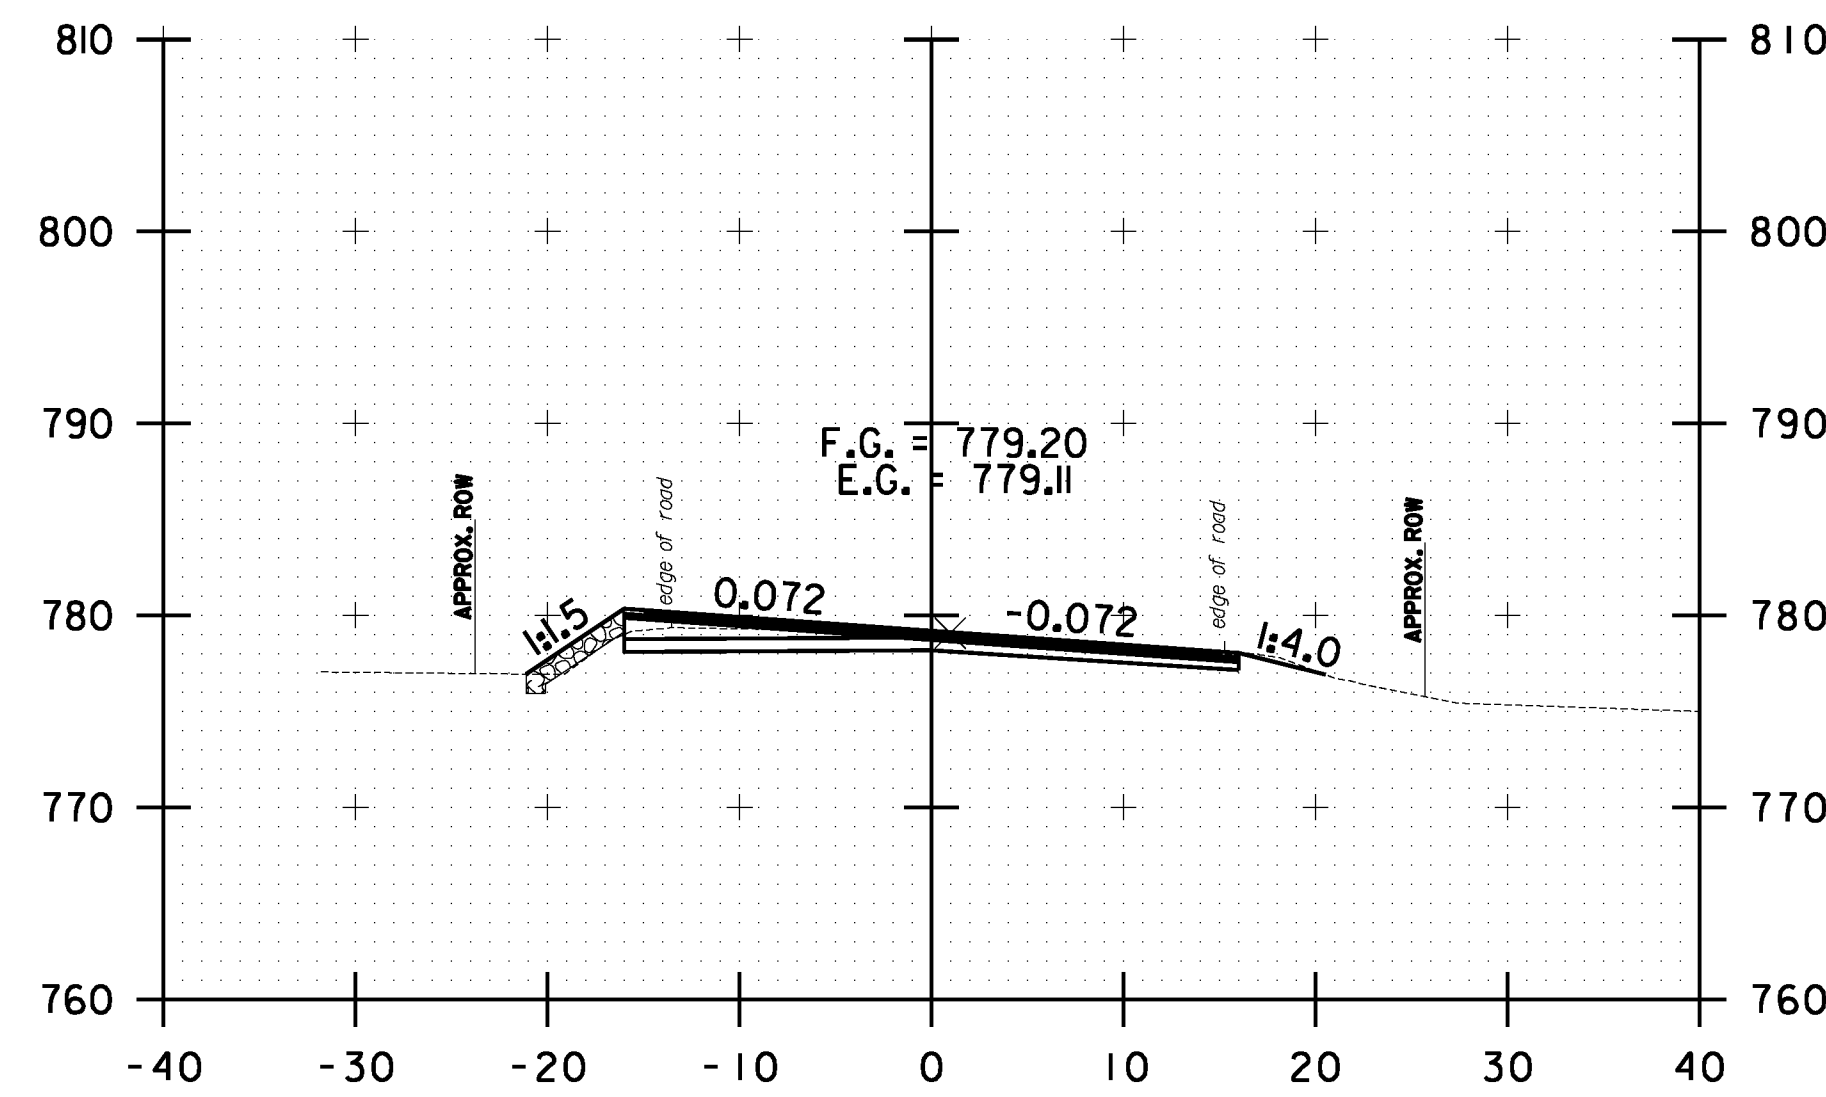


2+00.00

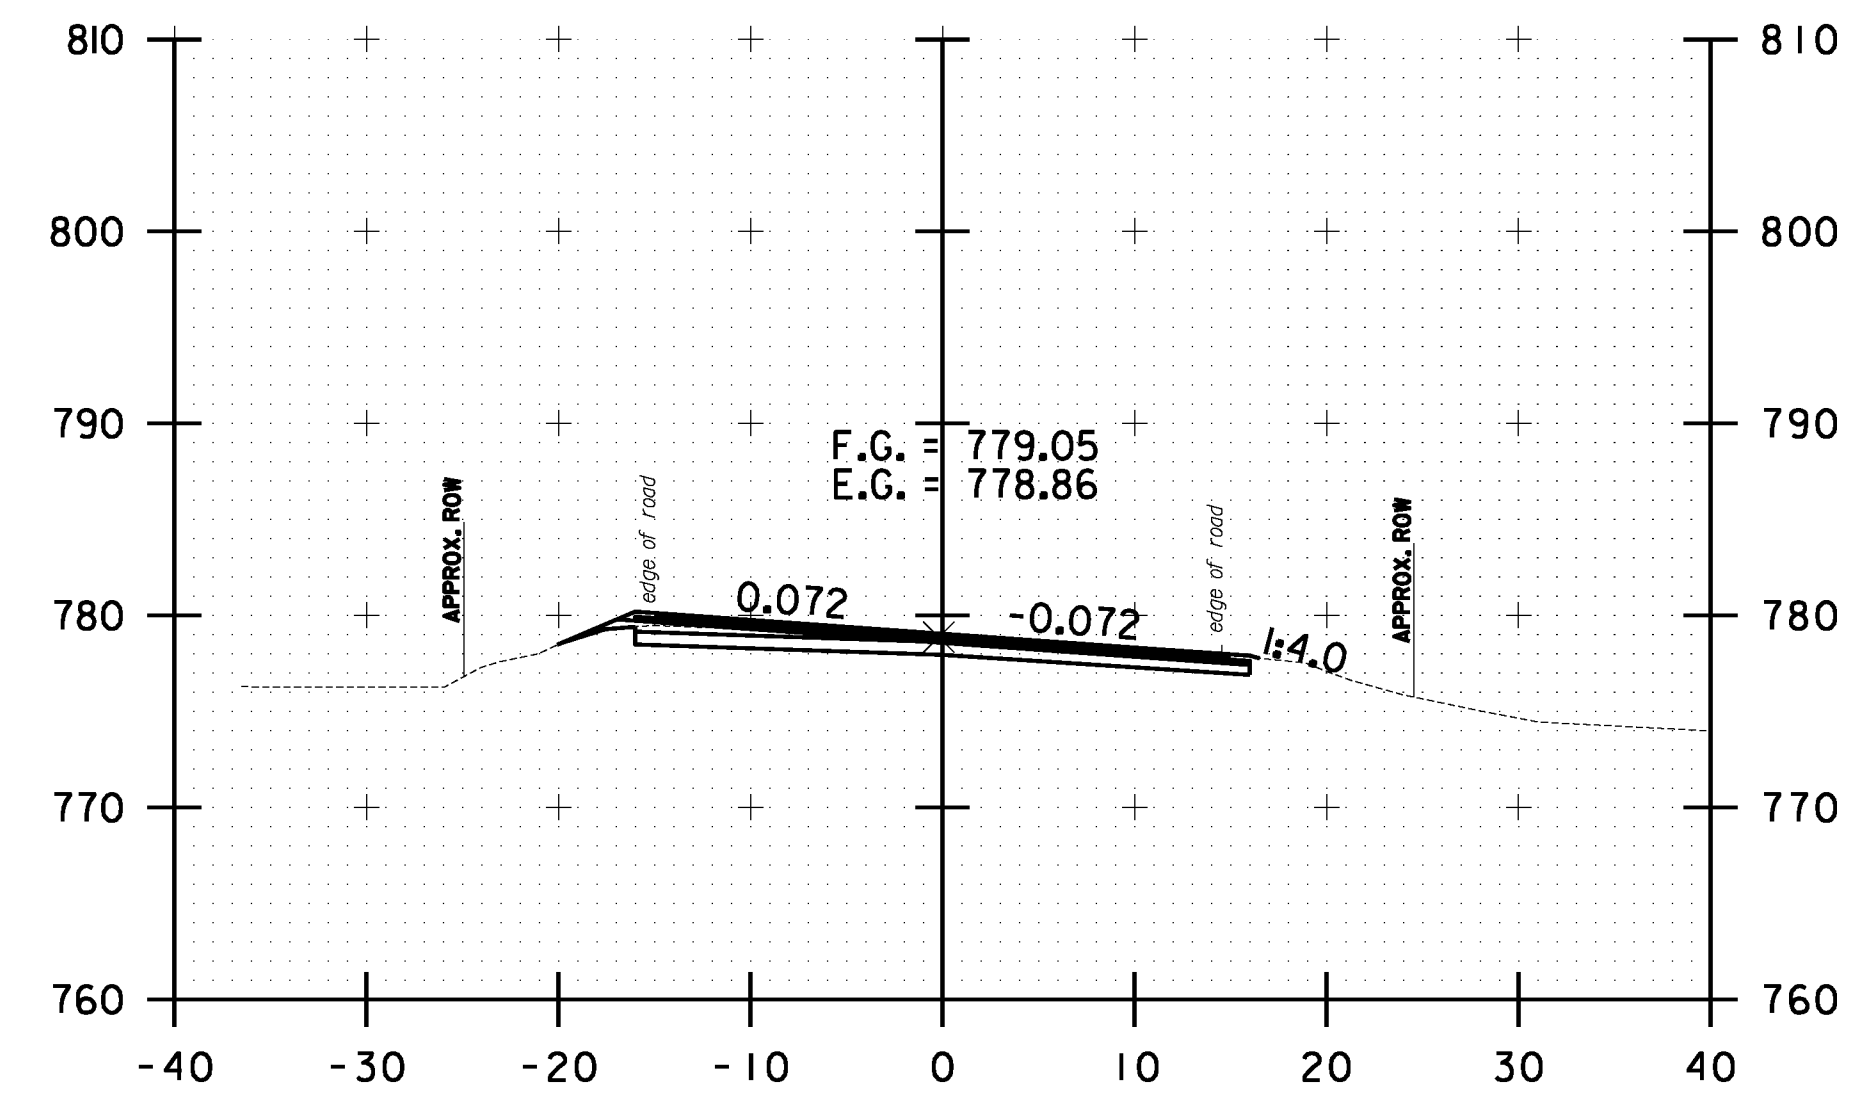


3+00.00

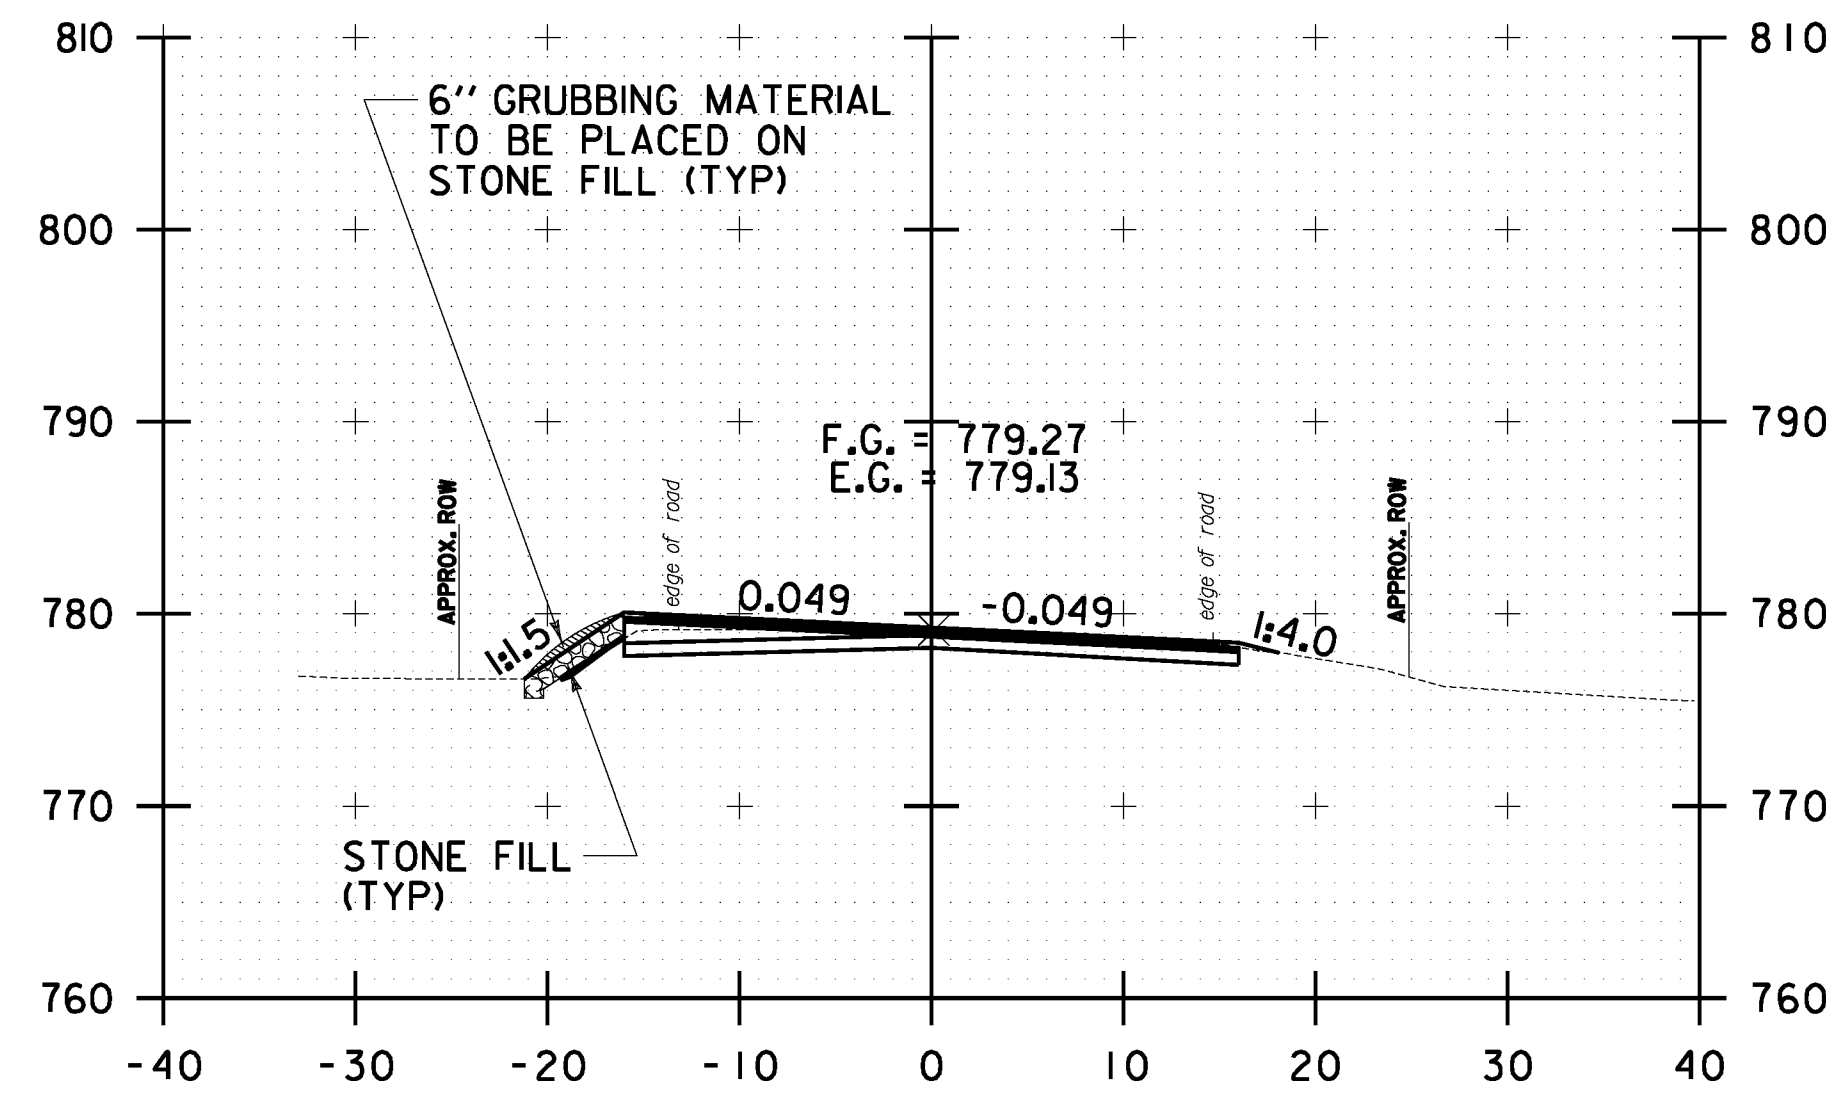

1+50.00

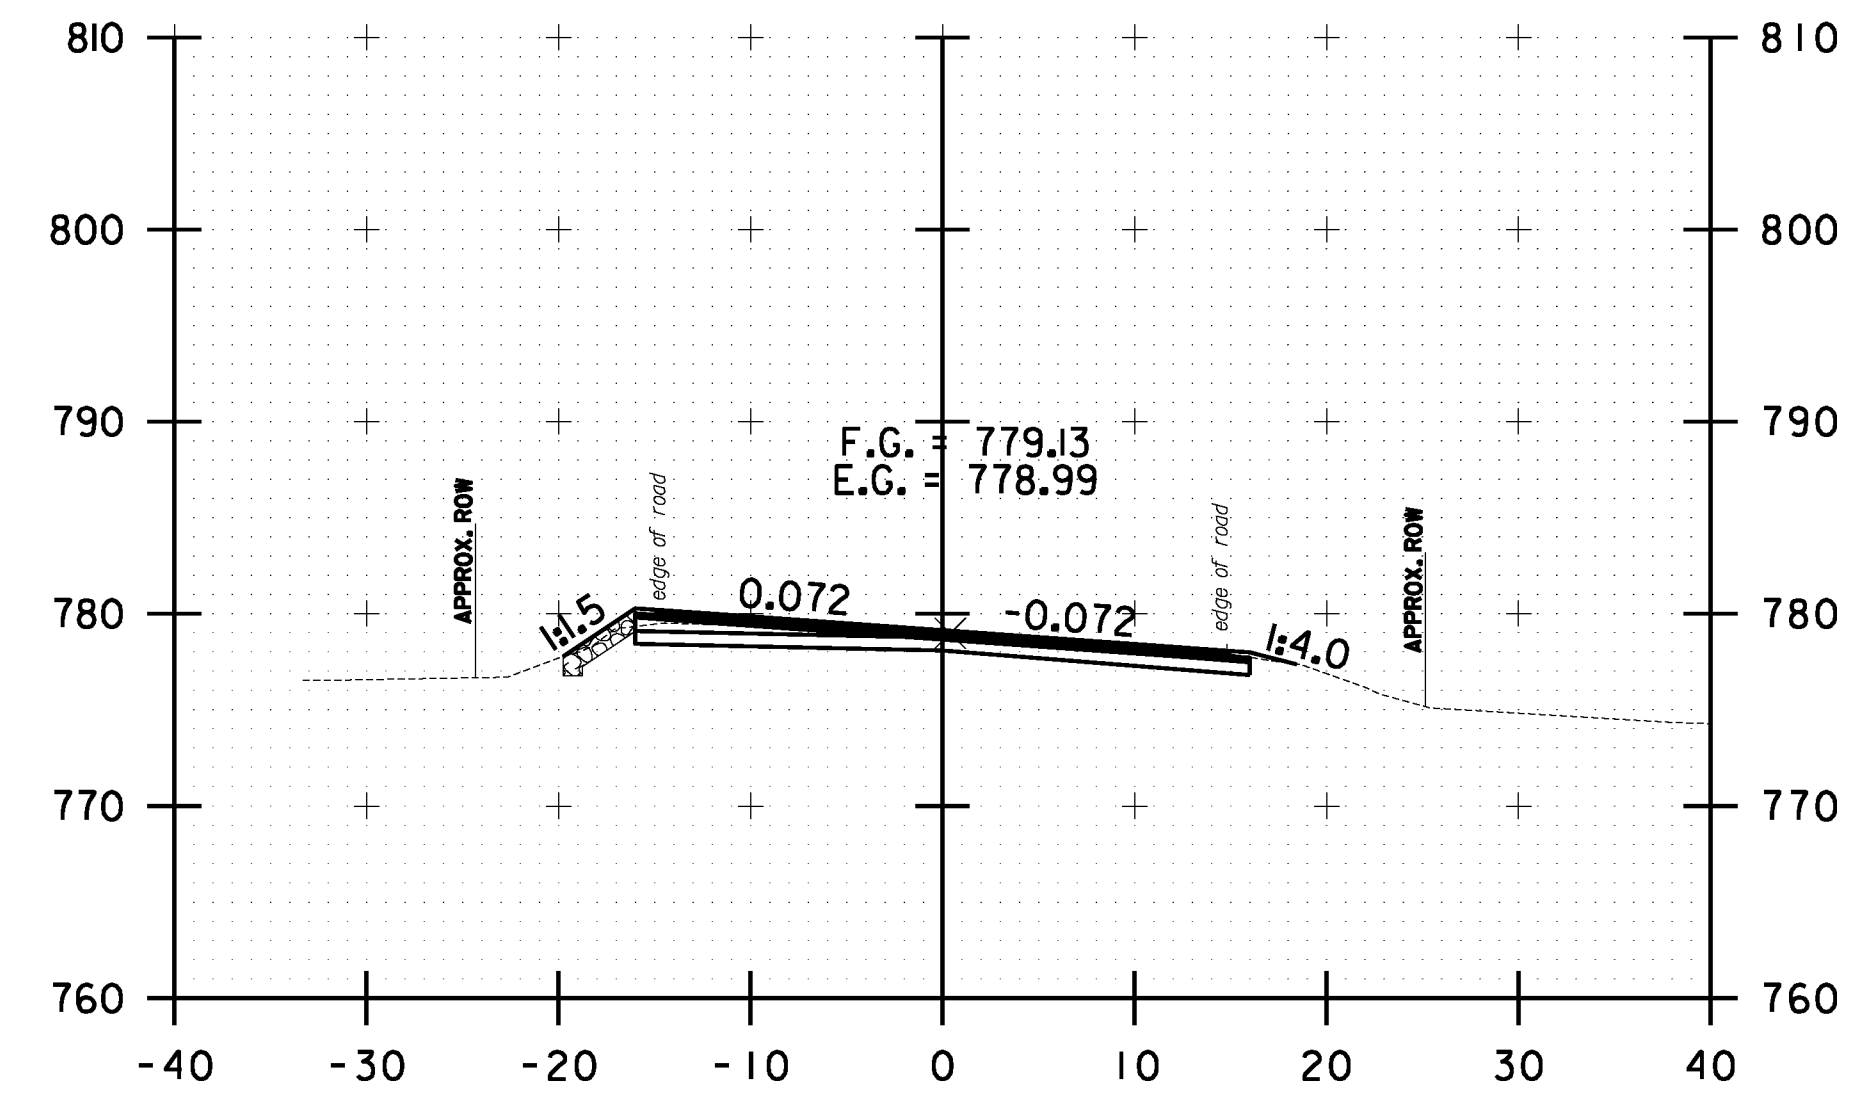

2+50.00

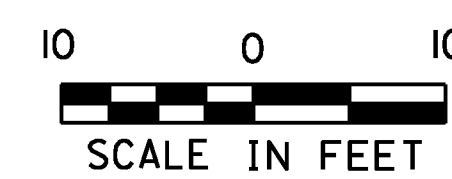

**WAITSFIELD
 CROSS SECTION
 SHEET #1**

PROJECT NAME: WARREN-WAITSFIELD

PROJECT NUMBER: STP 2506(1)

FILE NAME: p05b048.dgn

PROJECT LEADER: D.E.G.

DESIGNED BY: M.J.M.

IPARM FILE: p05b048xs94.1

PLOT DATE: 12/20/2012

DRAWN BY: W.G.P.

CHECKED BY: D.E.G.

SHEET 257 OF 310