




FILE NAME: U:\1762\CA00\MST\STP_2506\p05b048.Conv.eas Plana.dgn
 DATE/TIME: 12/20/2012
 USER: 4866

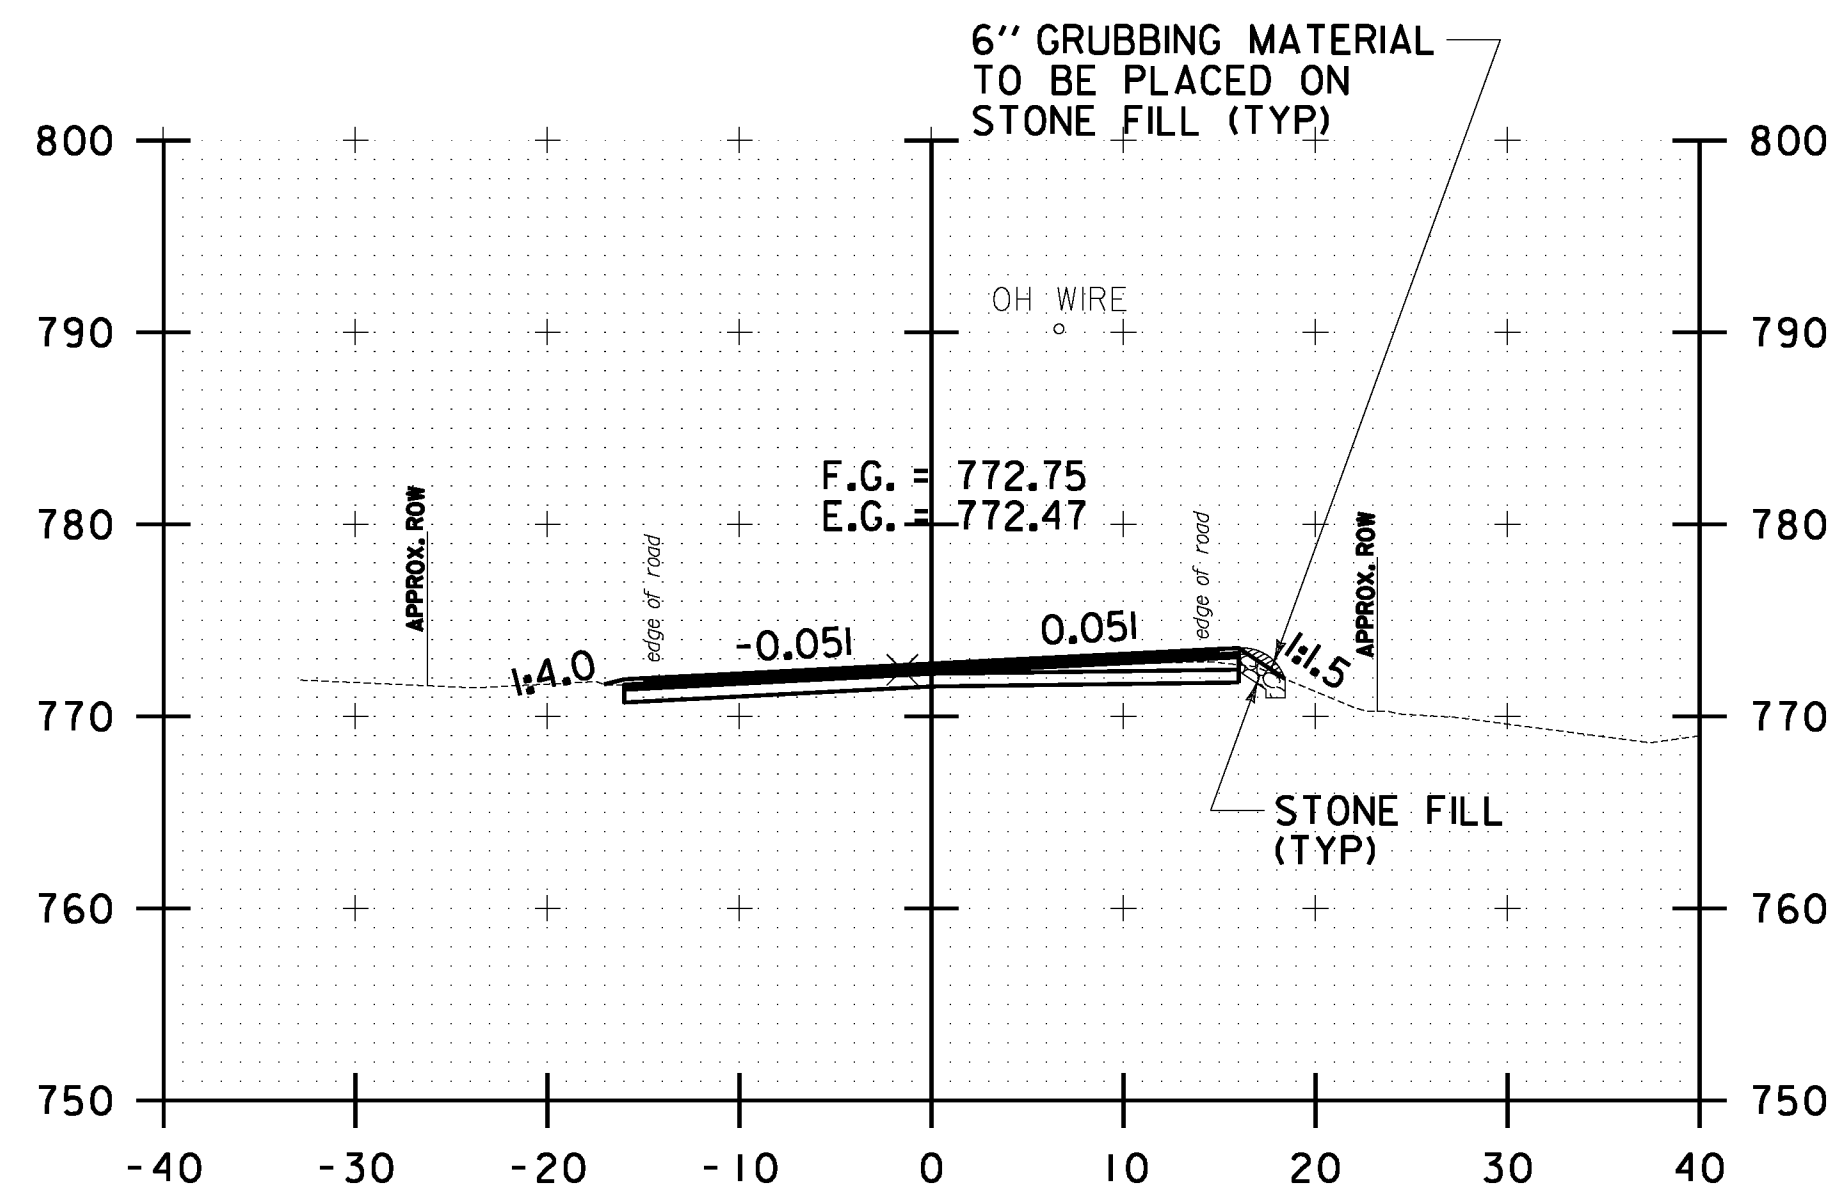


11+50.00

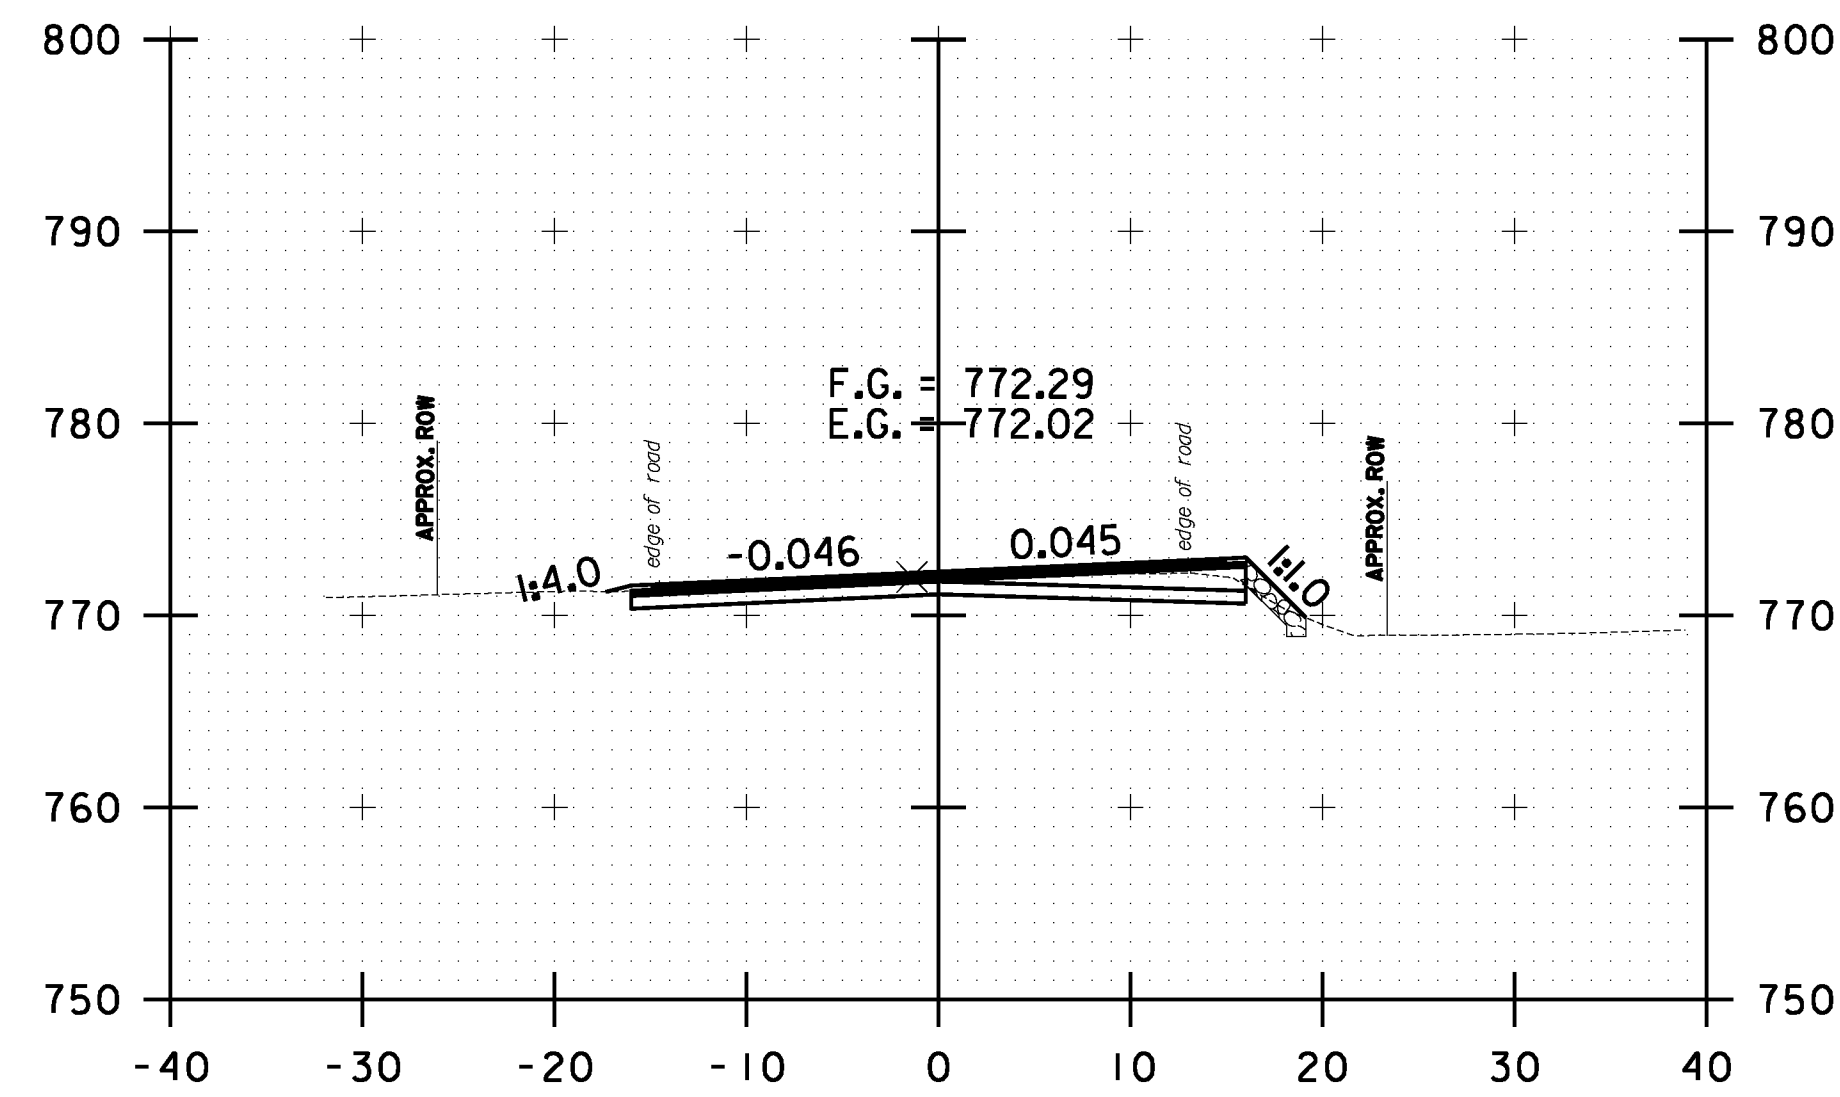


12+50.00

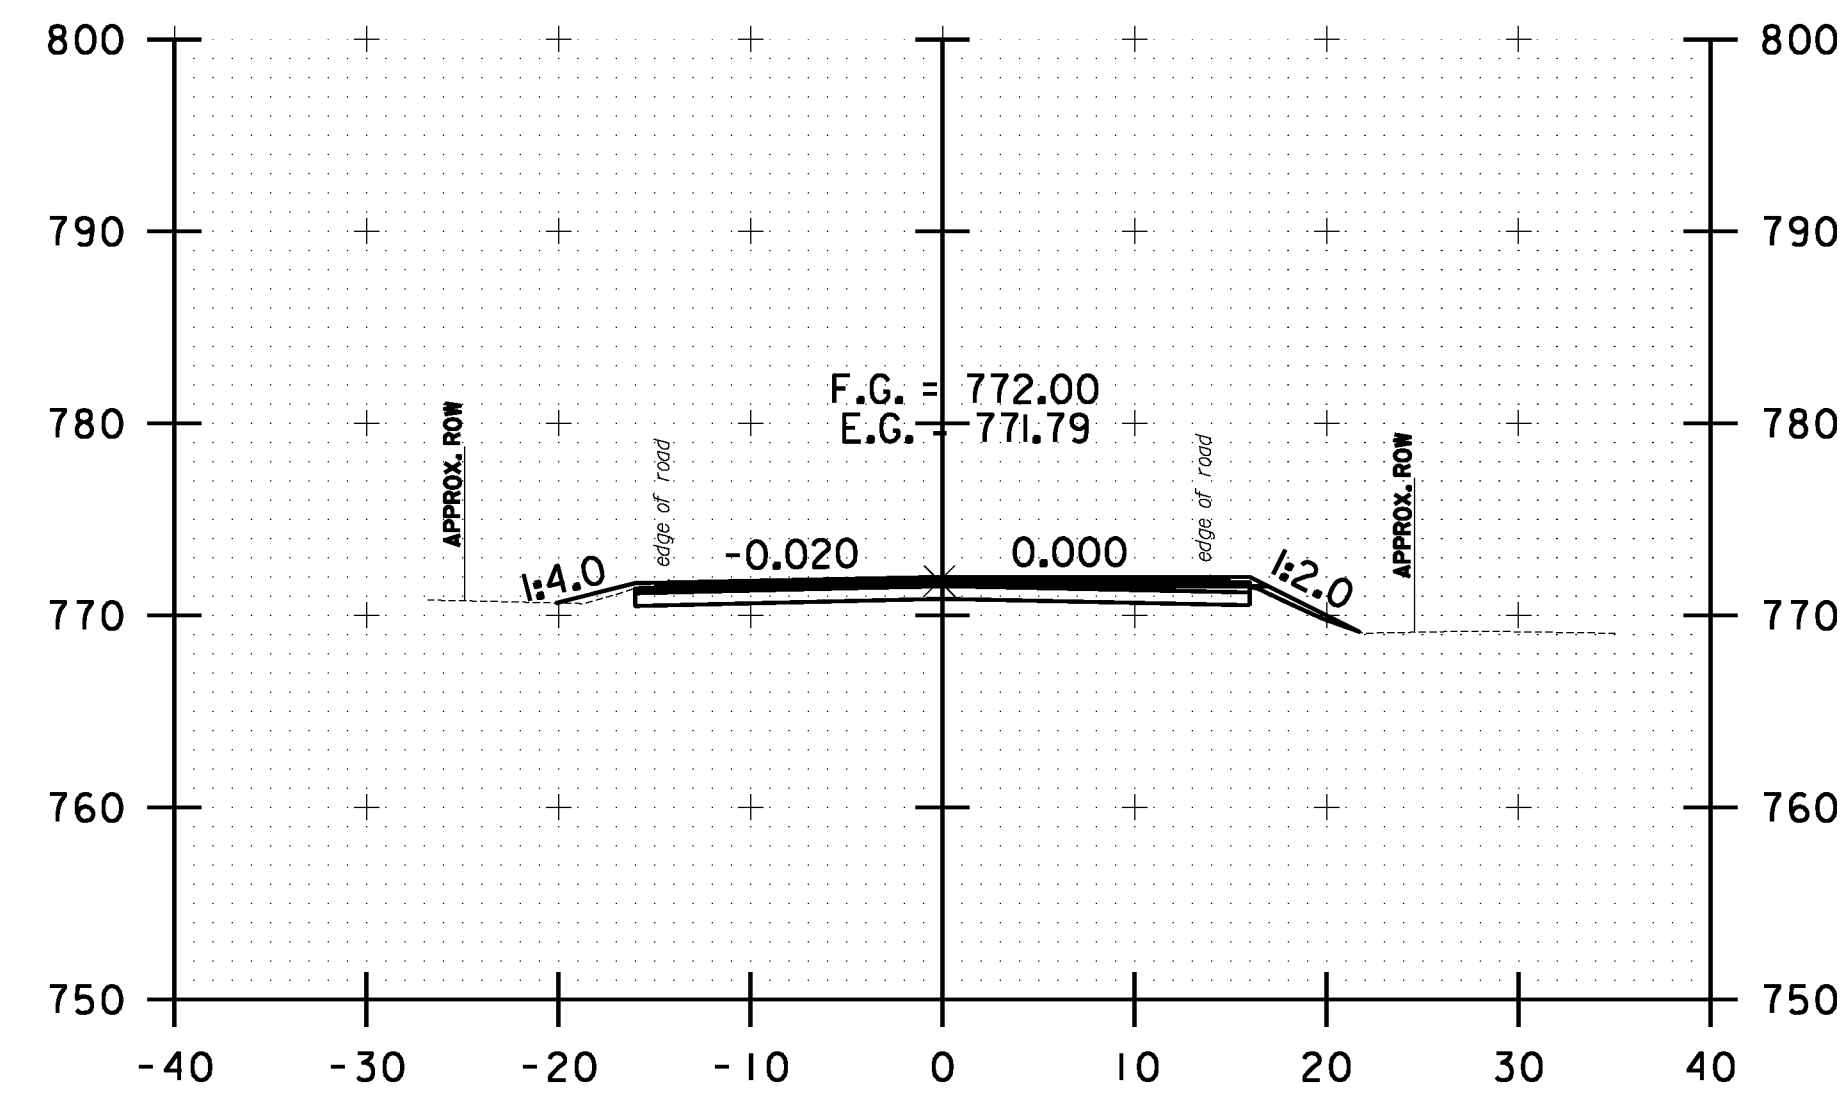


13+50.00

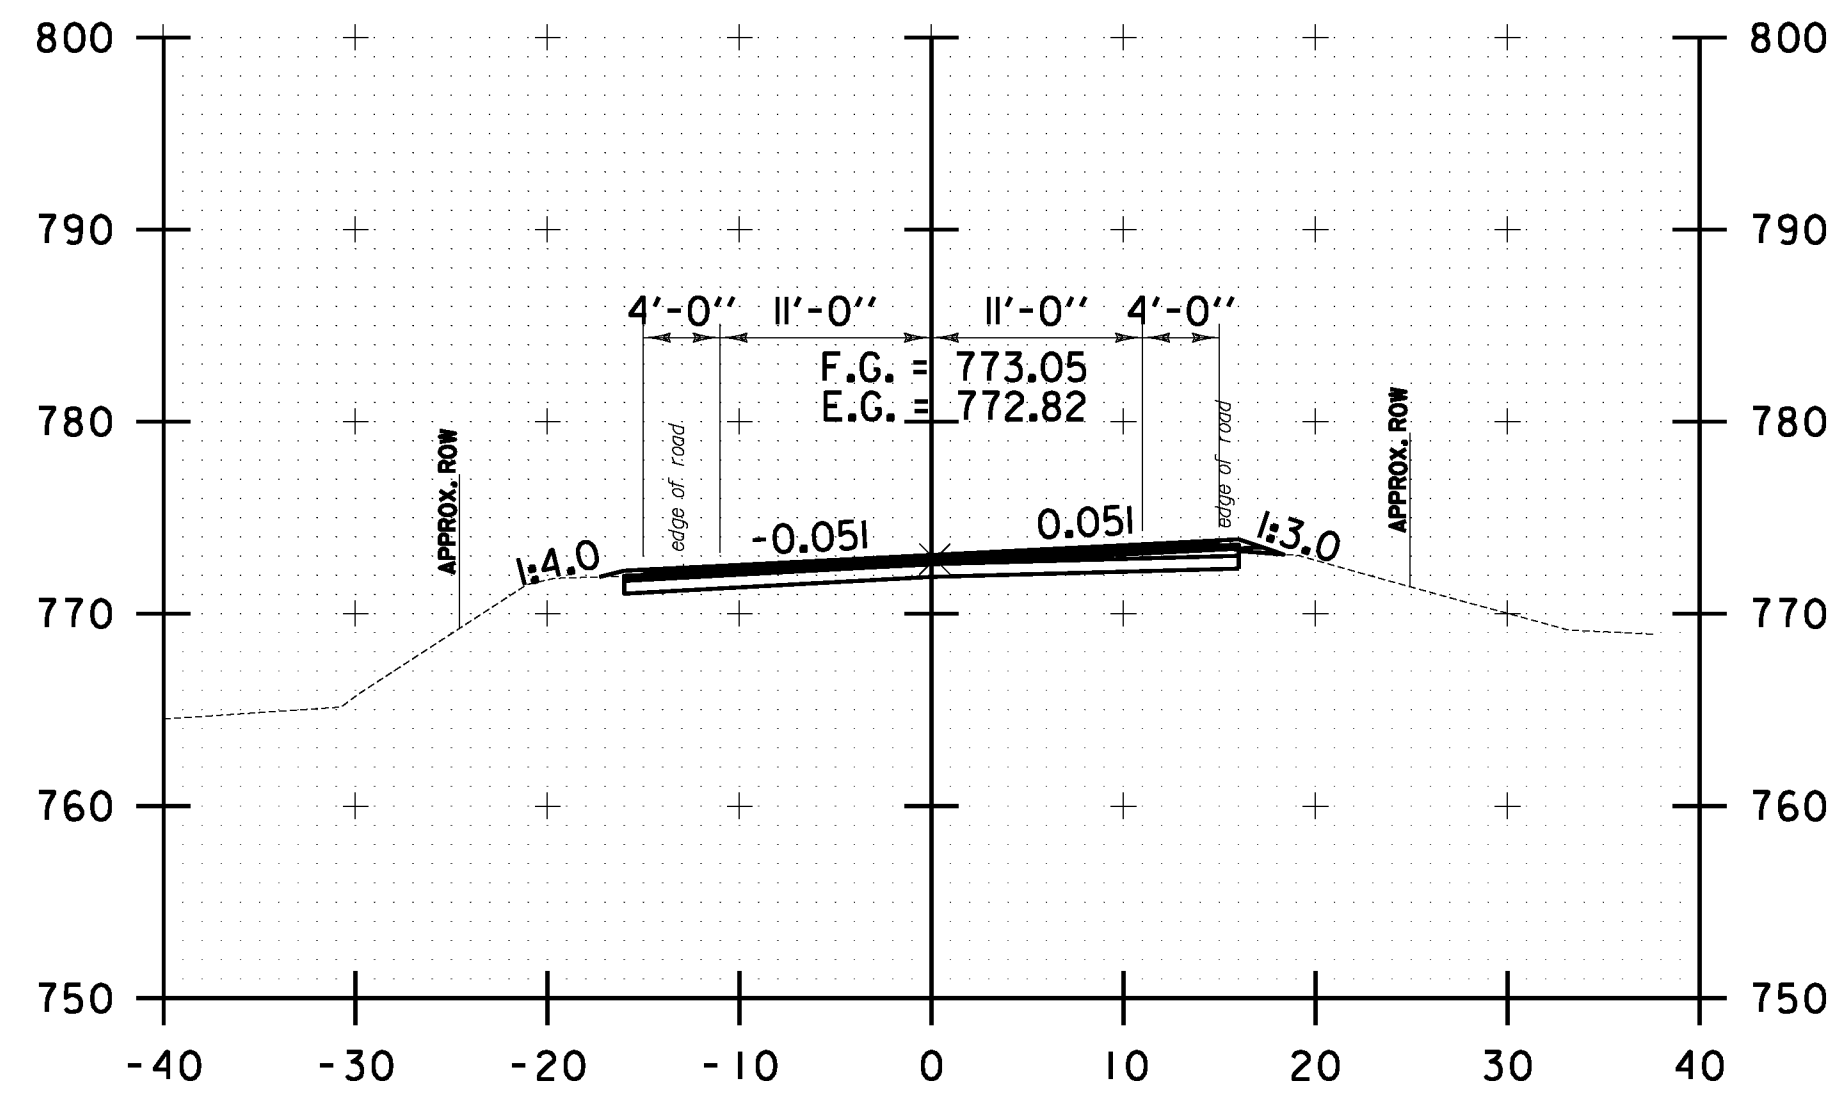


11+00.00

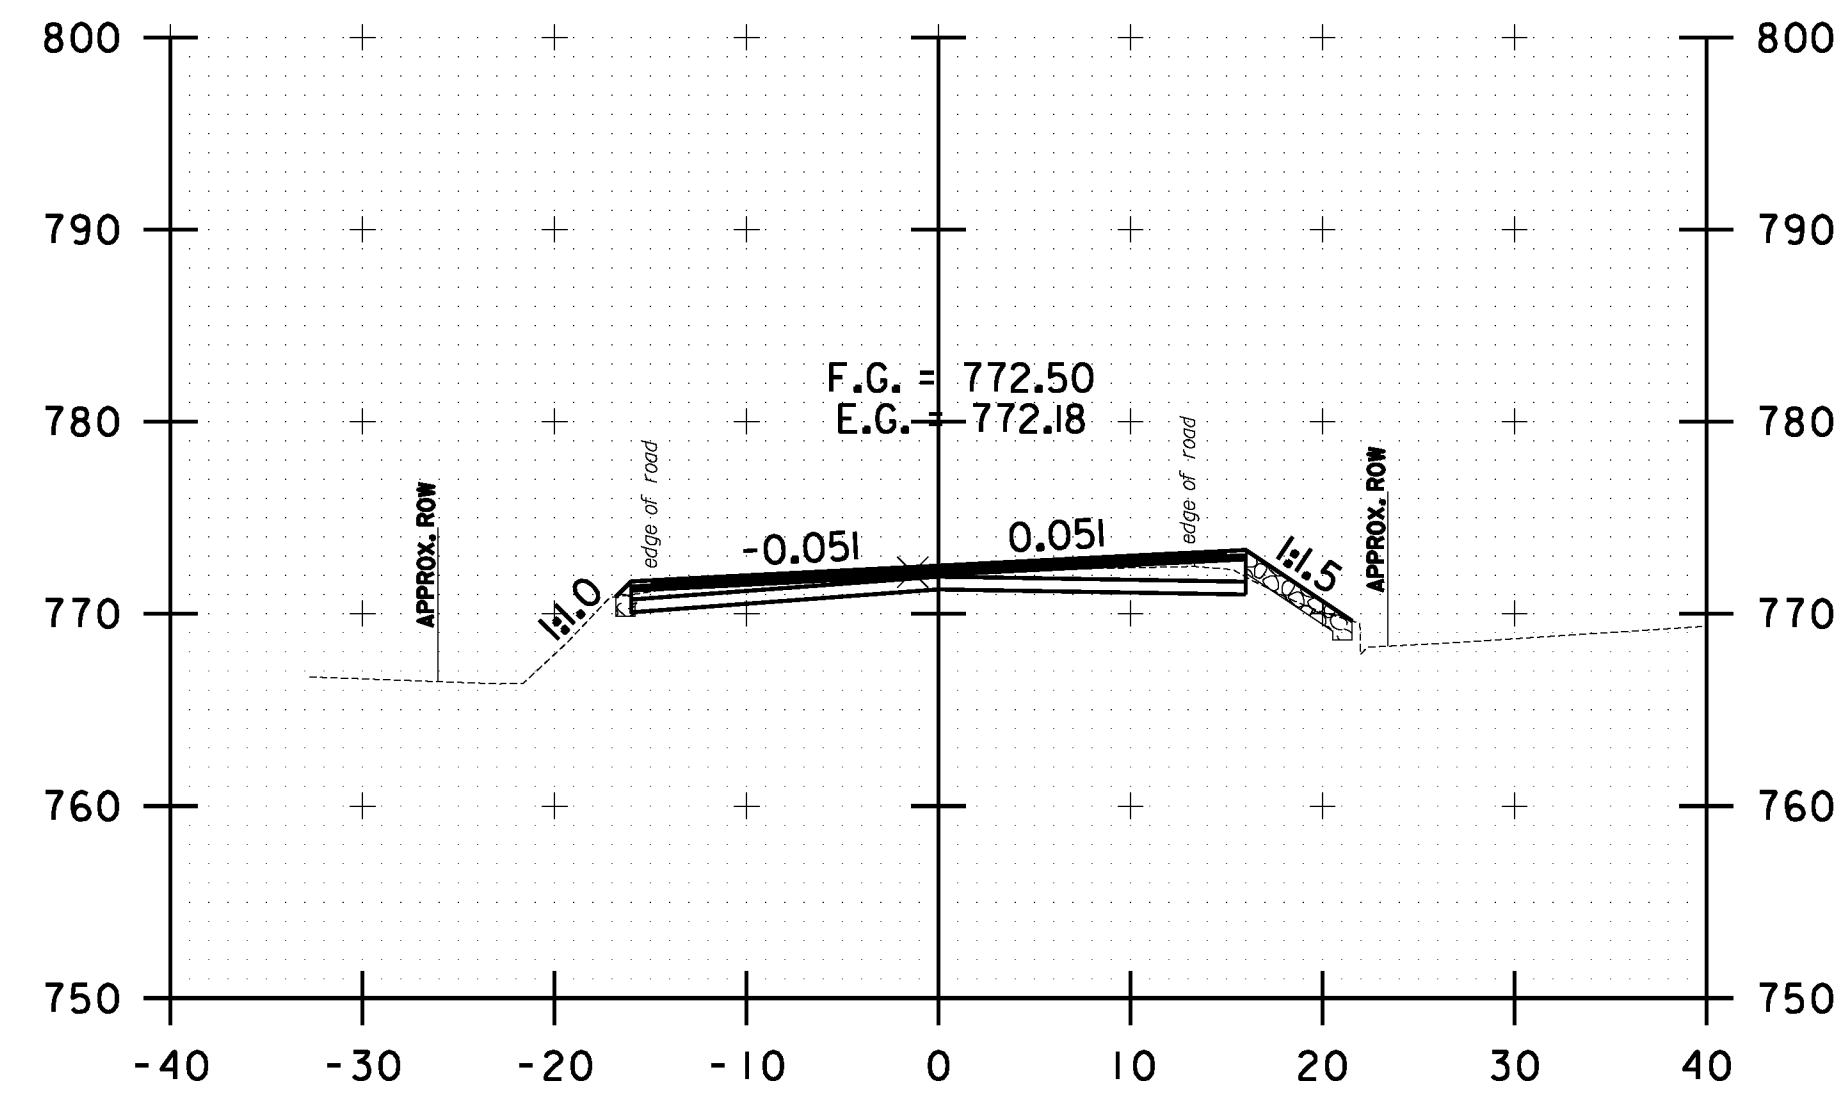

12+00.00

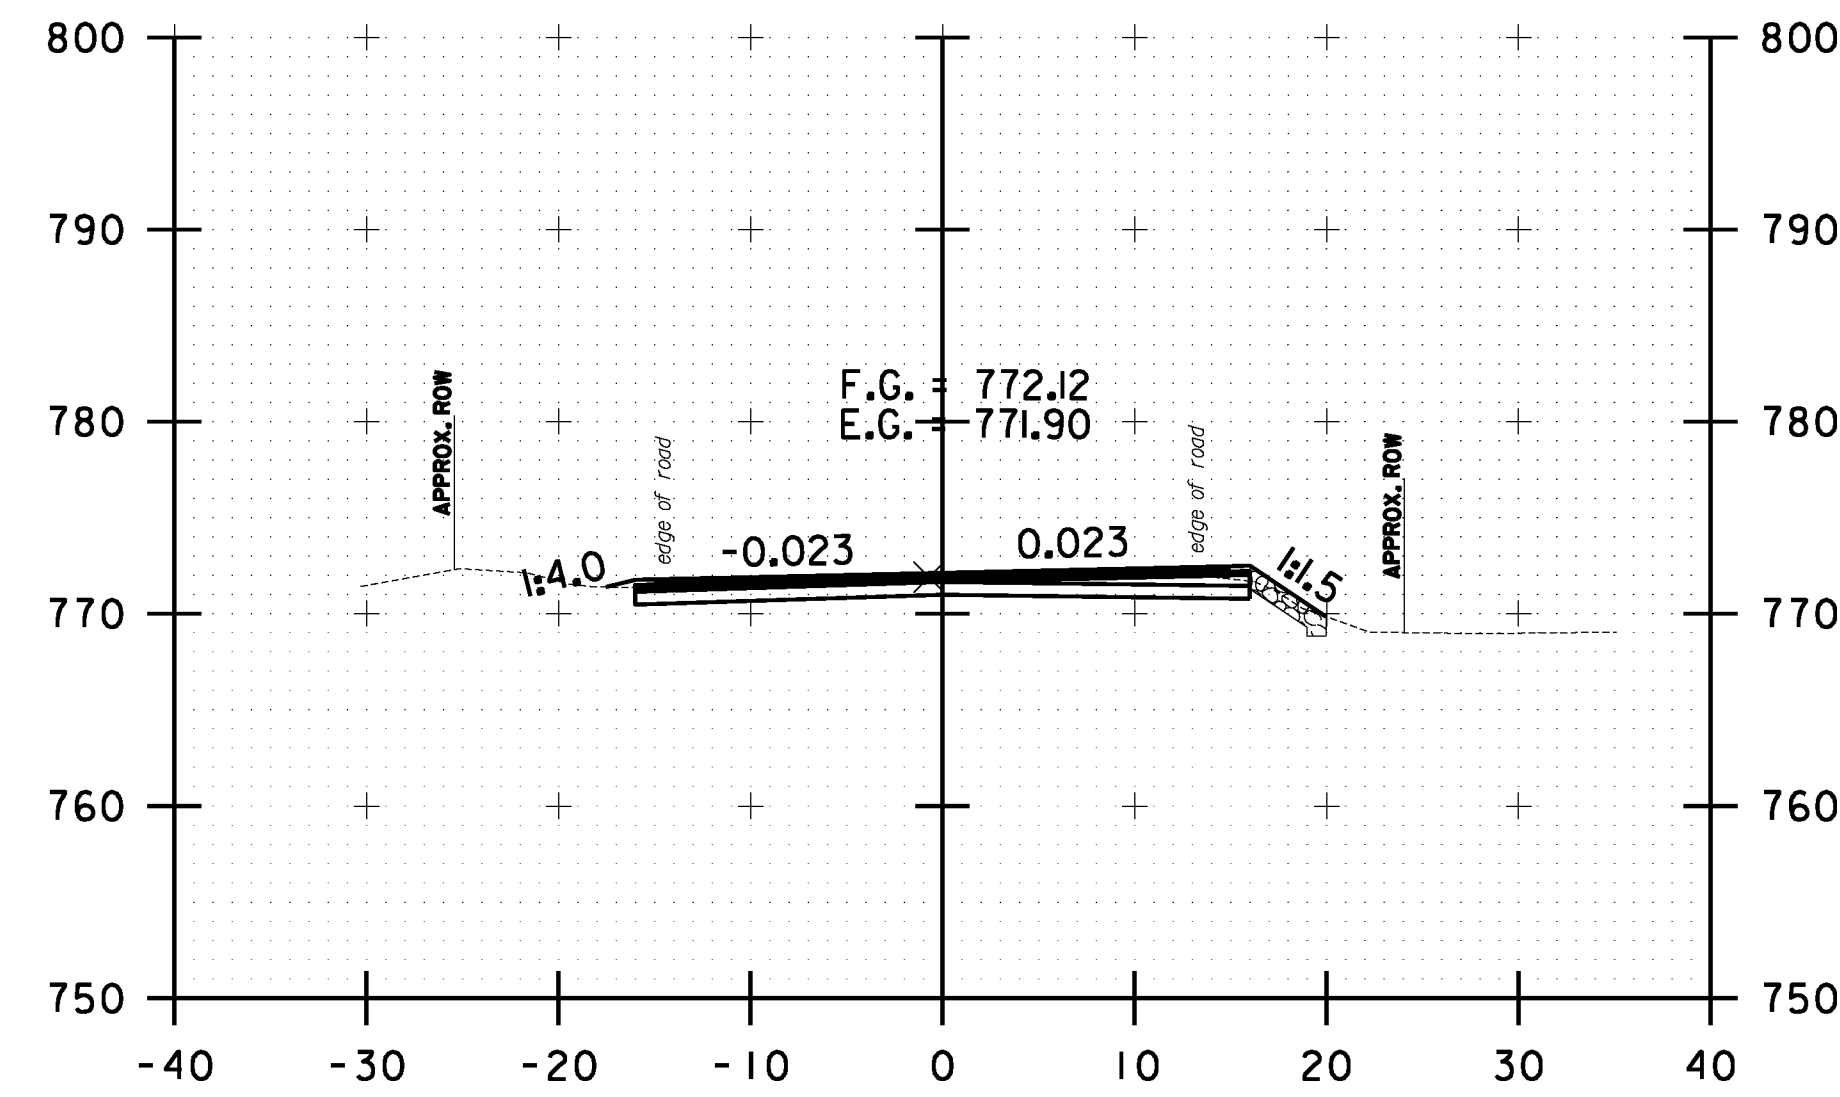

13+00.00

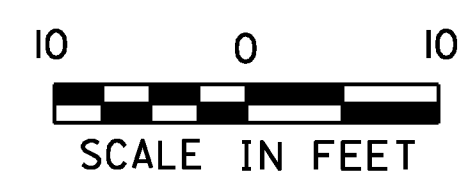

**WAITSFIELD
 CROSS SECTION
 SHEET #4**

PROJECT NAME: WARREN-WAITSFIELD

PROJECT NUMBER: STP 2506(1)

FILE NAME: p05b048.dgn

PROJECT LEADER: D.E.G.

DESIGNED BY: M.J.M.

IPARM FILE: p05b048xs97.1

PLOT DATE: 12/20/2012

DRAWN BY: W.G.P.

CHECKED BY: D.E.G.

SHEET 260 OF 310