
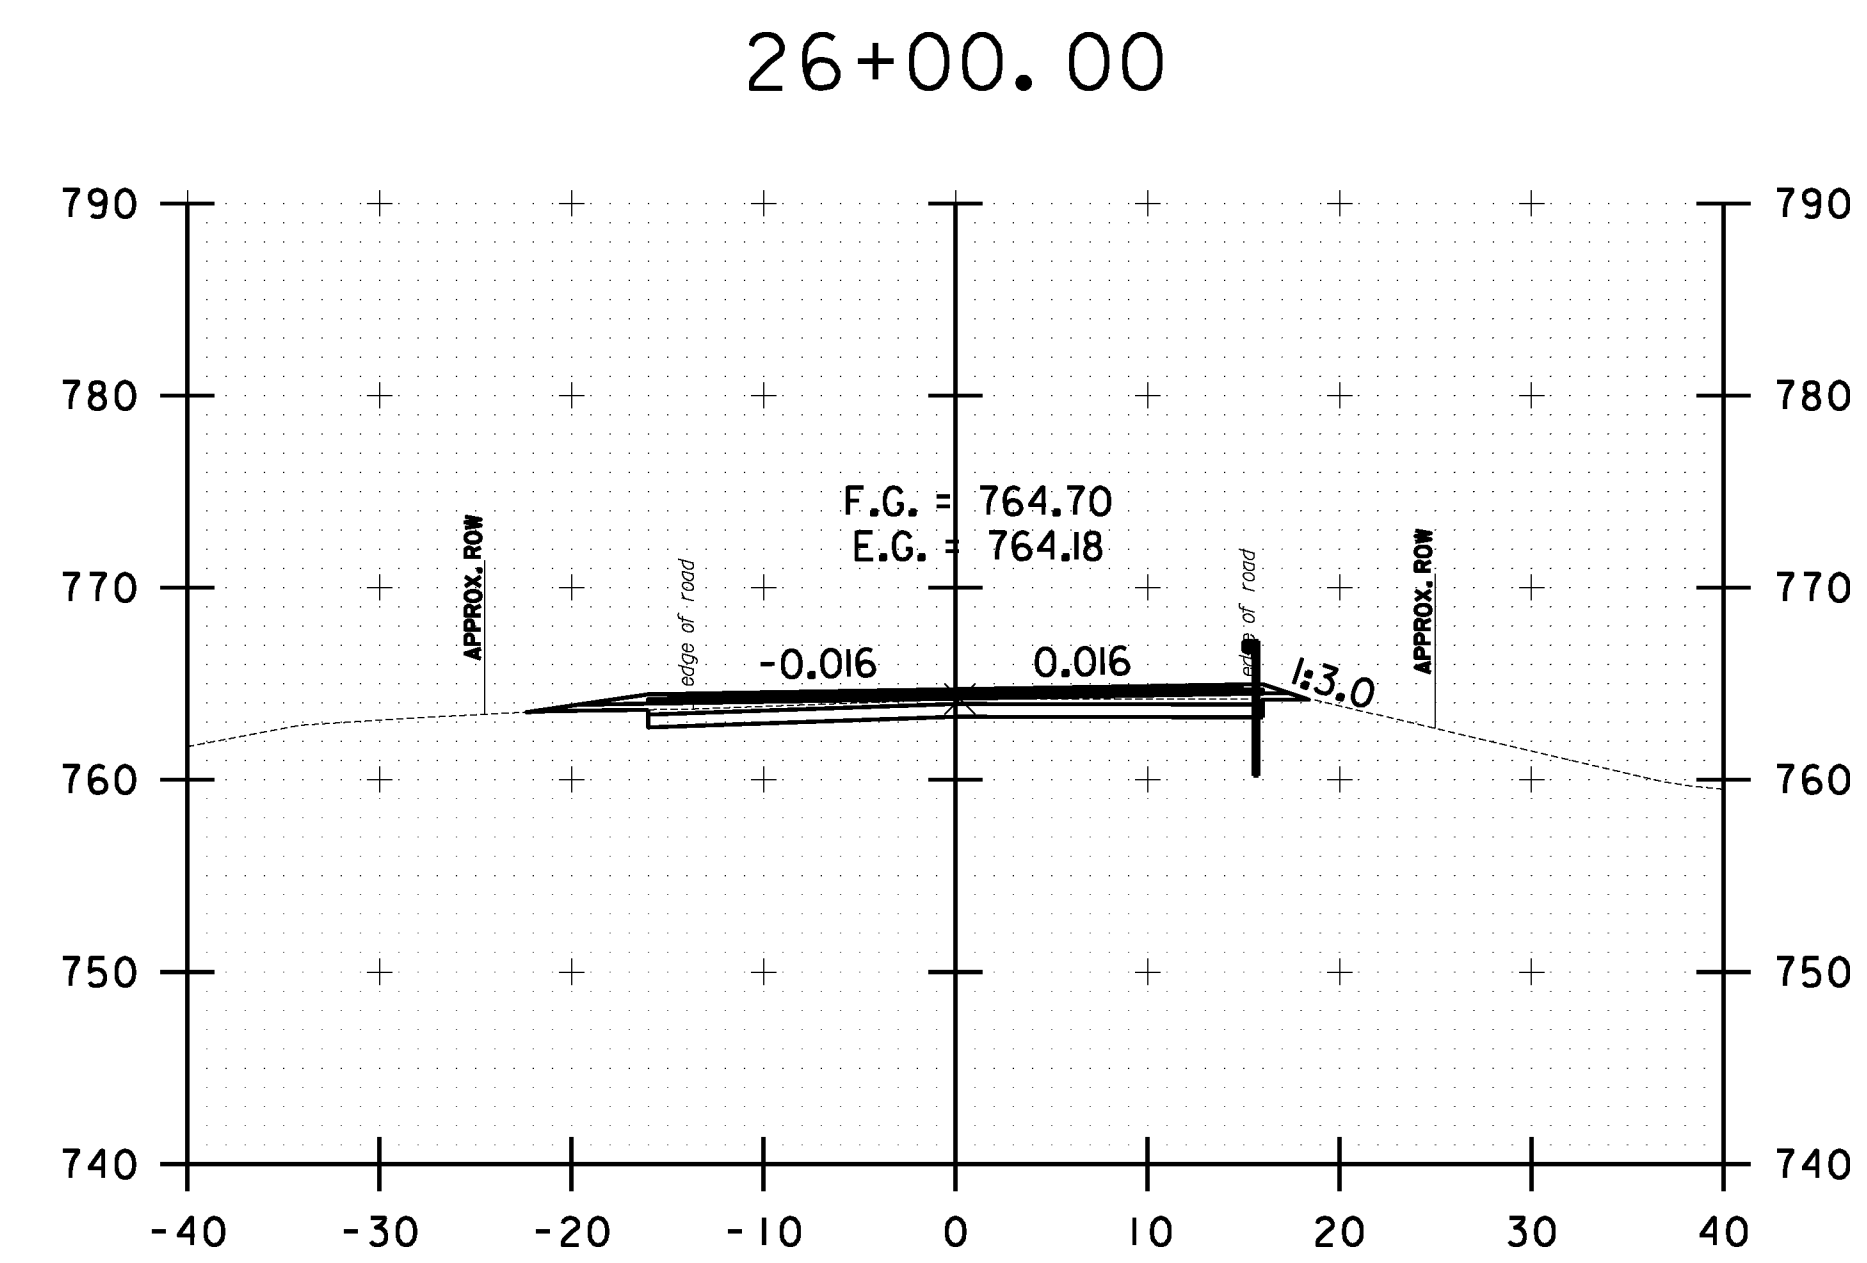
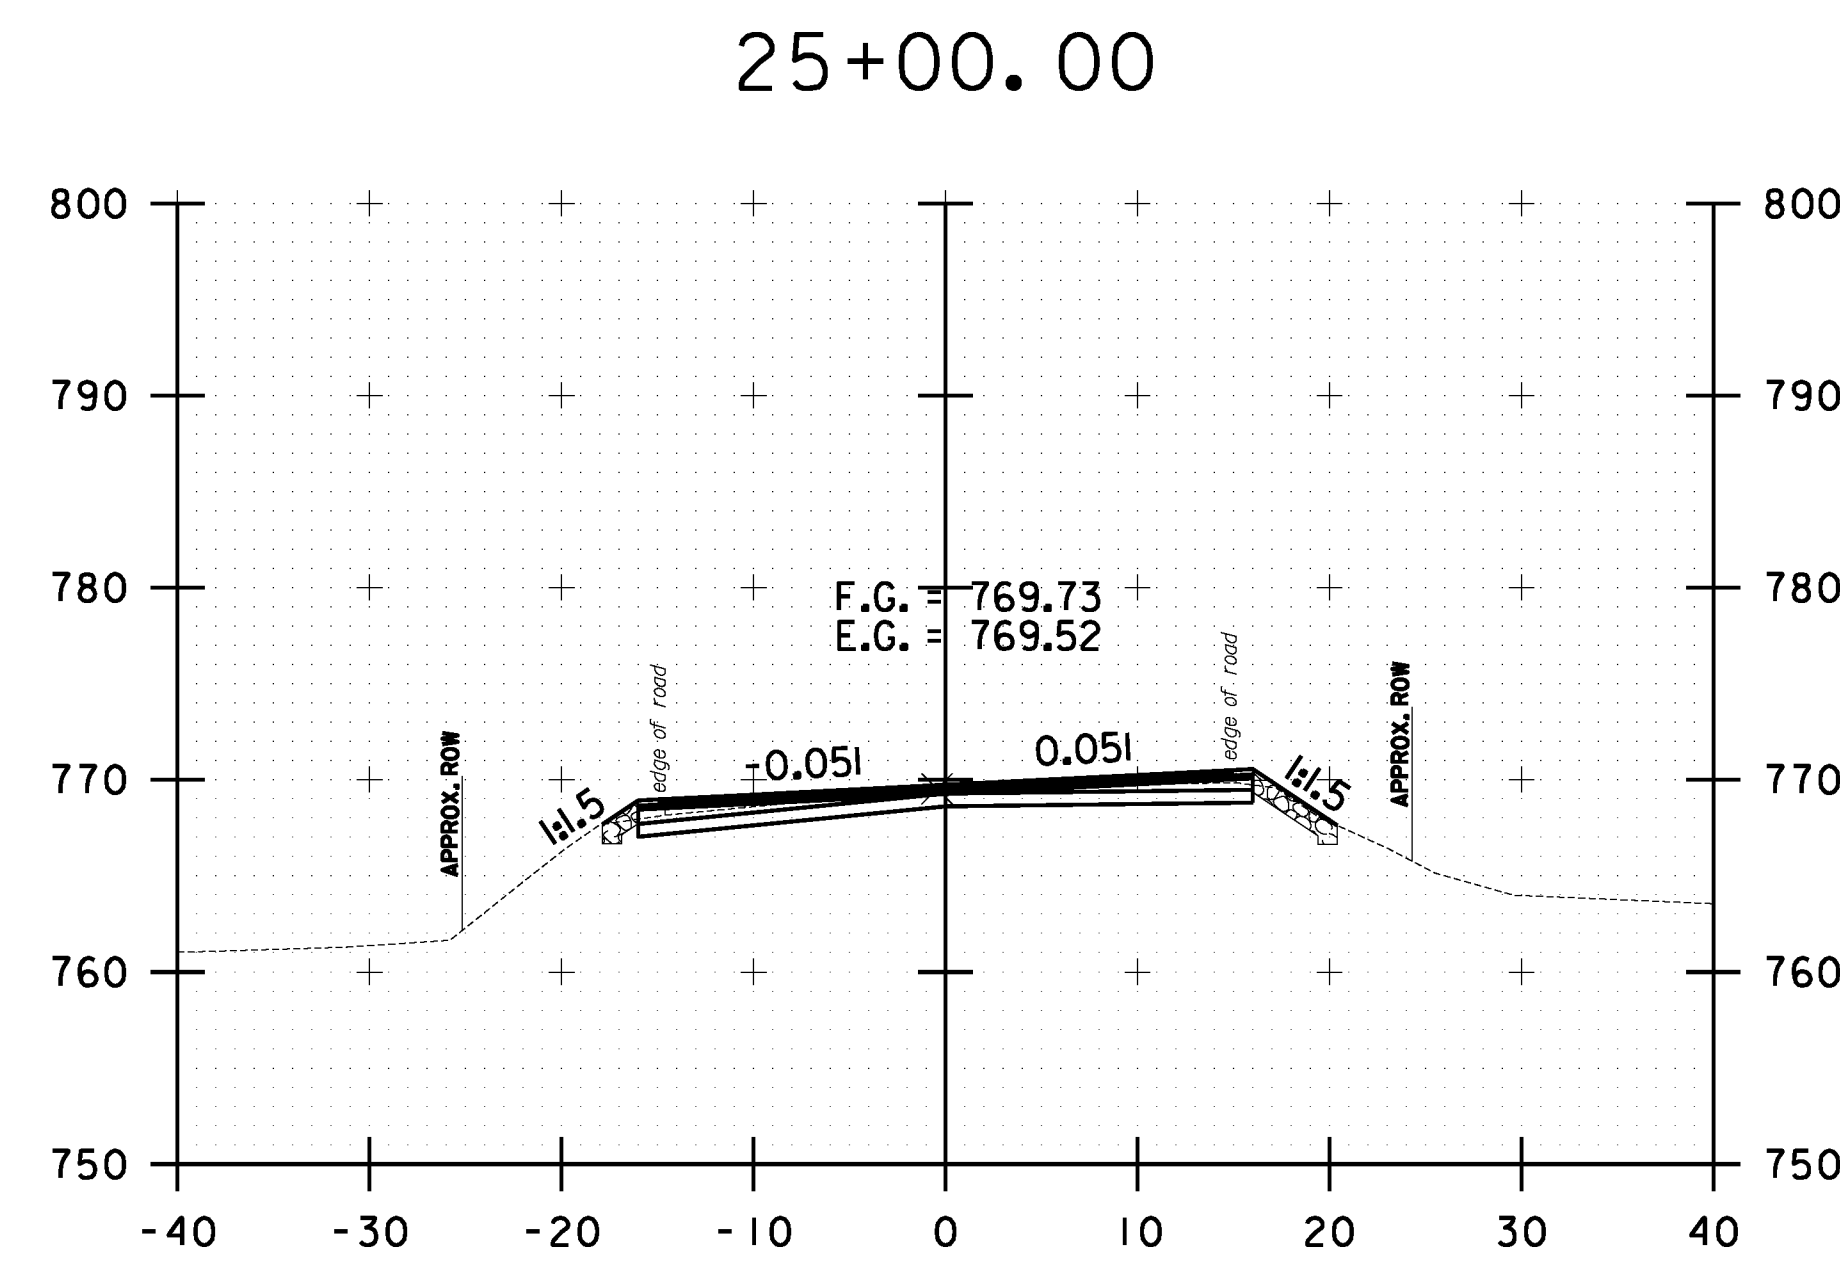
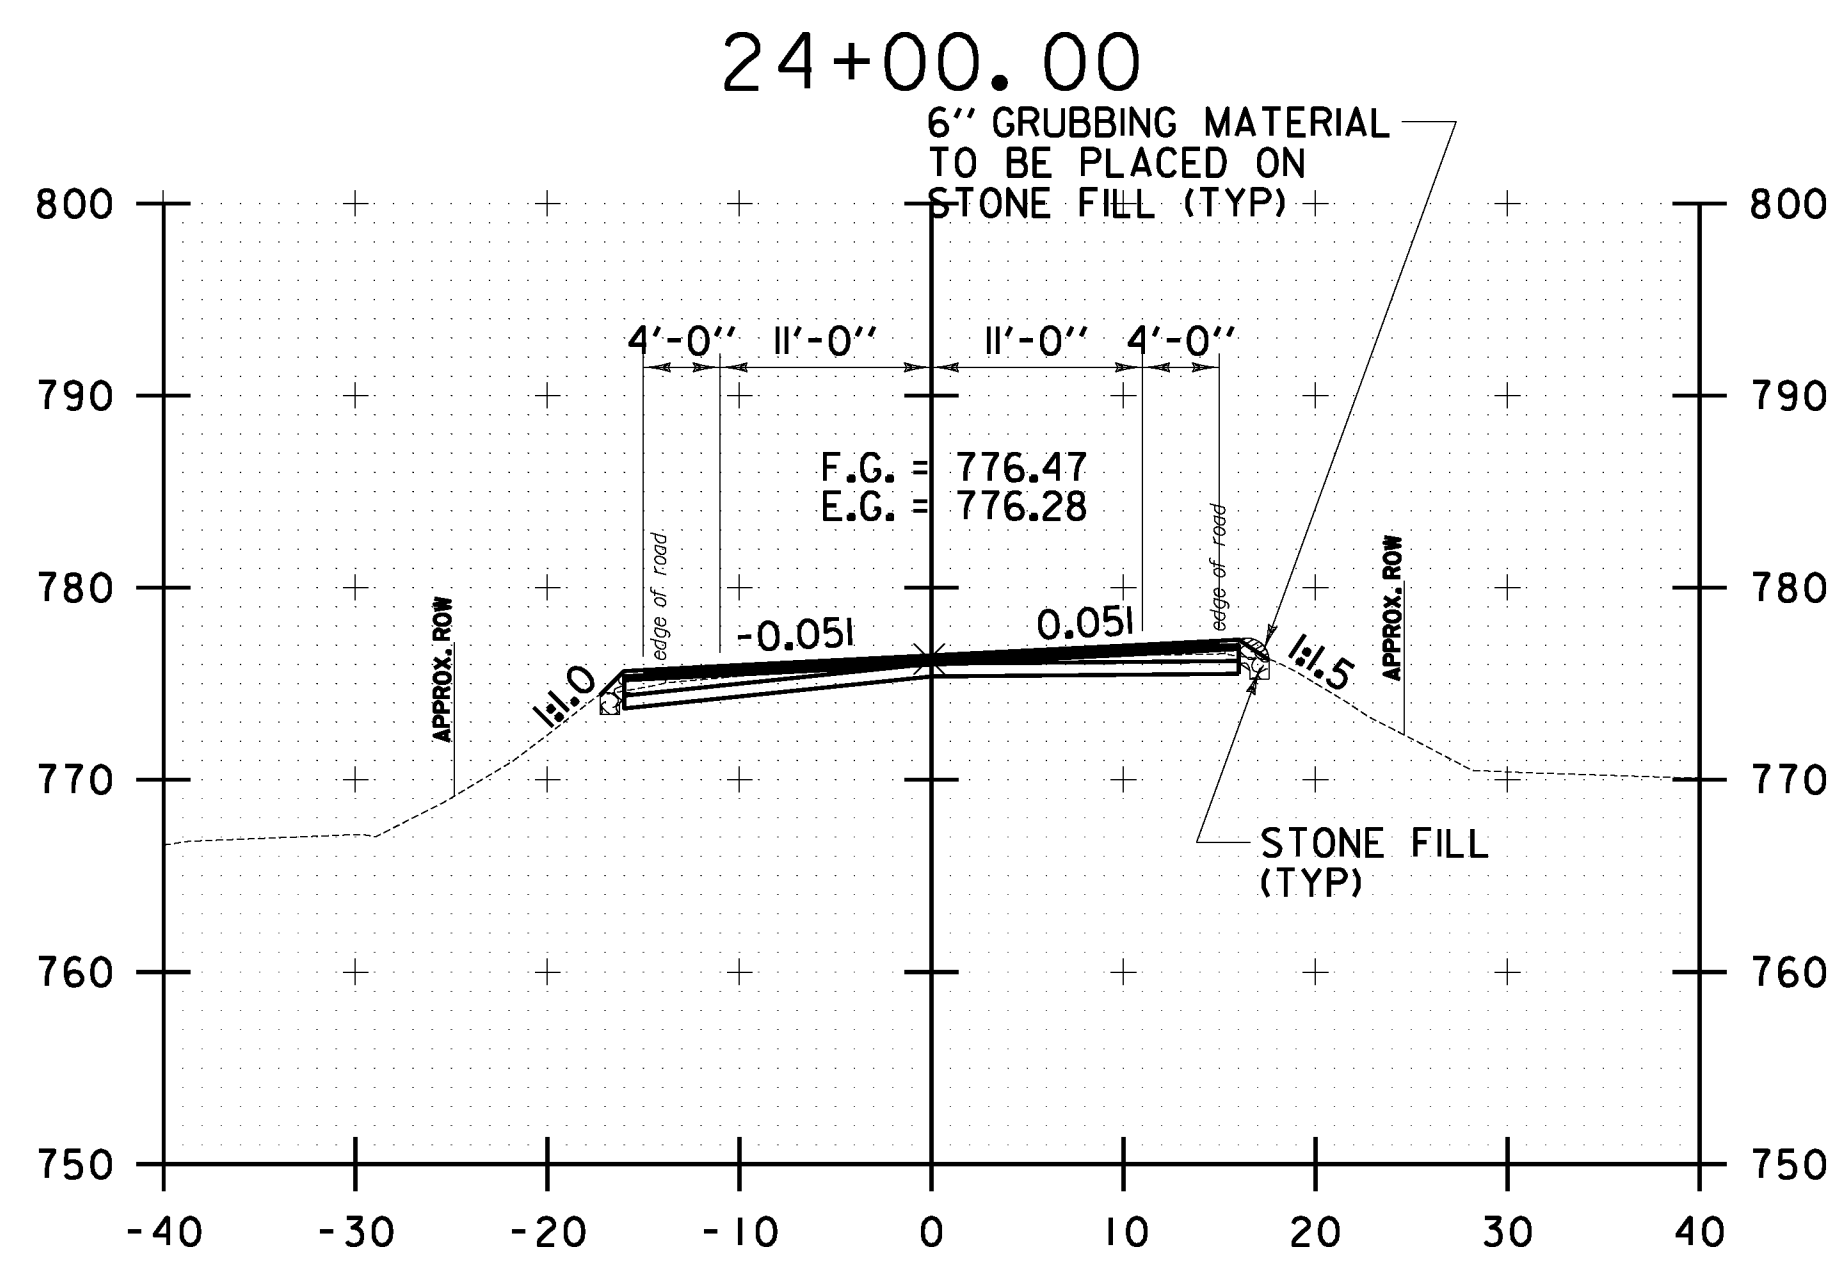
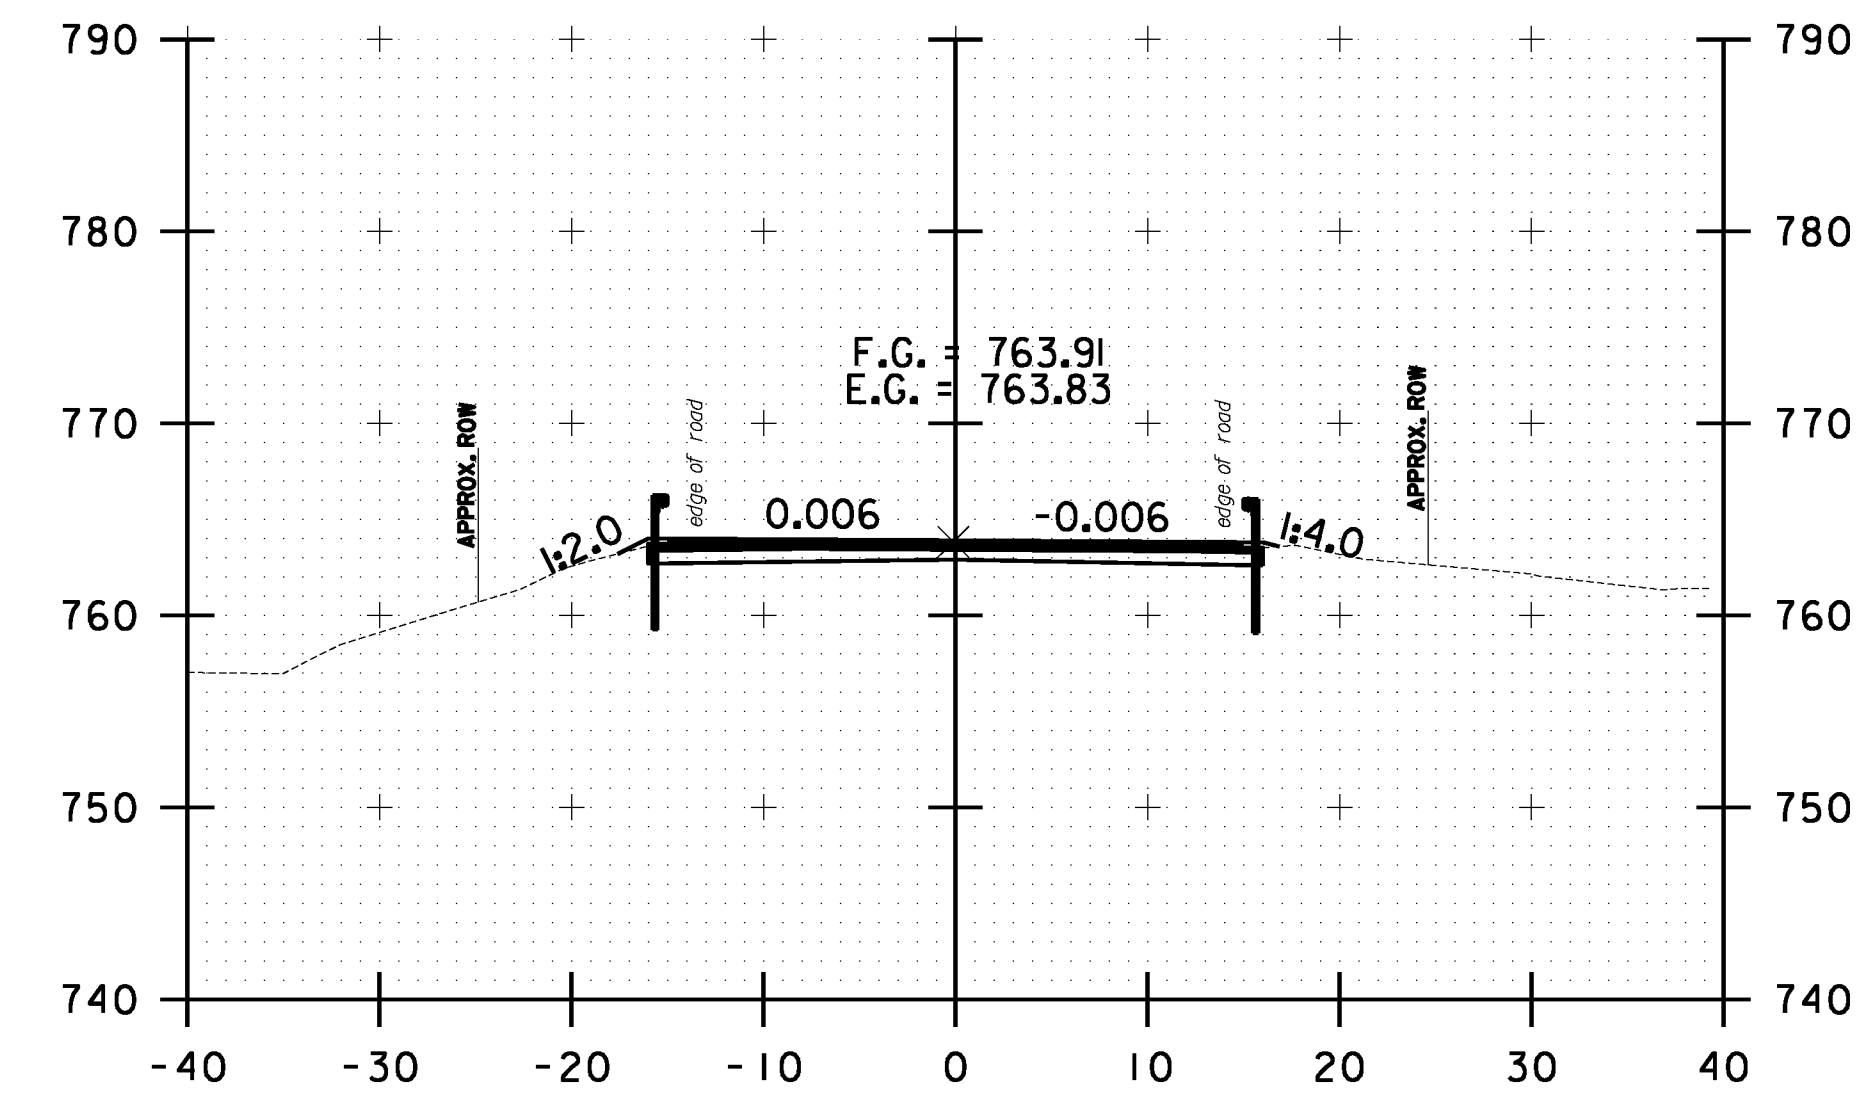
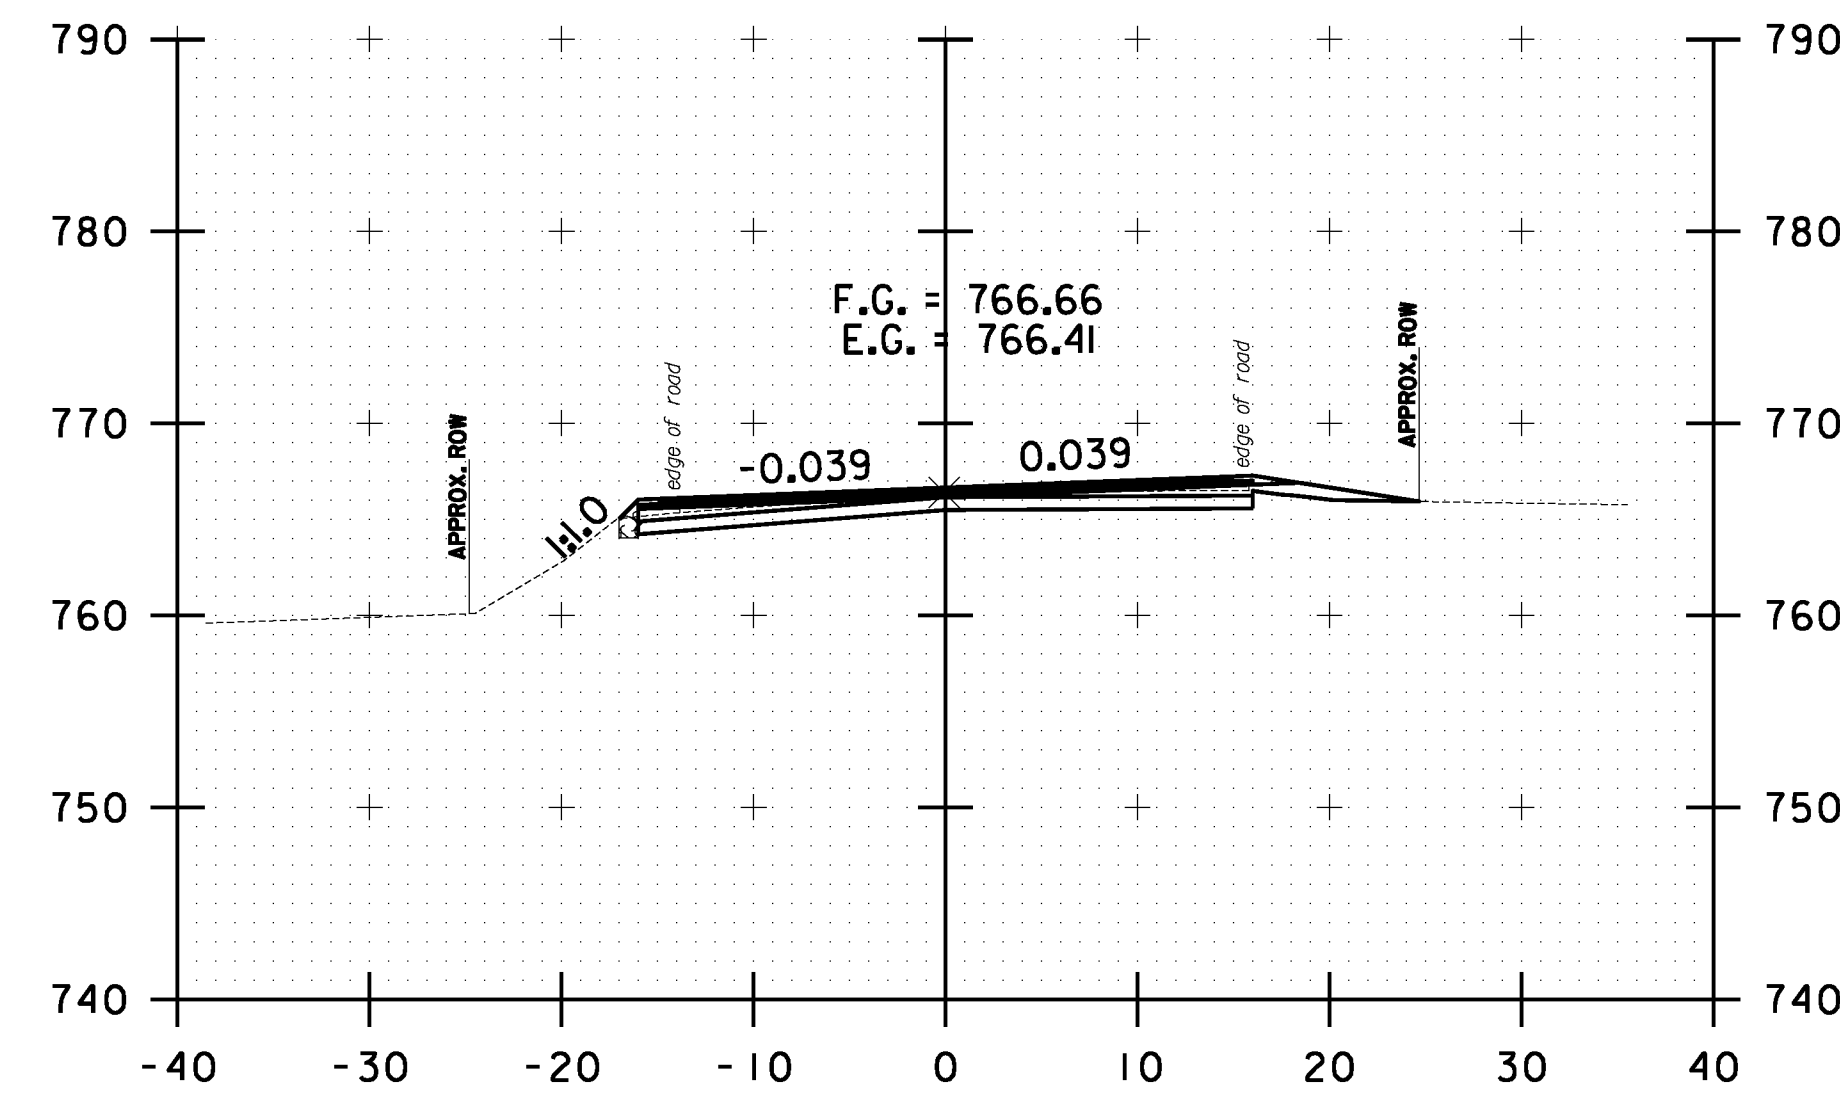


FILE NAME: U:\1762\CA00\MST\STP\_2506\p05b048.Conv.east.Plan.dgn  
 DATE/TIME: 12/20/2012  
 USER: 4866

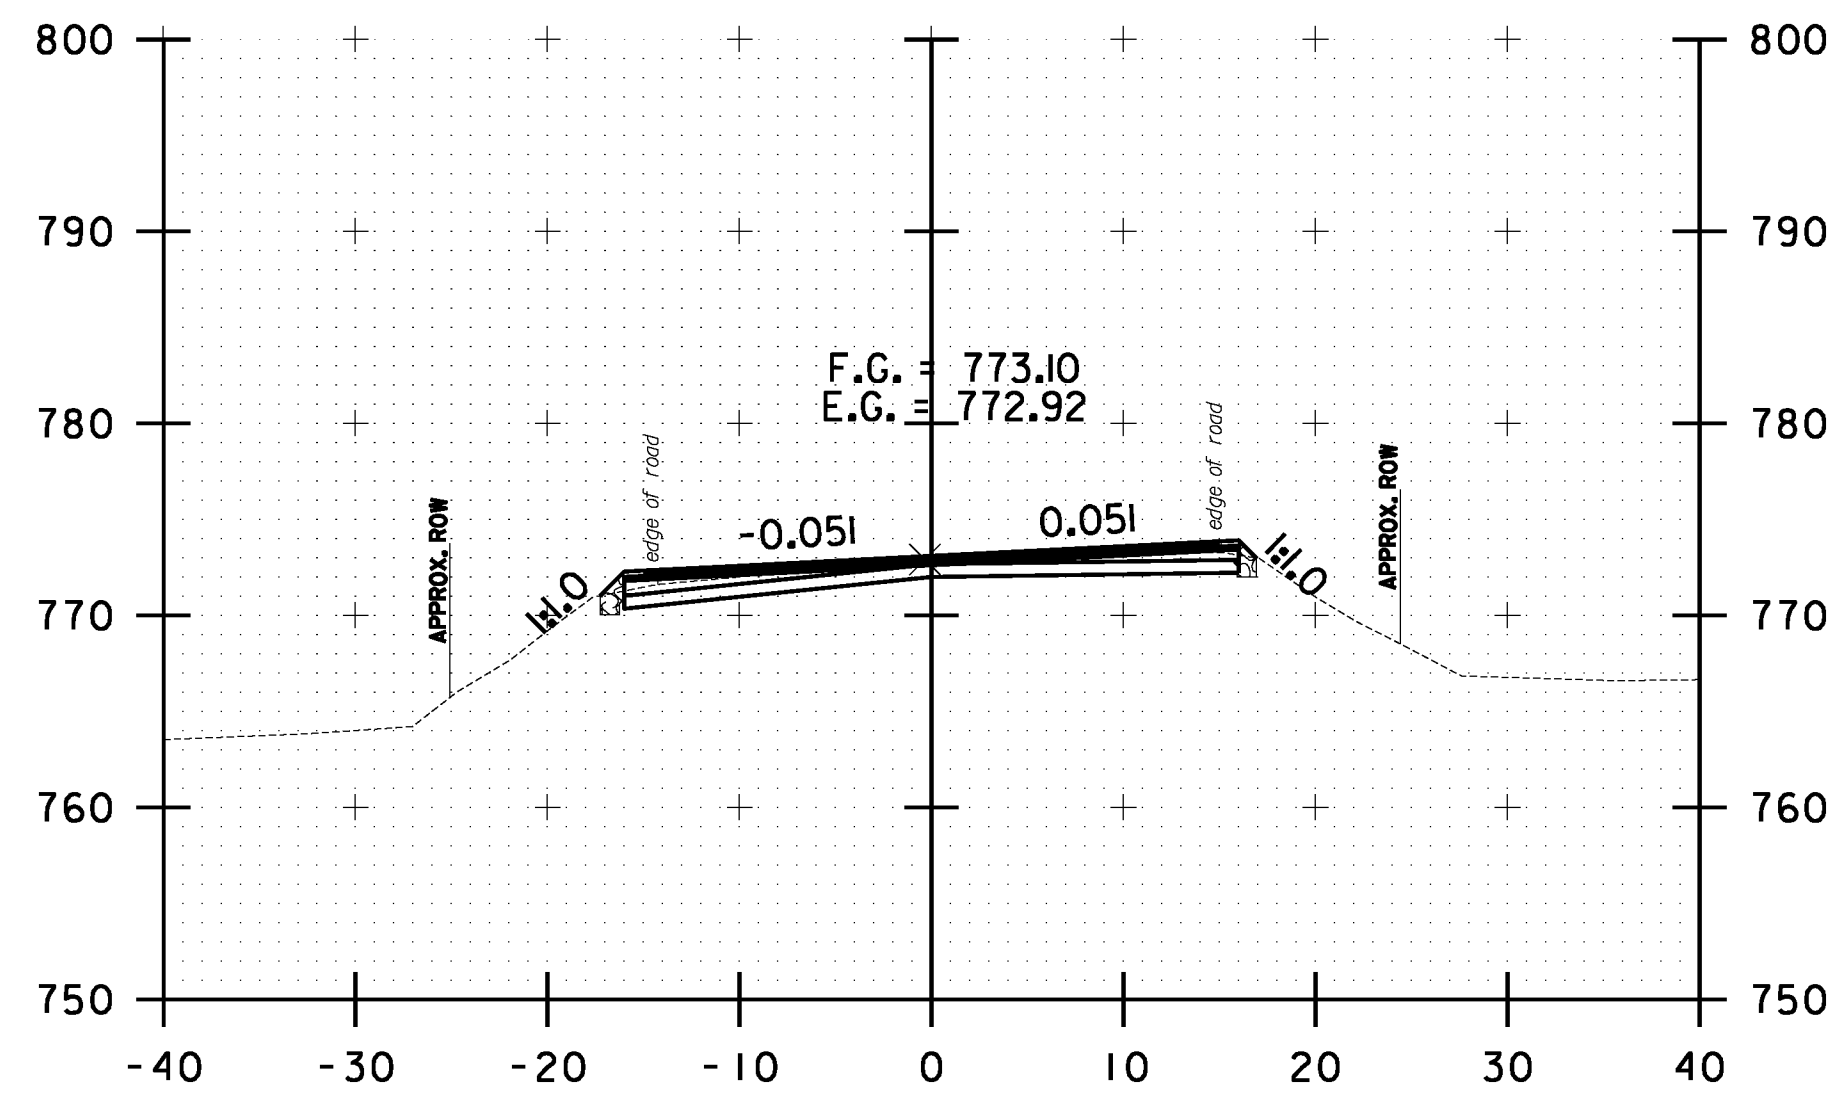

24+00.00


25+00.00

26+00.00

23+50.00

24+50.00

25+50.00

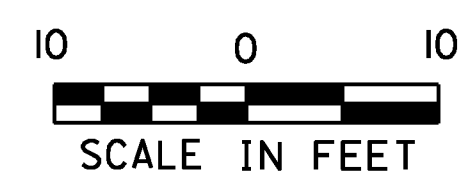

**WAITSFIELD  
 CROSS SECTION  
 SHEET #8**

PROJECT NAME: WARREN-WAITSFIELD	PLOT DATE: 12/20/2012
PROJECT NUMBER: STP 2506(1)	DRAWN BY: W.G.P.
FILE NAME: p05b048.dgn	CHECKED BY: D.E.G.
PROJECT LEADER: D.E.G.	SHEET 264 OF 310
DESIGNED BY: M.J.M.	
IPARM FILE: p05b048xsl01.l	