




FILE NAME: U:\1762\CA00\MSTN\STP_2506\p05b048.Convect Plans.dgn
 DATE/TIME: 12/20/2012
 USER: 4866

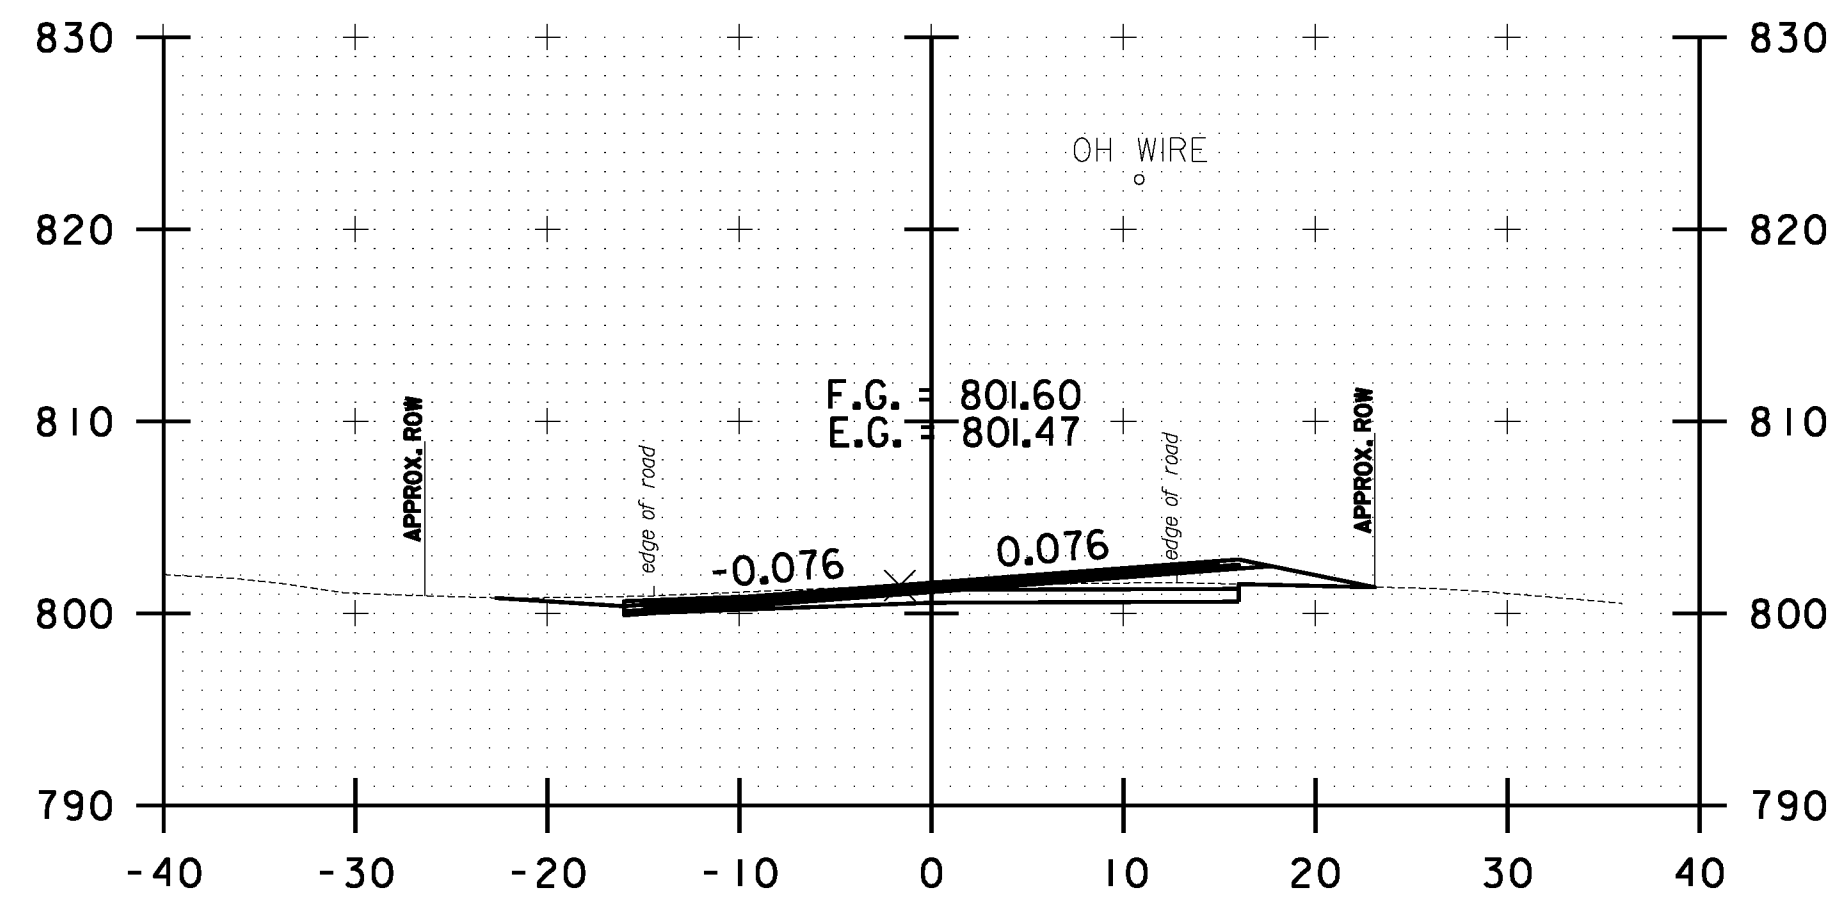


45+50.00

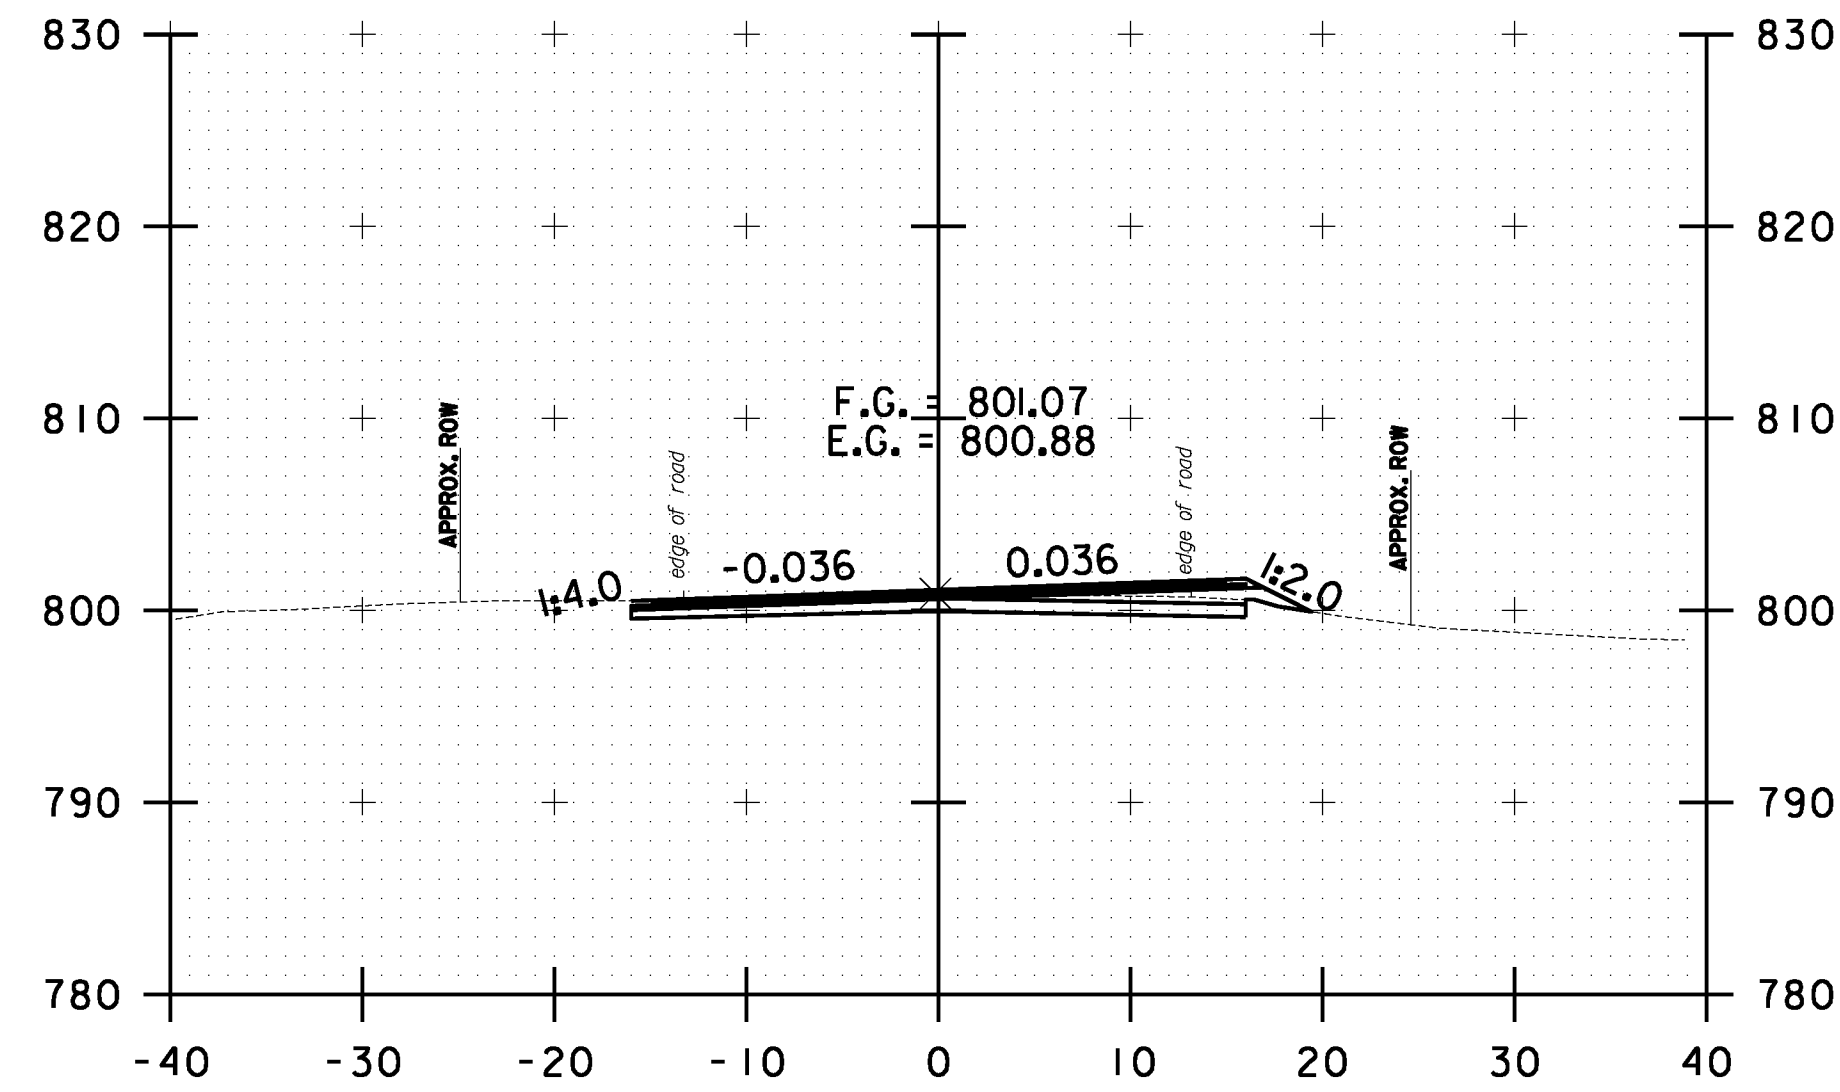


46+50.00

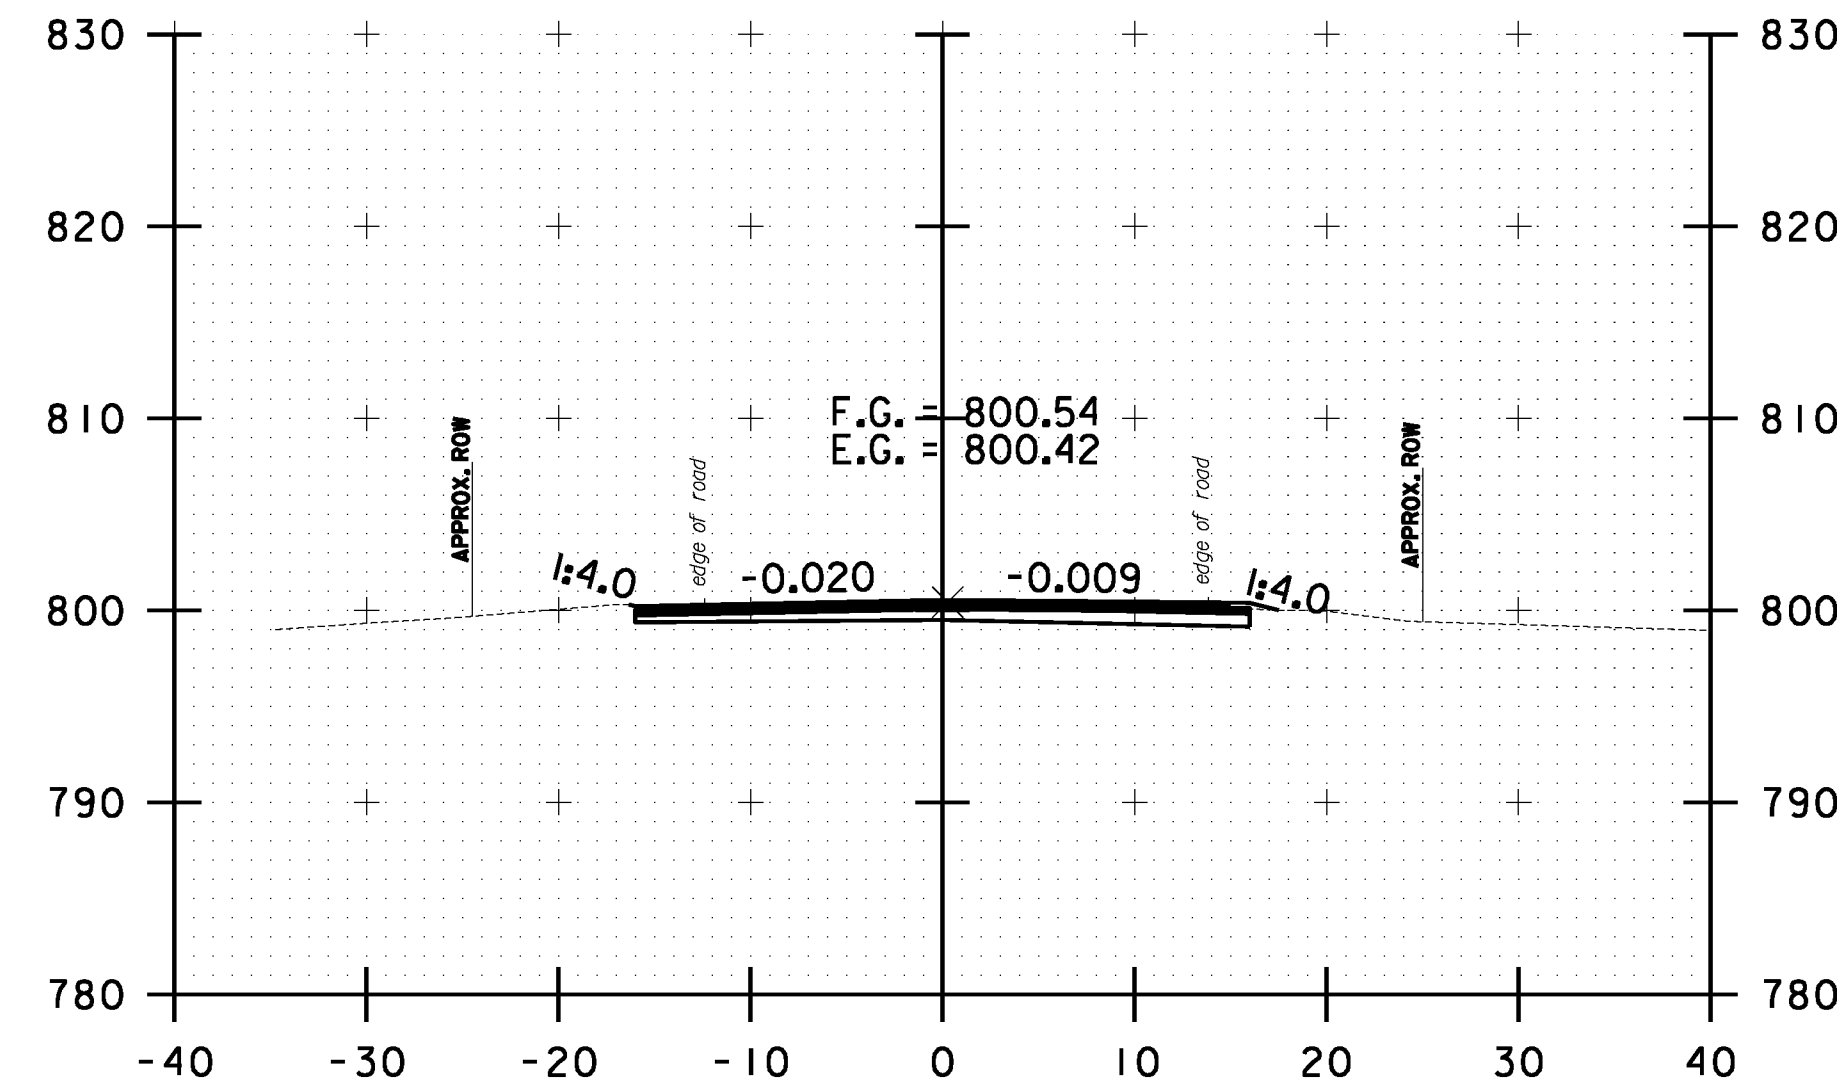


47+50.00

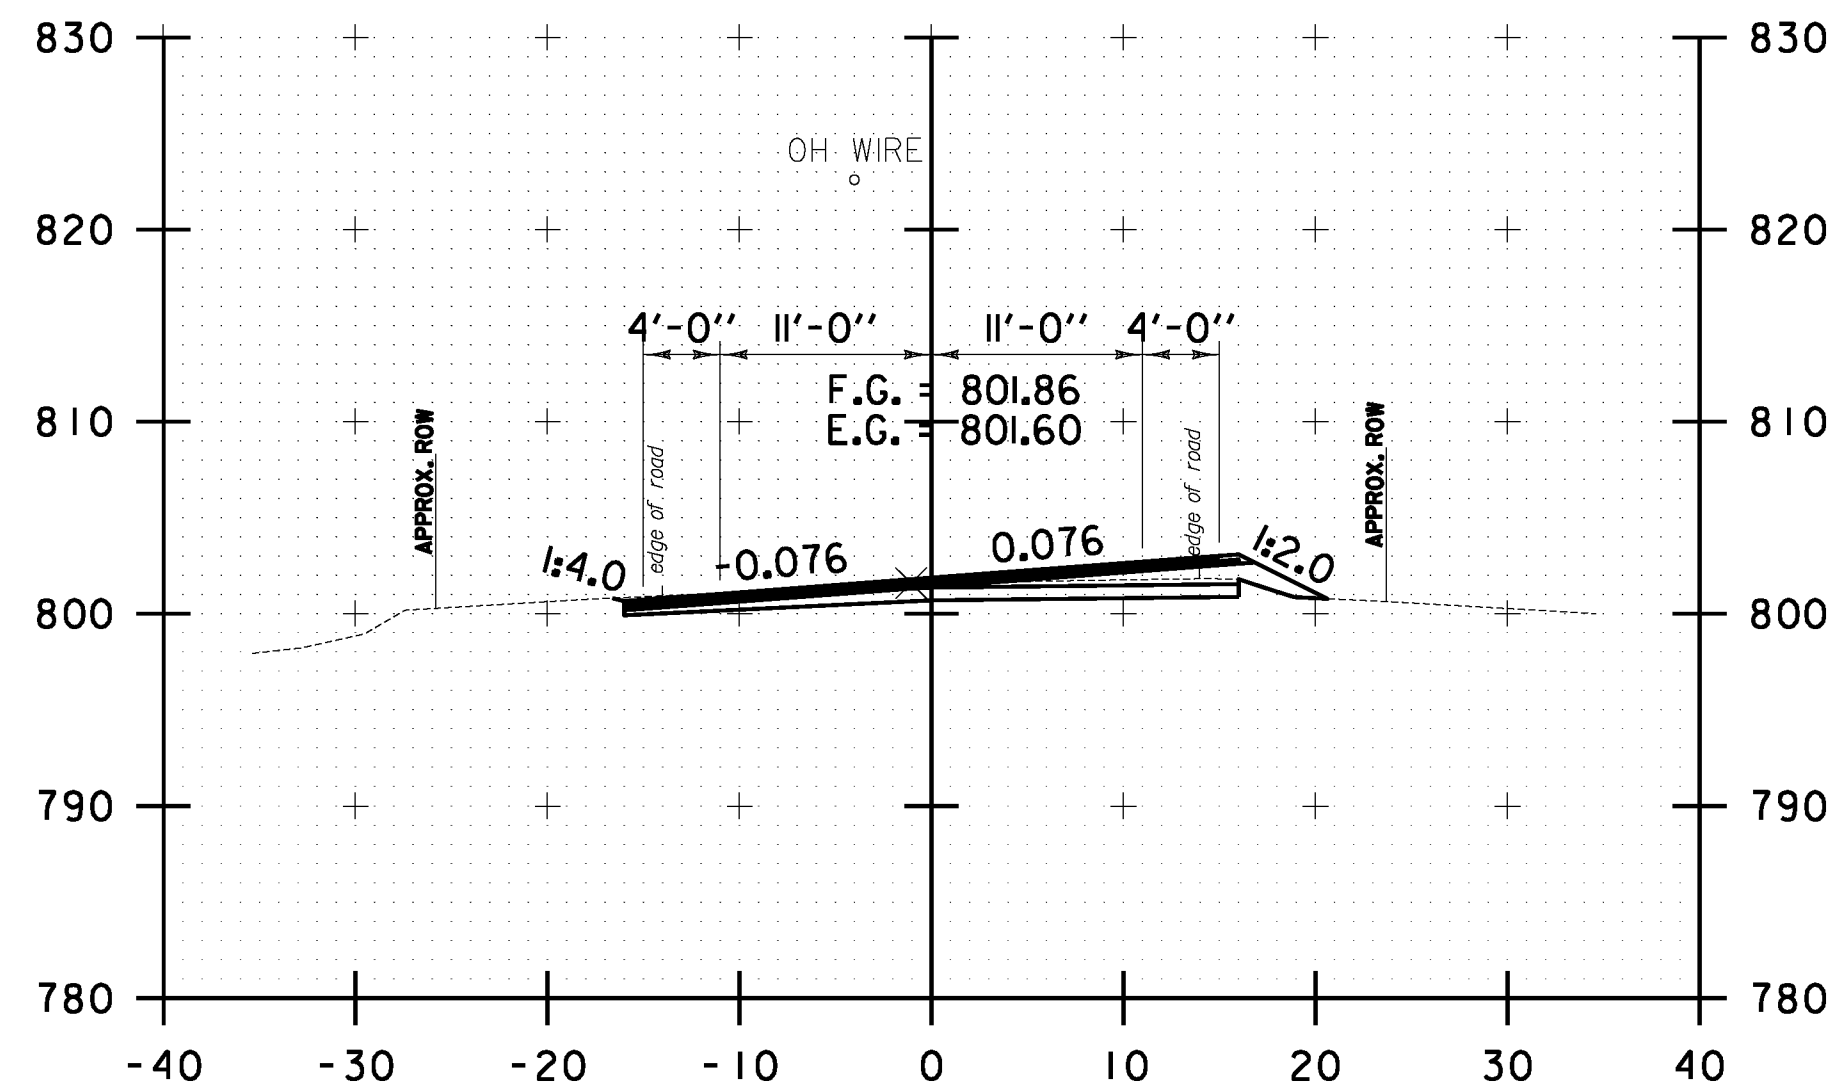

45+00.00

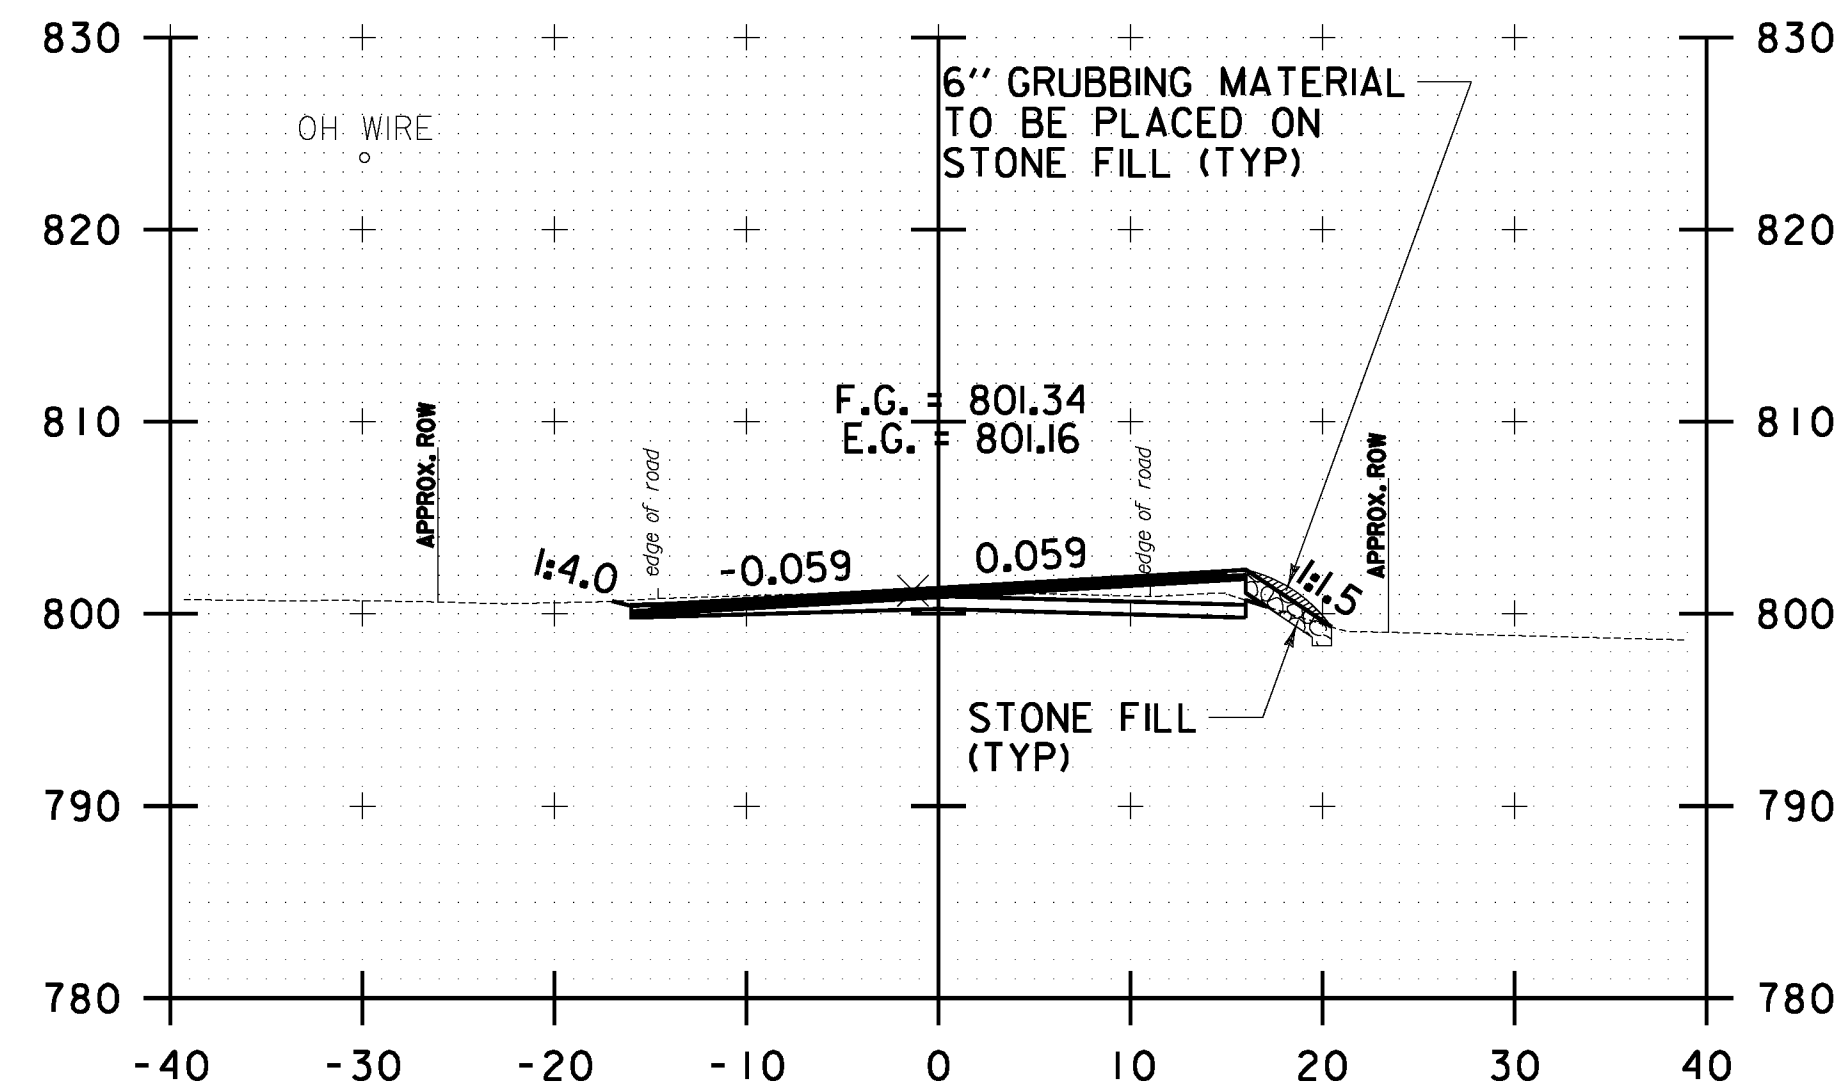

46+00.00

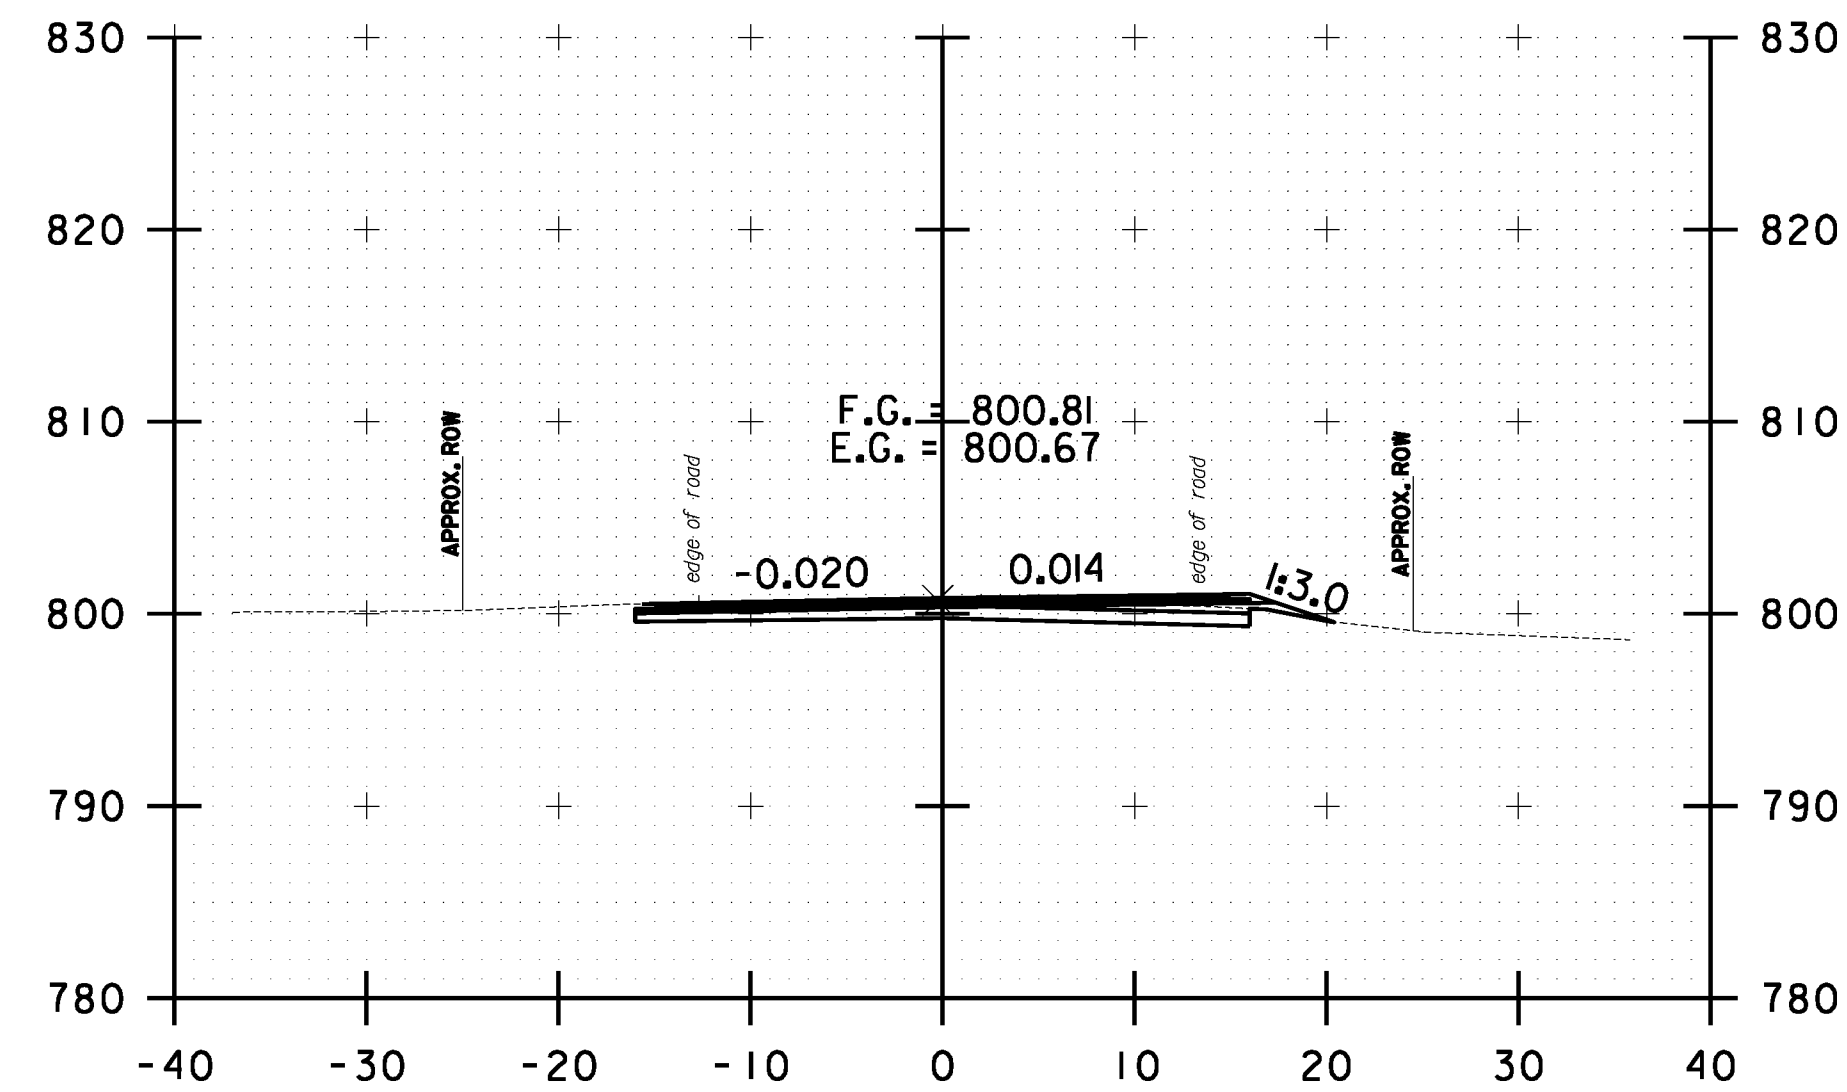

47+00.00



**WAITSFIELD
 CROSS SECTION
 SHEET #15**

PROJECT NAME: WARREN-WAITSFIELD

PROJECT NUMBER: STP 2506(1)

FILE NAME: p05b048.dgn

PROJECT LEADER: D.E.G.

DESIGNED BY: M.J.M.

IPARM FILE: p05b048xsl08.l

PLOT DATE: 12/20/2012

DRAWN BY: W.G.P.

CHECKED BY: D.E.G.

SHEET 271 OF 310