




FILE NAME: U:\1762\CAOD\MSTN\STP_2506\p05b048.Convect.Plan.dgn
 DATE/TIME: 12/20/2012
 USER: 4866

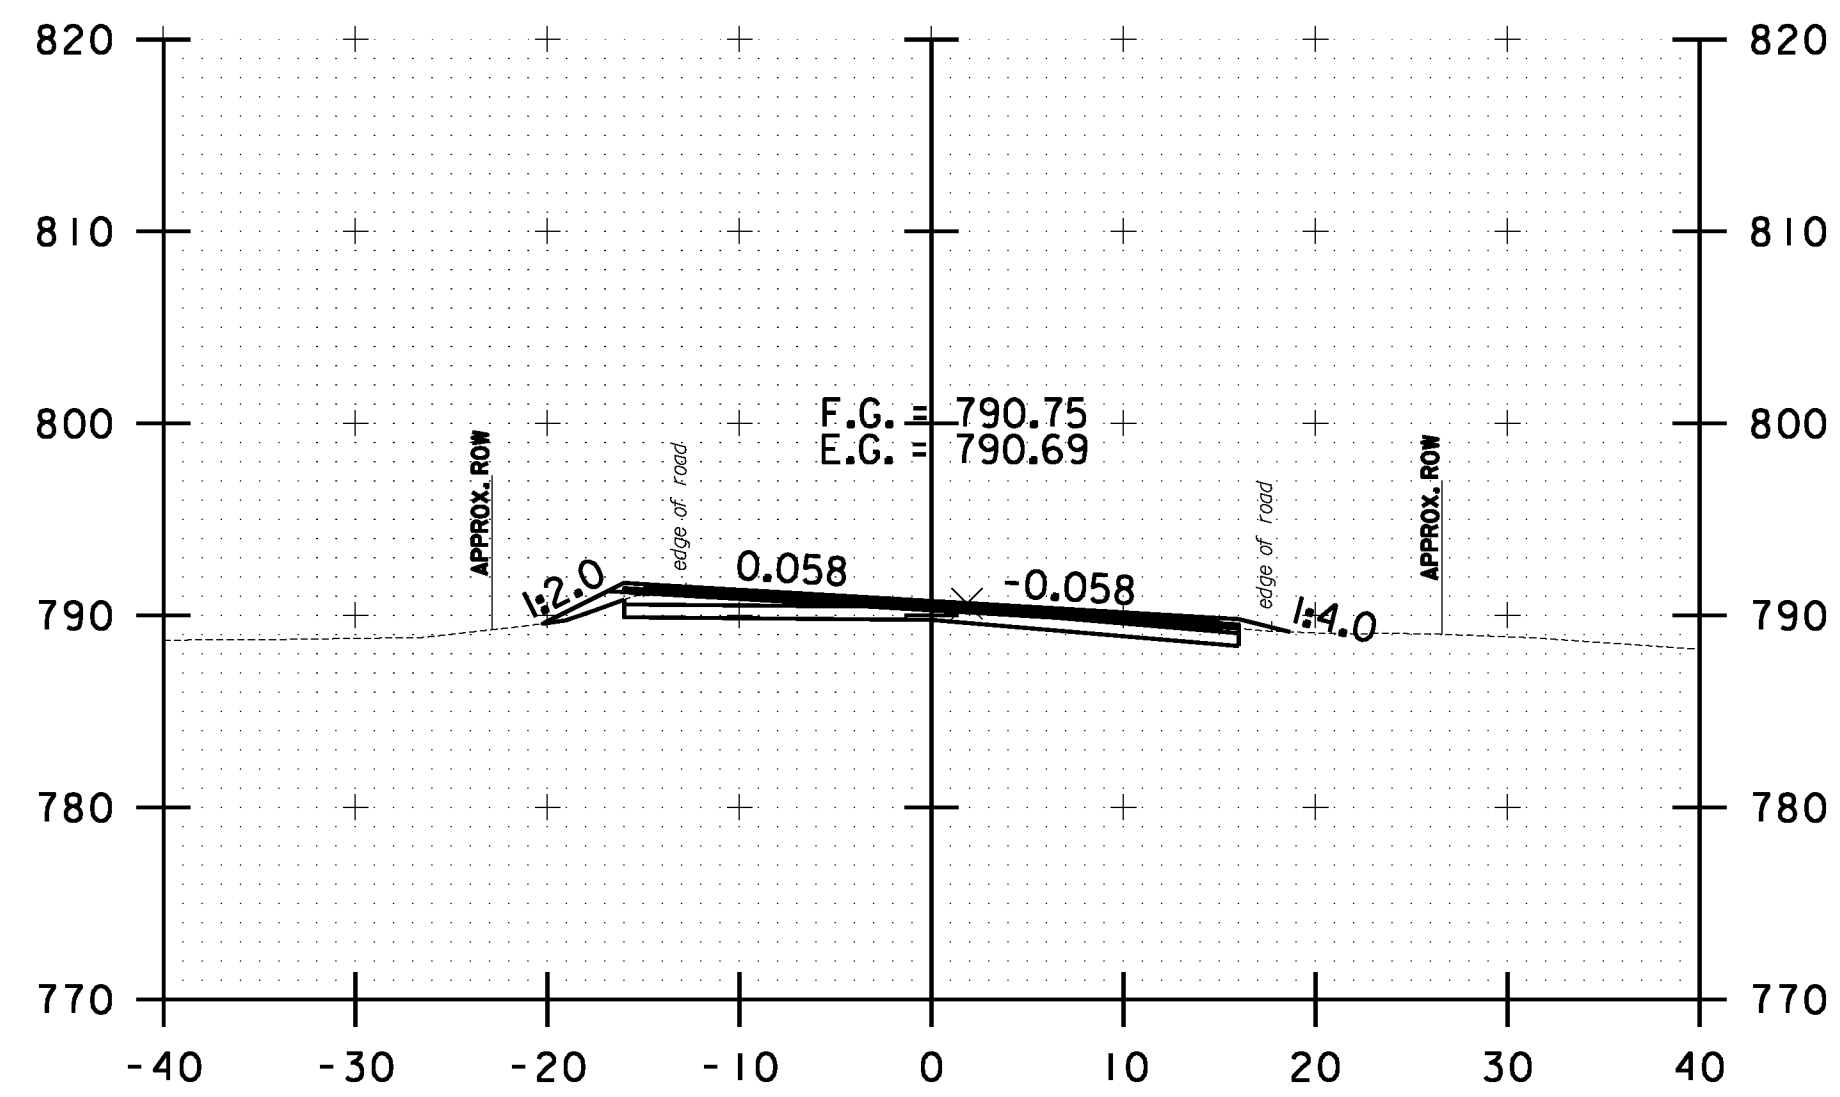


55+00.00

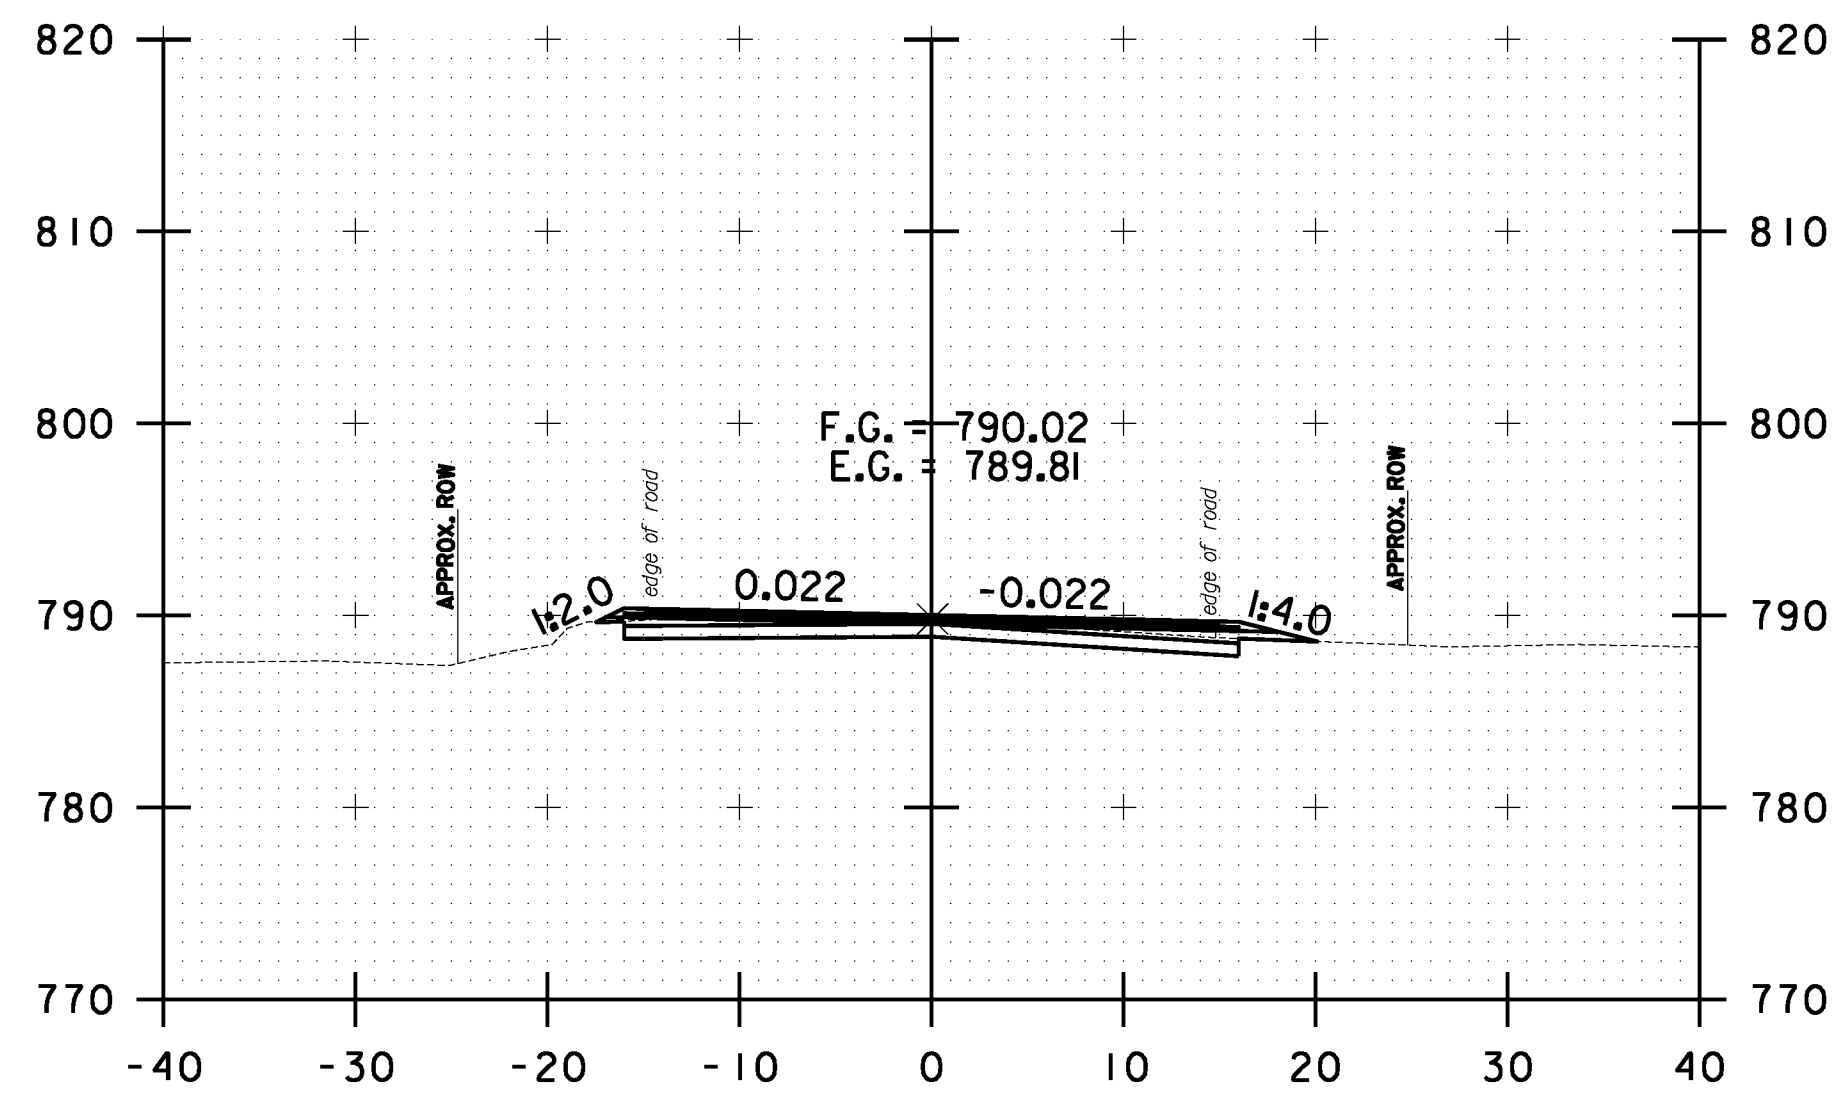


56+00.00

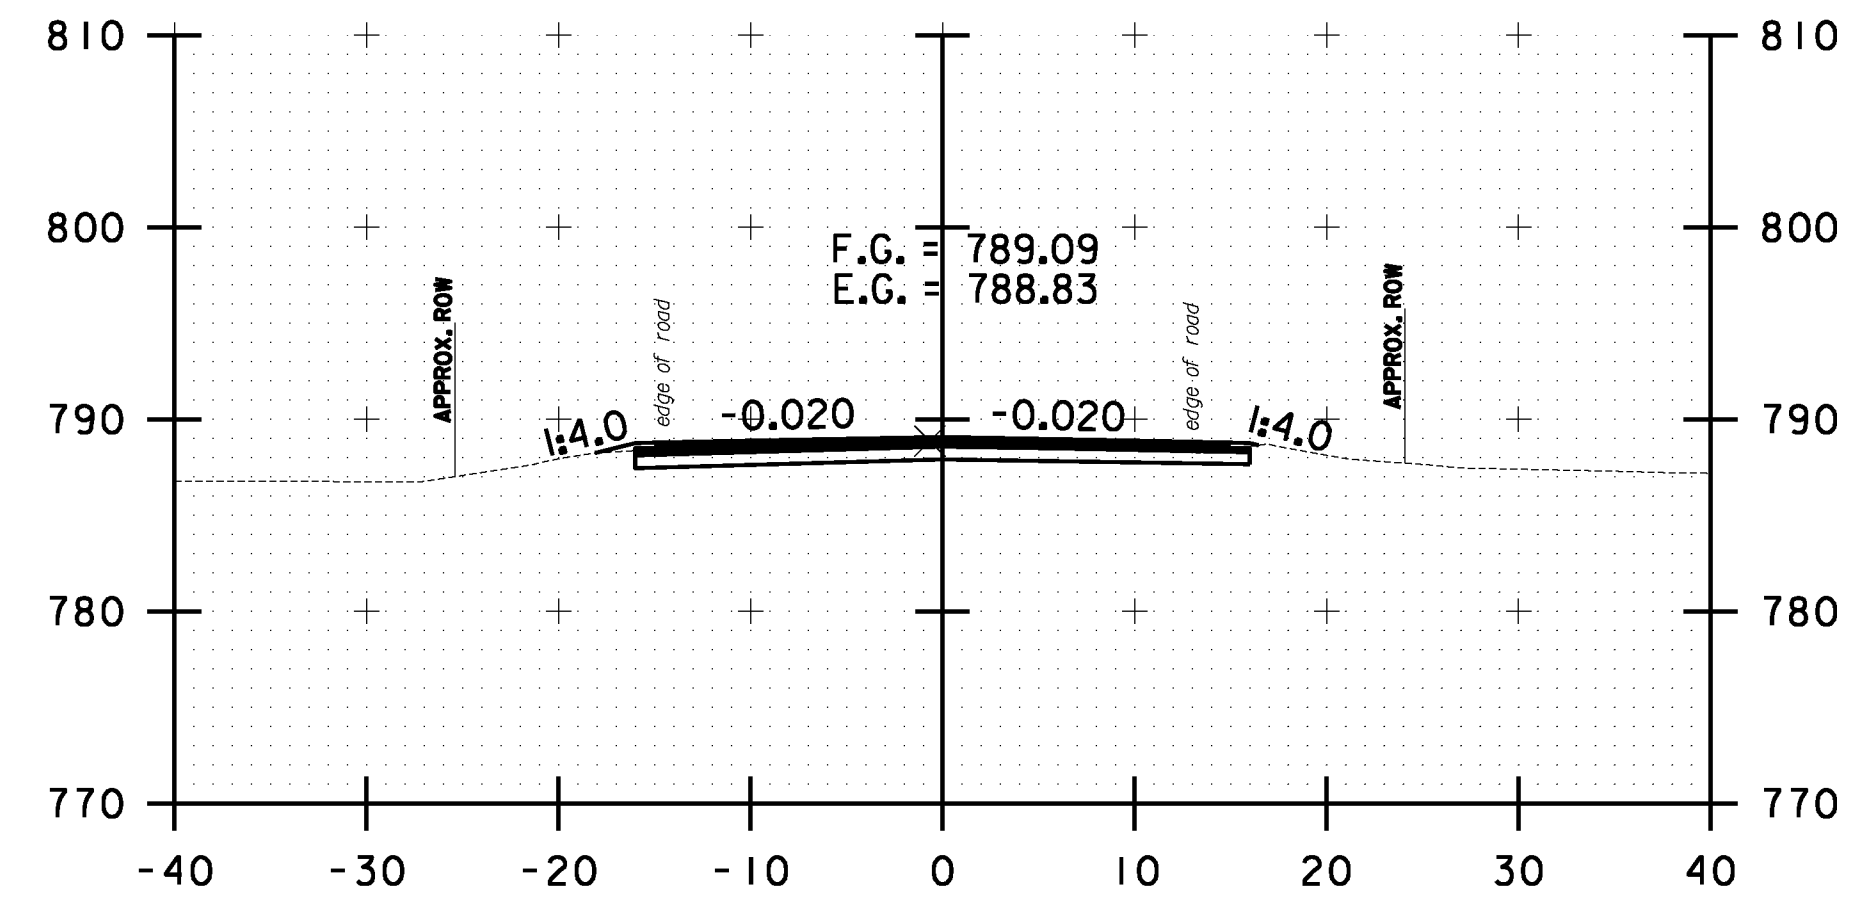


57+50.00

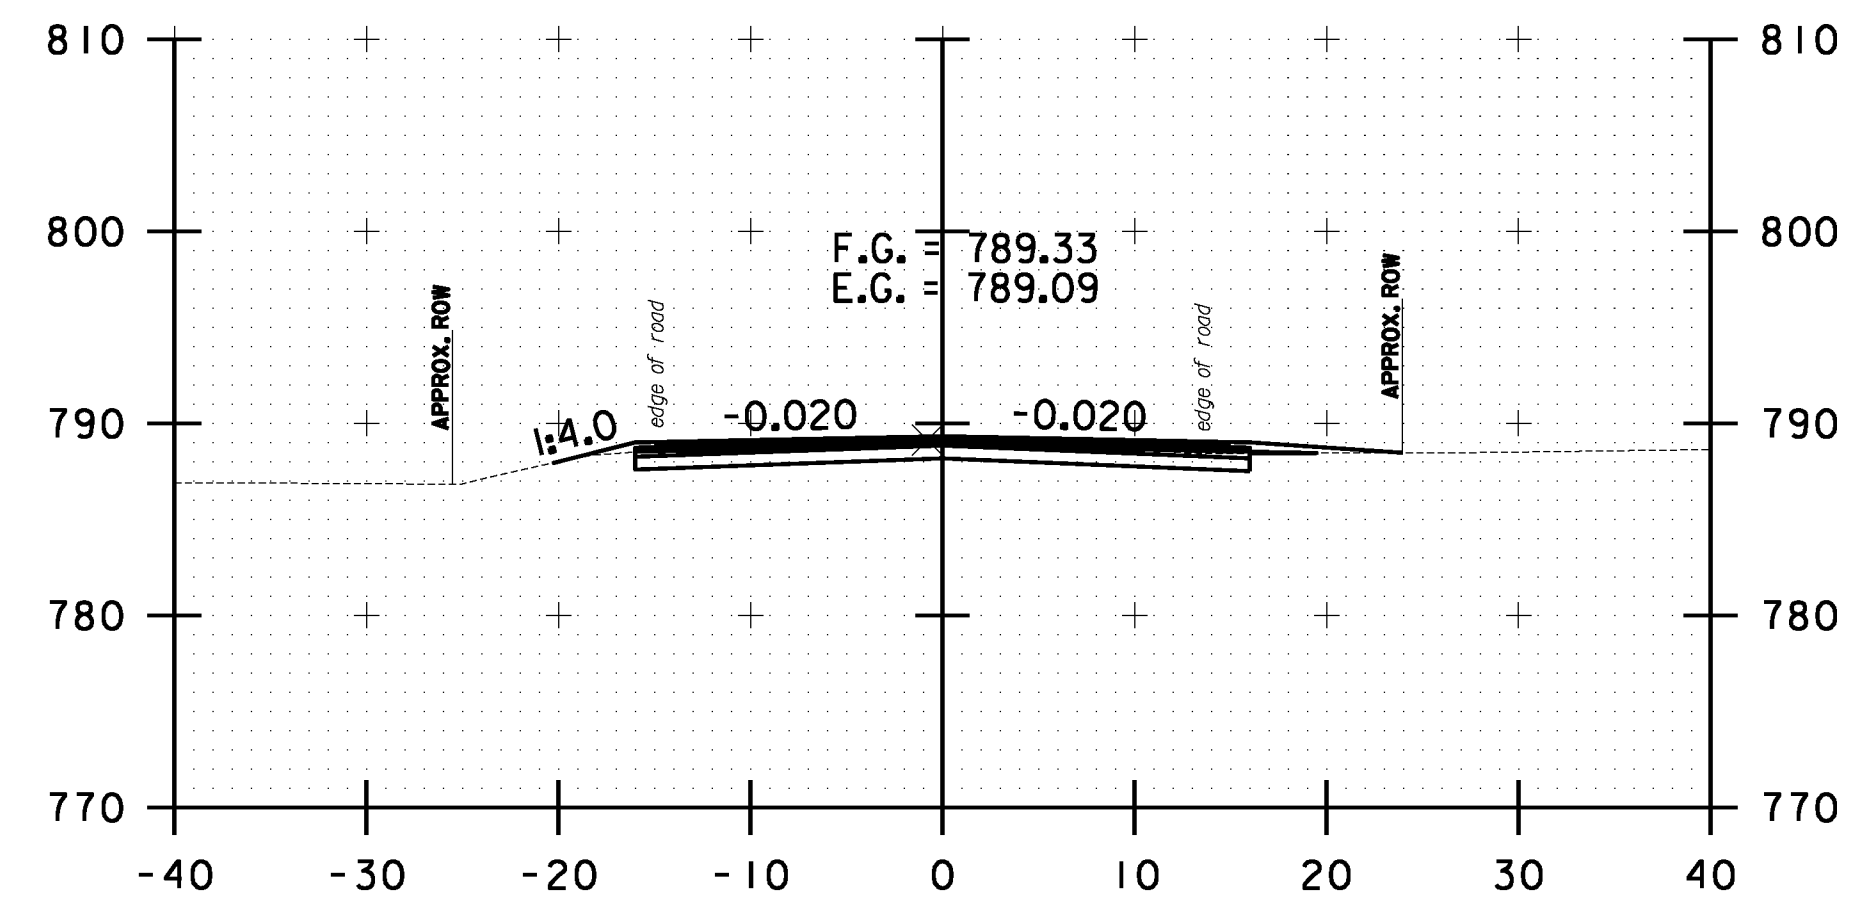


57+00.00

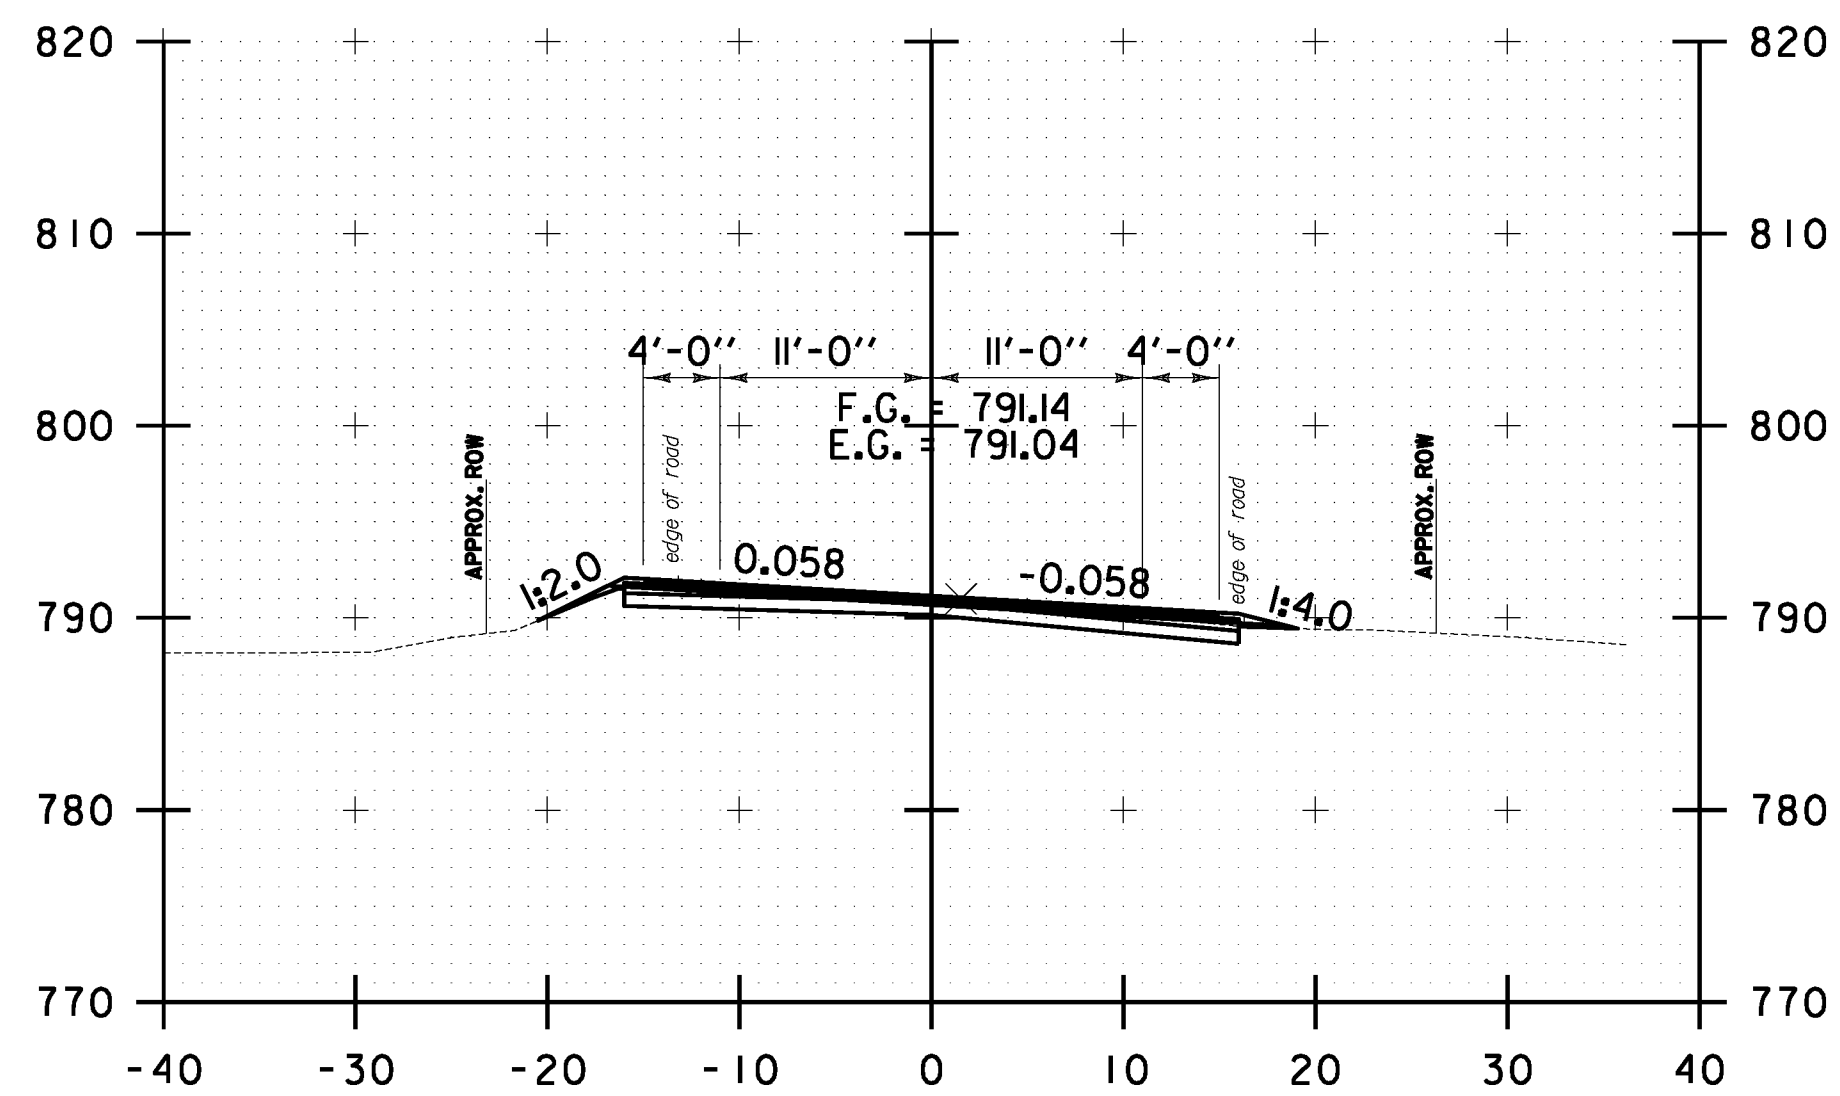


54+50.00

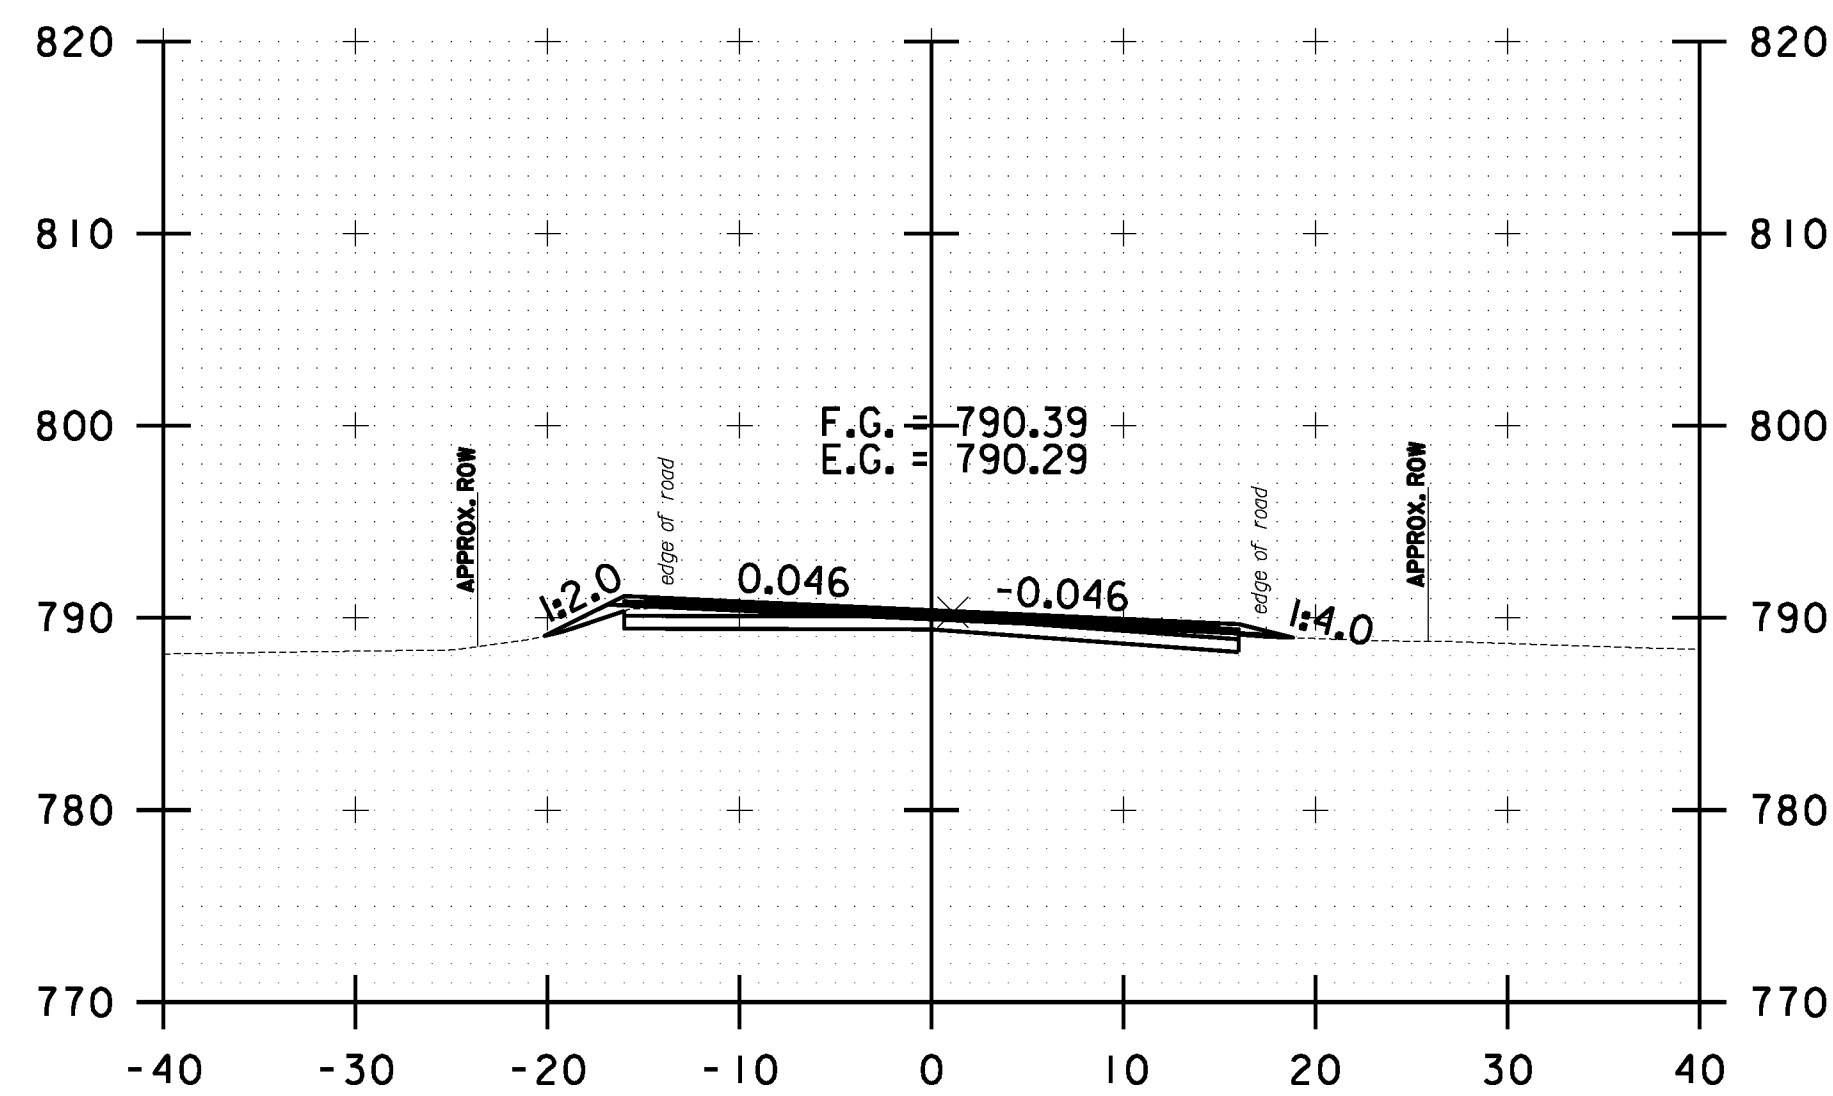

55+50.00

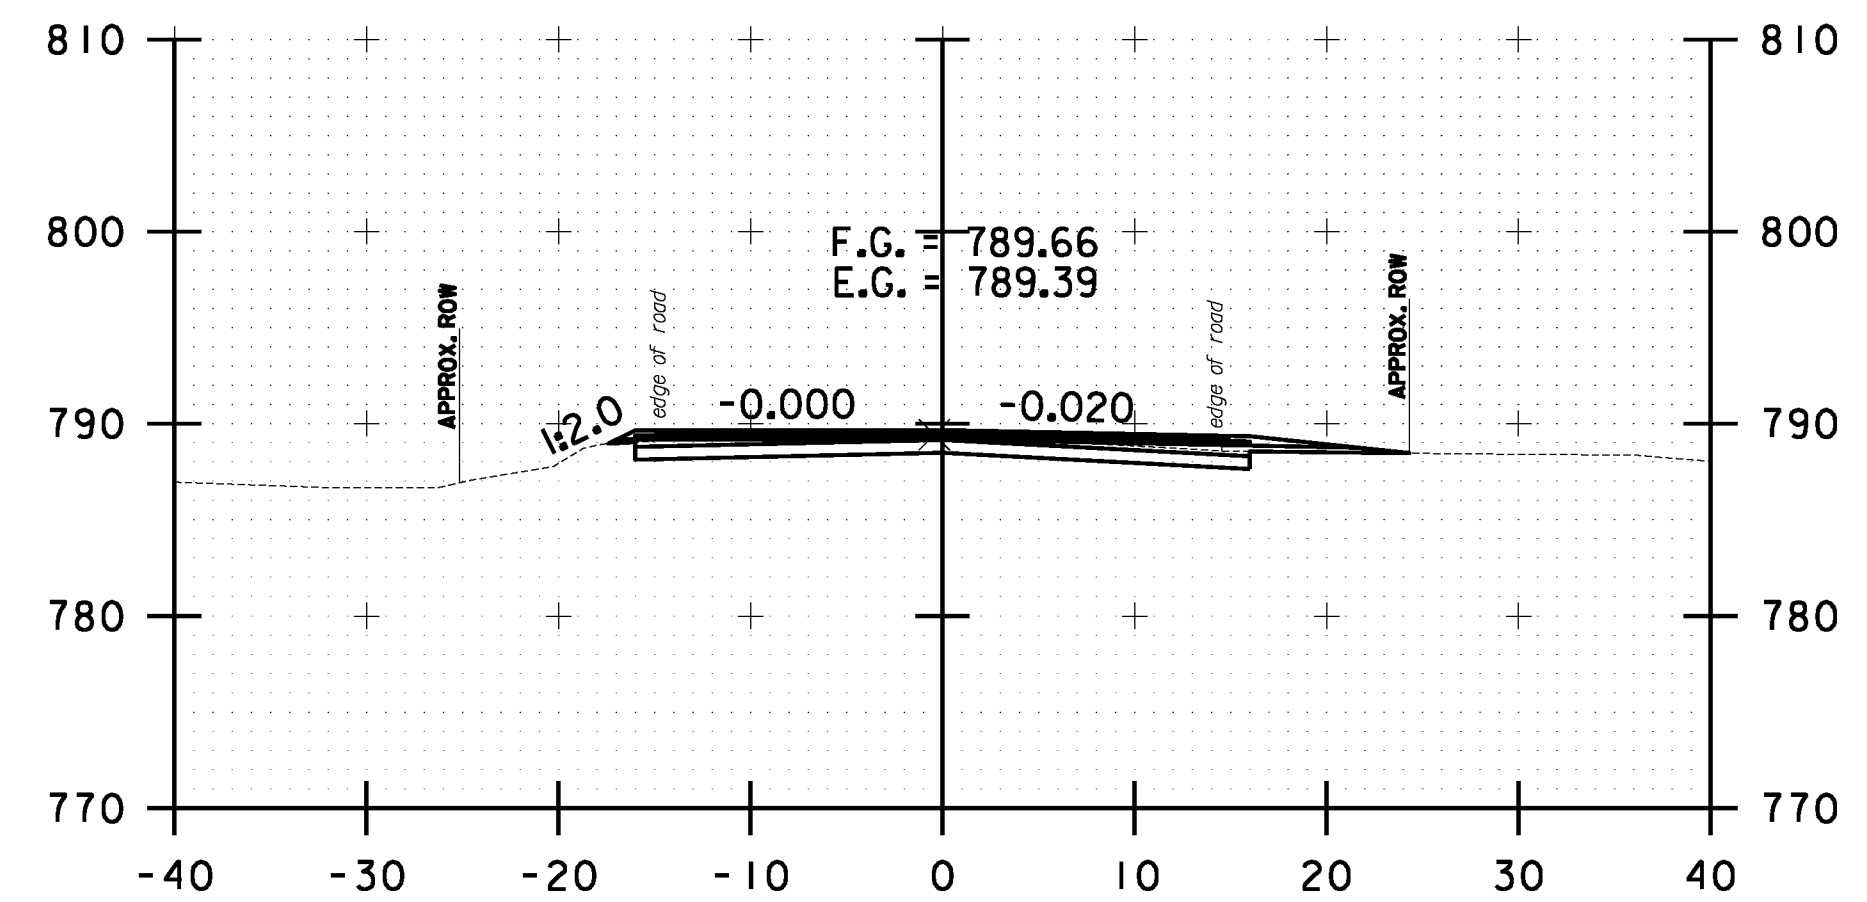

56+50.00

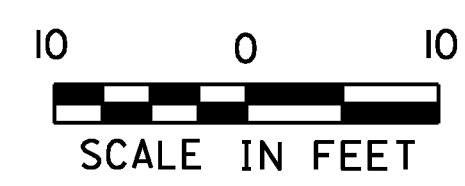

**WAITSFIELD
 CROSS SECTION
 SHEET #18**

PROJECT NAME: WARREN-WAITSFIELD

PROJECT NUMBER: STP 2506(1)

FILE NAME: p05b048.dgn

PROJECT LEADER: D.E.G.

DESIGNED BY: M.J.M.

IPARM FILE: p05b048xs11.l

PLOT DATE: 12/20/2012

DRAWN BY: W.G.P.

CHECKED BY: D.E.G.

SHEET 274 OF 310