




FILE NAME = I:\1762\CA00\MST\STP_2506\p05b048.Convect_Plan.dgn
 DATE/TIME = 12/20/2012
 USER = 4866

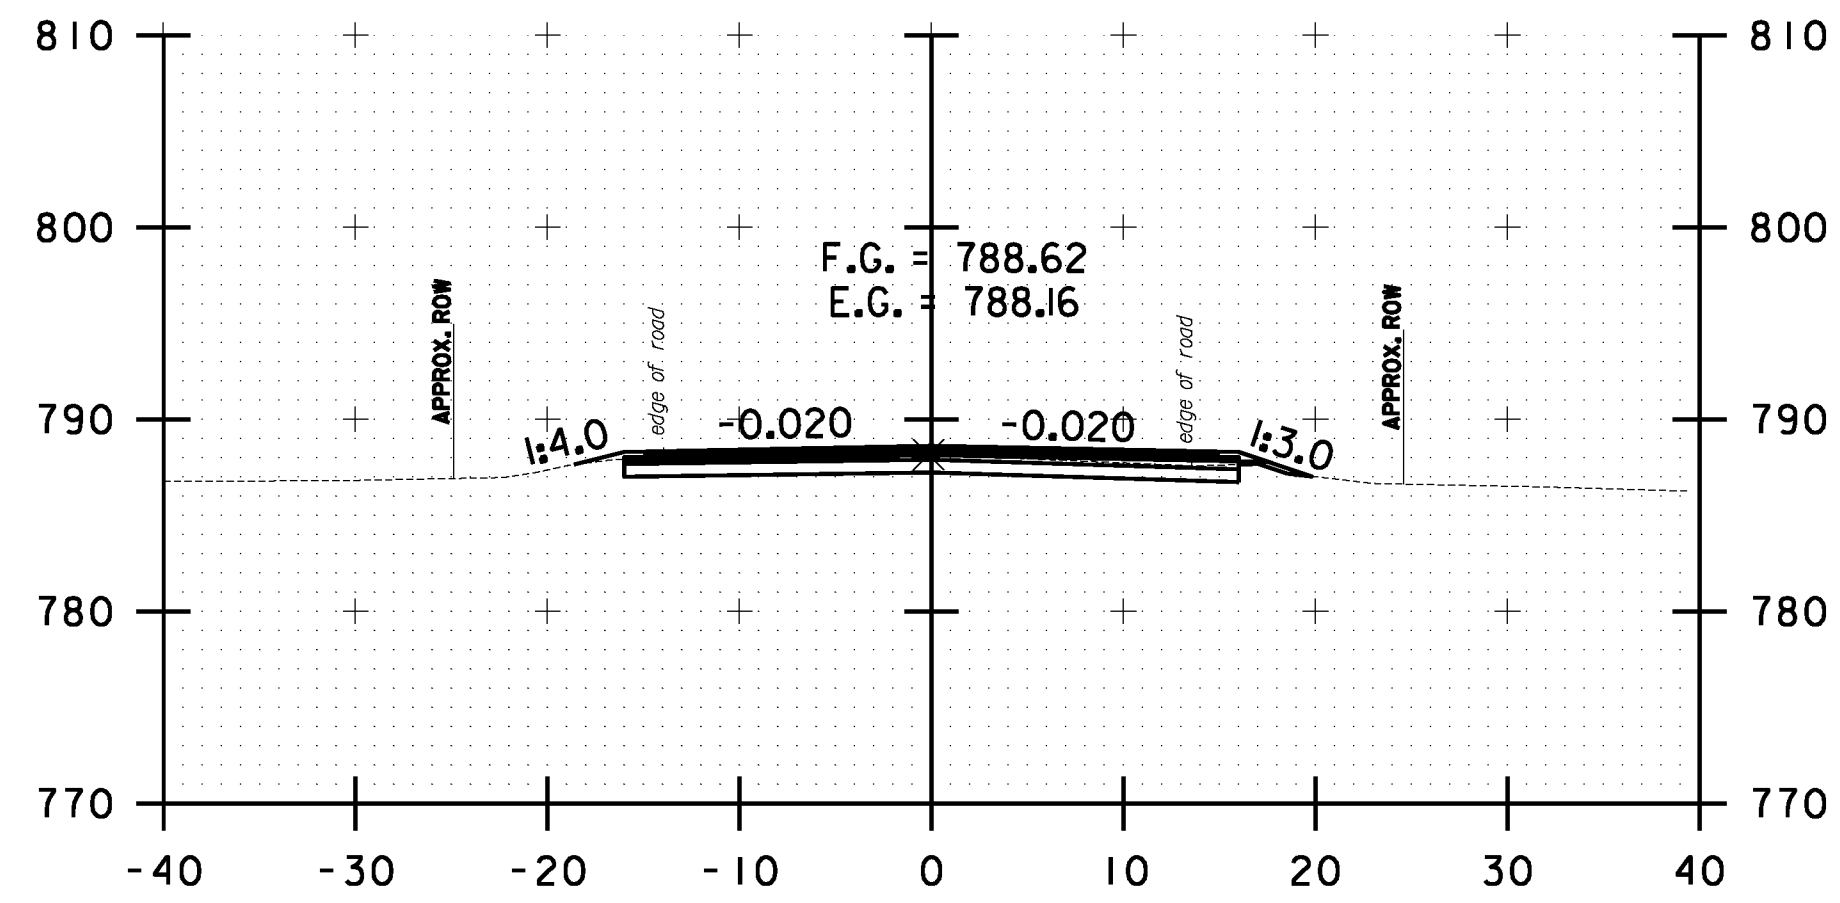


59+00.00

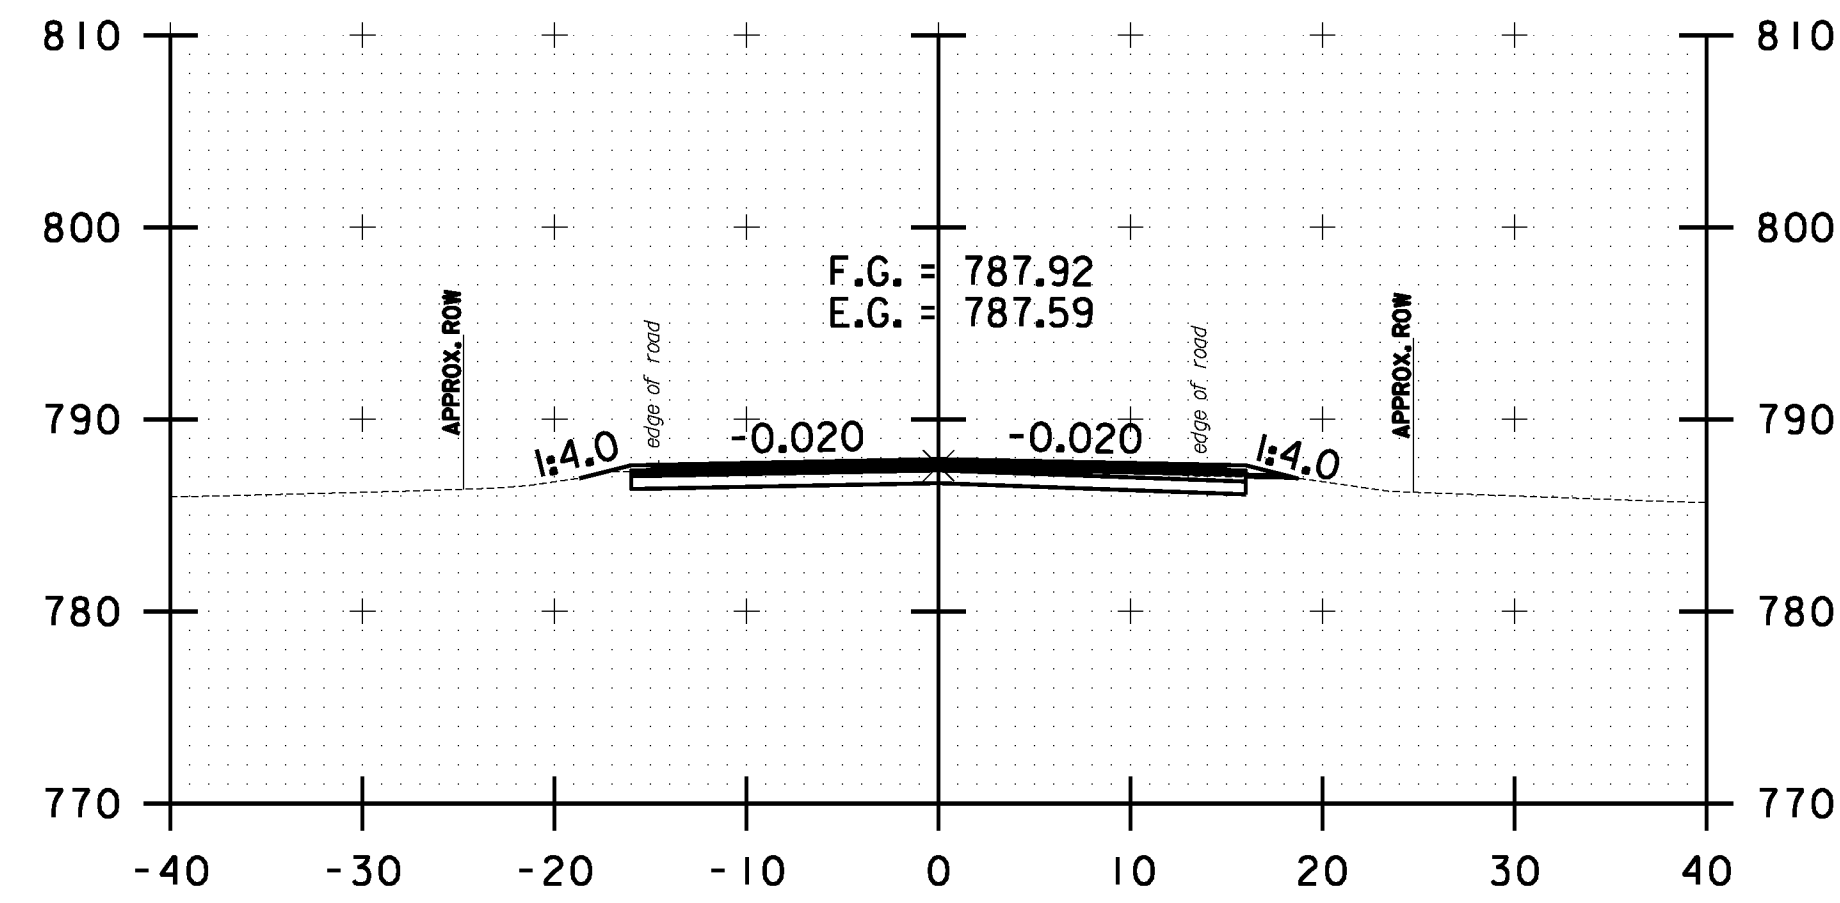


60+50.00

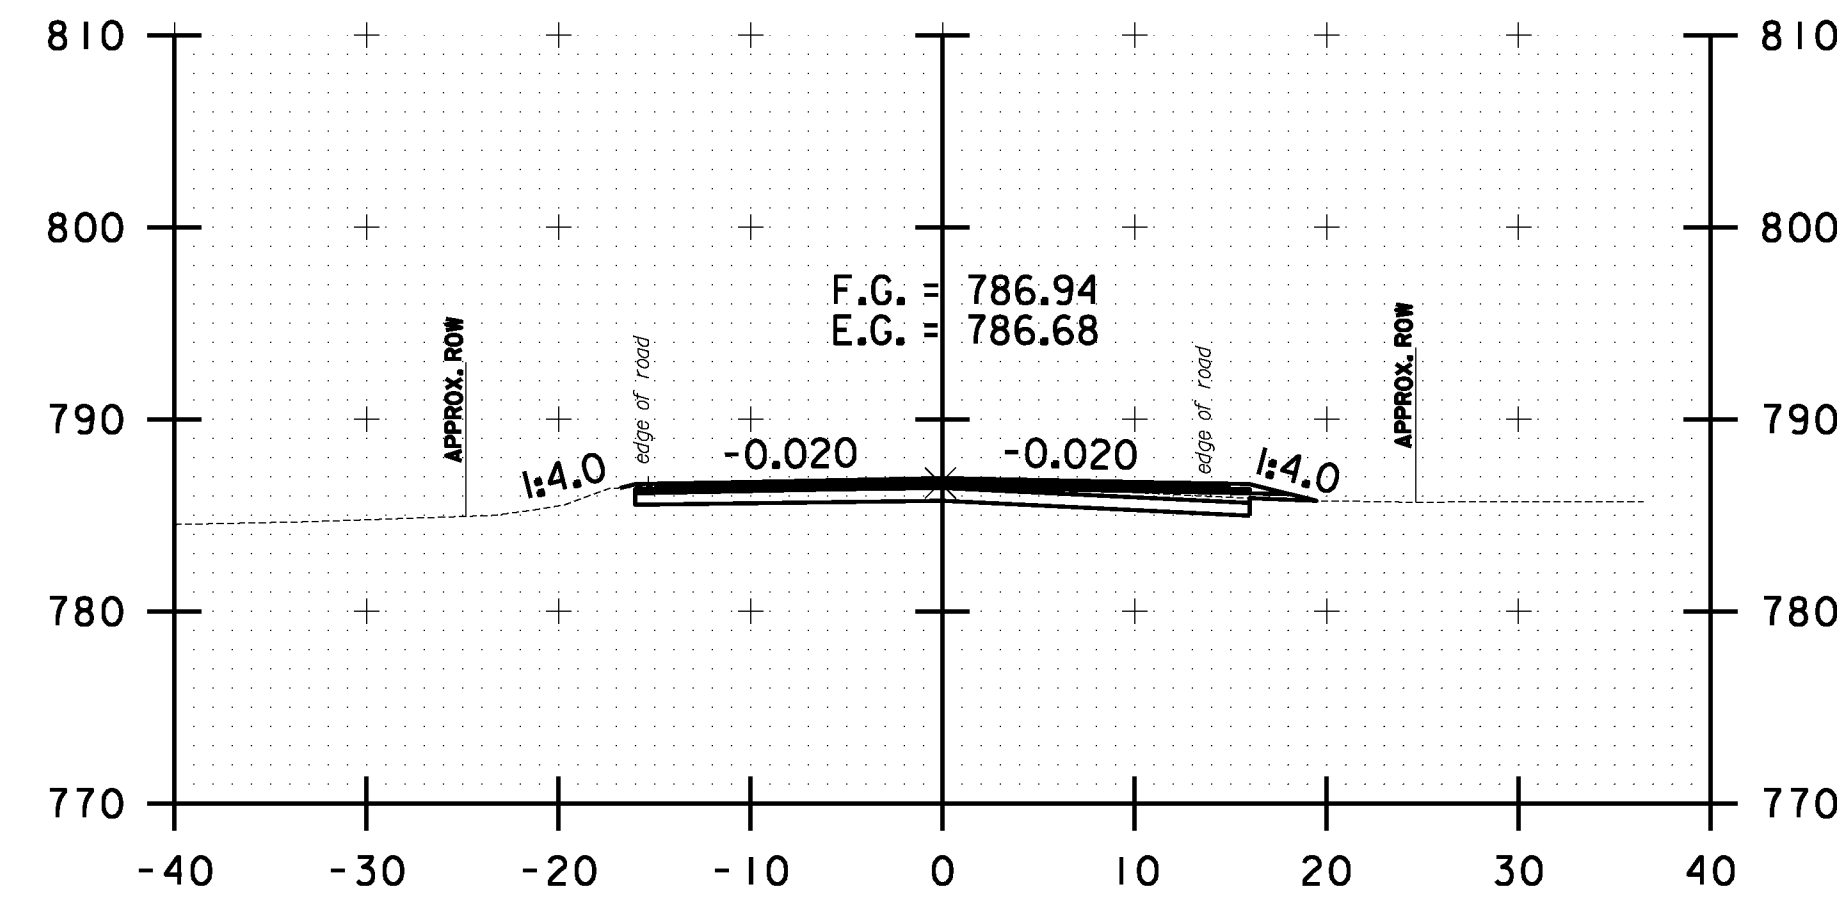


62+00.00

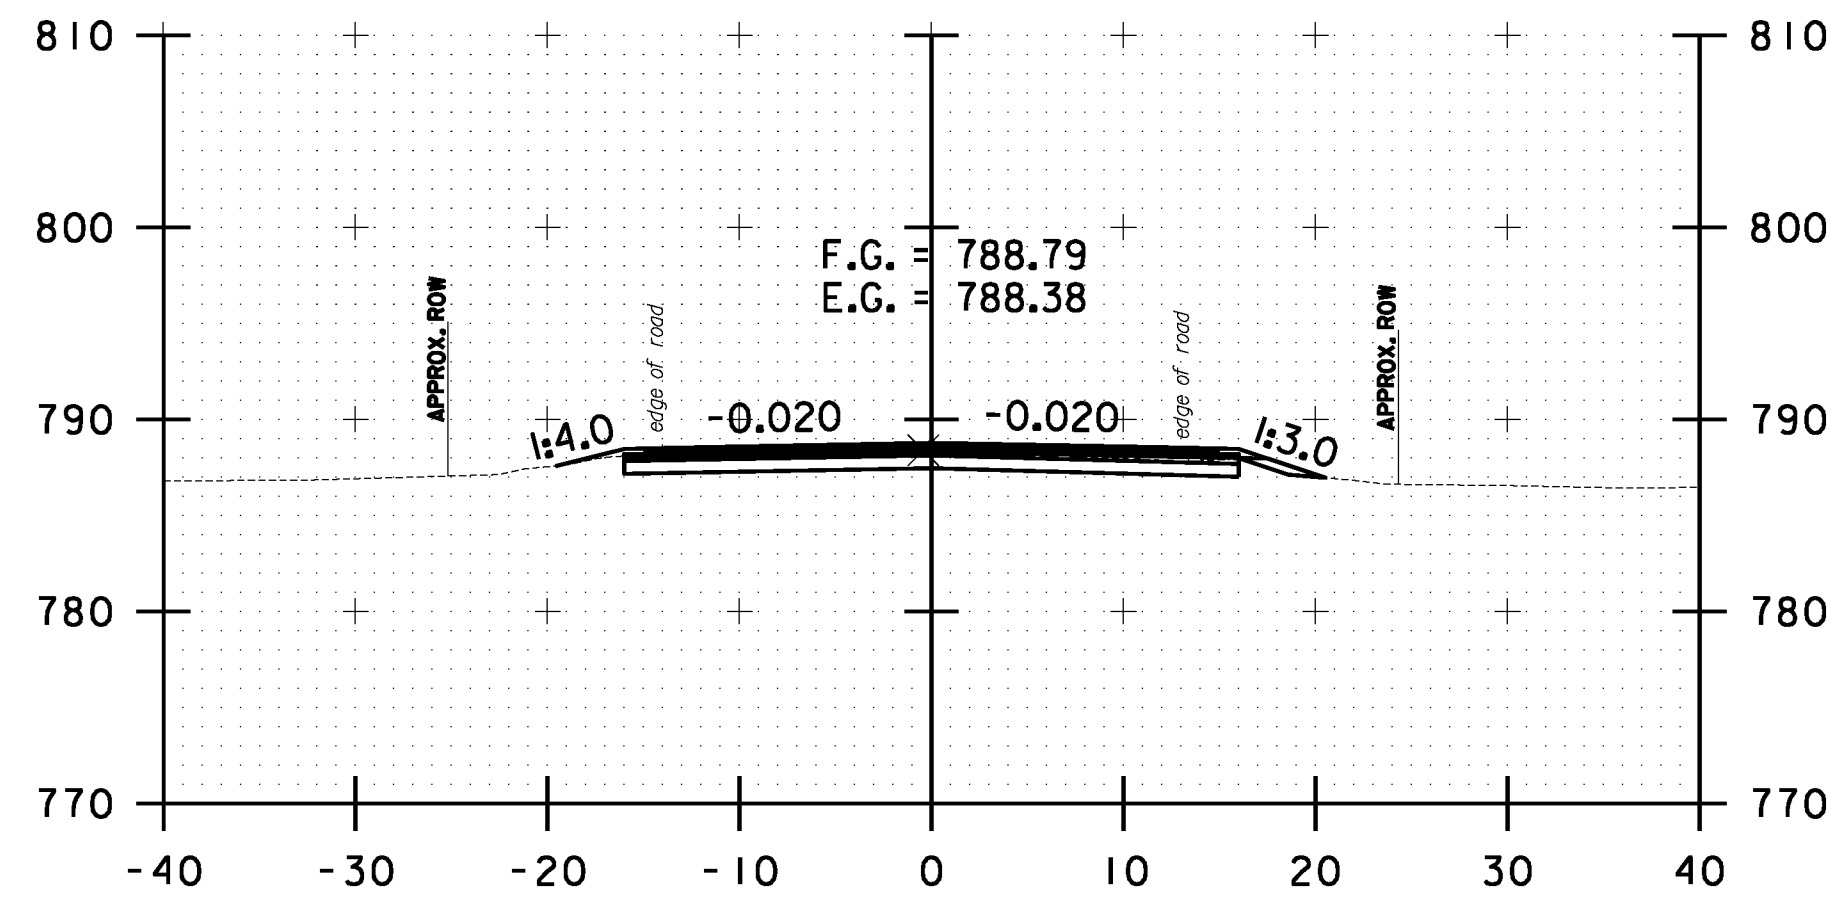


58+50.00

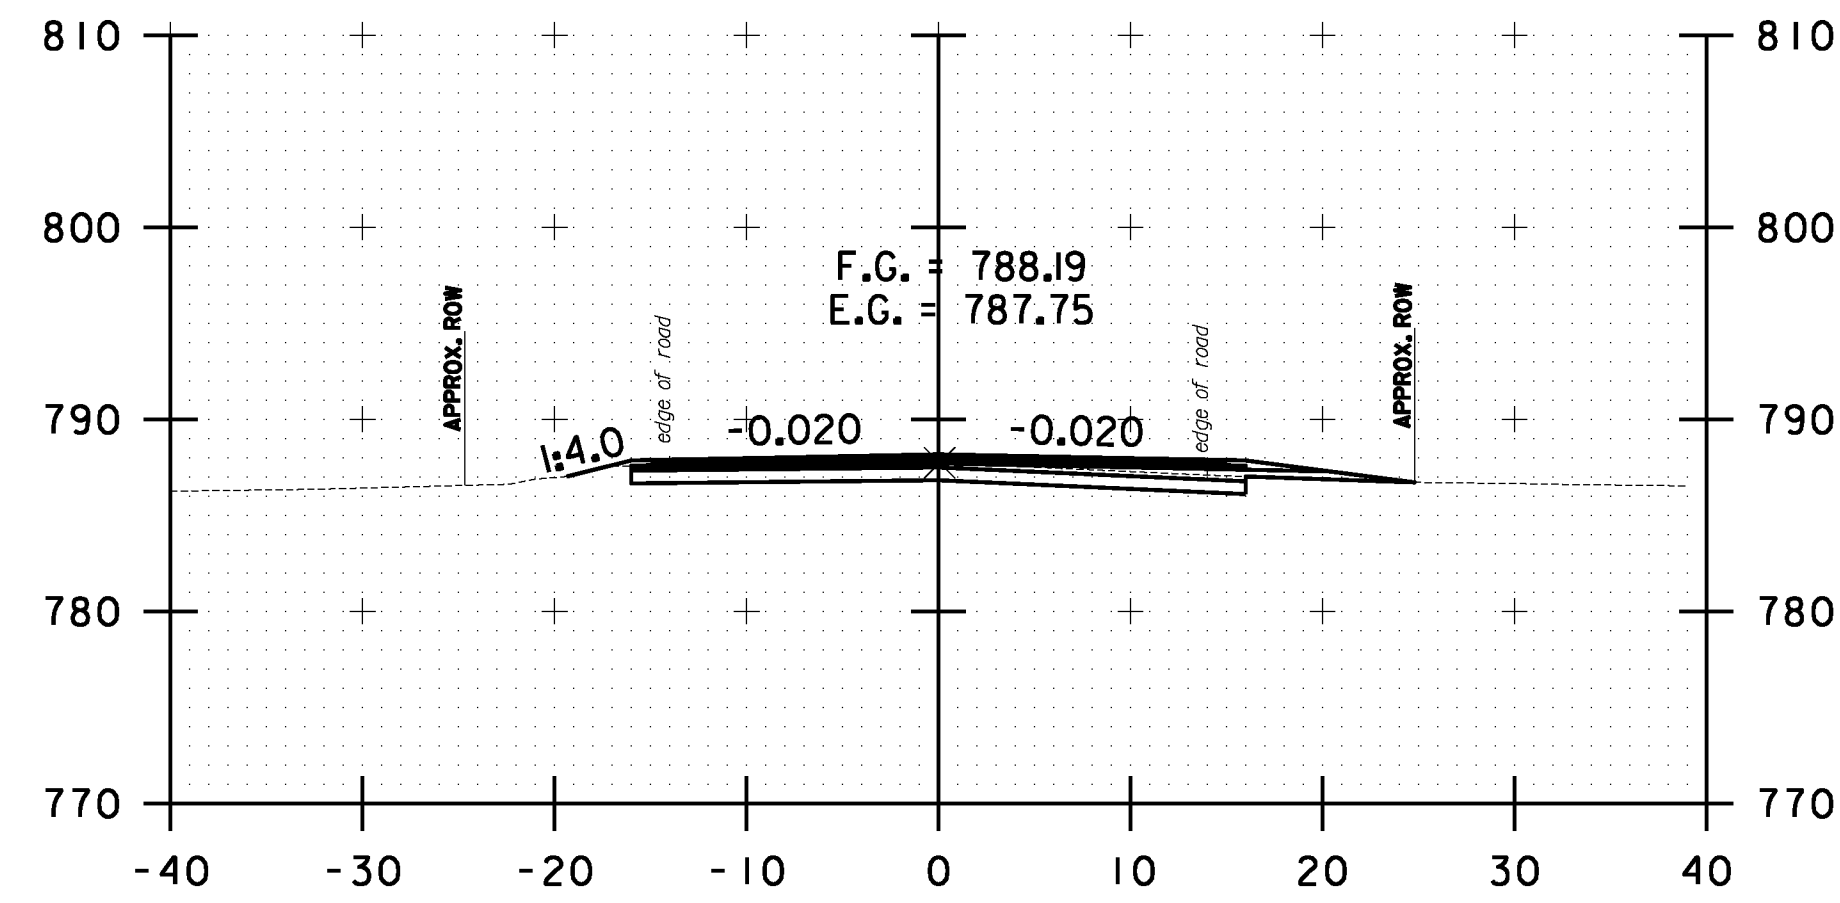


60+00.00

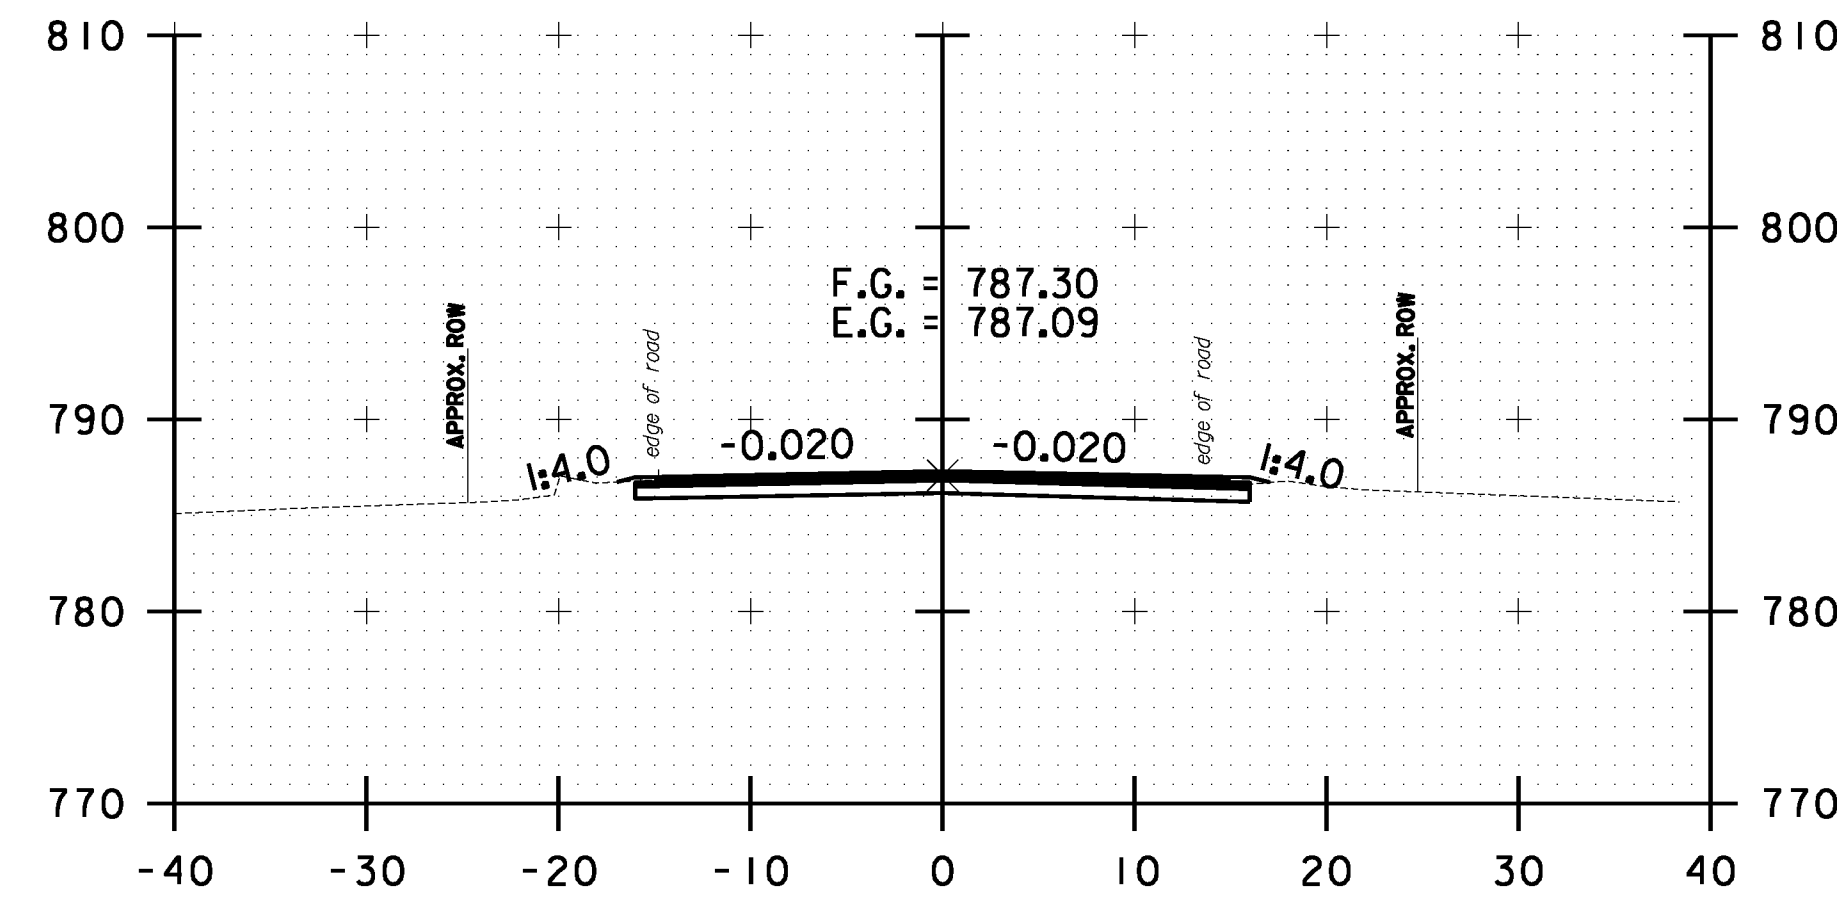


61+50.00

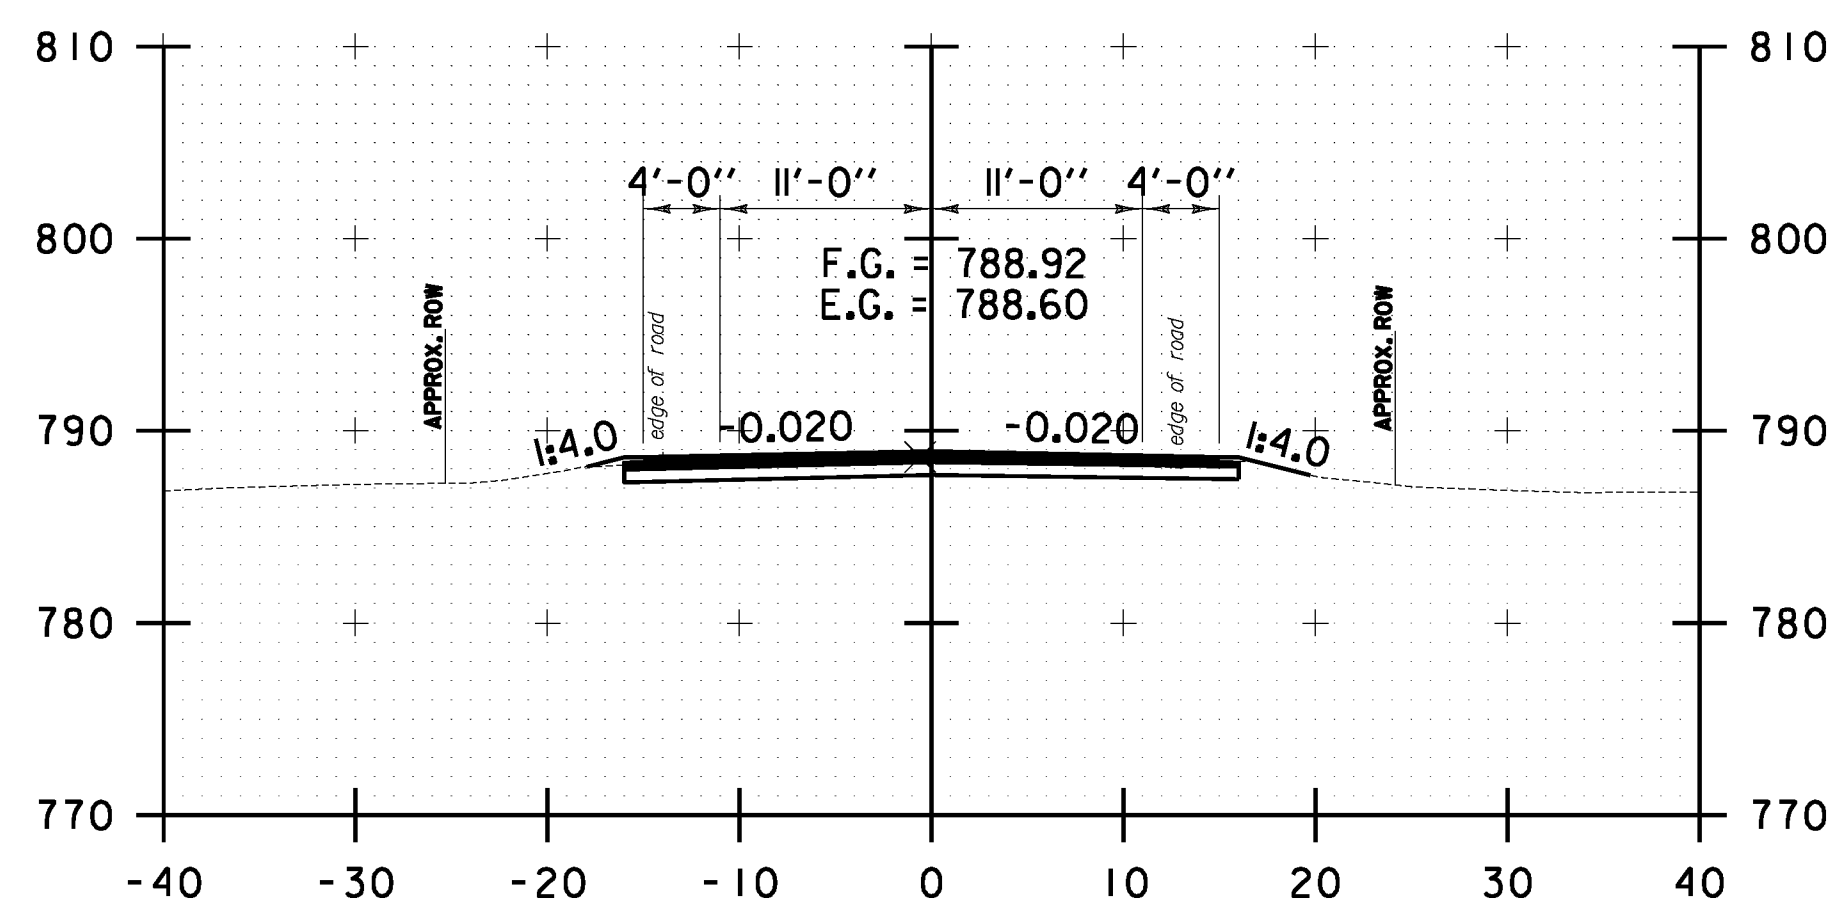


58+00.00

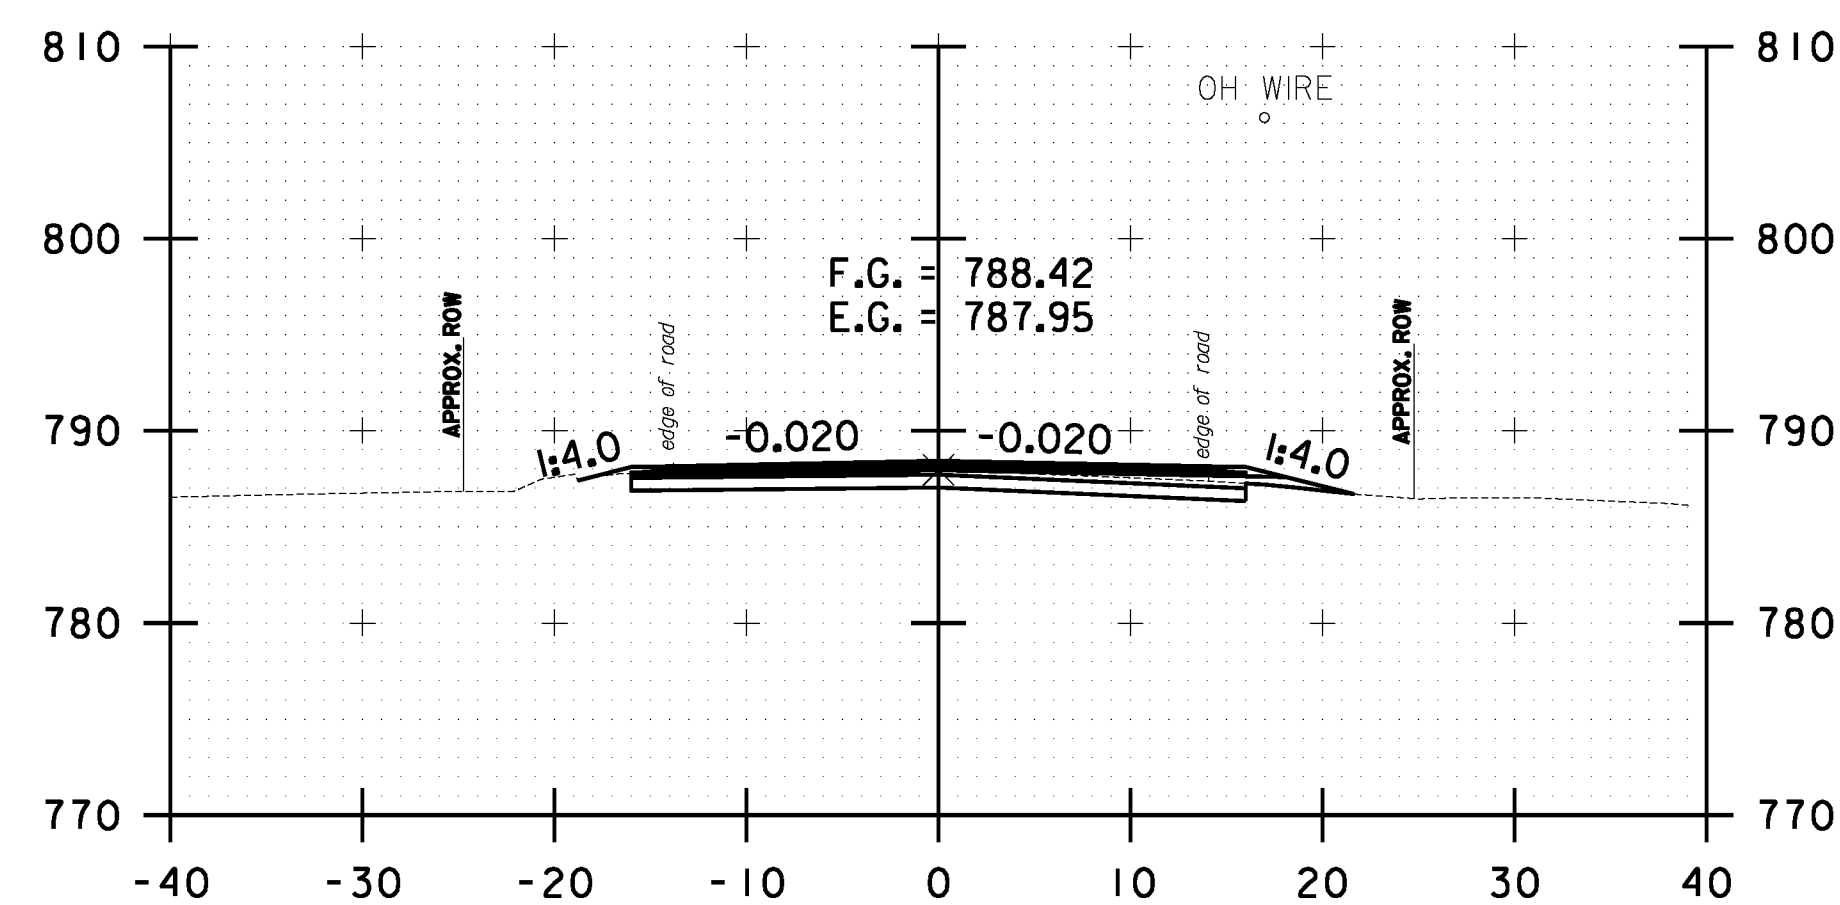

59+50.00

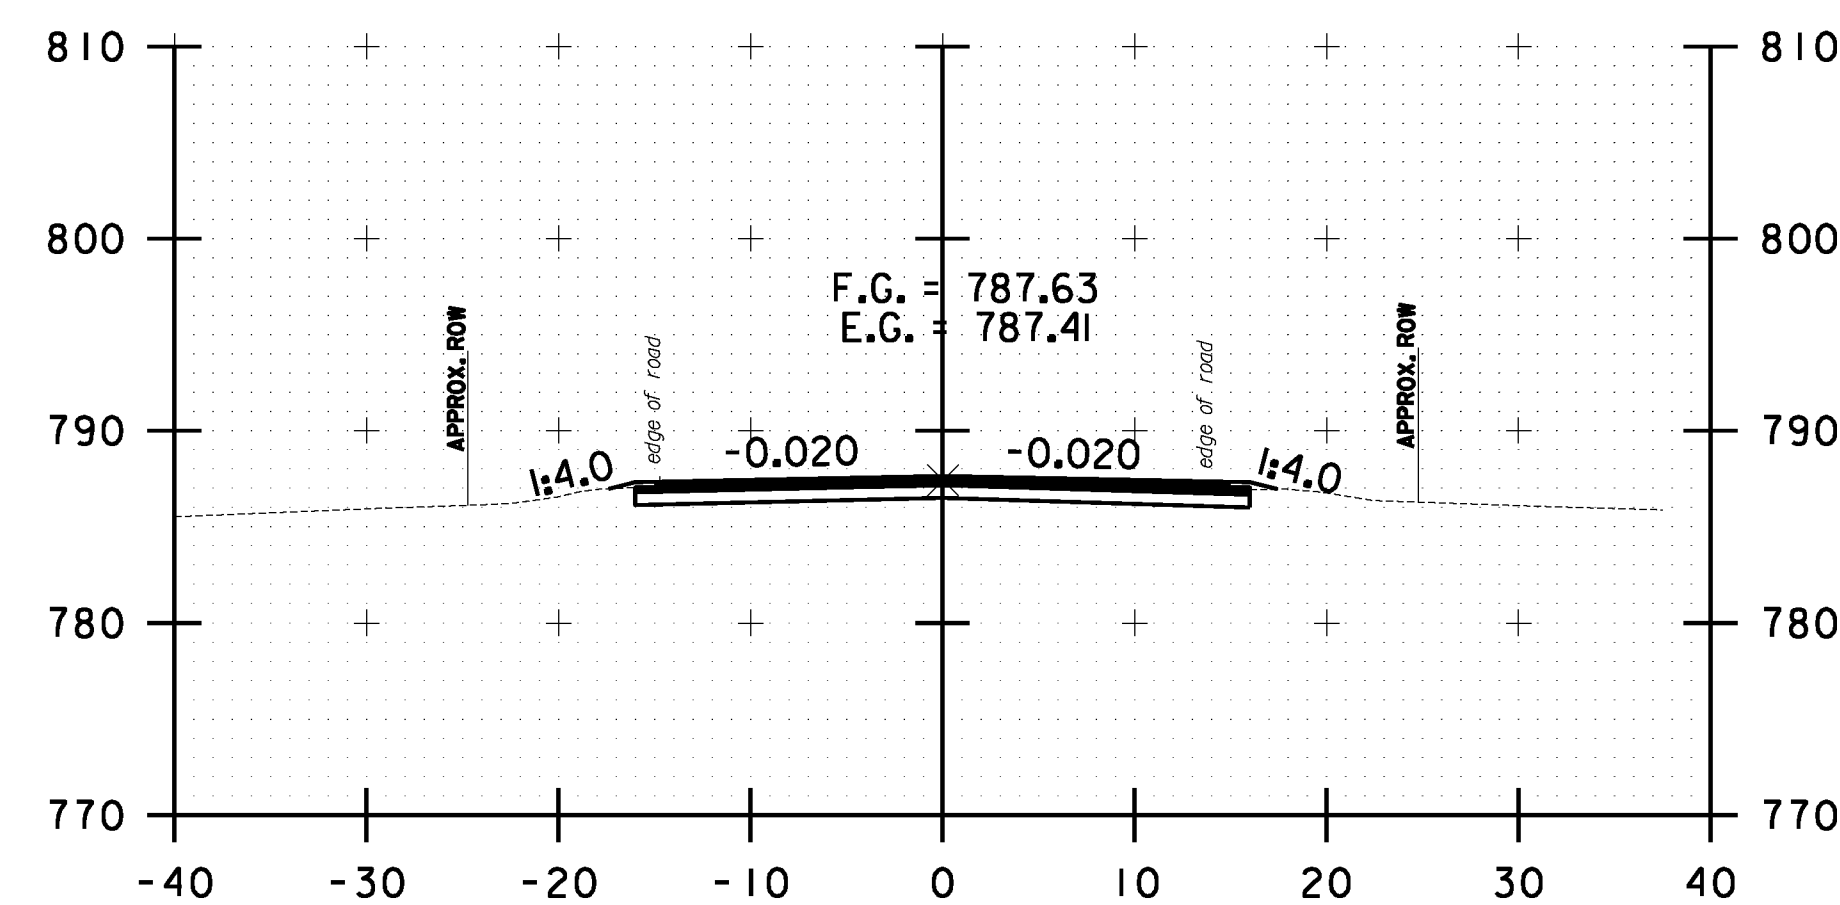

61+00.00

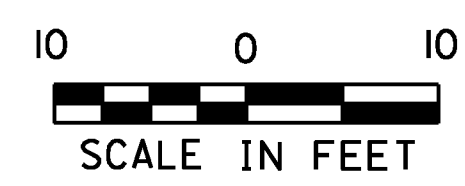

**WAITSFIELD
 CROSS SECTION
 SHEET #19**

PROJECT NAME: WARREN-WAITSFIELD

PROJECT NUMBER: STP 2506(1)

FILE NAME: p05b048.dgn

PROJECT LEADER: D.E.G.

DESIGNED BY: M.J.M.

IPARM FILE: p05b048xs112.l

PLOT DATE: 12/20/2012

DRAWN BY: W.G.P.

CHECKED BY: D.E.G.

SHEET 275 OF 310