




FILE NAME: U:\1762\CA00\MST\STP_2506\p05b048_Cross-section Plans.dgn
 DATE/TIME: 12/20/2012
 USER: 4866

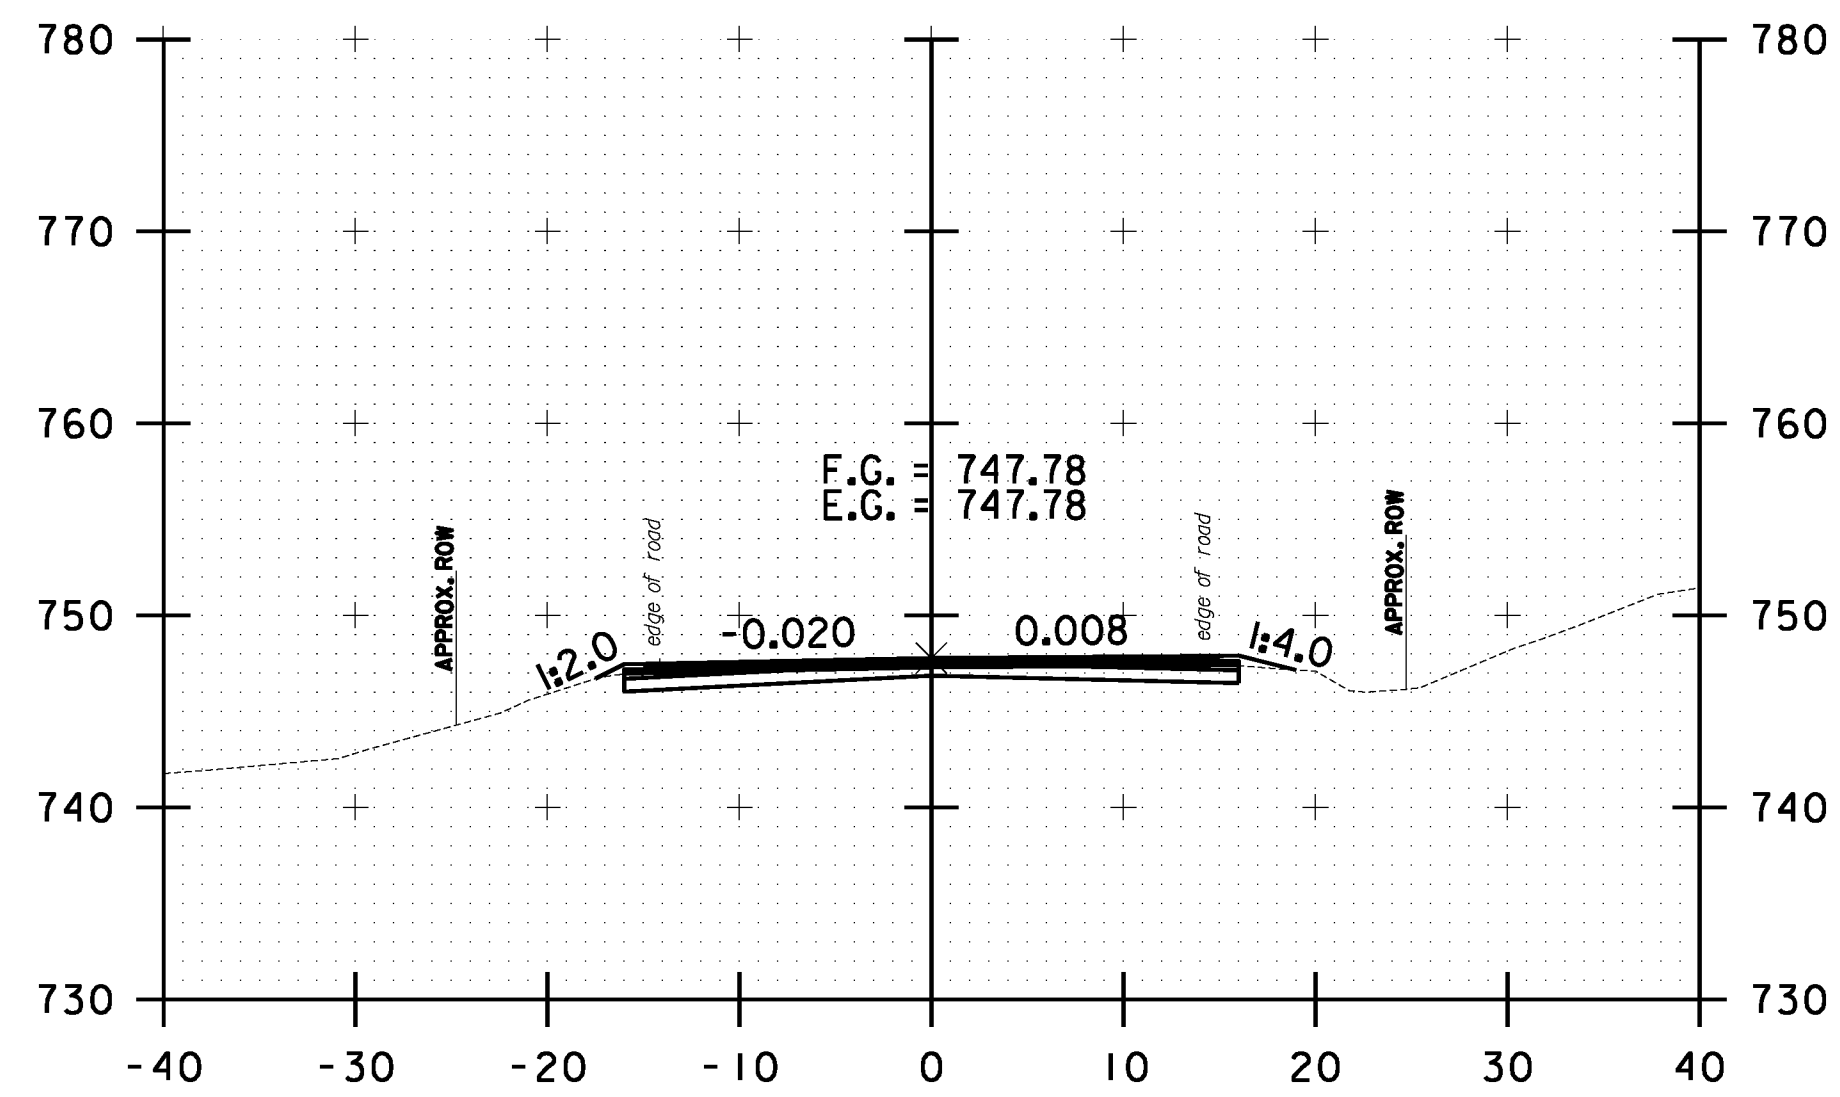


73+00.00

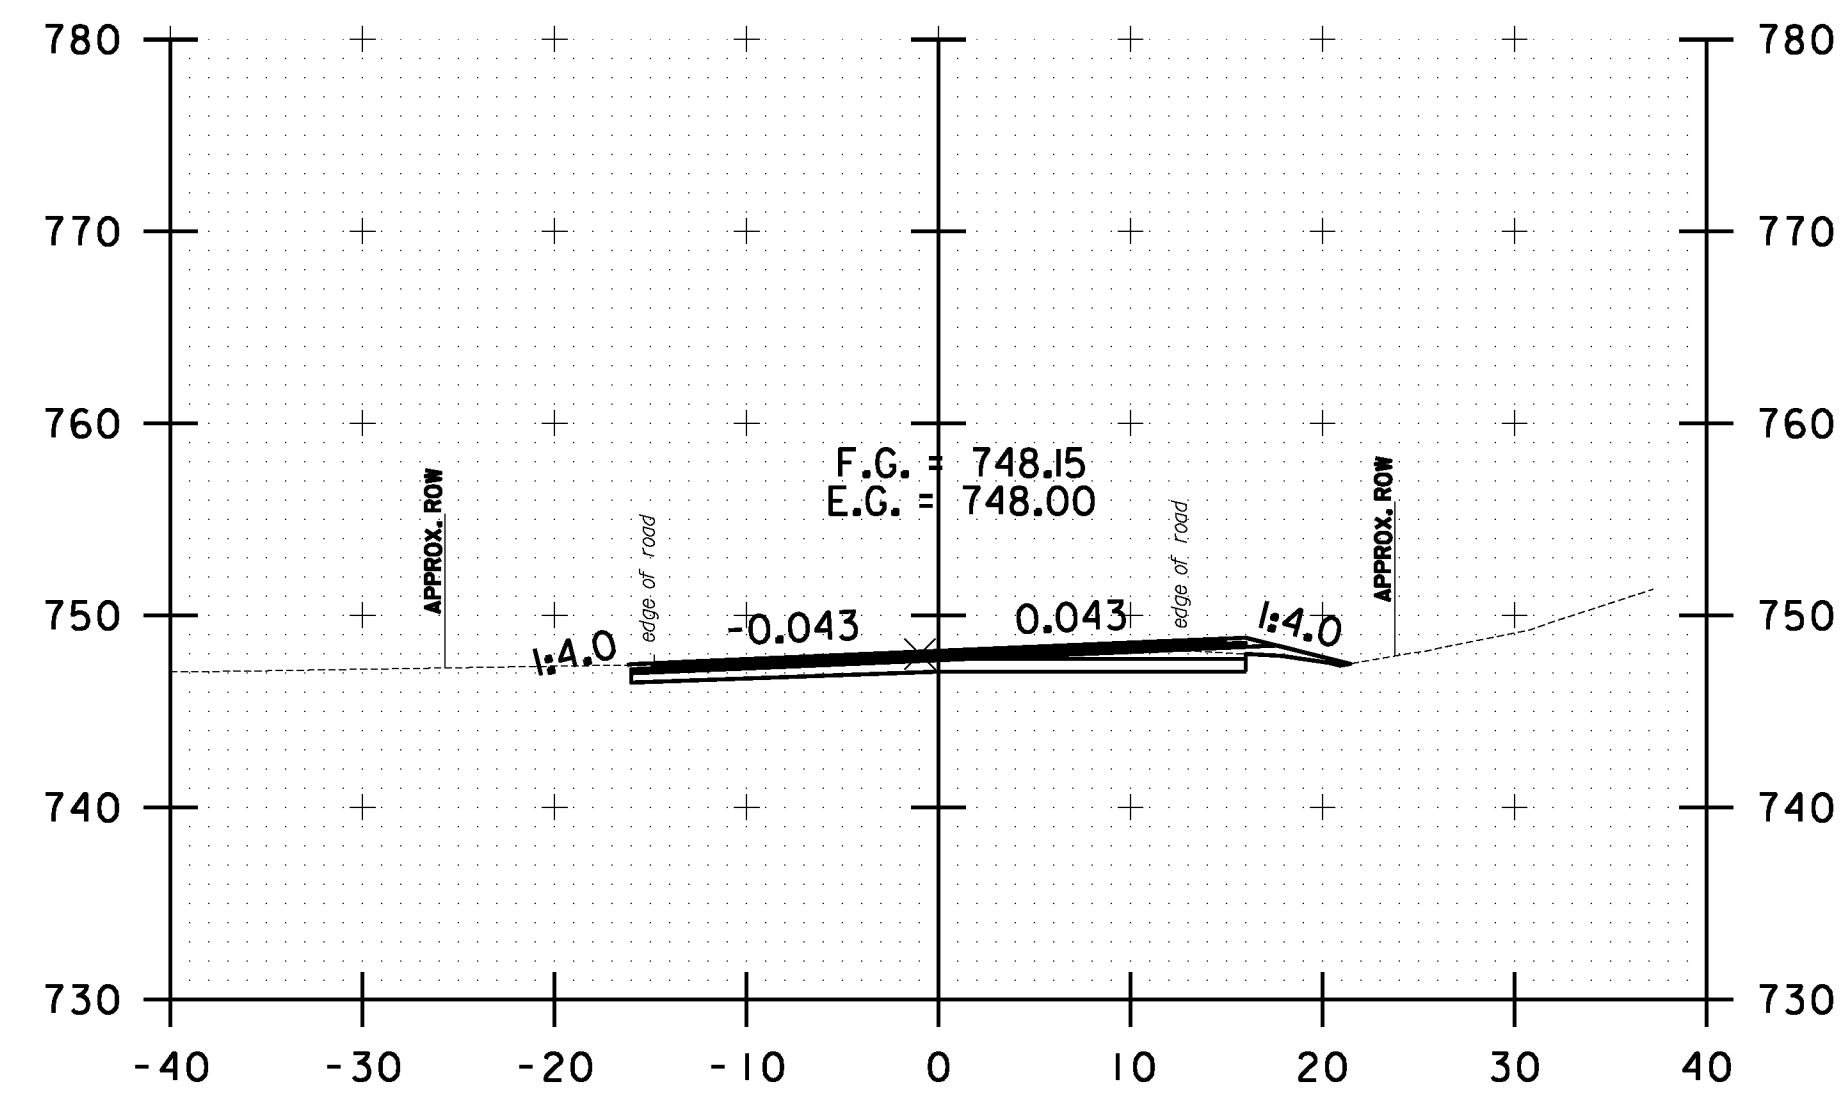


74+00.00

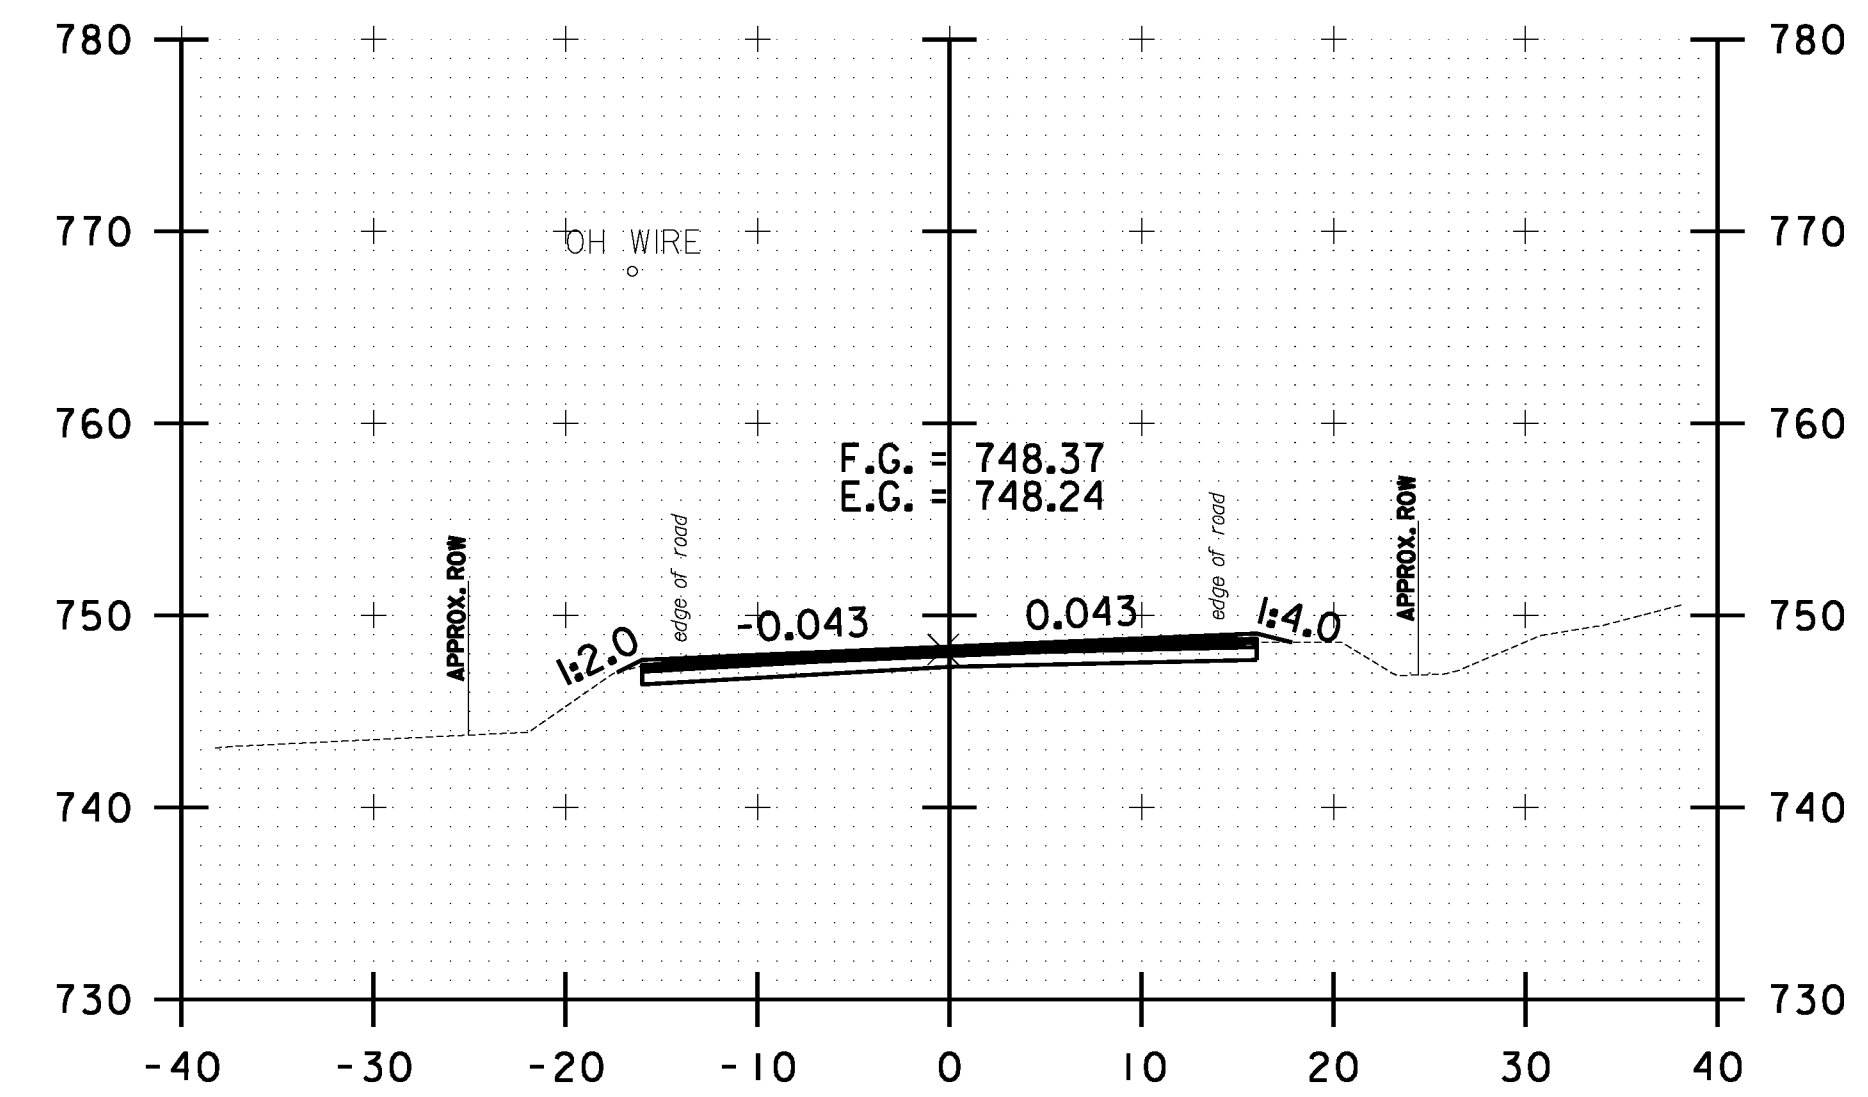


75+00.00

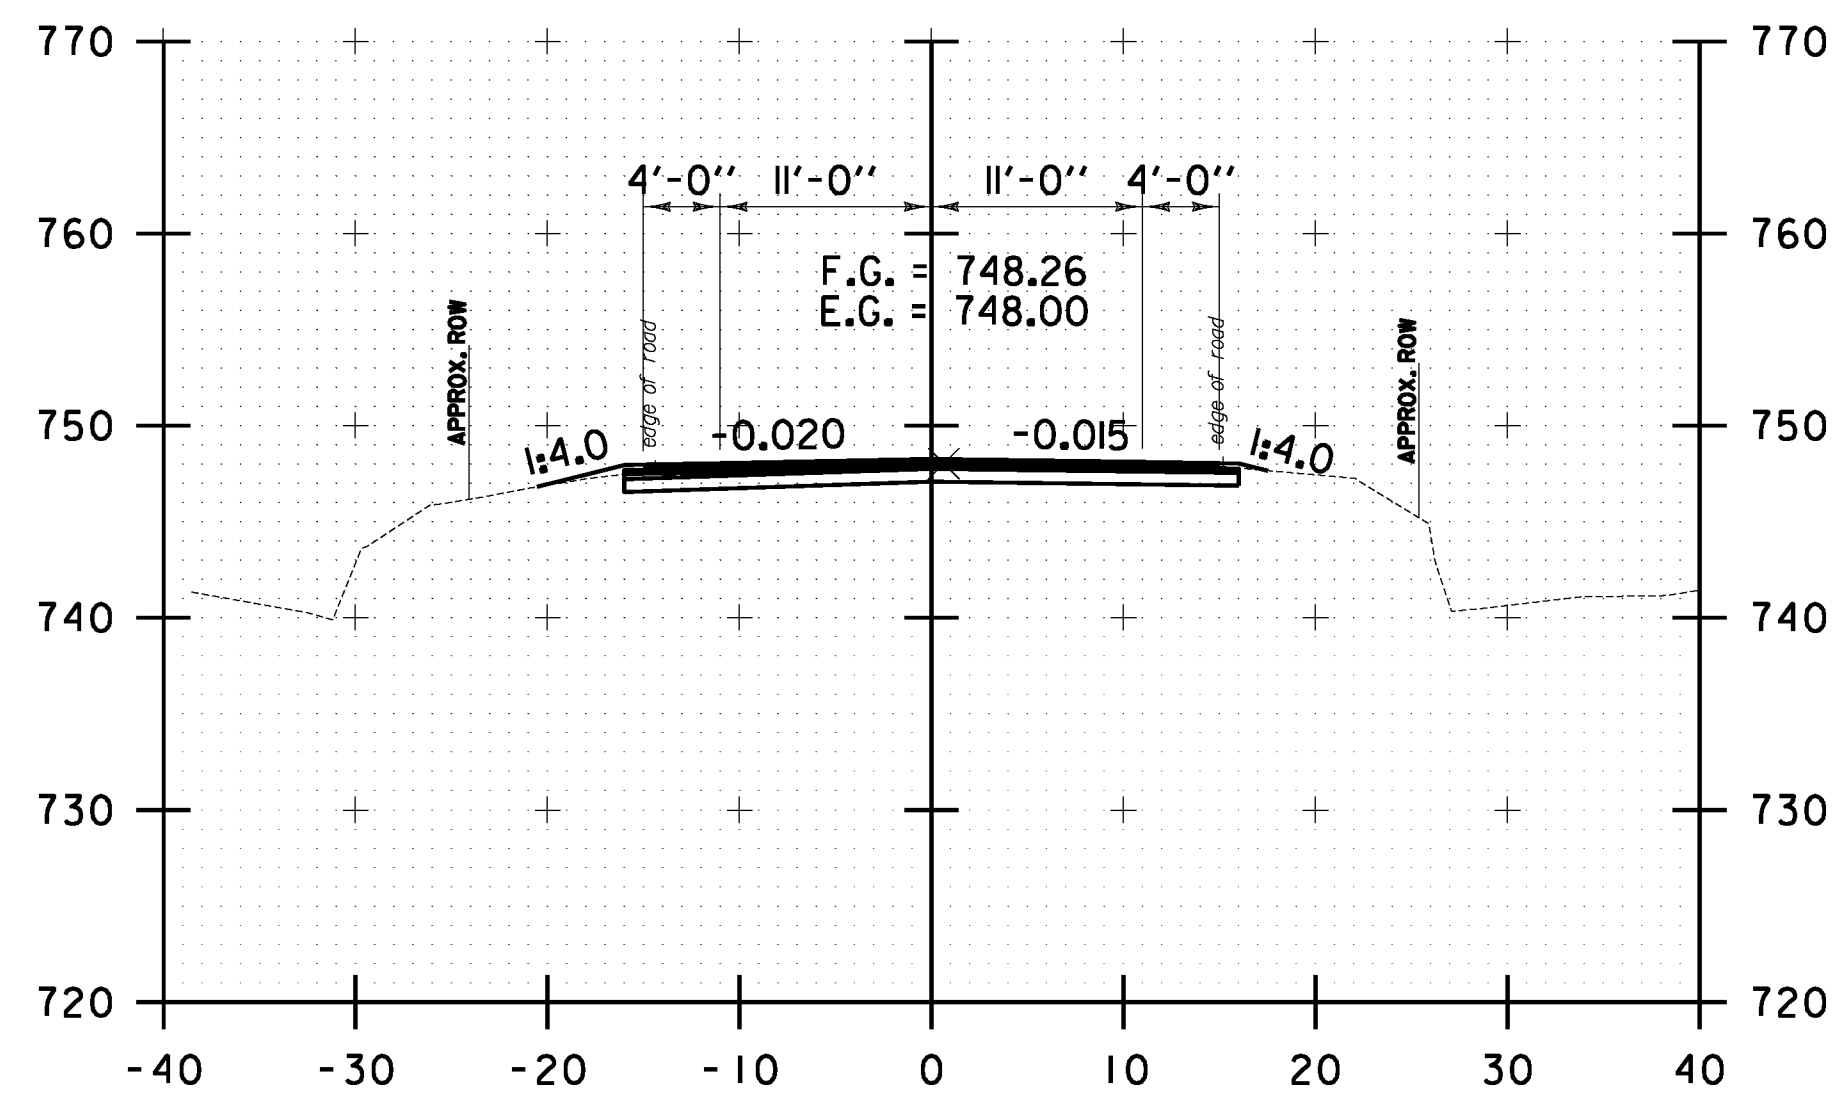


72+50.00

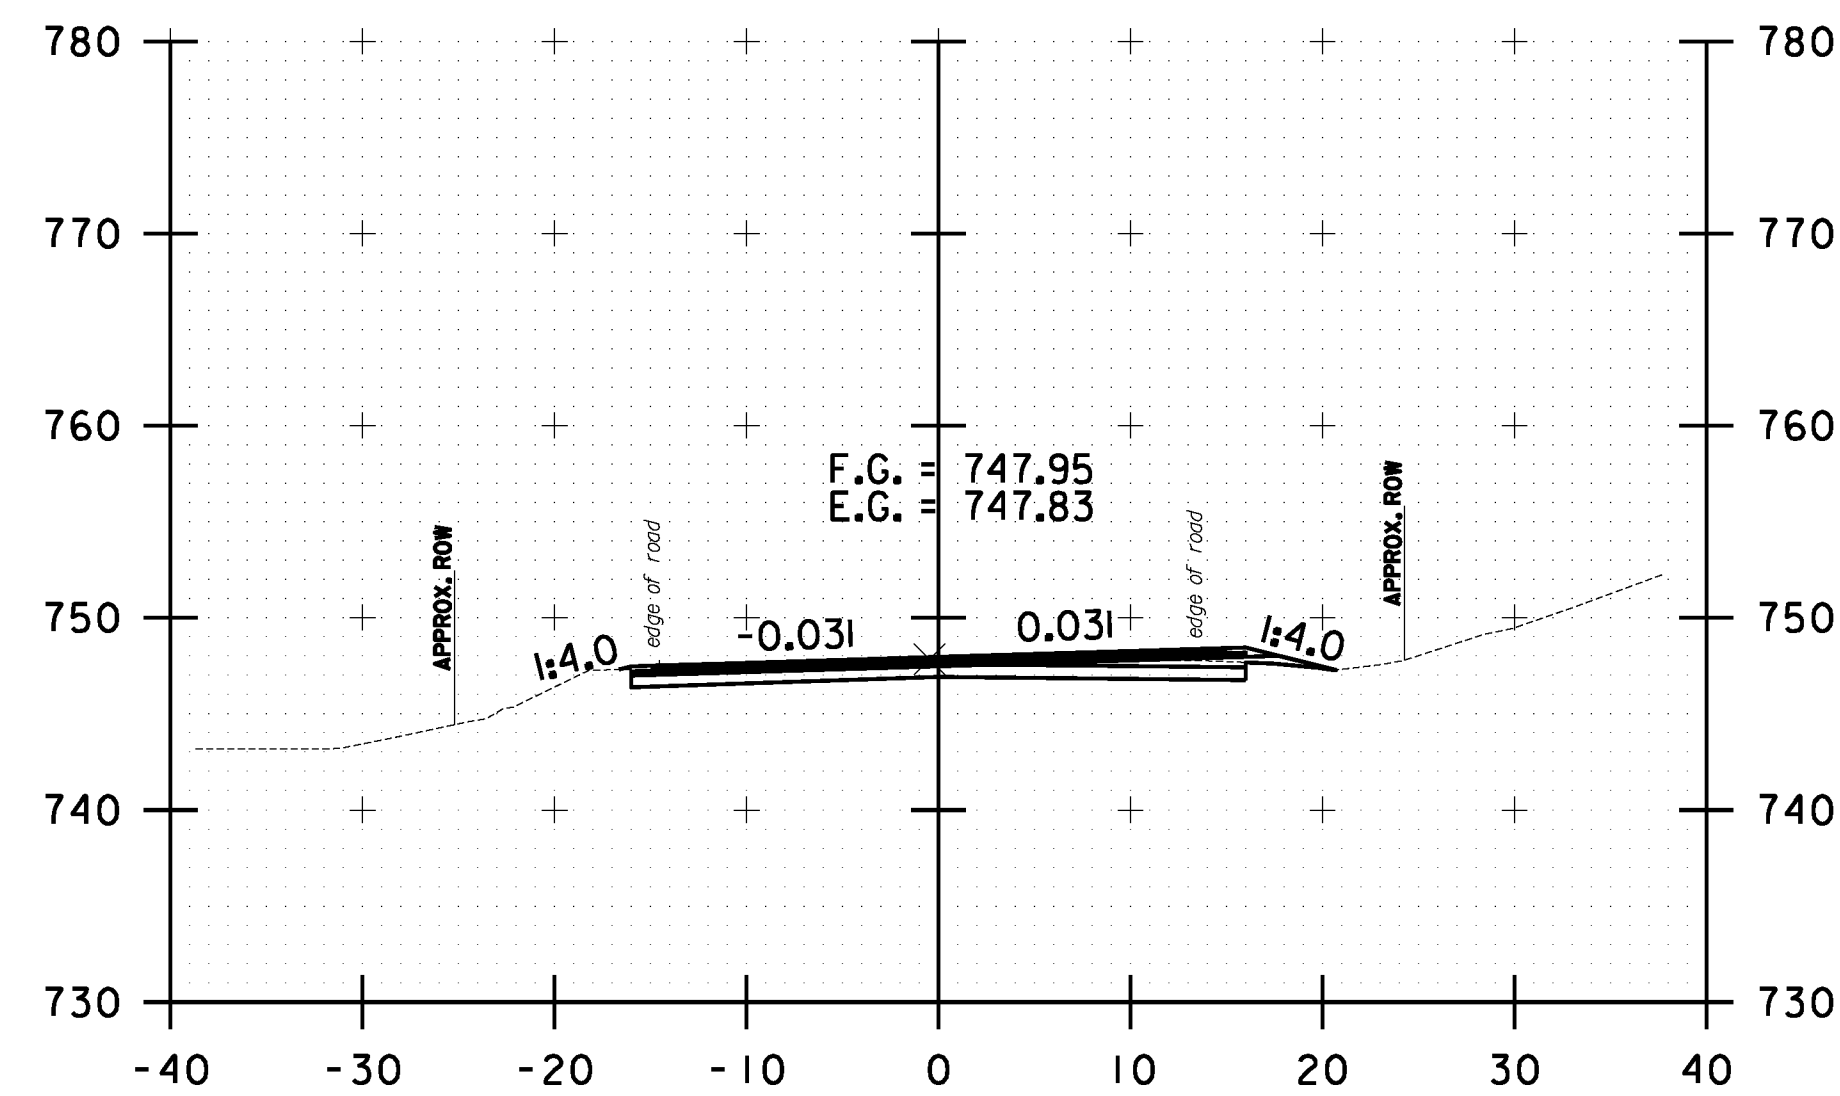

73+50.00

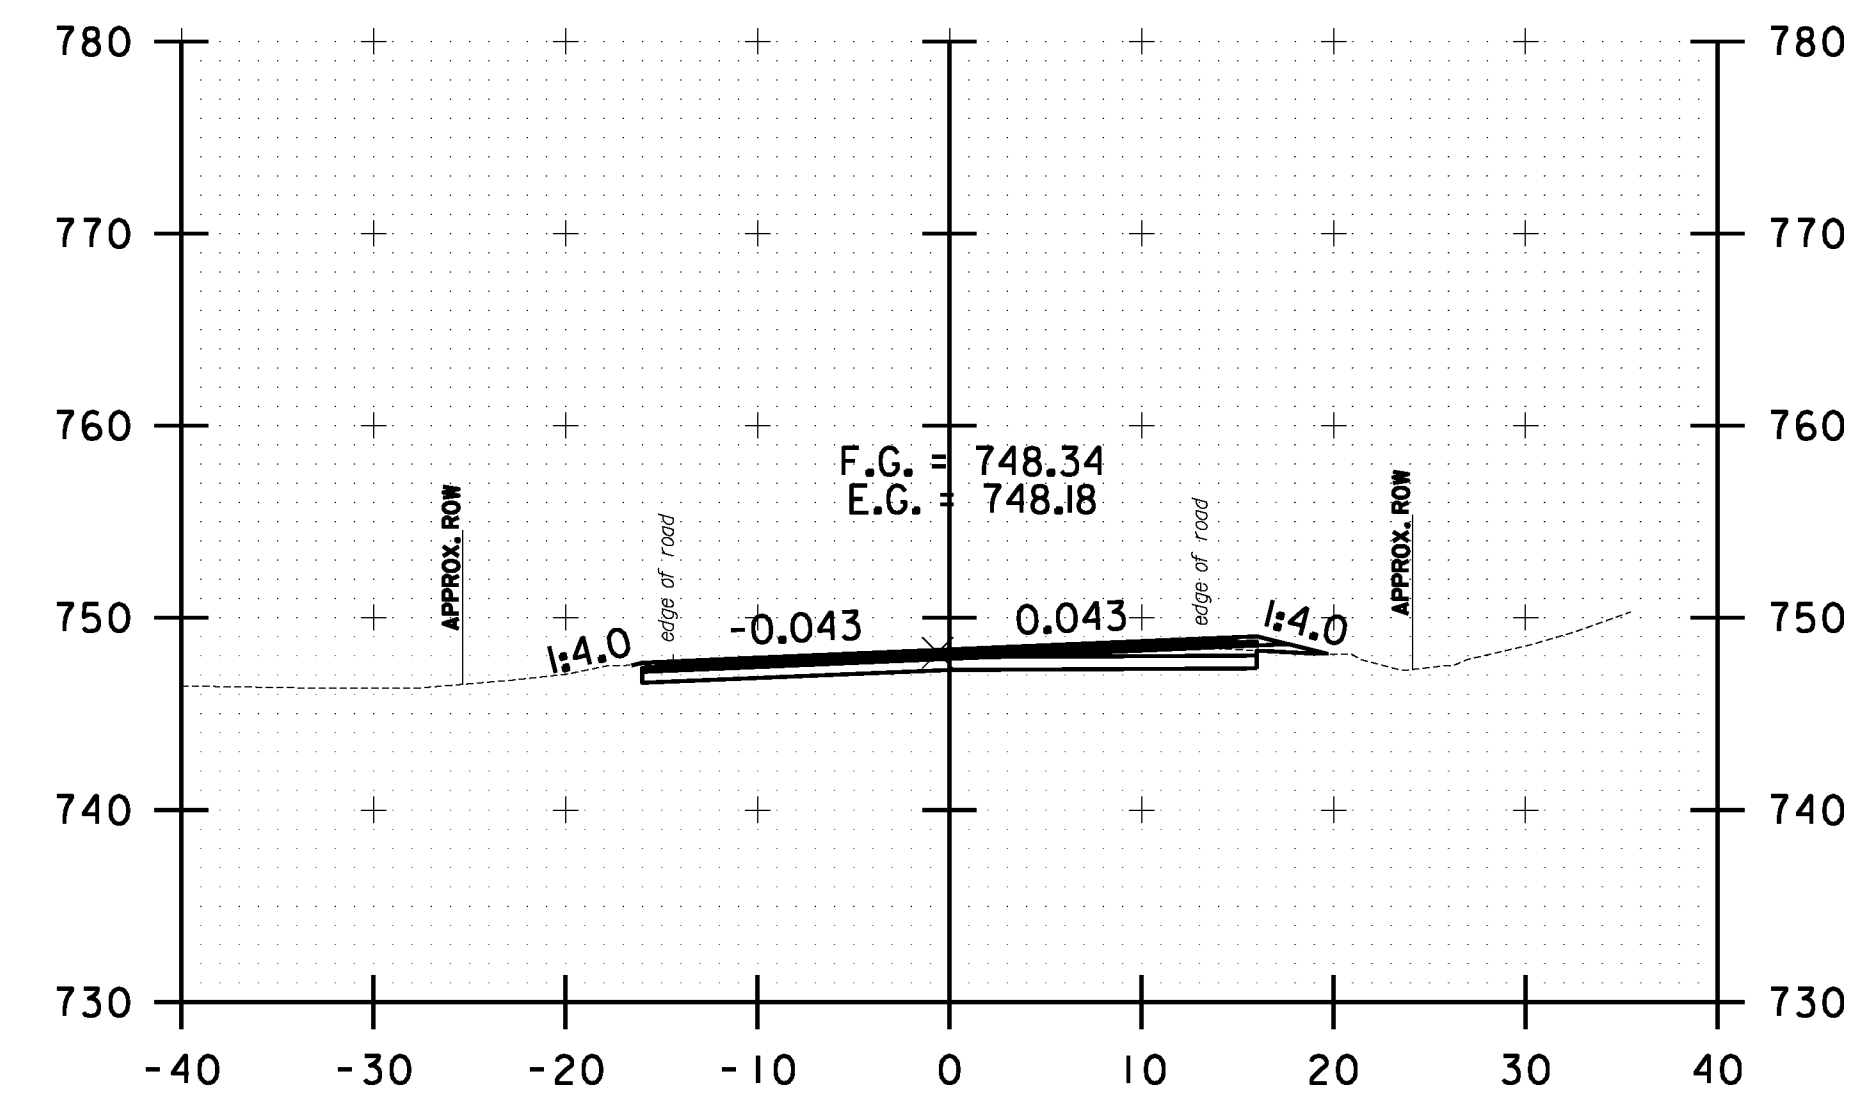

74+50.00

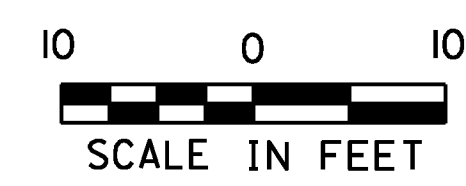

**WAITSFIELD
 CROSS SECTION
 SHEET #23**

PROJECT NAME: WARREN-WAITSFIELD

PROJECT NUMBER: STP 2506(1)

FILE NAME: p05b048.dgn

PROJECT LEADER: D.E.G.

DESIGNED BY: M.J.M.

IPARM FILE: p05b048xsl16.l

PLOT DATE: 12/20/2012

DRAWN BY: W.G.P.

CHECKED BY: D.E.G.

SHEET 279 OF 310