




FILE NAME = U:\1762\CA00\MST\STP_2506\p05b048_Conv.eas_Plan.dgn
 DATE/TIME = 12/20/2012
 USER = 4866

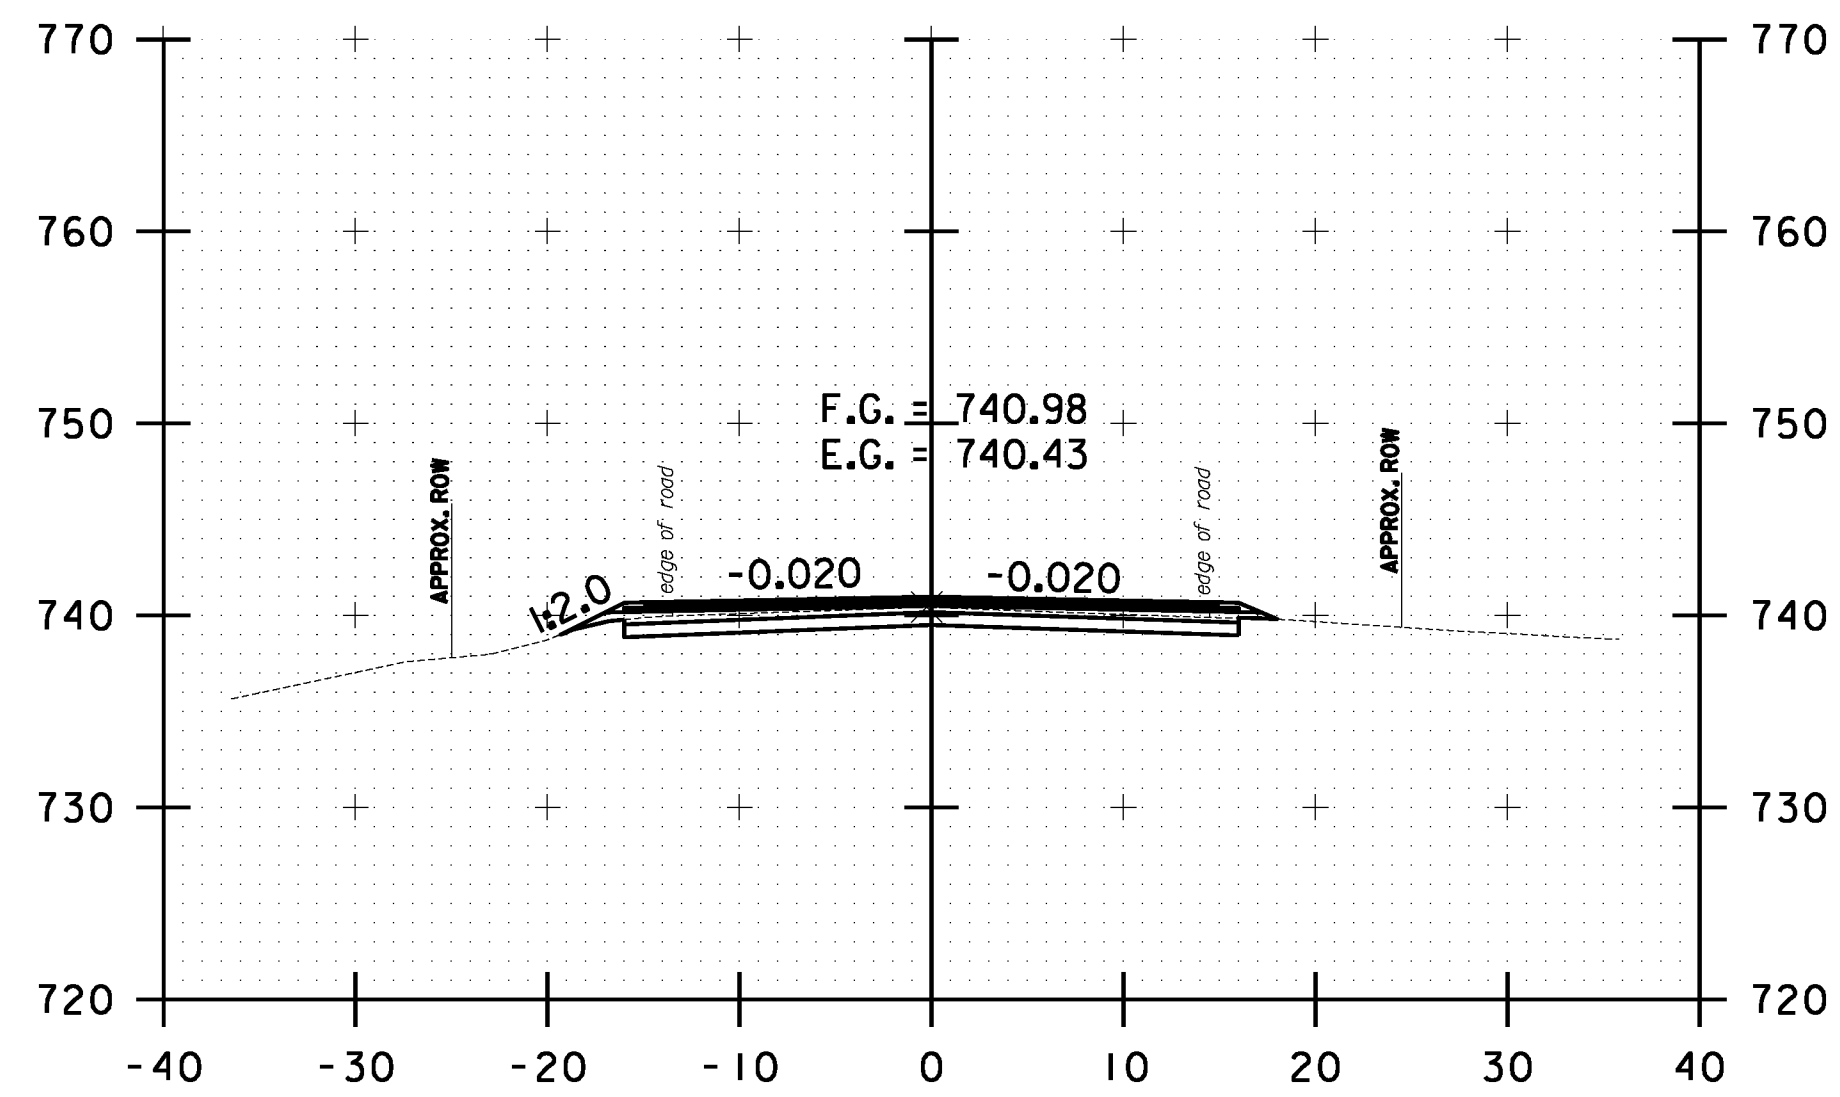


85+50.00

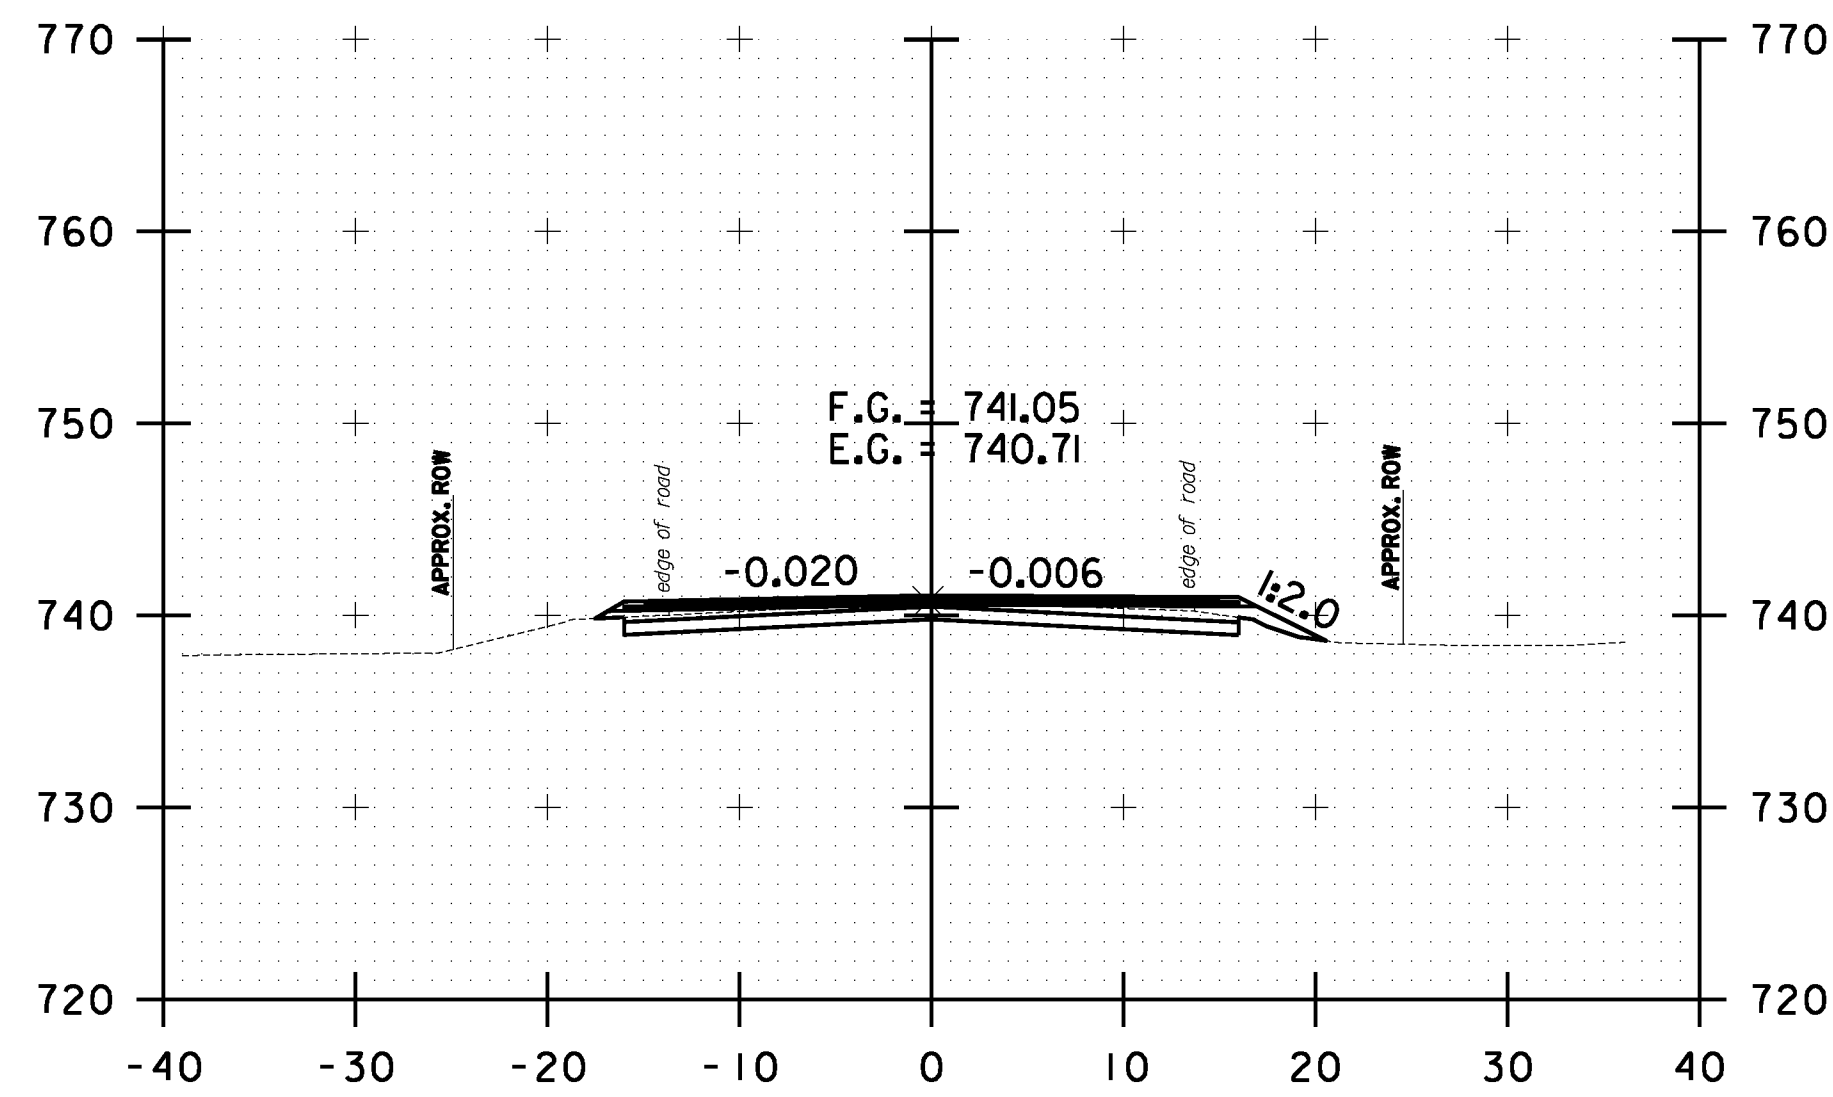


86+50.00

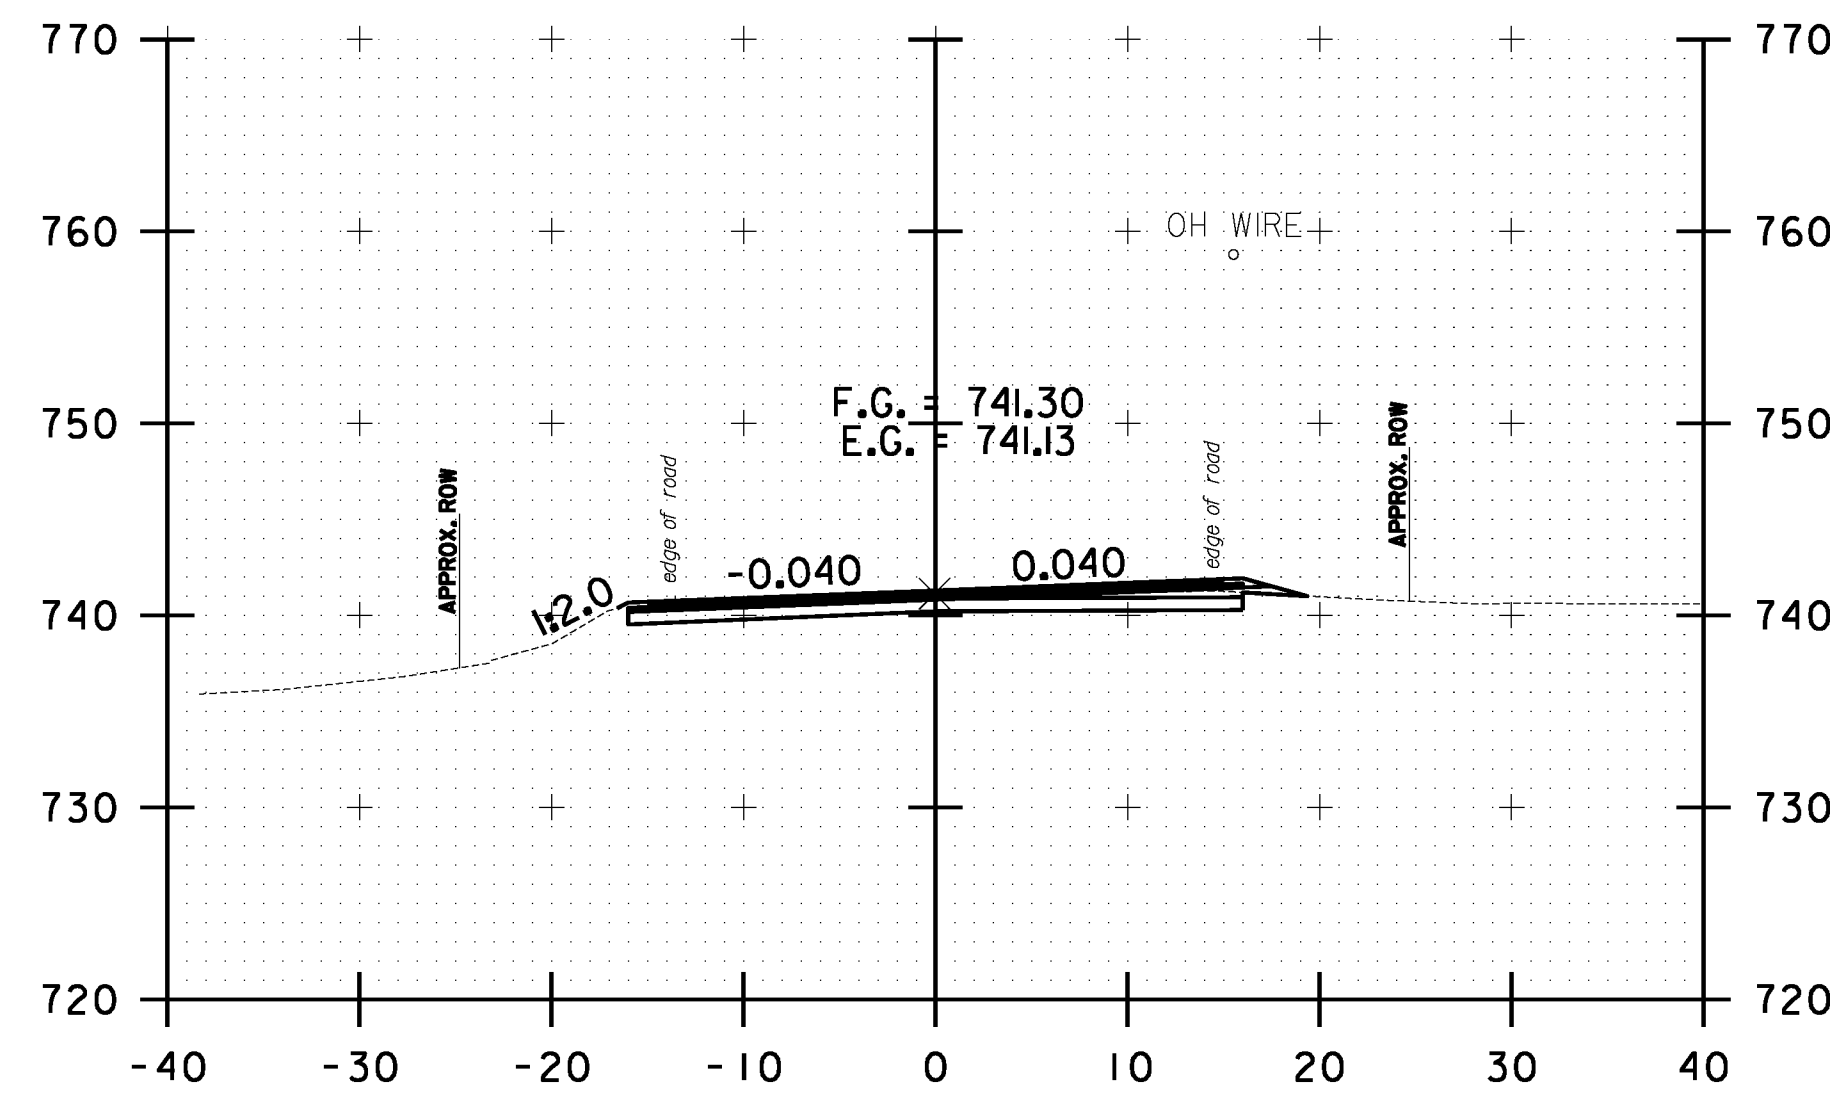


87+50.00

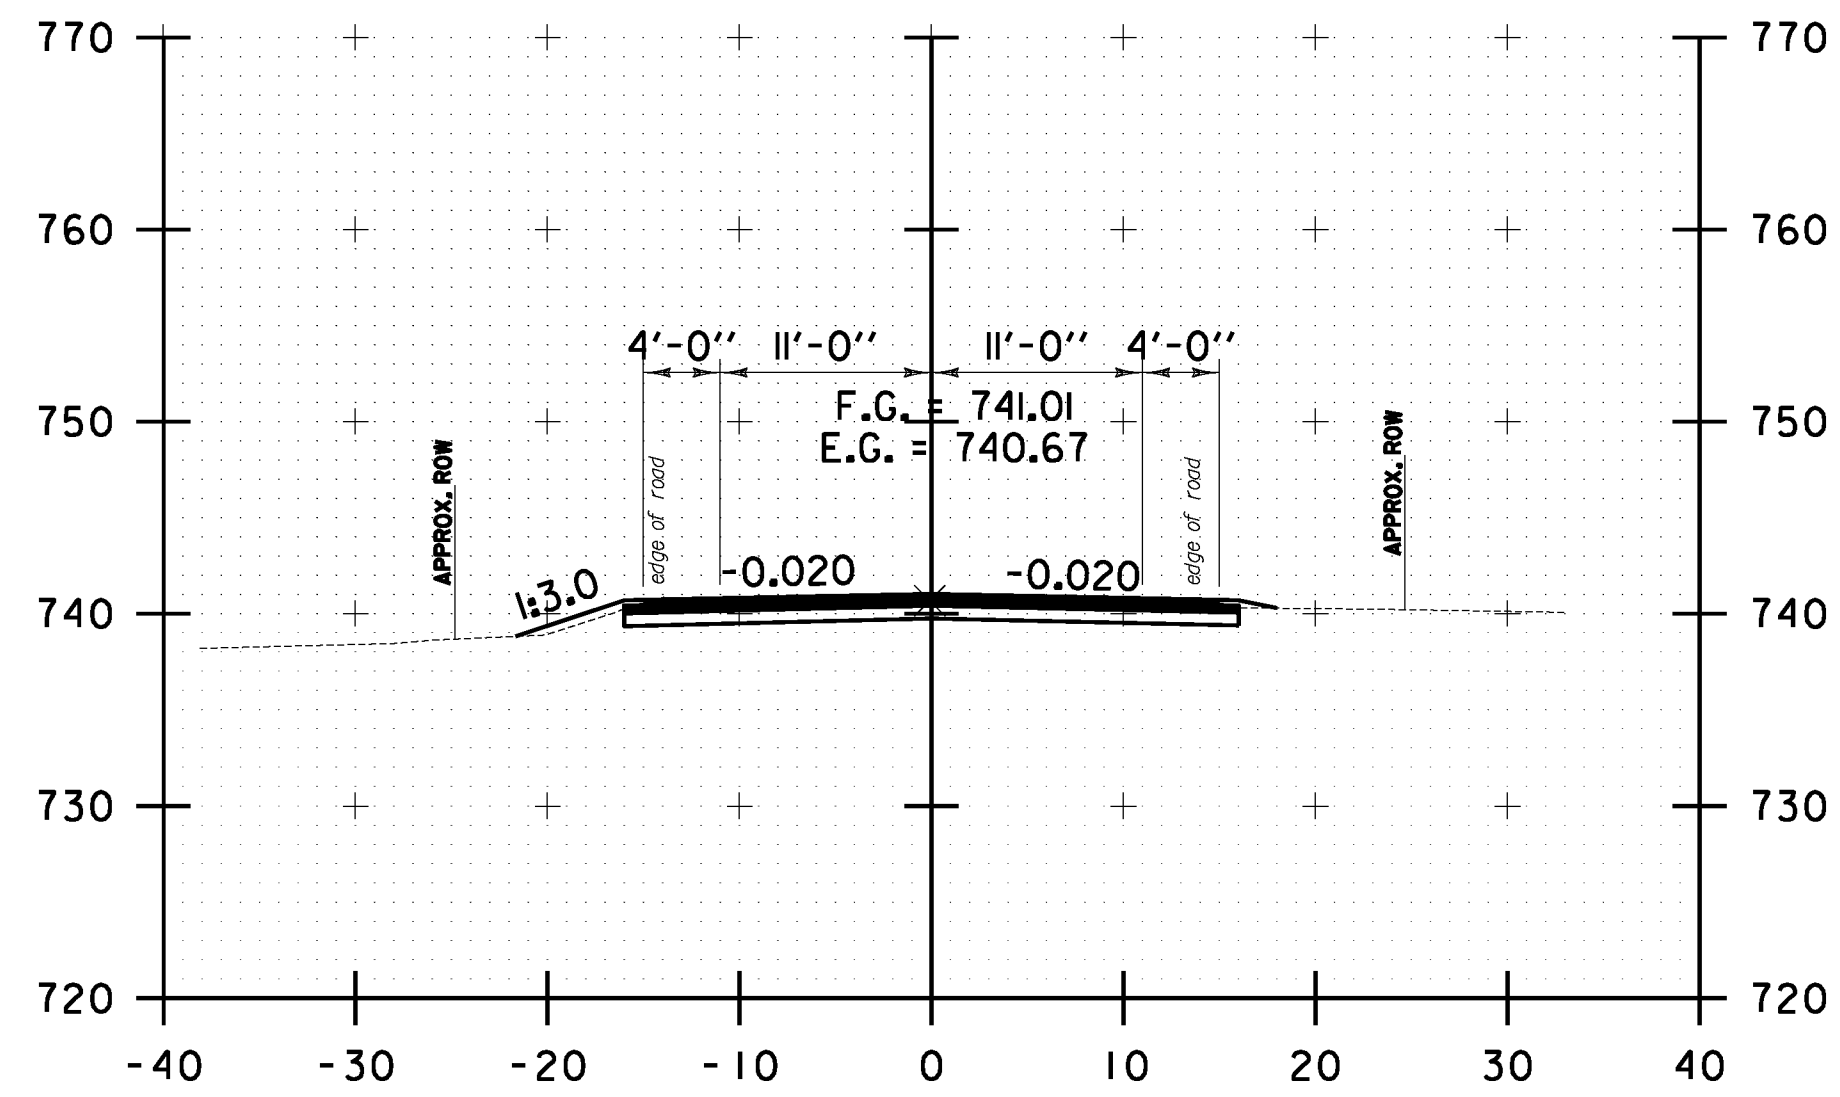

85+00.00

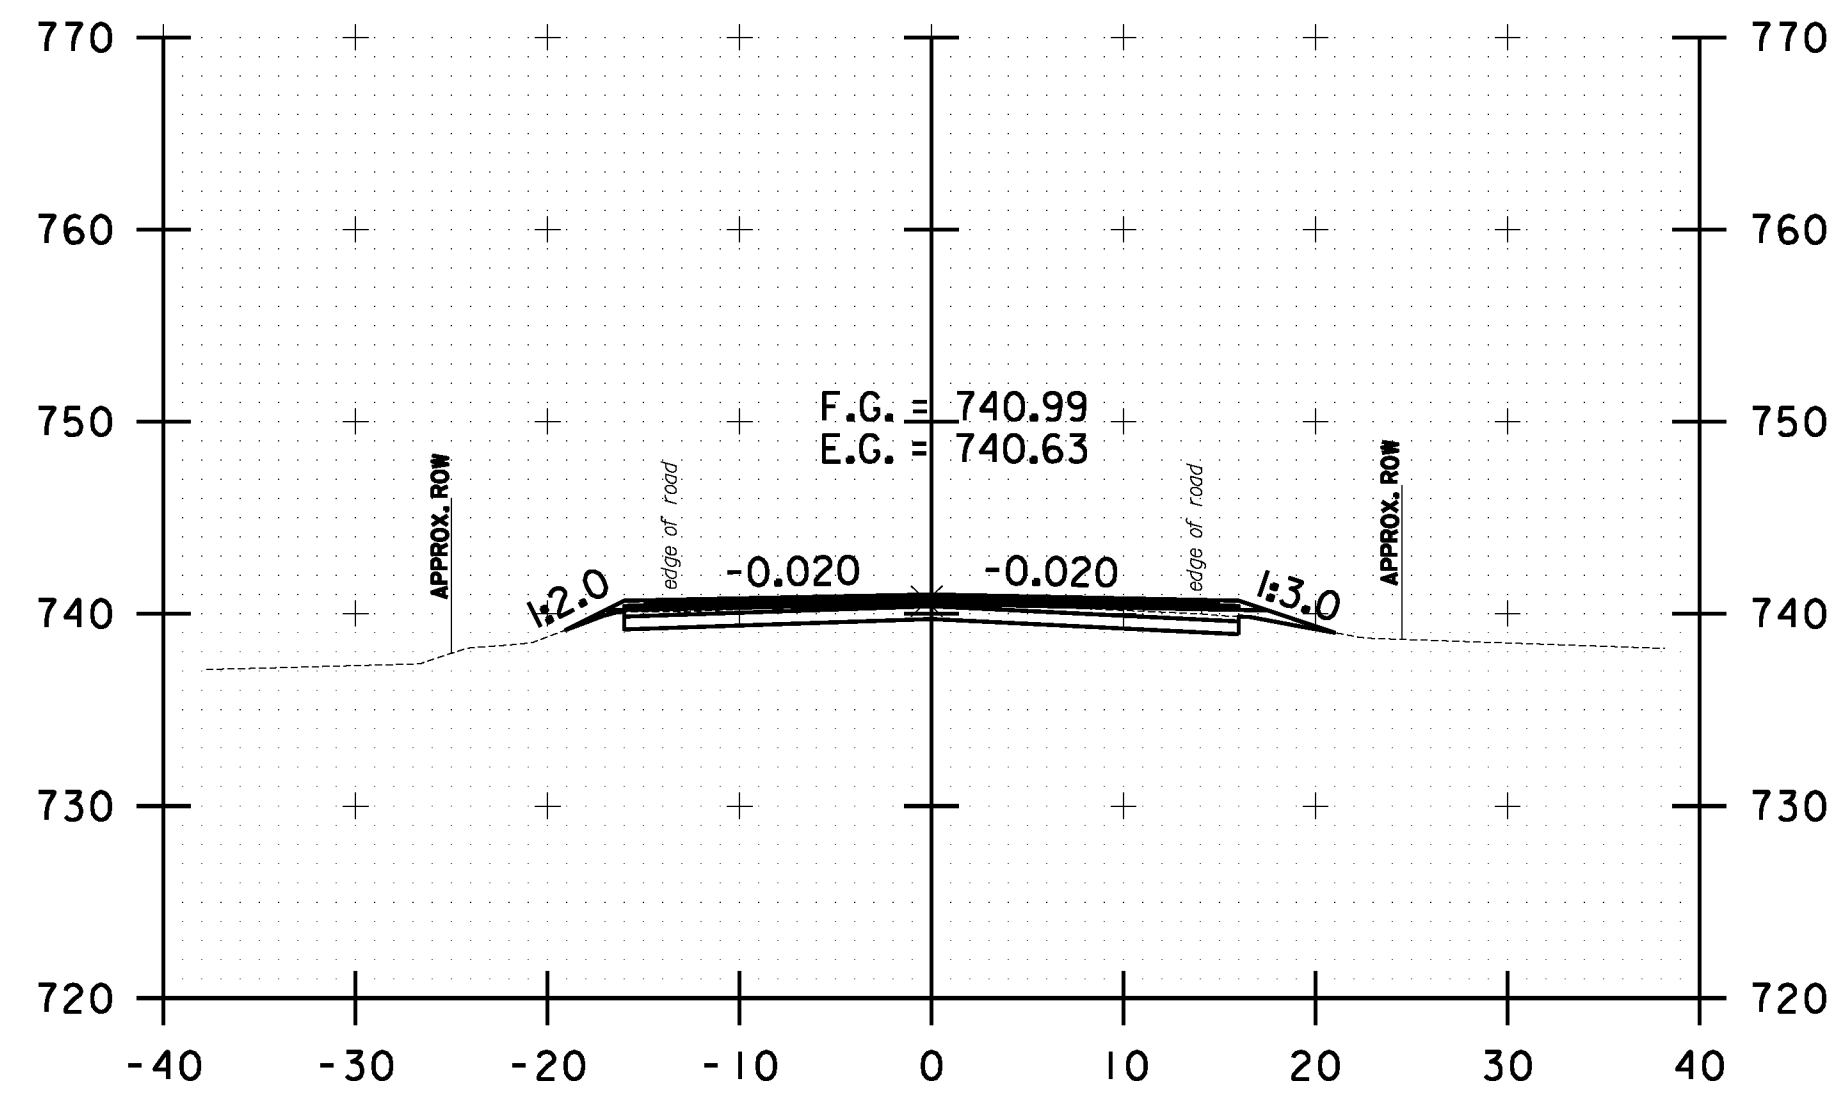

86+00.00

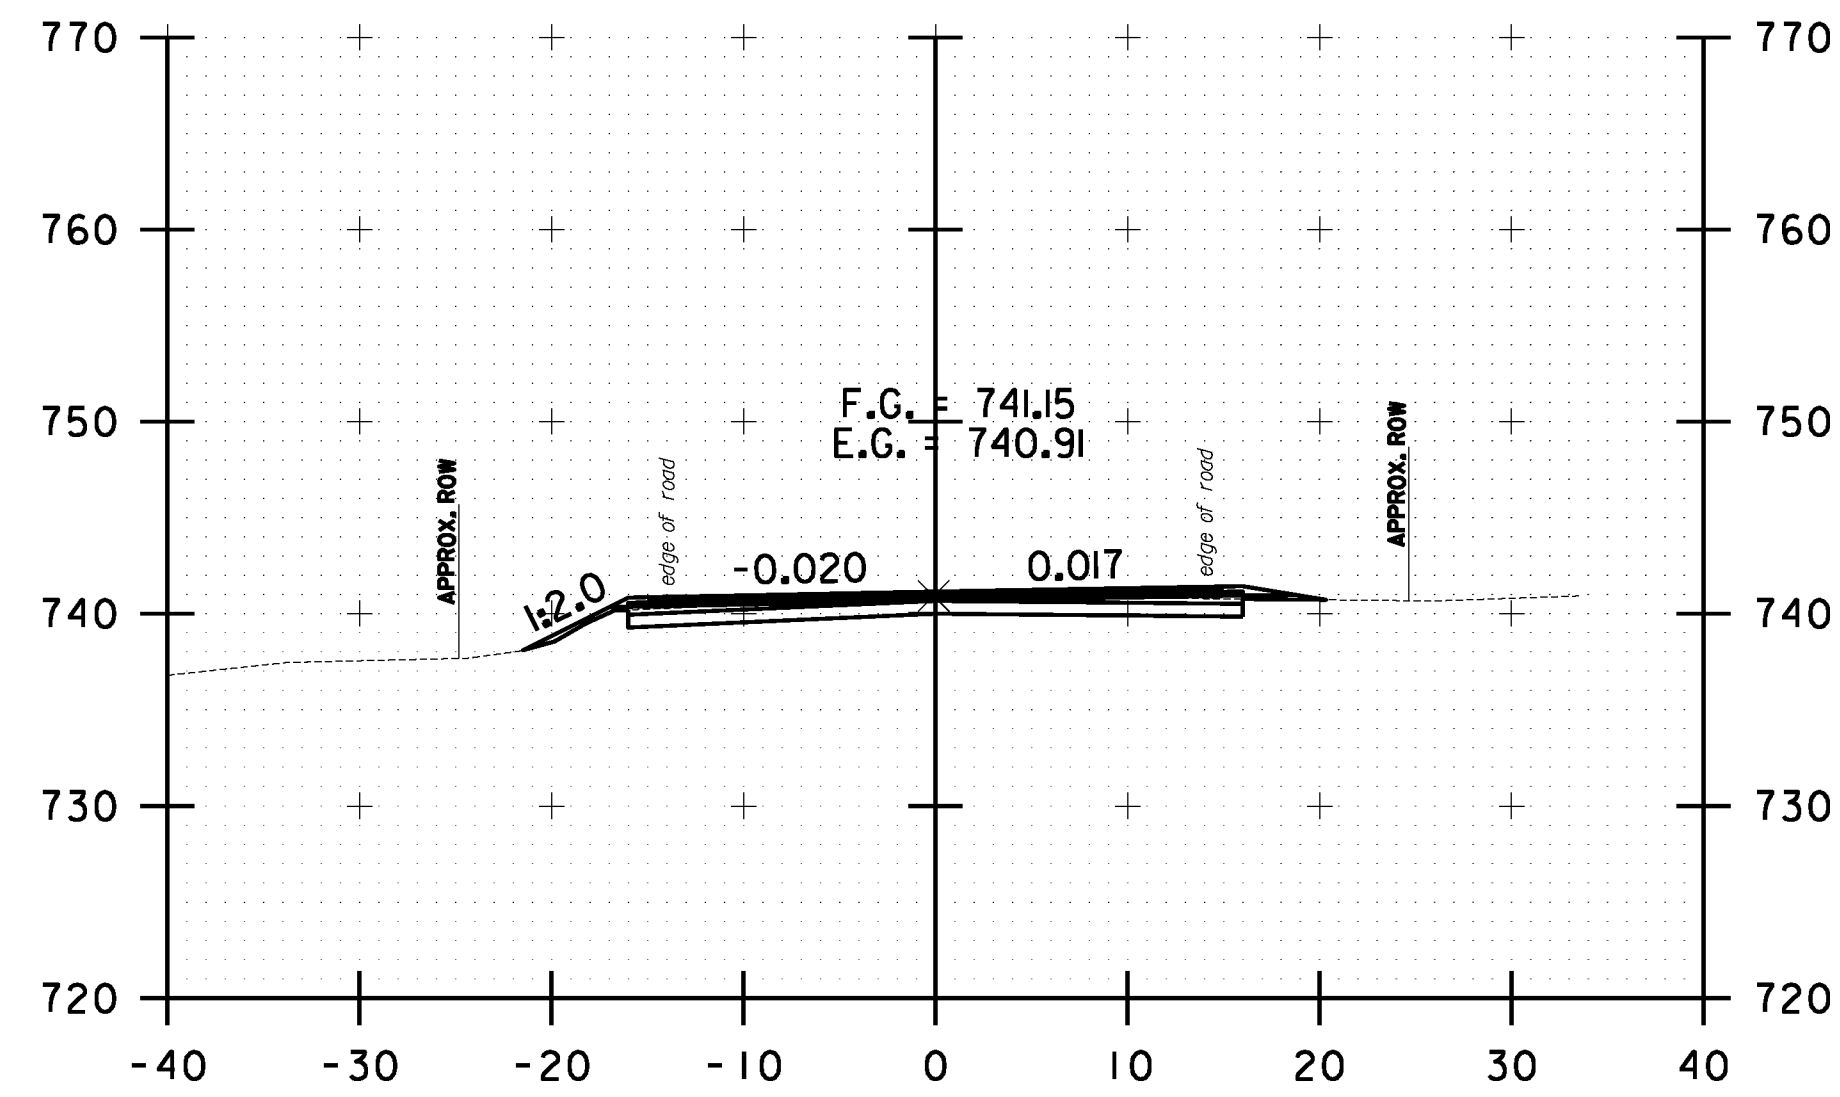

87+00.00



**WAITSFIELD
 CROSS SECTION
 SHEET #27**

PROJECT NAME: WARREN-WAITSFIELD

PROJECT NUMBER: STP 2506(1)

FILE NAME: p05b048.dgn

PROJECT LEADER: D.E.G.

DESIGNED BY: M.J.M.

IPARM FILE: p05b048xsl20.l

PLOT DATE: 12/20/2012

DRAWN BY: W.G.P.

CHECKED BY: D.E.G.

SHEET 283 OF 310