




FILE NAME: U:\1762\CA00\MST\STP_2506\p05b048_Conv.eest_Plane.dgn
 DATE/TIME: 12/20/2012
 USER: 4866

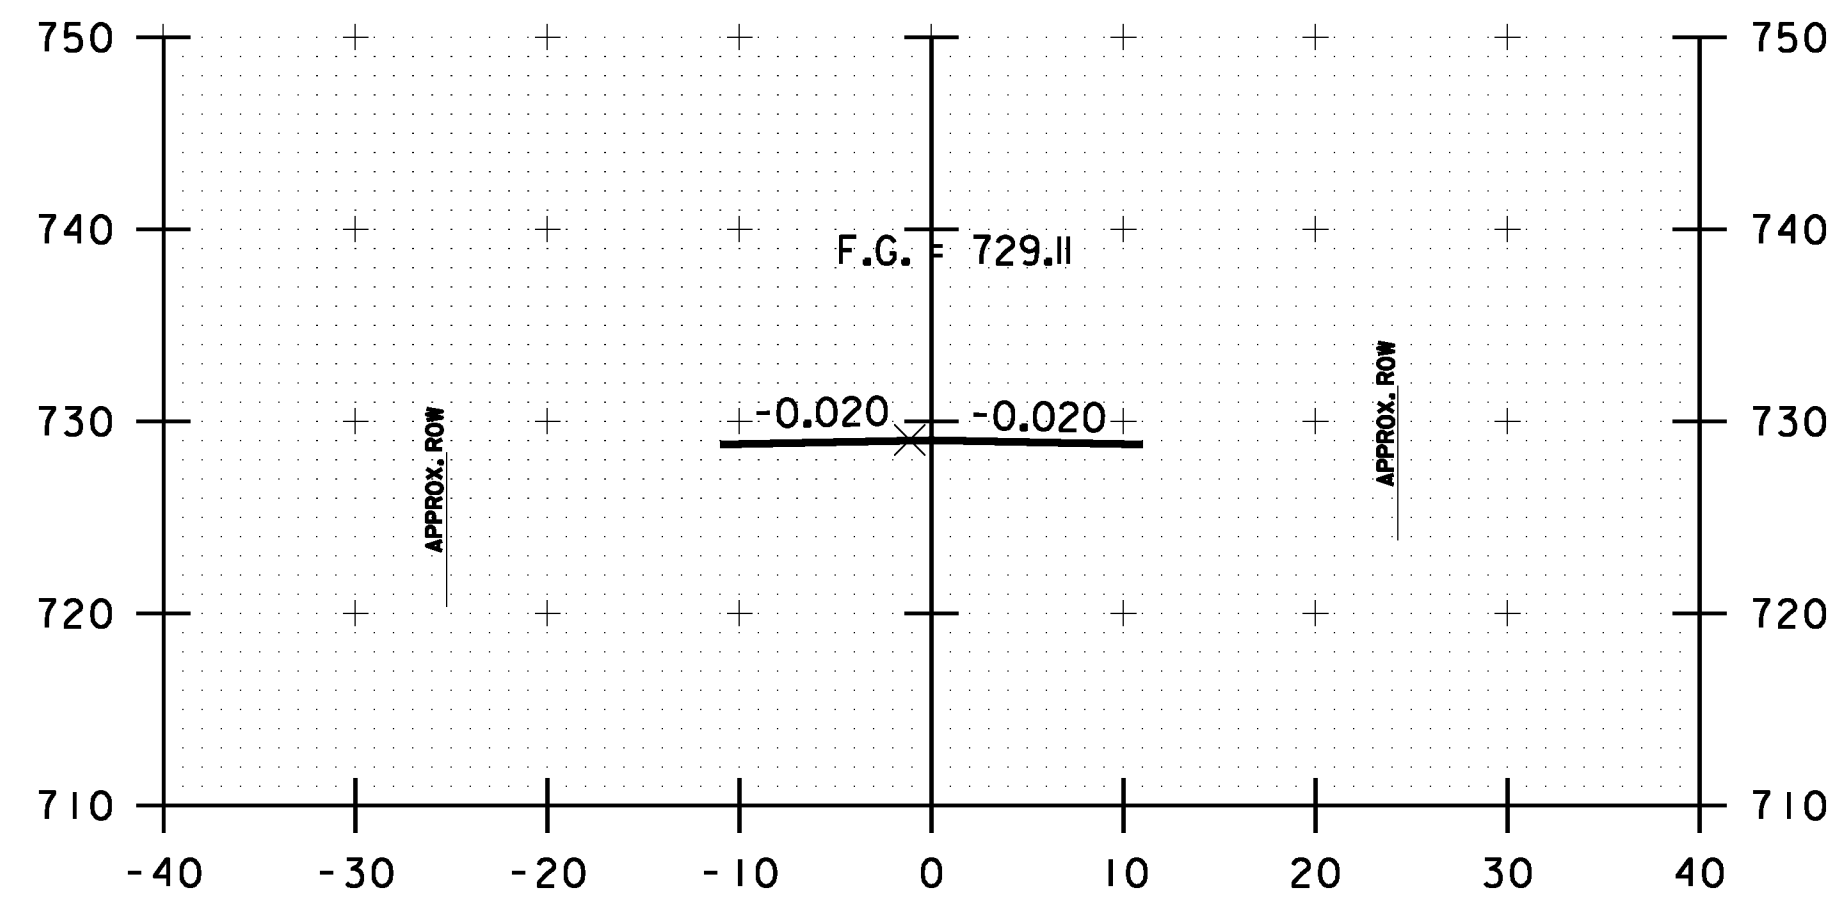


102+00.00

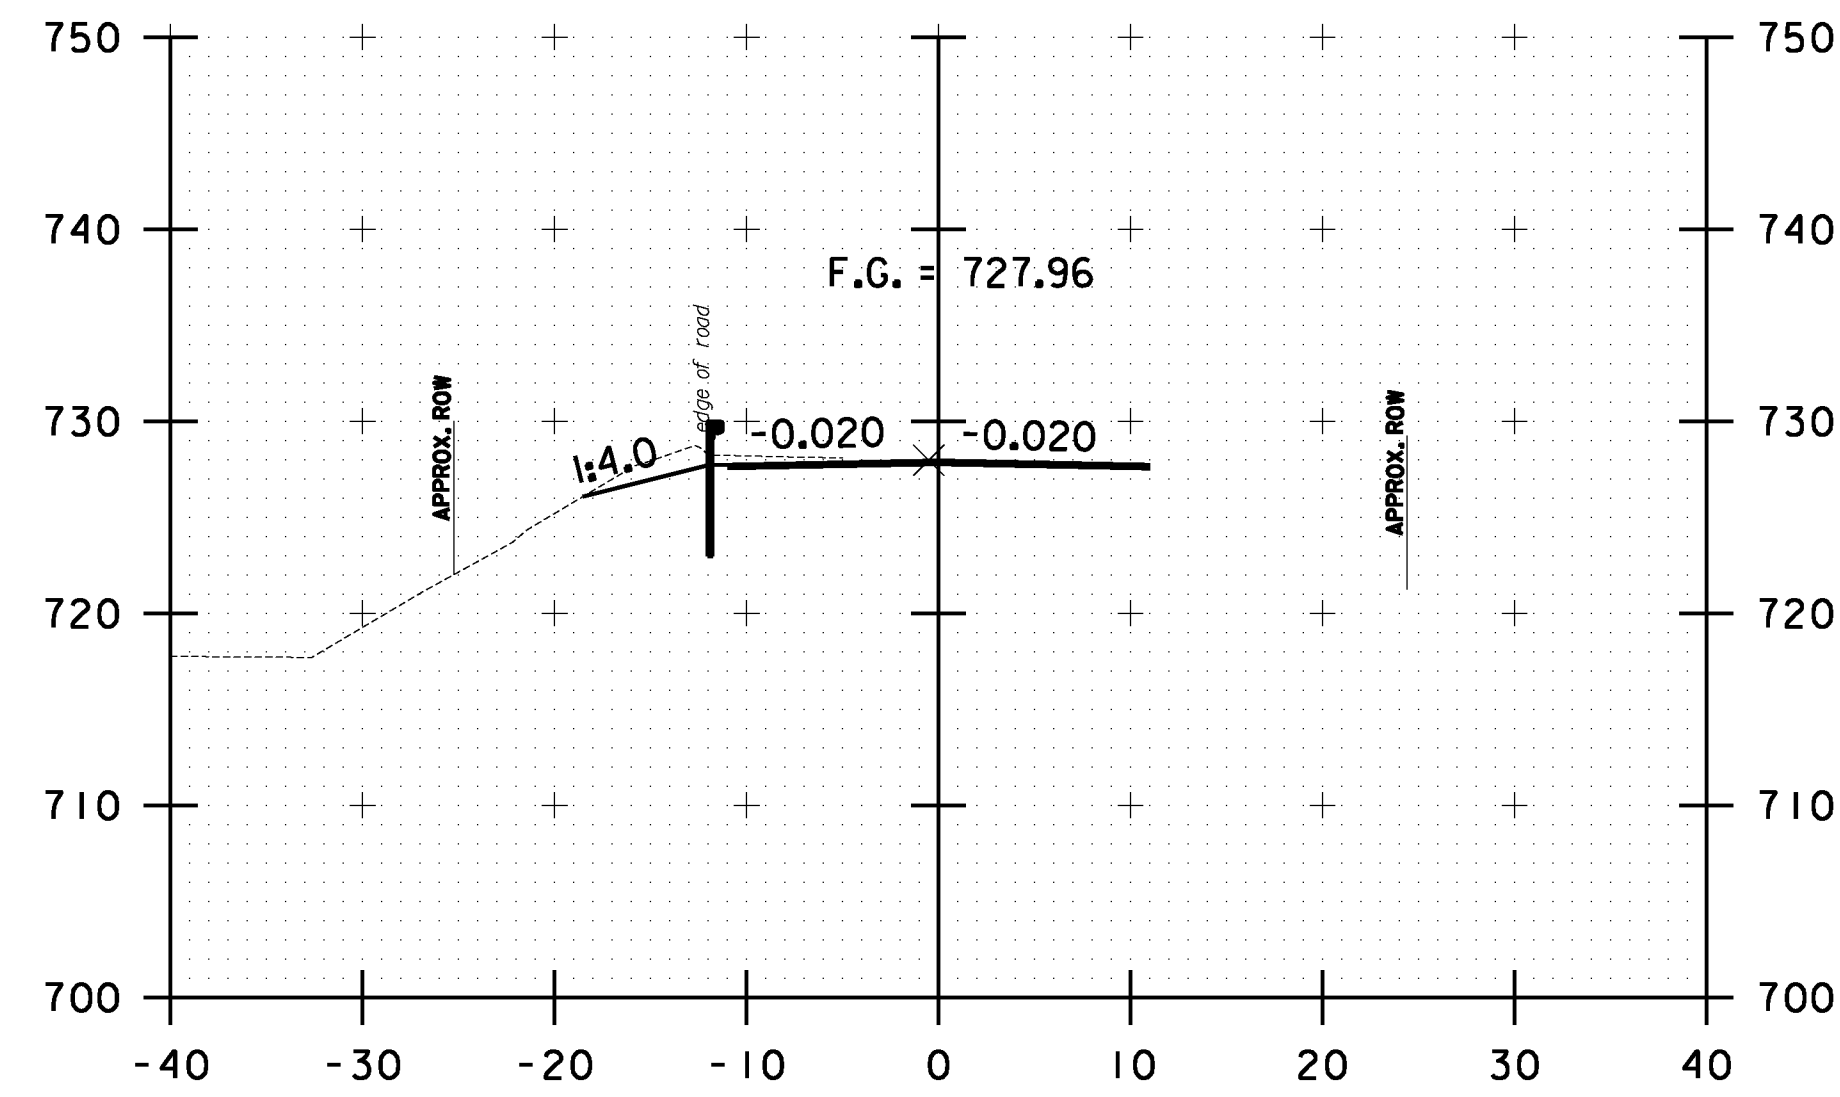


103+00.00

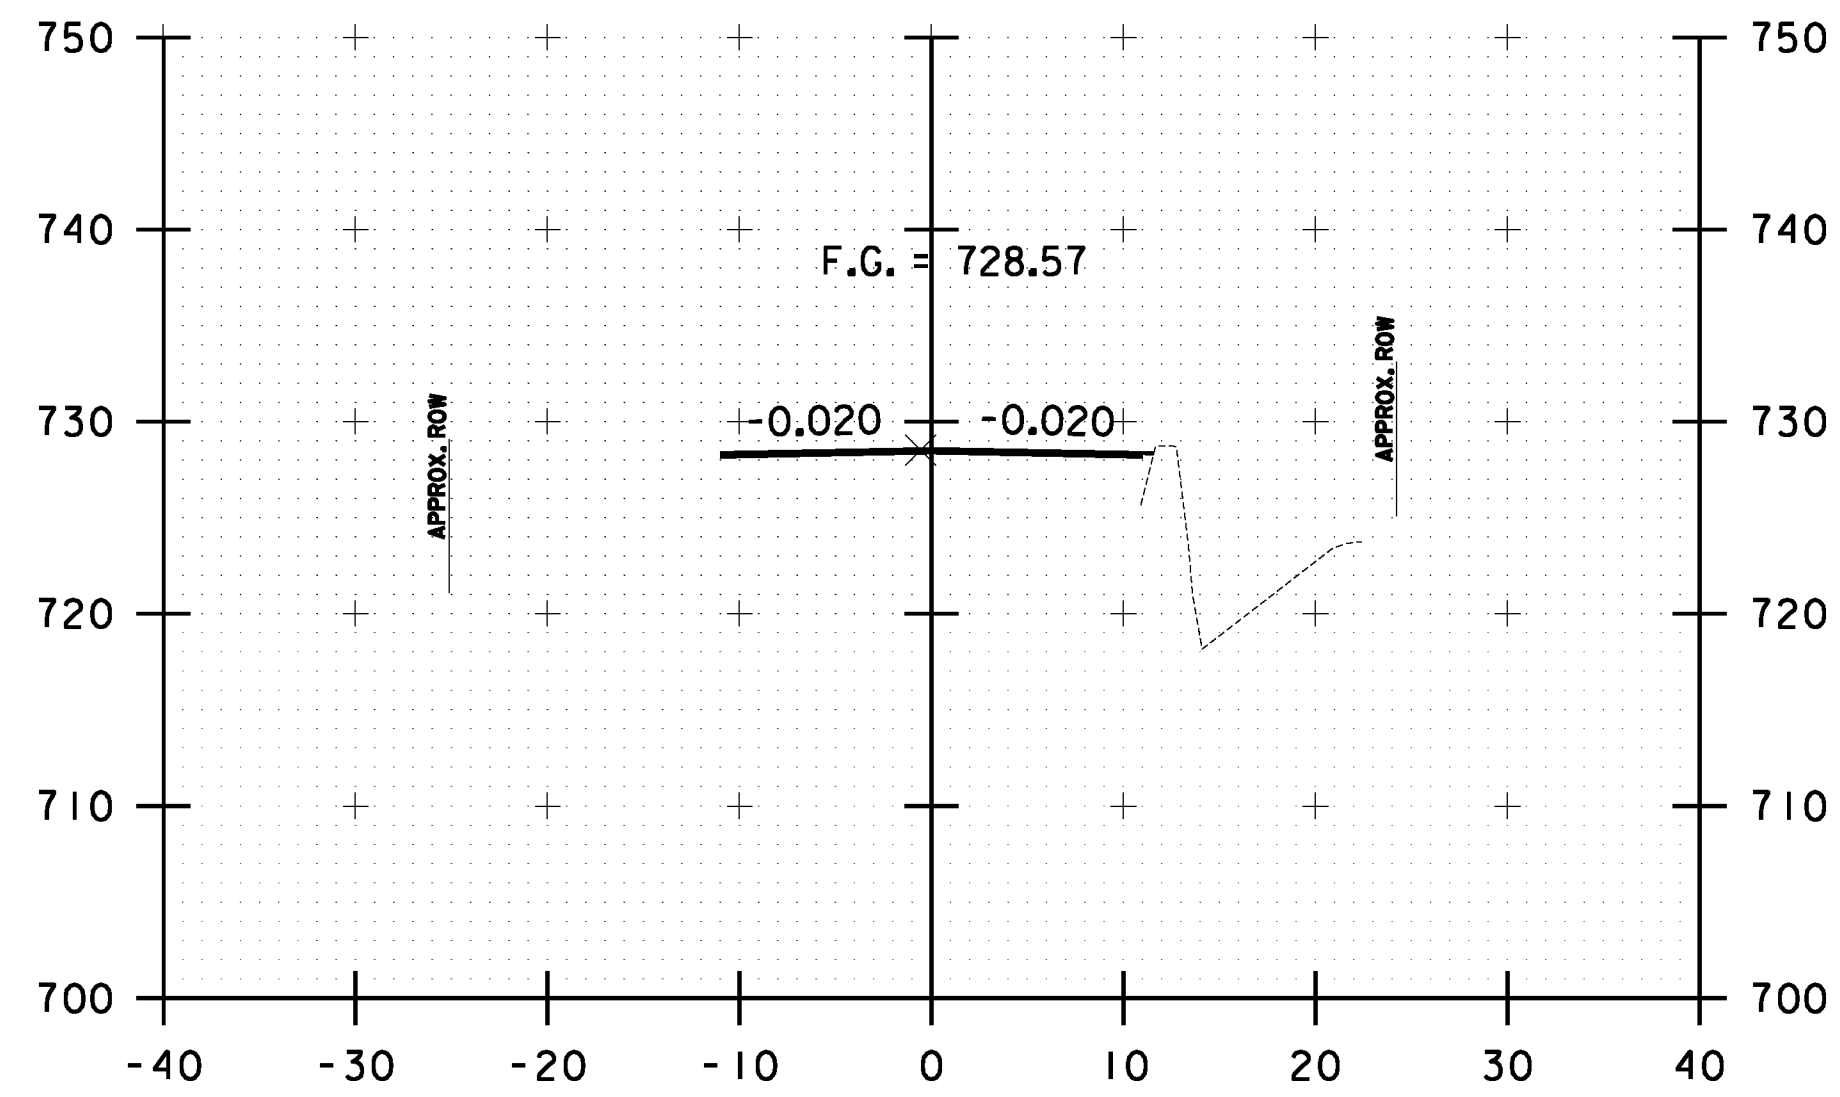


101+50.00

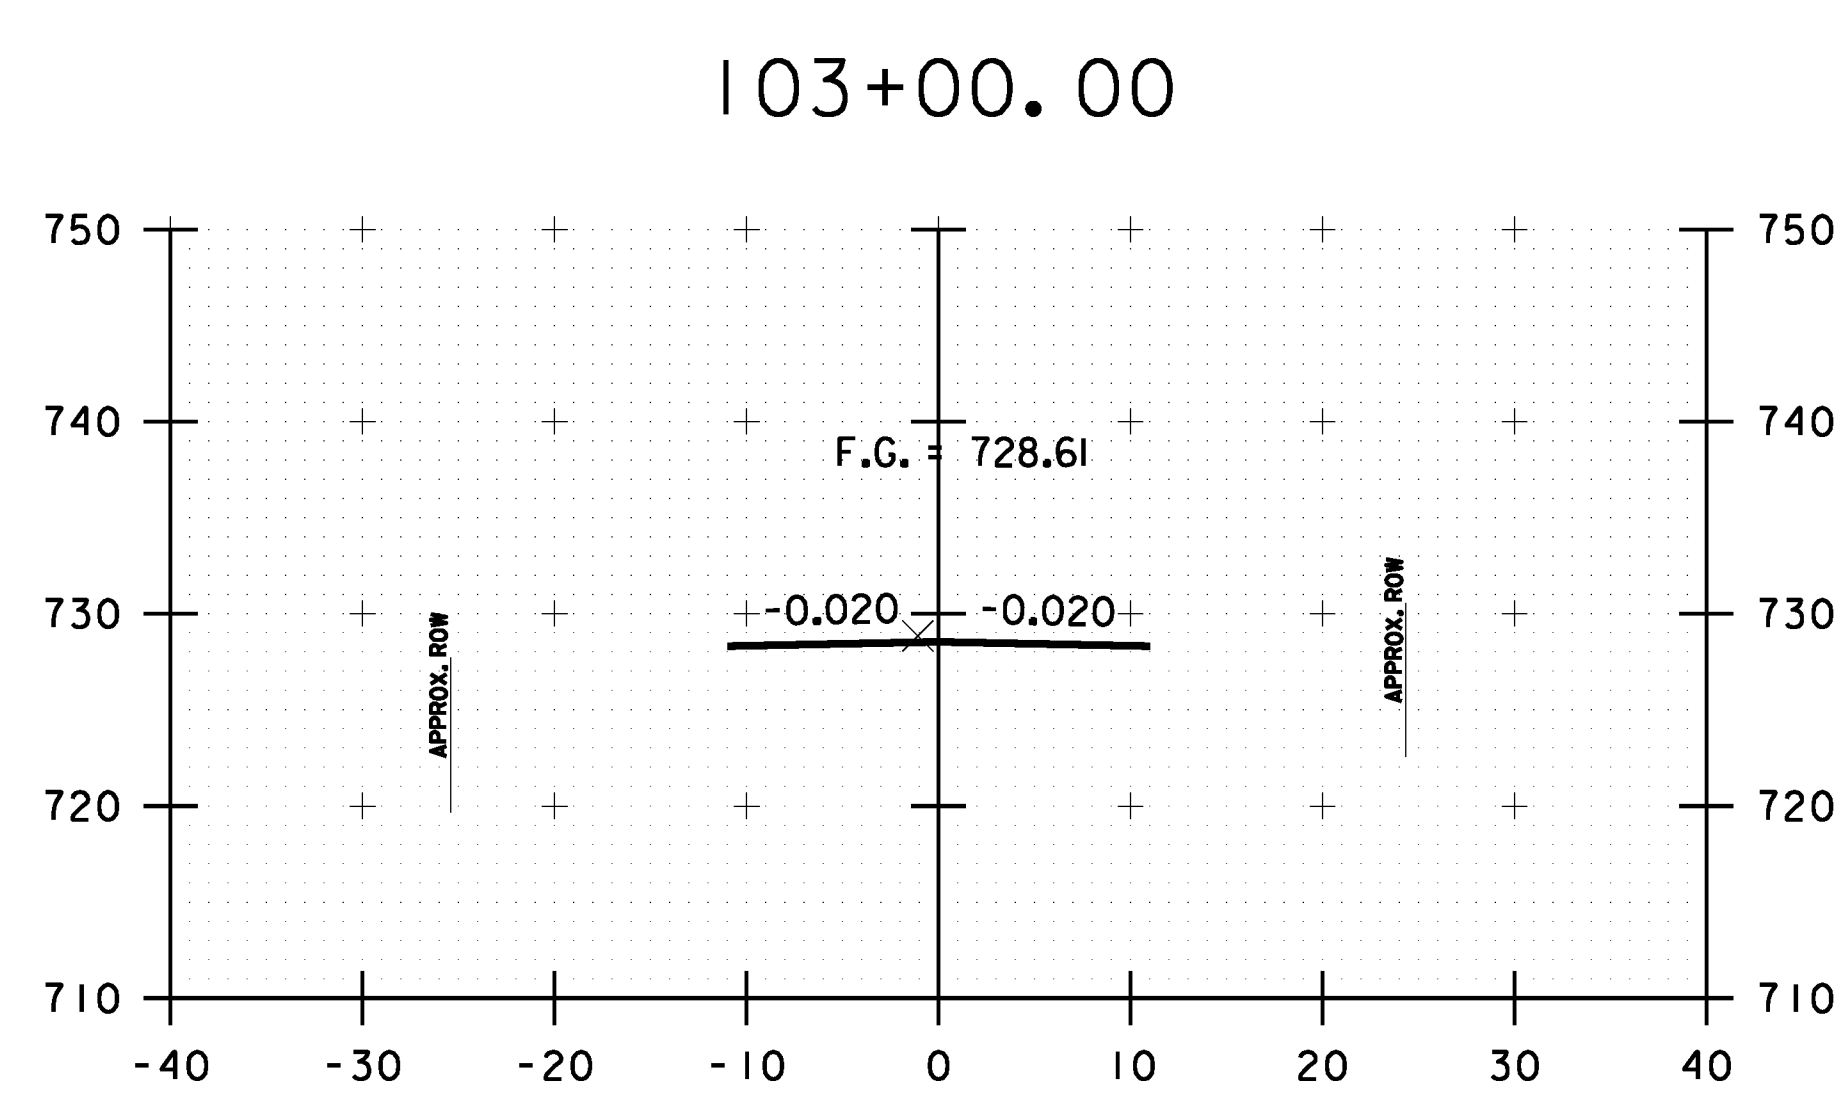

102+50.00

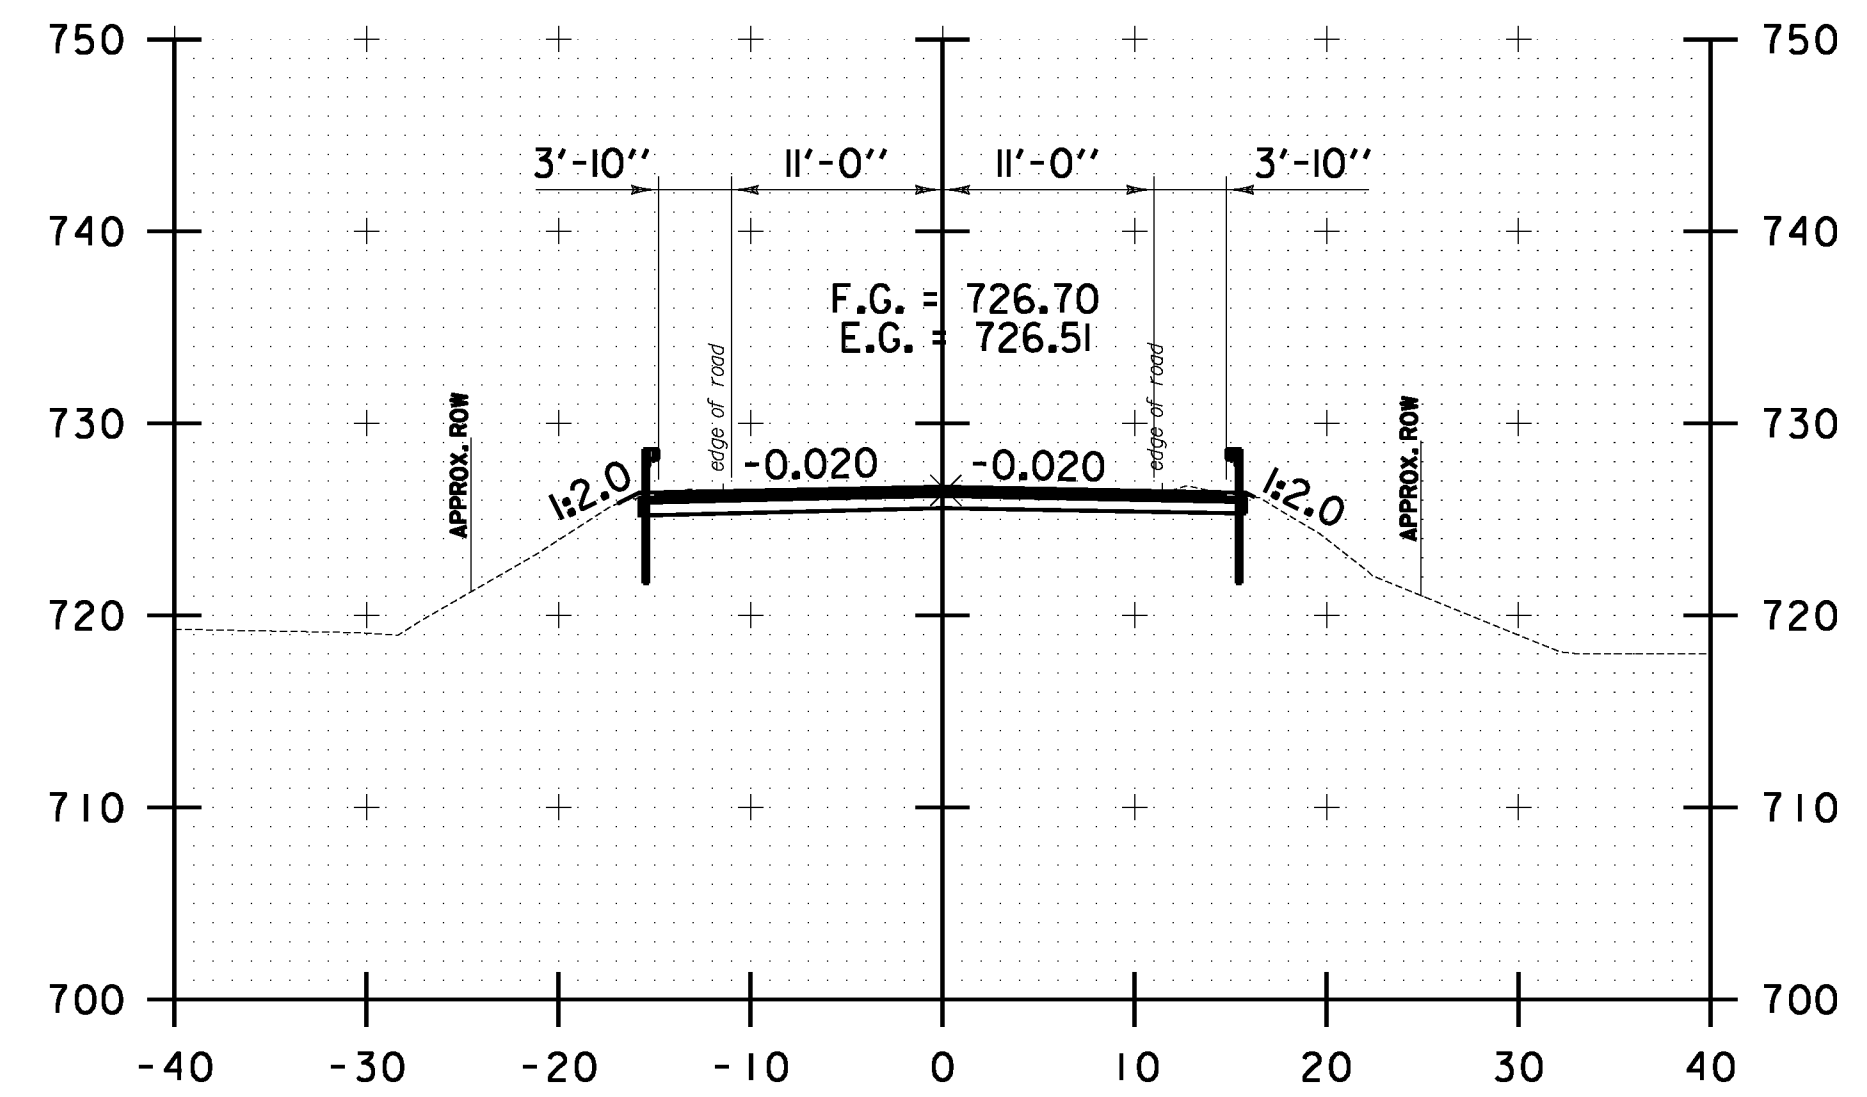

104+00.00

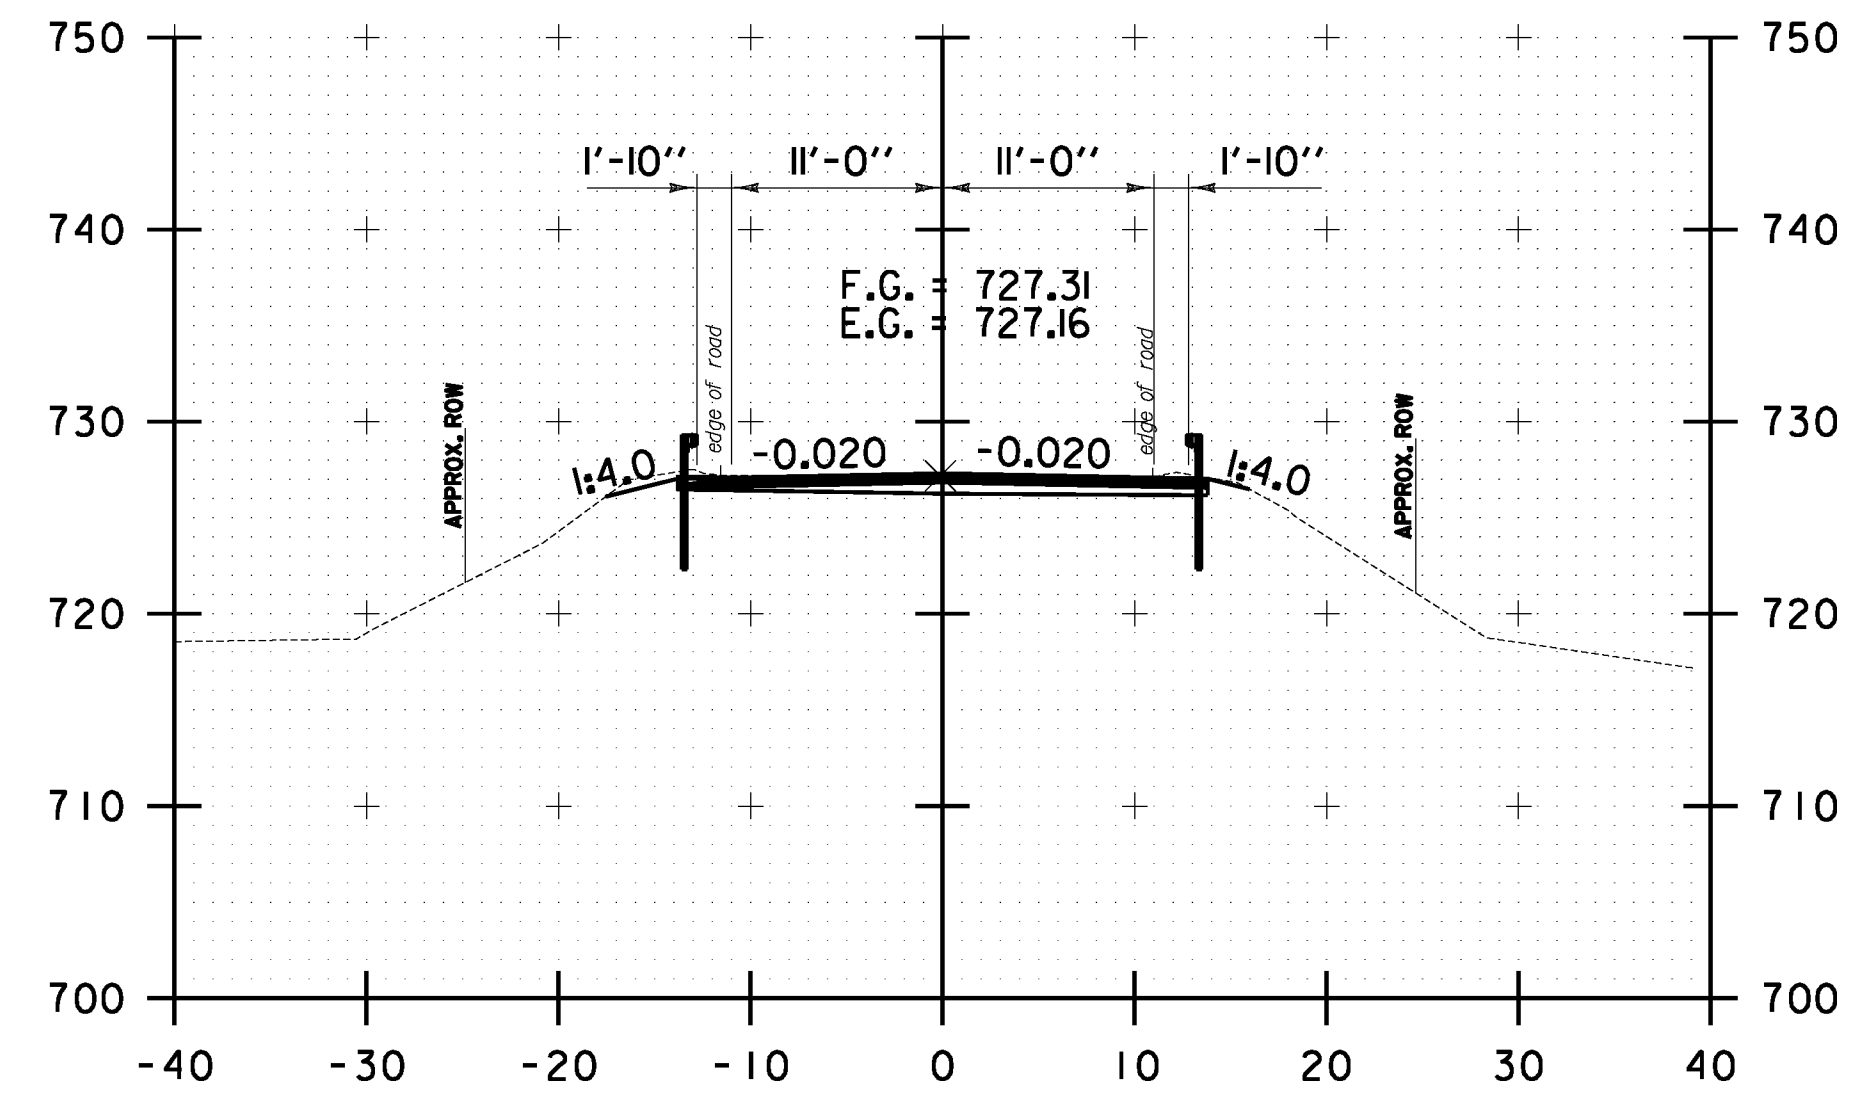

103+50.00



**WAITSFIELD
 CROSS SECTION
 SHEET #32**

PROJECT NAME: WARREN-WAITSFIELD

PROJECT NUMBER: STP 2506(1)

FILE NAME: p05b048.dgn

PROJECT LEADER: D.E.G.

DESIGNED BY: M.J.M.

IPARM FILE: p05b048.xsl25.l

PLOT DATE: 12/20/2012

DRAWN BY: W.G.P.

CHECKED BY: D.E.G.

SHEET 288 OF 310