




FILE NAME: U:\1762\CADD\MSTN\STP_2506\p05b048.Convect_Plan.dgn
 DATE/TIME: 12/20/2012
 USER: 4866

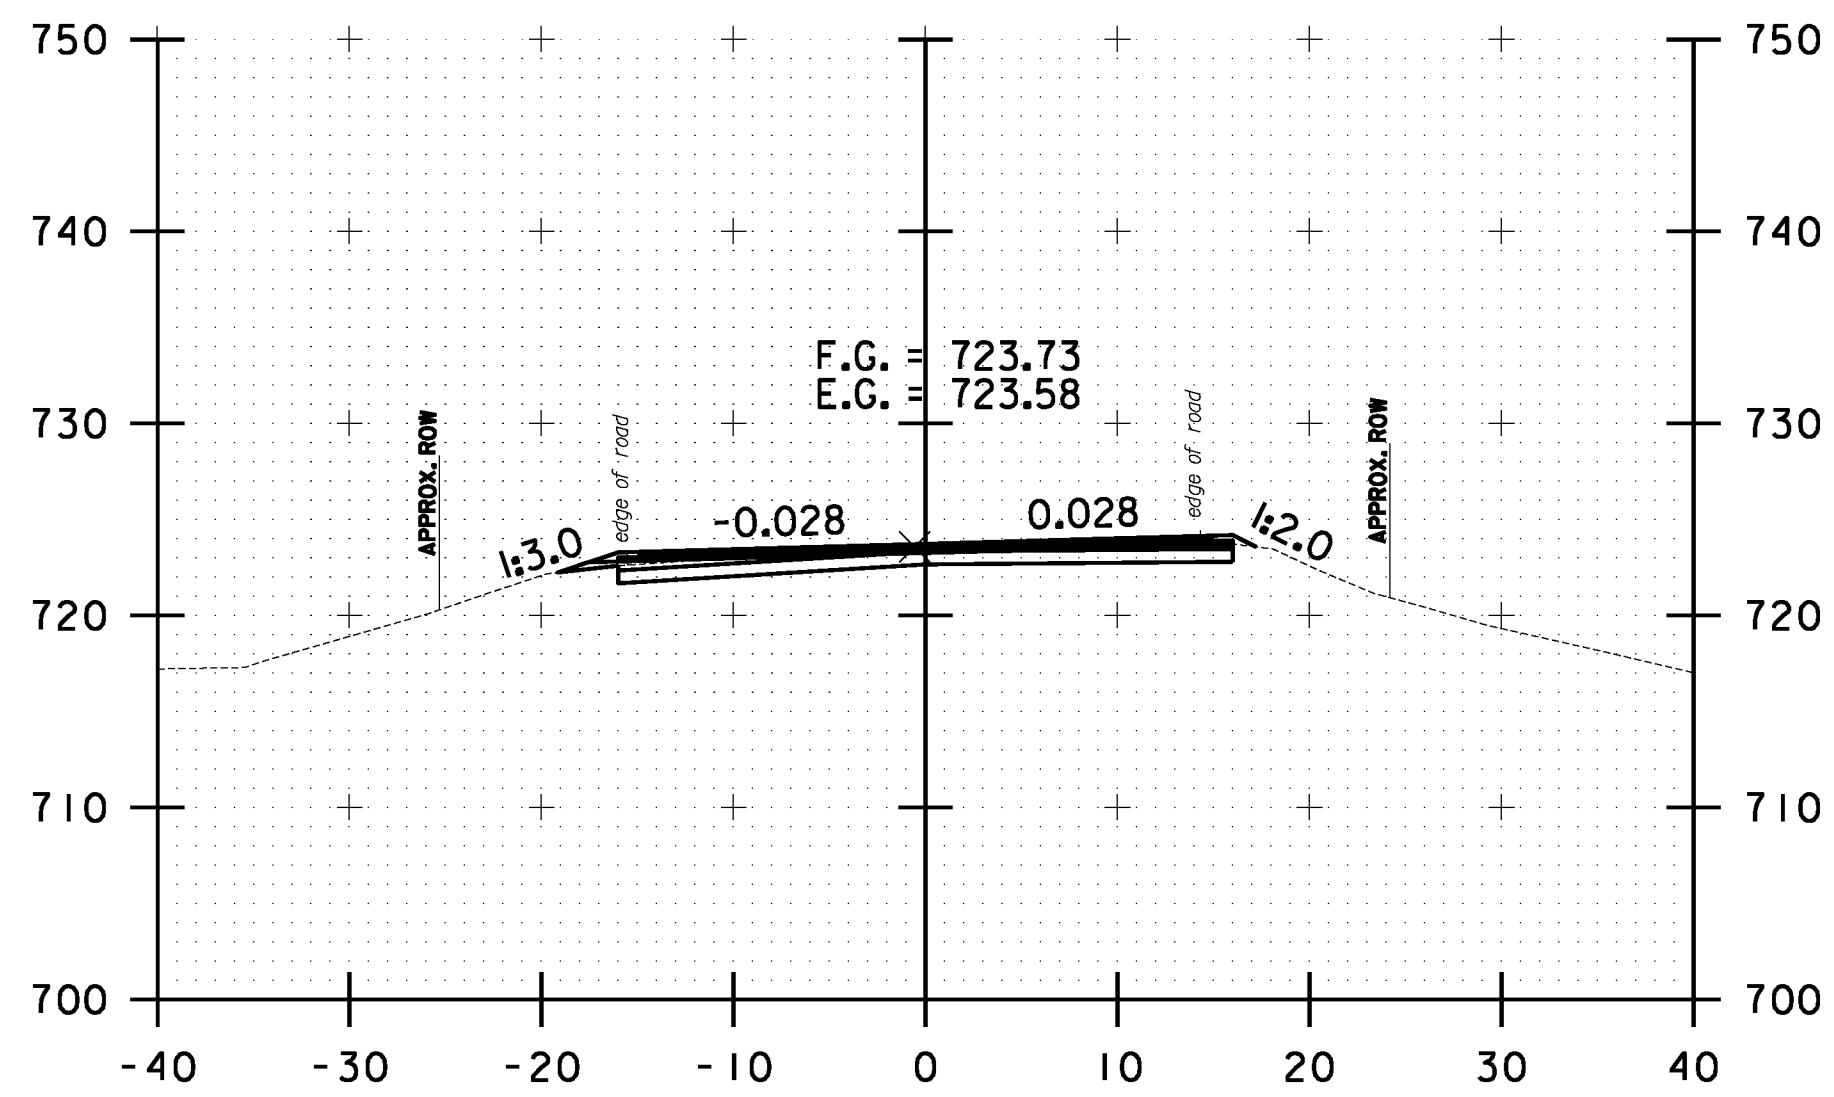


117+00.00

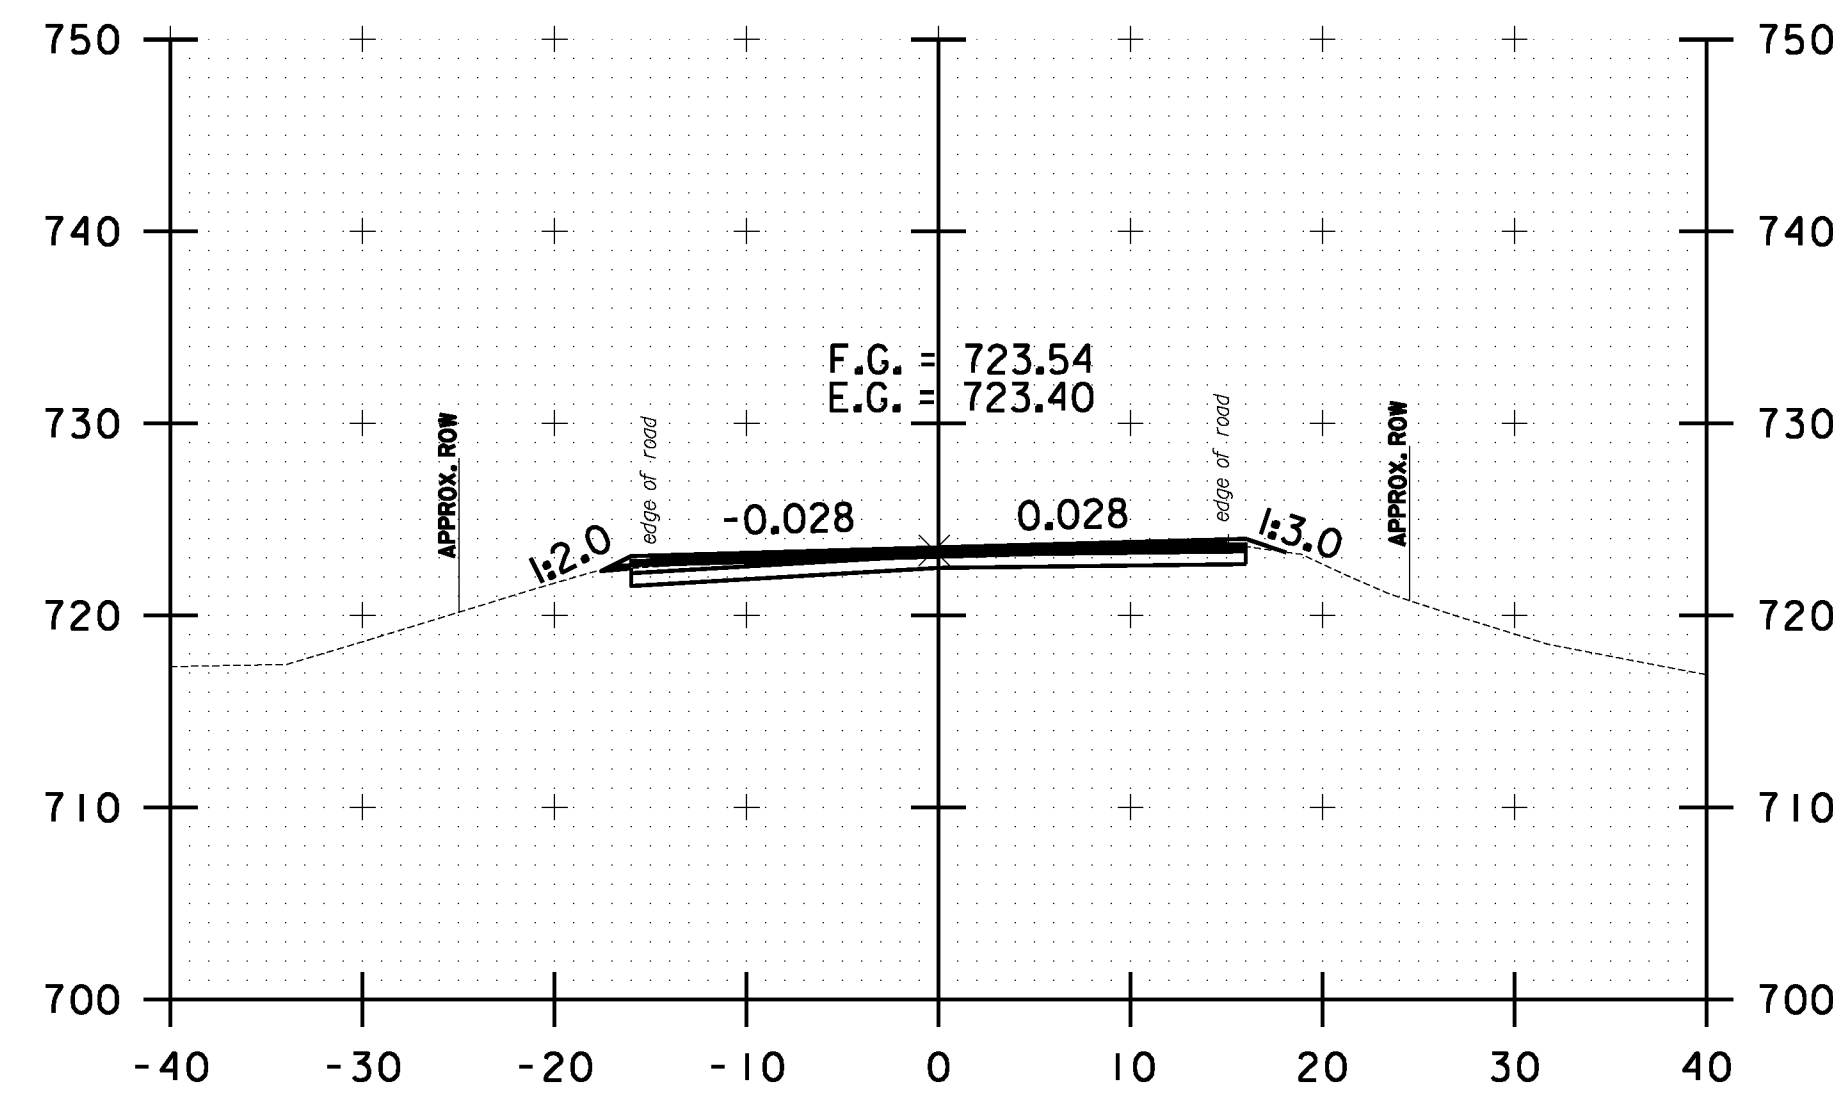


118+00.00

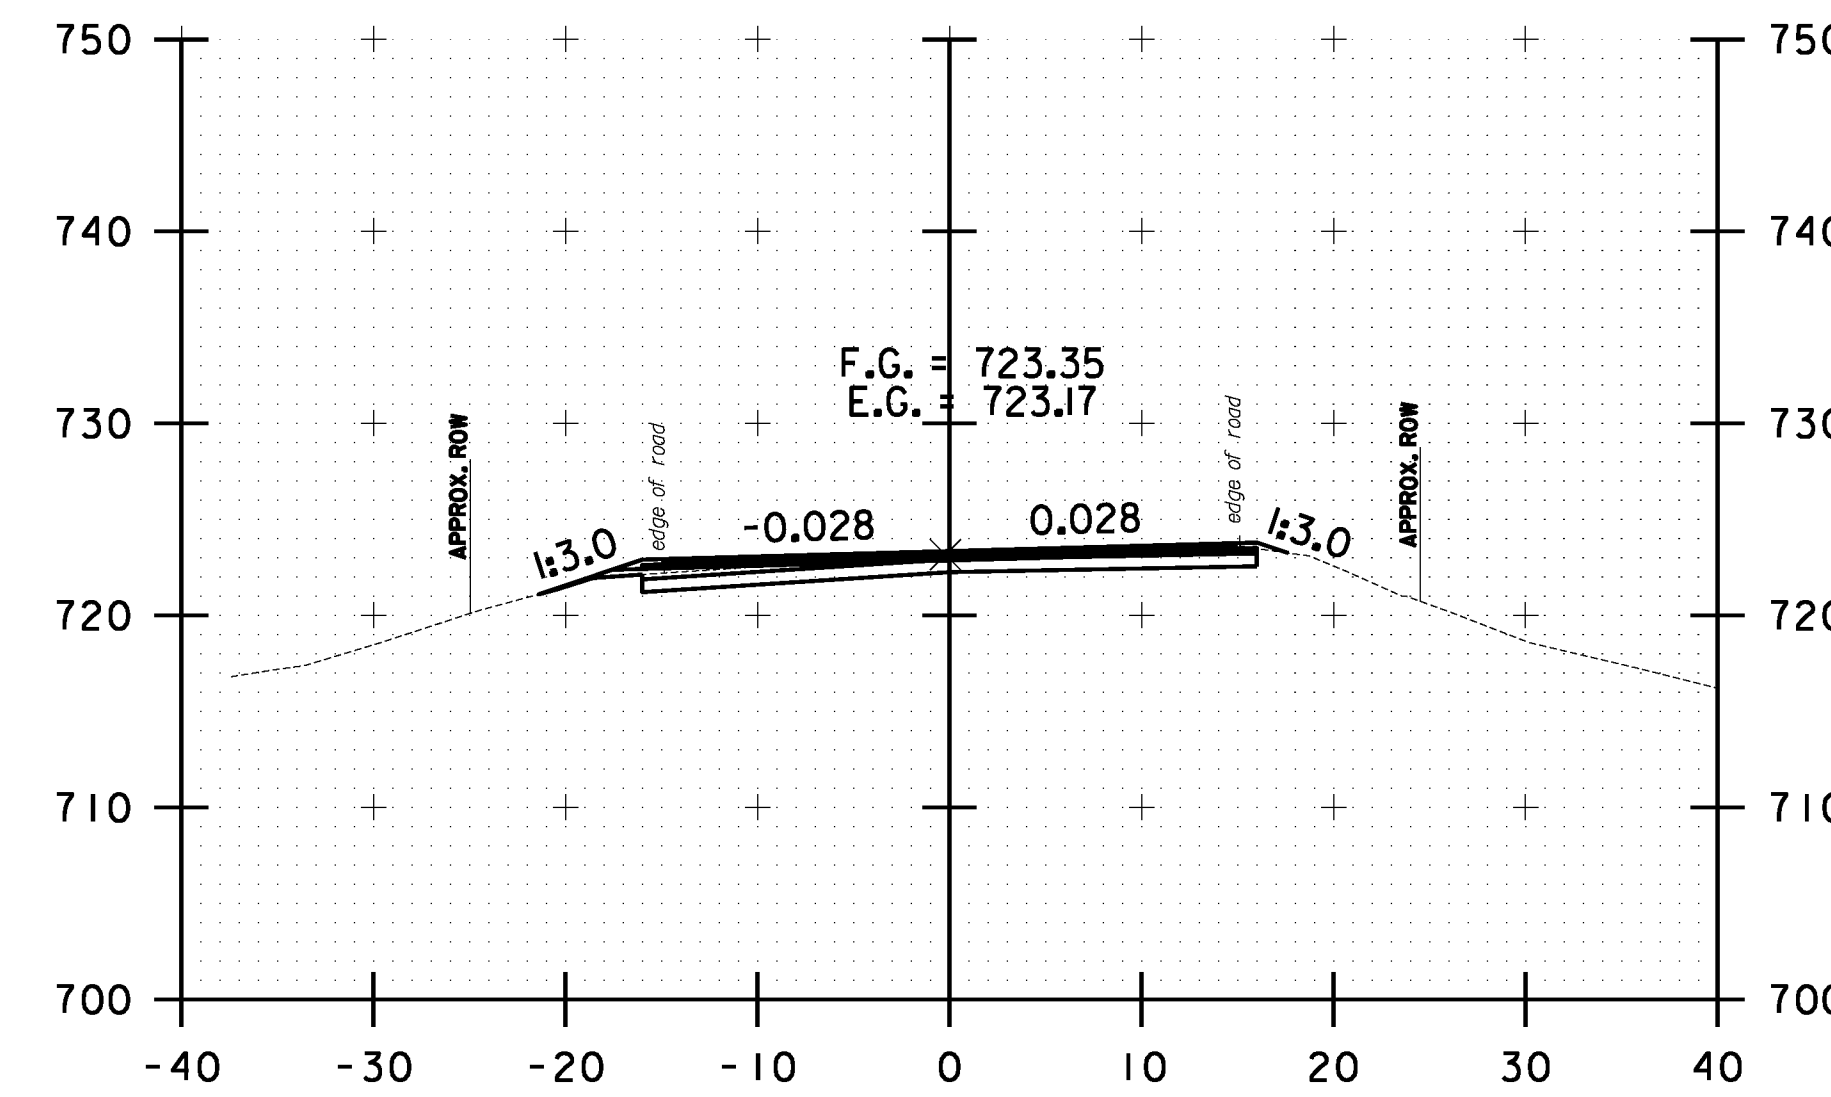


119+00.00

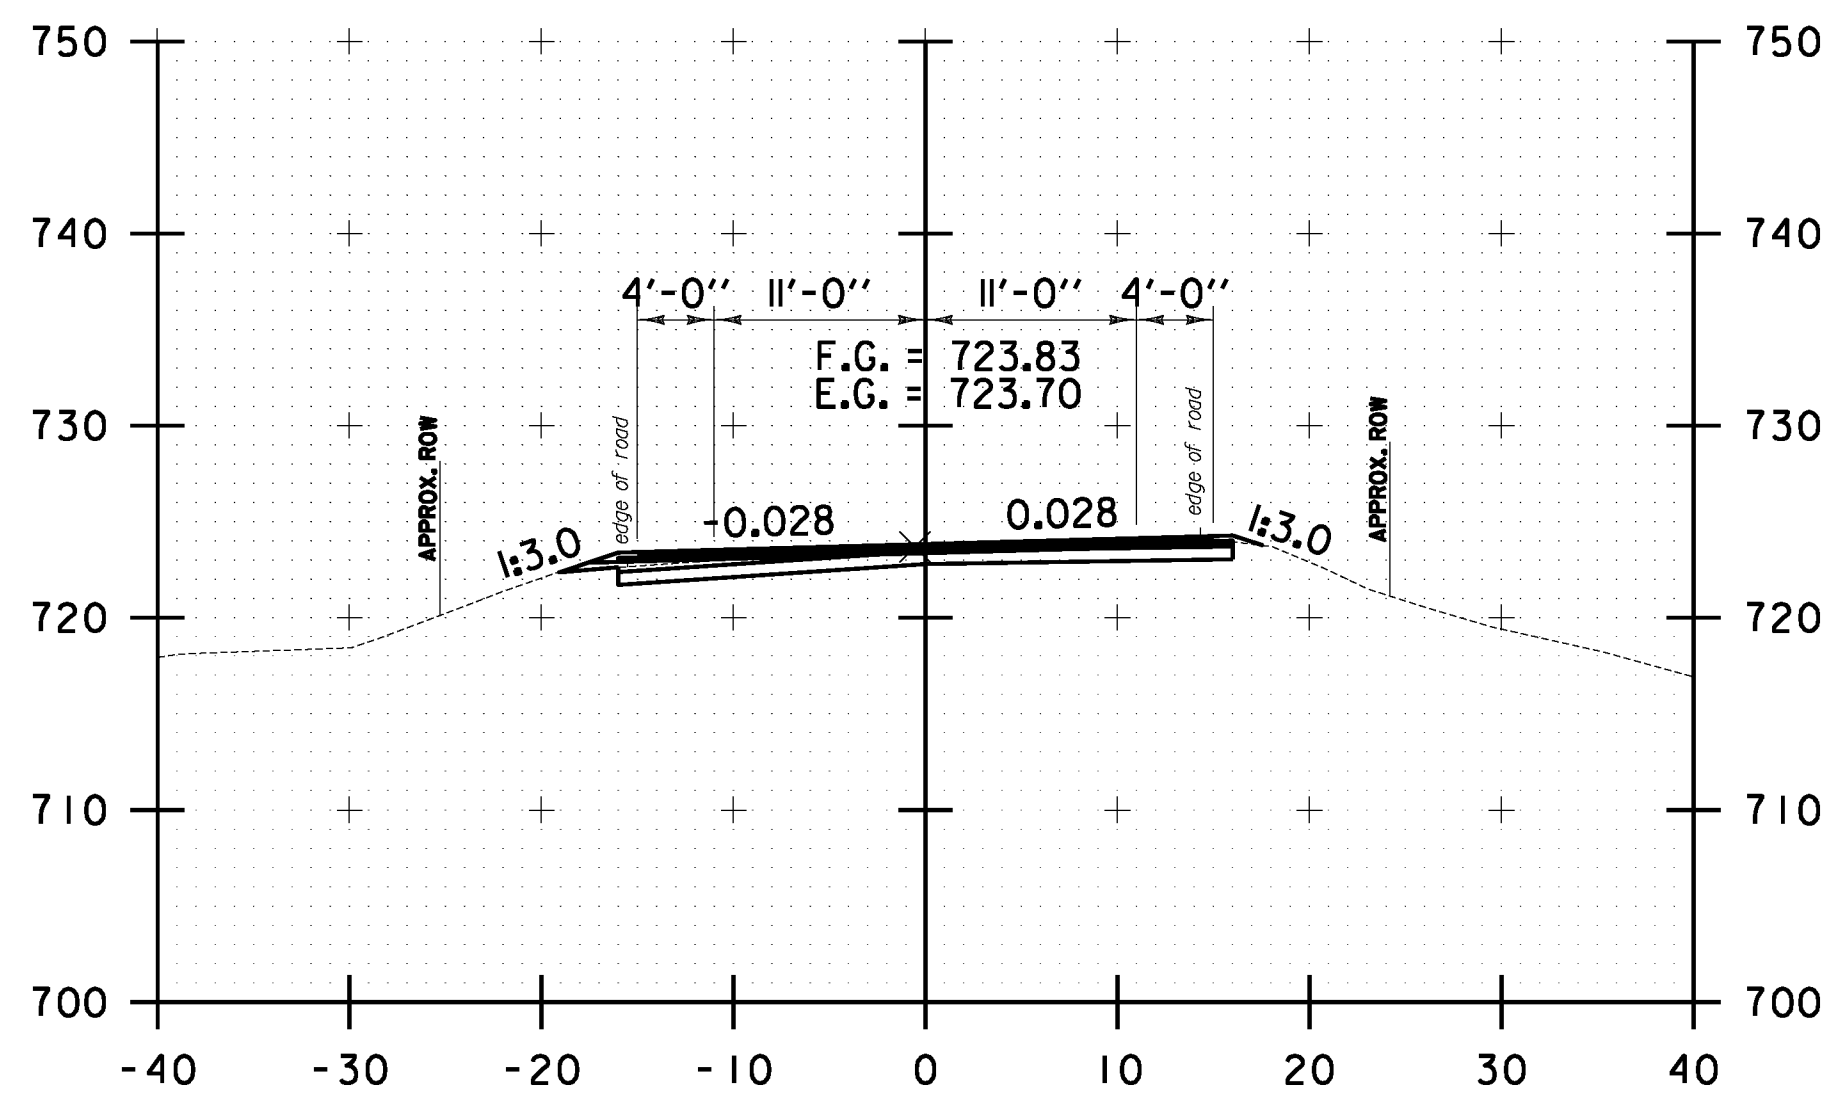

116+50.00

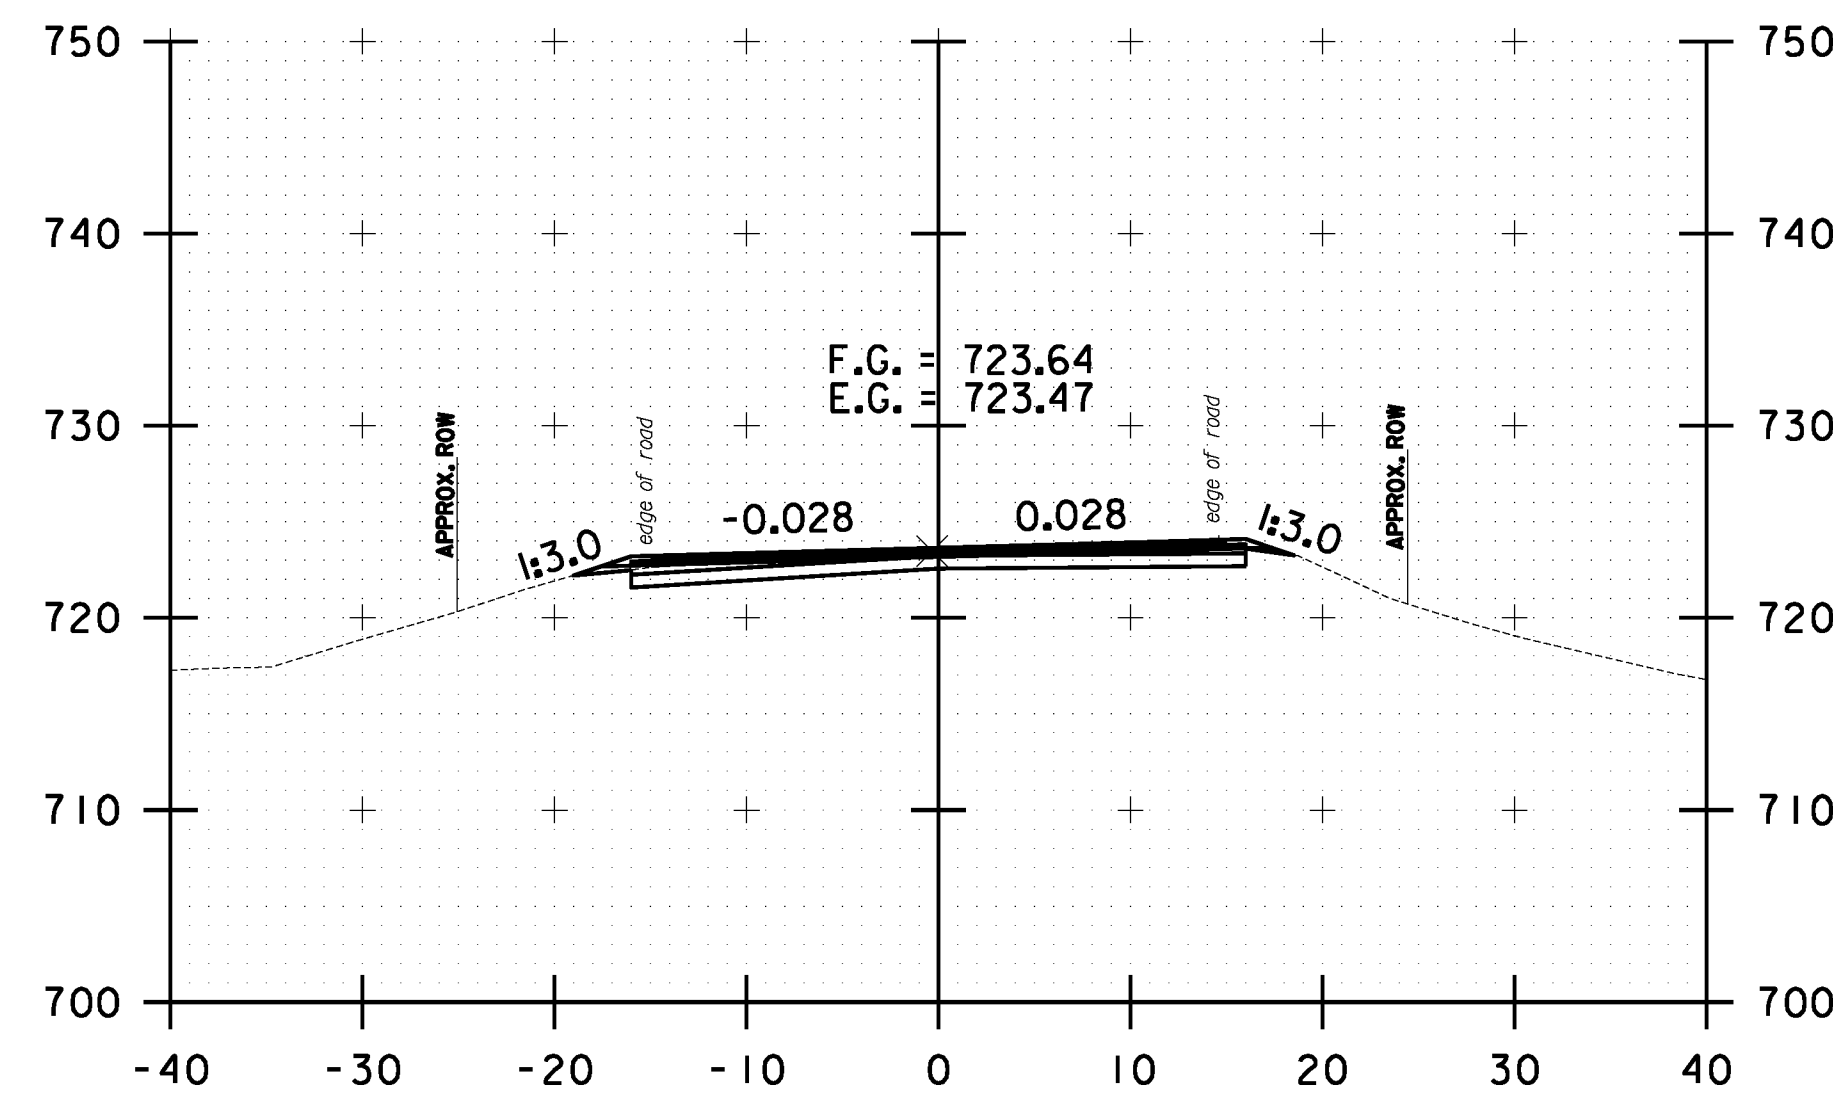

117+50.00

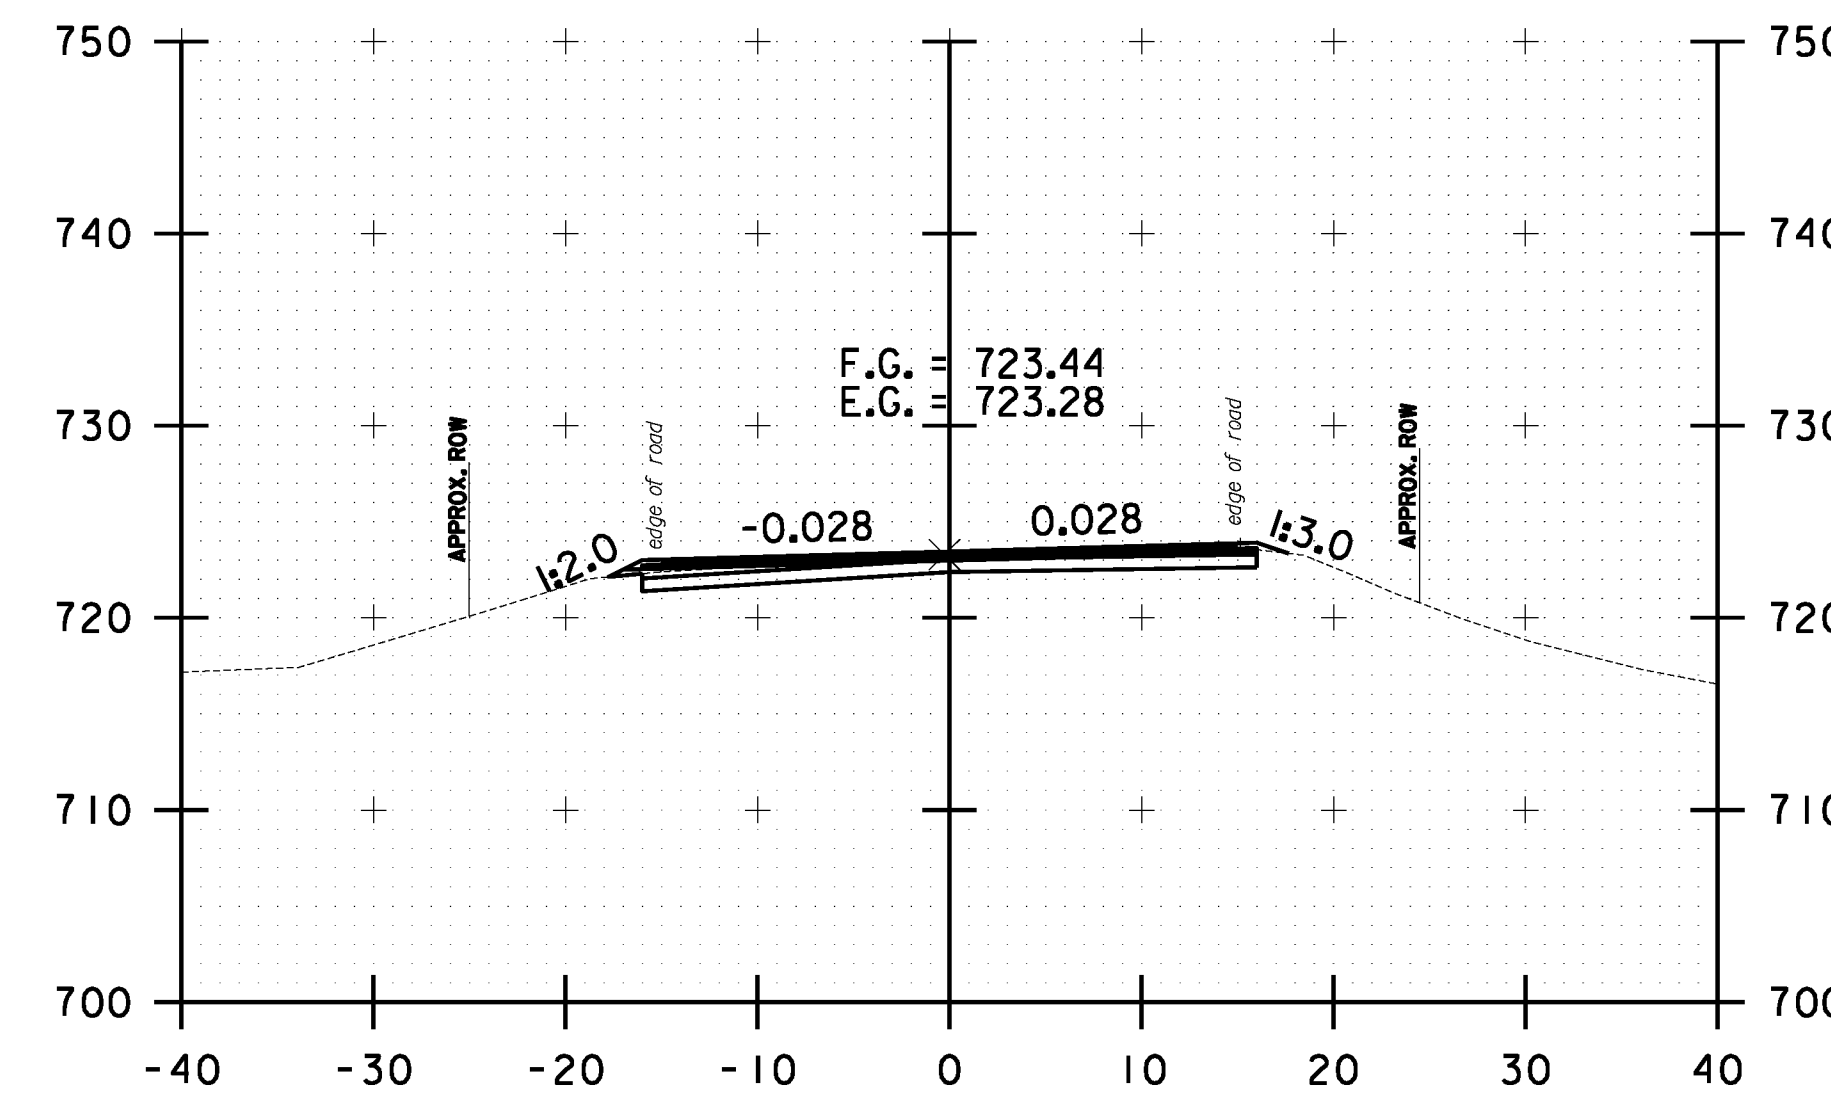

118+50.00



**WAITSFIELD
 CROSS SECTION
 SHEET #37**

PROJECT NAME: WARREN-WAITSFIELD

PROJECT NUMBER: STP 2506(1)

FILE NAME: p05b048.dgn

PROJECT LEADER: D.E.G.

DESIGNED BY: M.J.M.

IPARM FILE: p05b048xsl30.l

PLOT DATE: 12/20/2012

DRAWN BY: W.G.P.

CHECKED BY: D.E.G.

SHEET 293 OF 310