


CURVE # 13
 Δ 23°20'43"RT
 R = 1150'
 D = 4°58'56"
 T = 238'
 L = 469'
 BANKING 0.071 FT./FT.
 170' RUNOFF (50 MPH)
 SEE SHEET 26 FOR BANKING DETAIL

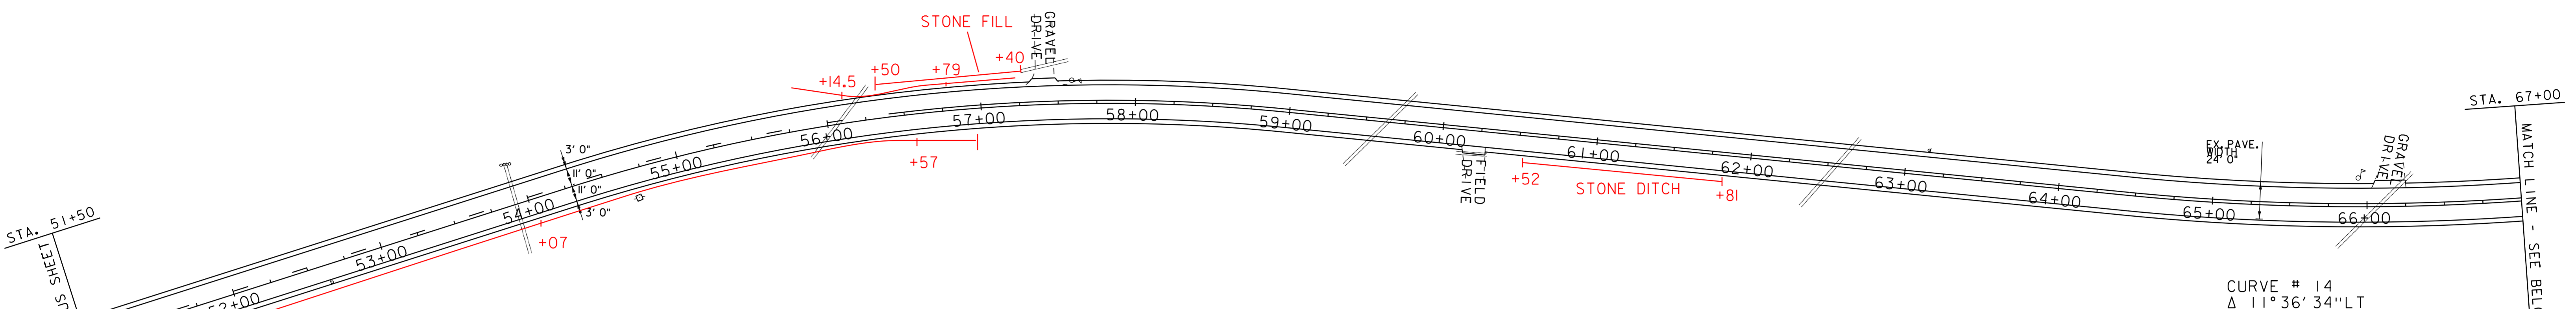


646.402 DURABLE 4" WHITE LINE, THERMOPLASTIC
 STA. 51+50 - STA. 67+00 (SOLID LT & RT)
 646.412 DURABLE 4" YELLOW LINE, THERMOPLASTIC
 STA. 51+50 - STA. 67+00 (SOLID RT)
 STA. 51+50 - STA. 56+50 (DASHED LT)
 STA. 56+50 - STA. 67+00 (SOLID LT)
 646.602 TEMPORARY 4" WHITE LINE, PAINT
 STA. 51+50 - STA. 67+00 (SOLID LT & RT)
 646.612 TEMPORARY 4" YELLOW LINE, PAINT
 STA. 51+50 - STA. 67+00 (SOLID RT)
 STA. 51+50 - STA. 56+50 (DASHED LT)
 STA. 56+50 - STA. 67+00 (SOLID LT)

CURVE # 14
 Δ 11°36'34"LT
 R = 1500'
 D = 3°49'11"
 T = 152'
 L = 304'
 BANKING 0.062 FT./FT.
 150' RUNOFF (50 MPH)
 SEE SHEET 26 FOR BANKING DETAIL

SIGN LEGEND
 R = REMOVE
 S = SALVAGE
 N = NEW
 RET = RETAIN
 B-B = BACK TO BACK

646.402 DURABLE 4" WHITE LINE, THERMOPLASTIC
 STA. 67+00 - STA. 83+00 (SOLID LT & RT)
 646.412 DURABLE 4" YELLOW LINE, THERMOPLASTIC
 STA. 67+00 - STA. 83+00 (SOLID LT & RT)
 646.602 TEMPORARY 4" WHITE LINE, PAINT
 STA. 67+00 - STA. 83+00 (SOLID LT & RT)
 646.612 TEMPORARY 4" YELLOW LINE, PAINT
 STA. 67+00 - STA. 83+00 (SOLID LT & RT)

621.205 STEEL BEAM GUARDRAIL, GALVANIZED W/8 FEET POSTS
 STA. 79+05.00 RT - STA. 83+00.00 RT
 621.50 MANUFACTURED TERMINAL SECTION, FLARED
 STA. 78+67.50 RT - STA. 79+05.00 RT
 621.80 REMOVAL AND DISPOSAL OF GUARDRAIL
 STA. 79+95 RT - STA. 81+66 RT
 676.10 DELINEATOR WITH STEEL POST, WHITE
 STA. 78+67.50 RT

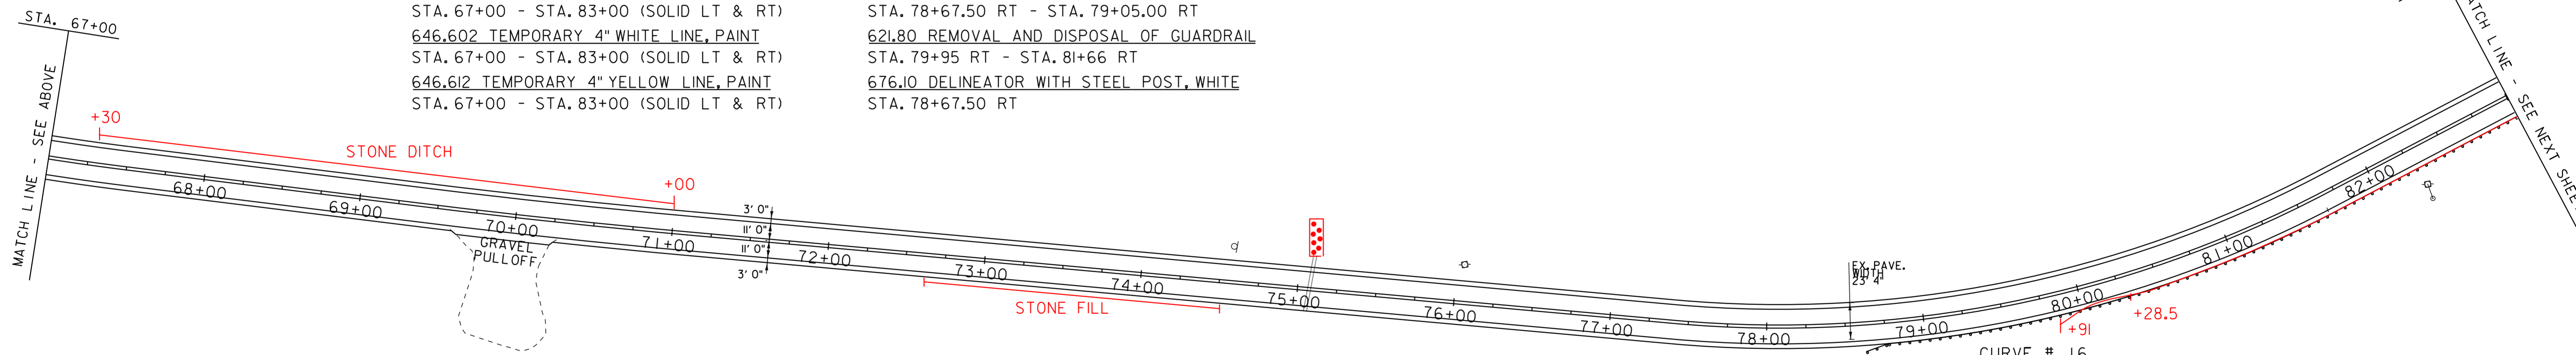


CURVE # 15
 Δ 1°55'31"LT
 R = 5000'
 D = 1°08'45"
 T = 84'
 L = 168'
 BANKING 0.025 FT./FT.
 150' RUNOFF (50 MPH)
 SEE SHEET 26 FOR BANKING DETAIL

CURVE # 16
 Δ 32°43'23"LT
 R = 750'
 D = 7°38'22"
 T = 220'
 L = 428'
 BANKING 0.08 FT./FT.
 190' RUNOFF (50 MPH)
 SEE SHEET 26 FOR BANKING DETAIL

SIGN LEGEND
 R = REMOVE
 S = SALVAGE
 N = NEW
 RET = RETAIN
 B-B = BACK TO BACK

DATUM	
VERTICAL	N/A
HORIZONTAL	N/A

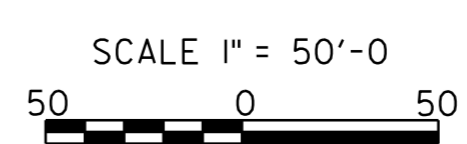

PROJECT LAYOUT SHEET 4

PROJECT NAME: MORETOWN-DUXBURY-MORETOWN	PLOT DATE: 31-OCT-2012 16:08
PROJECT NUMBER: STP 2507 (1)S	DRAWN BY: SJB/RHB
FILE NAME: p05b050.dgn	CHECKED BY: EPD
DESIGNED BY: CDL	SHEET 16 OF 33
PLOT FILE: p05b050pi04.i	