

TEMPORARY 4in YELLOW LINE (PAINT)
4in YELLOW LINE

ST. GEORGE
STA 42+00 TO 53+57
SOLID LT&RT

SHELBURNE
STA 0+00 TO 31+00
SOLID LT&RT
DOUBLE SOLID LT

TEMPORARY 4in WHITE LINE (PAINT)
4in WHITE LINE

ST. GEORGE
STA 42+00 TO 53+57
SOLID LT&RT

SHELBURNE
STA 0+00 TO 31+00
SOLID LT&RT



TEMPORARY LETTER OR SYMBOL
LETTER OR SYMBOL

SHELBURNE
STA 1+72 LT
"STOP"

TEMPORARY 24in STOP BAR (PAINT)
24in STOP BAR

SHELBURNE
STA 1+72 LT
POND RD

REMOVING SIGNS
3

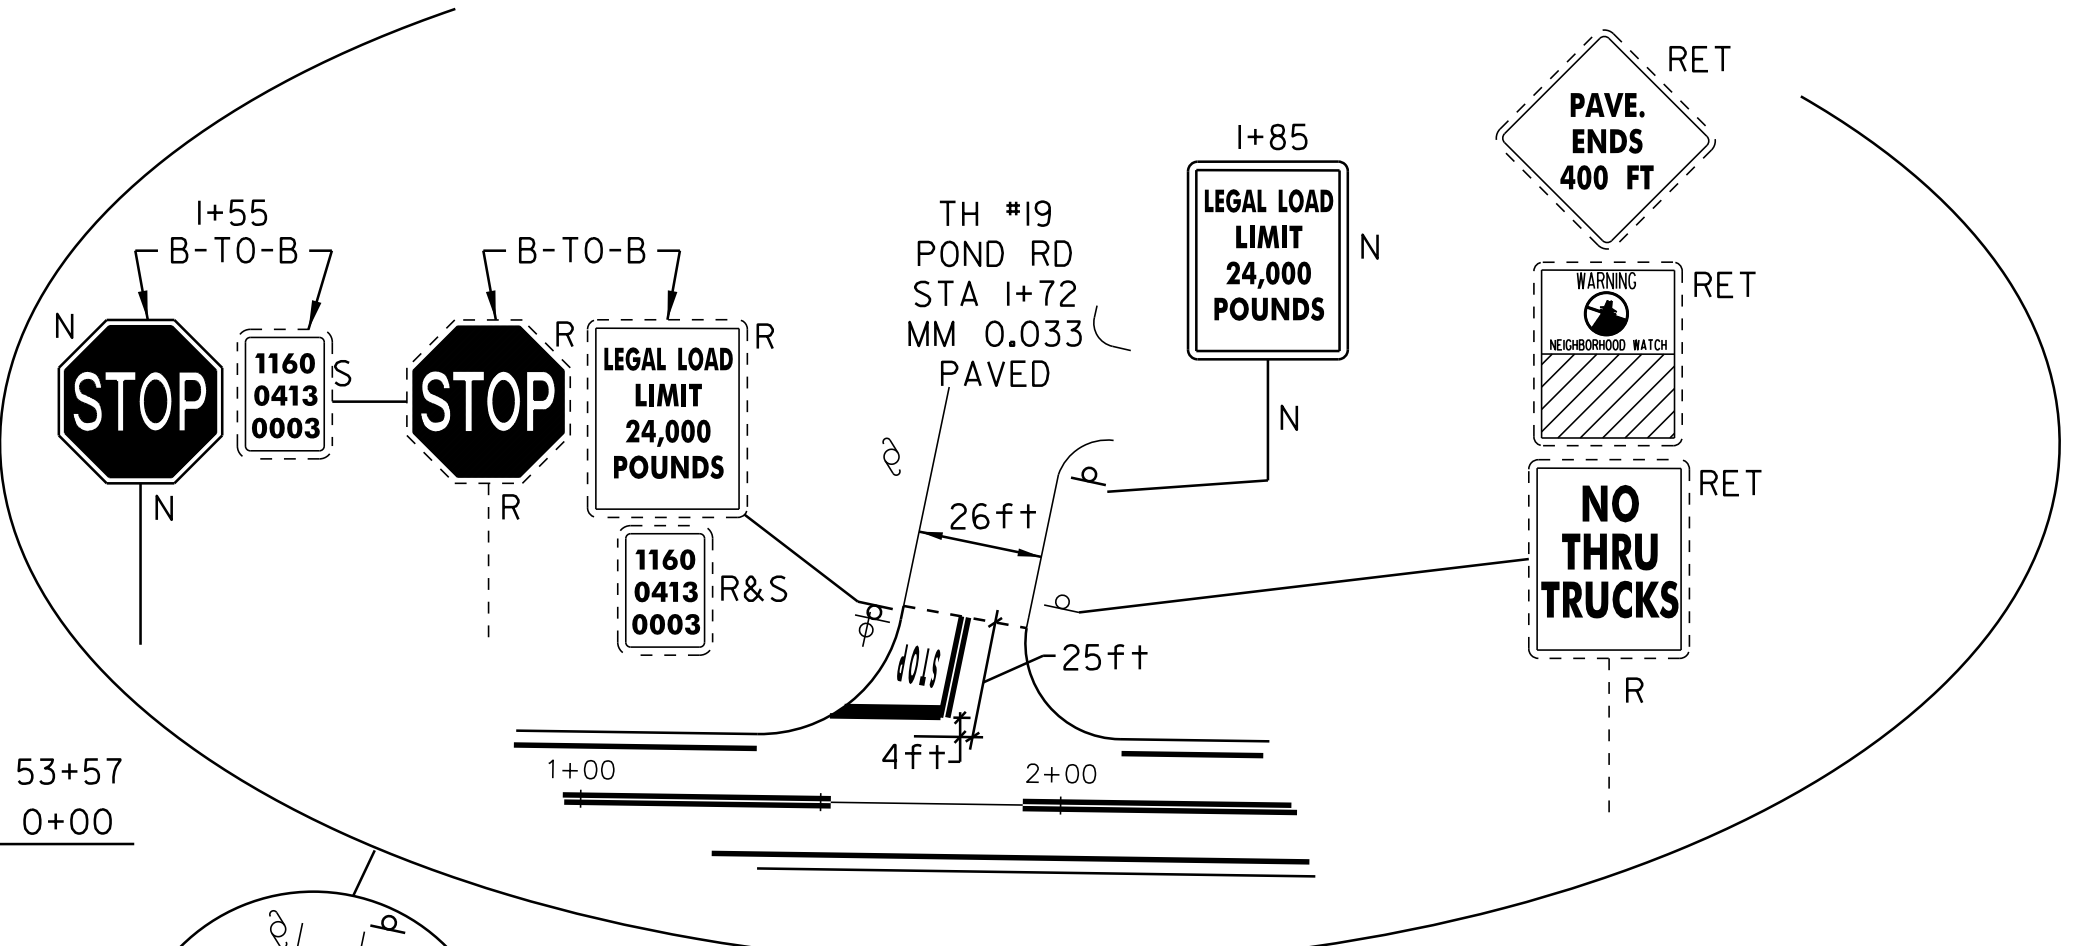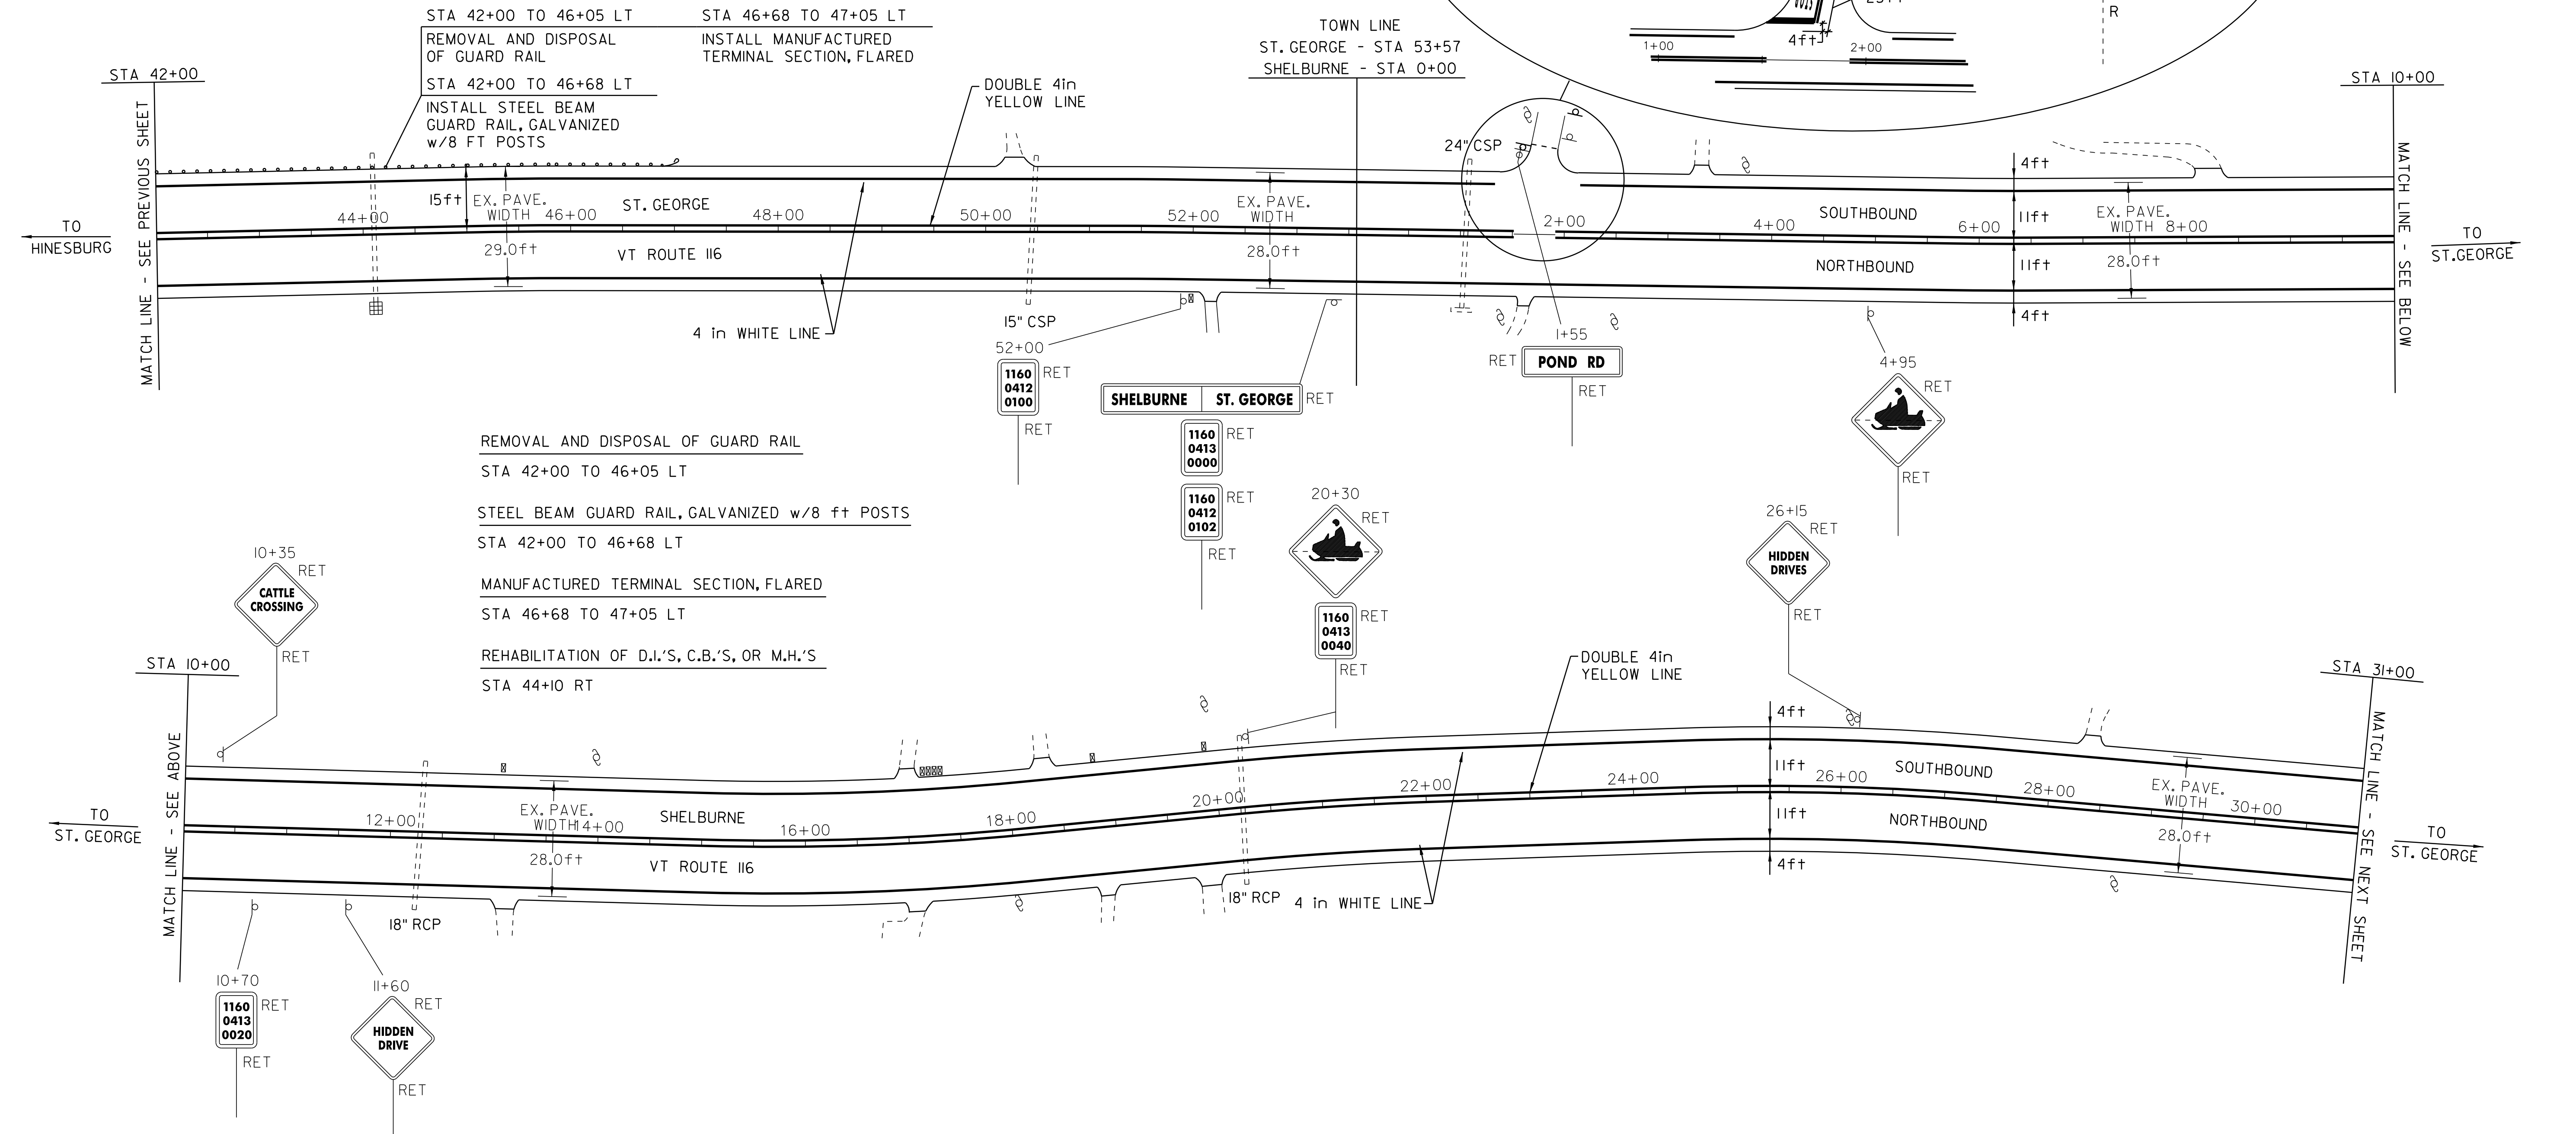

REMOVAL AND DISPOSAL OF GUARD RAIL
STA 42+00 TO 46+05 LT

STEEL BEAM GUARD RAIL, GALVANIZED w/8 ft POSTS
STA 42+00 TO 46+68 LT

MANUFACTURED TERMINAL SECTION, FLARED
STA 46+68 TO 47+05 LT

REHABILITATION OF D.I.'S, C.B.'S, OR M.H.'S
STA 44+10 RT

DITCHING LOCATIONS (REFER TO SHEET 9 FOR DETAILS)

TOWN OF ST. GEORGE
STA 46+00 TO 50+25 RT

TOWN OF SHELBURNE
STA 1+75 TO 3+00 RT
STA 4+50 TO 7+00 LT
STA 13+50 TO 16+00 RT
STA 26+25 TO 28+00 LT

LEGEND

N	= NEW
R	= REMOVE
R&S	= REMOVE & SALVAGE
S	= SALVAGE
RET	= RETAIN
B-TO-B	= BACK TO BACK
⊕ ⊞ □	= CATCH BASIN/DI
(N.W.)	= NO WORK REQUIRED (TYP. FOR D.I.'S, & C.B.'S WHERE NOTED)
I	= YIELDING MARKER POST
⊕	= UTILITY POLE
⊕	= DRIVE

PAVING PROJECT LAYOUT SHEET #2

DESIGNED BY	BCE/PJM	DATE	10-06
DRAWN BY	C.E.A., INC.	DATE	10-06
DESIGN FILE NO.	p05b052.dgn		
PRF FILE	p05b0521a02	DATE PLOTTED	03-MAY-2012 17
PROJ. NAME	ST. GEORGE-SO. BURLINGTON		
PROJ. NO.	ST-STP 2508(1)S		
SHEET	11	OF	42 SHEETS