

TEMPORARY 4in YELLOW LINE  
4in YELLOW LINE

TEMPORARY 4in WHITE LINE (PAINT)  
4in WHITE LINE

DITCHING LOCATIONS (REFER TO SHEET 9 FOR DETAILS)

SHELBURNE  
STA 31+00 TO 62+21  
SOLID LT&RT



ST. GEORGE  
STA 53+57 TO 65+00  
SOLID LT&RT

SHELBURNE  
STA 31+00 TO 62+21  
SOLID LT&RT

ST. GEORGE  
STA 53+57 TO 65+00  
SOLID LT&RT

TOWN OF SHELBURNE  
STA 31+50 TO 39+50 LT  
STA 32+00 TO 35+00 RT  
STA 45+50 TO 48+00 LT&RT  
STA 56+50 TO 62+20 RT

TOWN OF ST. GEORGE  
STA 53+60 TO 58+00 RT  
STA 58+50 TO 61+50 RT

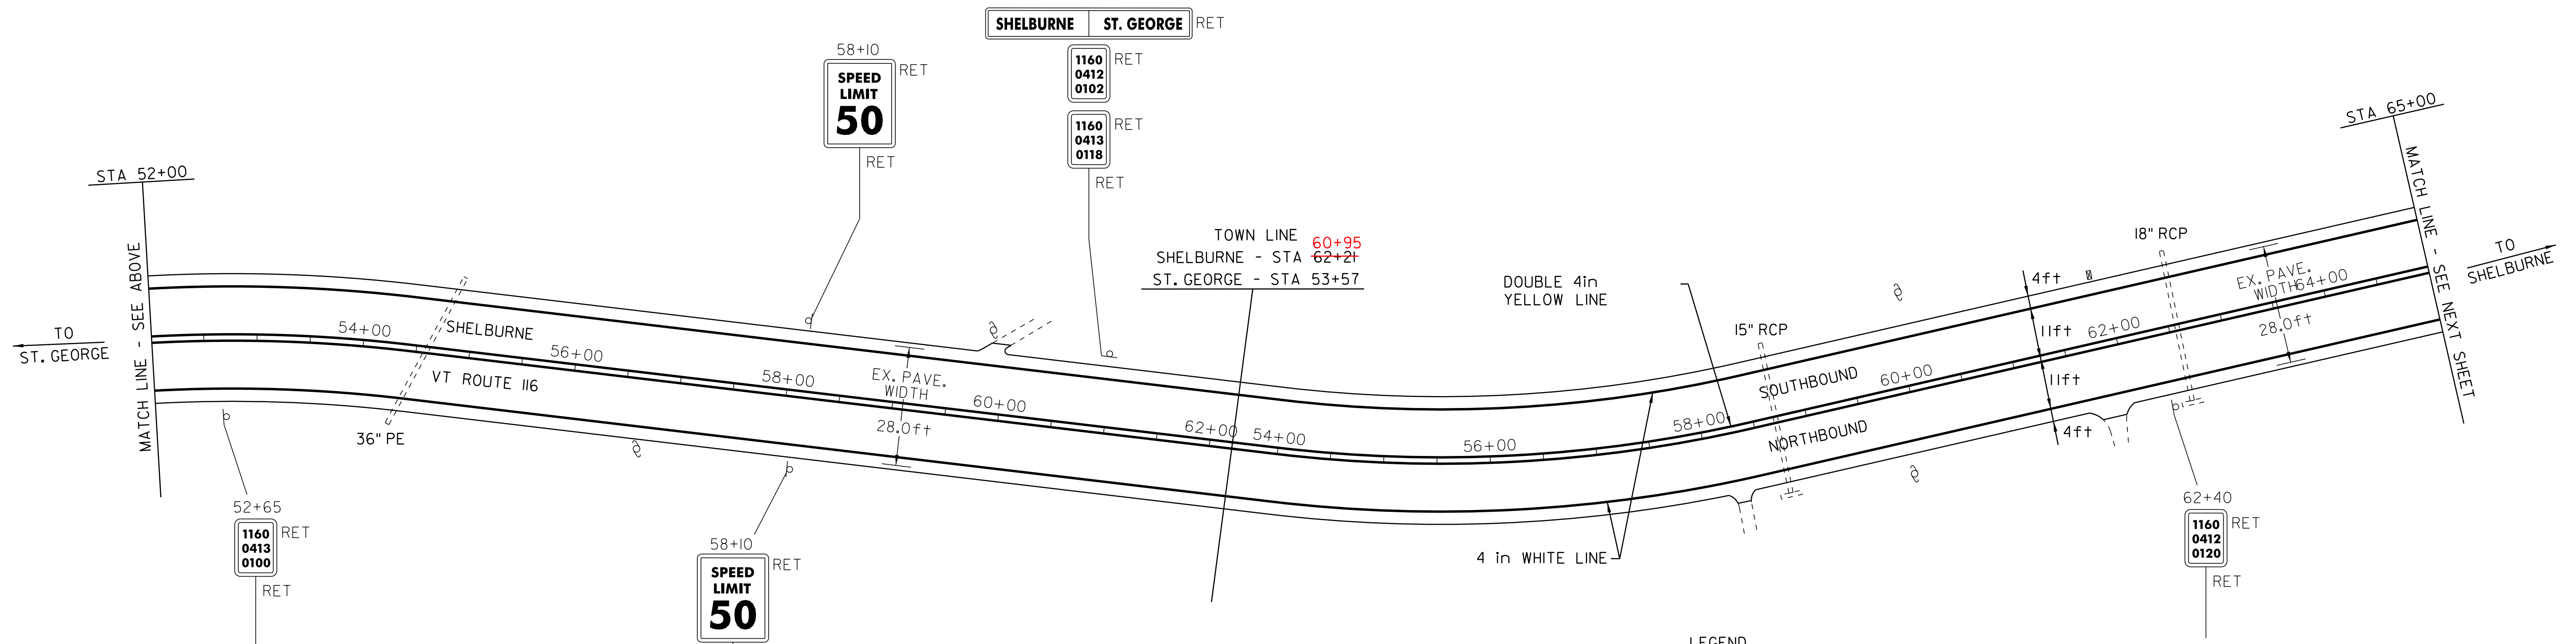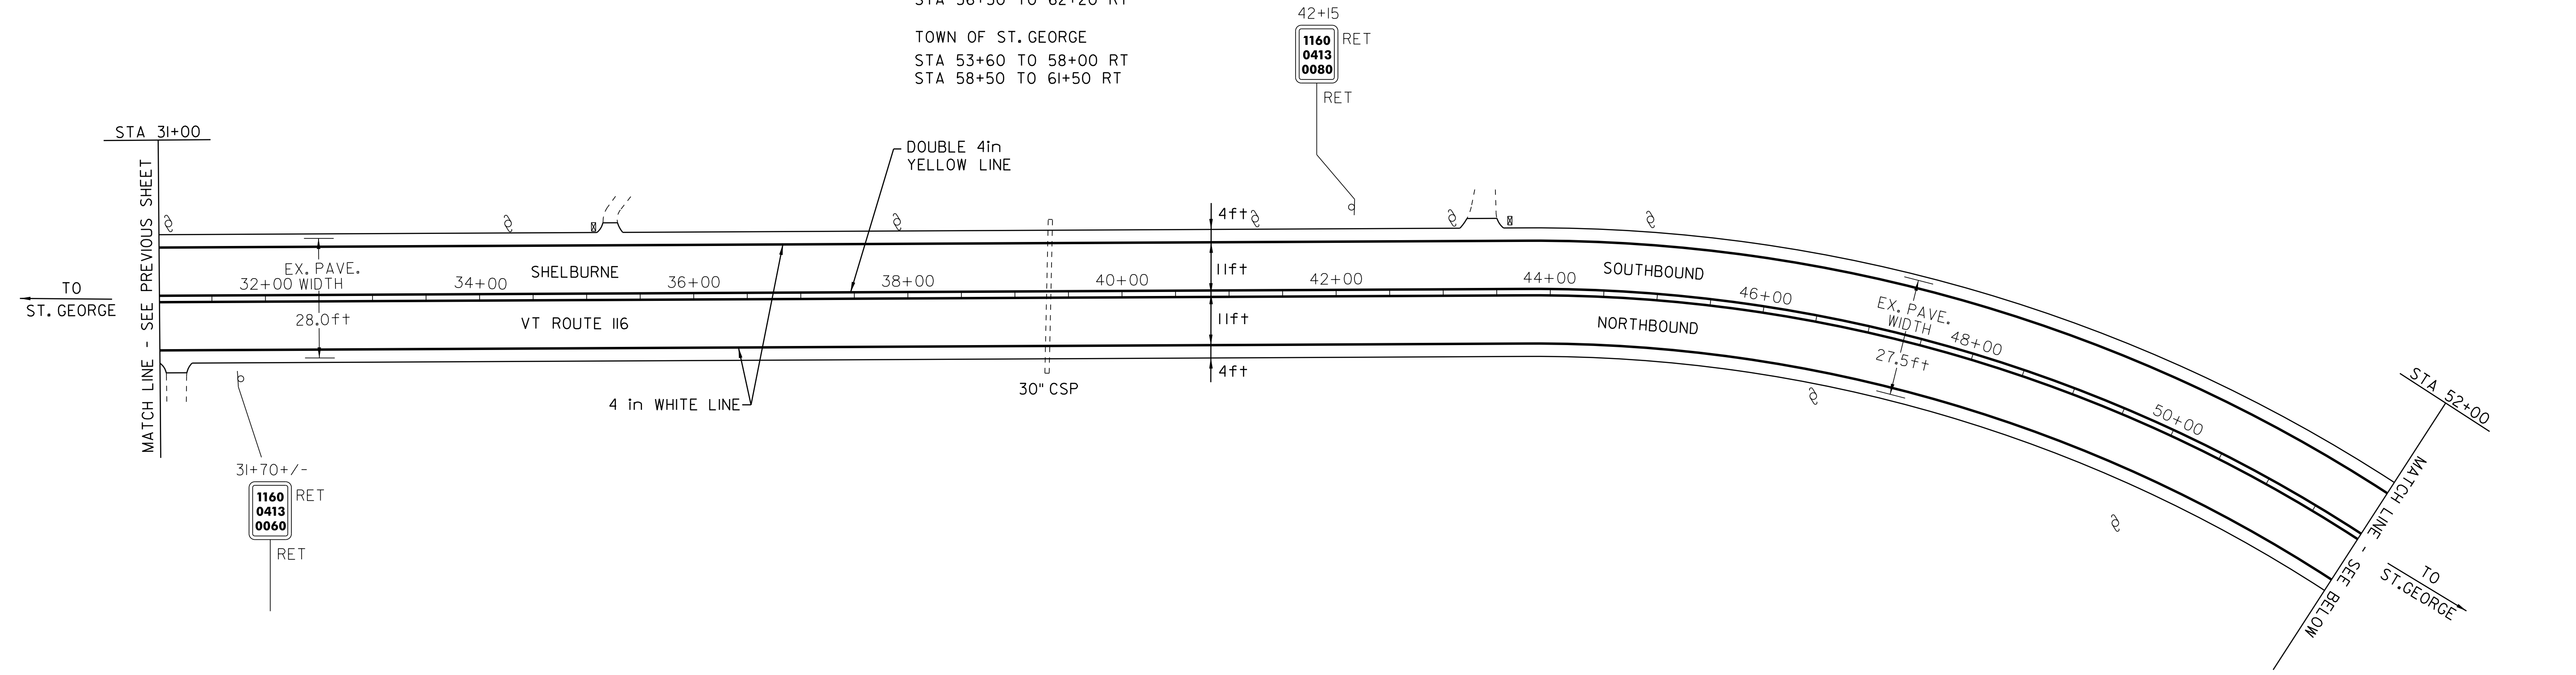

- LEGEND**
- N = NEW
  - R = REMOVE
  - R&S = REMOVE & SALVAGE
  - S = SALVAGE
  - RET = RETAIN
  - B-TO-B = BACK TO BACK
  - ⊕ ⊞ □ CATCH BASIN/DI
  - (N.W.) = NO WORK REQUIRED (TYP. FOR D.I.'S, & C.B.'S WHERE NOTED)
  - I YIELDING MARKER POST
  - ⊕ UTILITY POLE
  - ⊔ DRIVE

**PAVING PROJECT LAYOUT SHEET #3**

DESIGNED BY BCE/PJM DATE 10-06

DRAWN BY C.E.A., INC. DATE 10-06

DESIGN FILE NO. p05b052.dgn

PRF FILE p05b0521a03 DATE 03-MAY-2012 PLOTTED

PROJ. NAME **ST. GEORGE-SO. BURLINGTON**

PROJ. NO. **ST-STP 2508(1)S**

SHEET **12** OF **42** SHEETS