

REHABILITATION OF D.I.'S, C.B.'S, OR M.H.'S

STA 68+70 RT

DITCHING LOCATIONS (REFER TO SHEET 9 FOR DETAILS)


TOWN OF ST. GEORGE

STA 66+70 TO 68+70 RT

STA 72+50 TO 77+75 RT

STA 78+00 TO 79+00 RT

TOWN LINE
ST. GEORGE - STA 85+61
SHELBURNE - STA 62+21

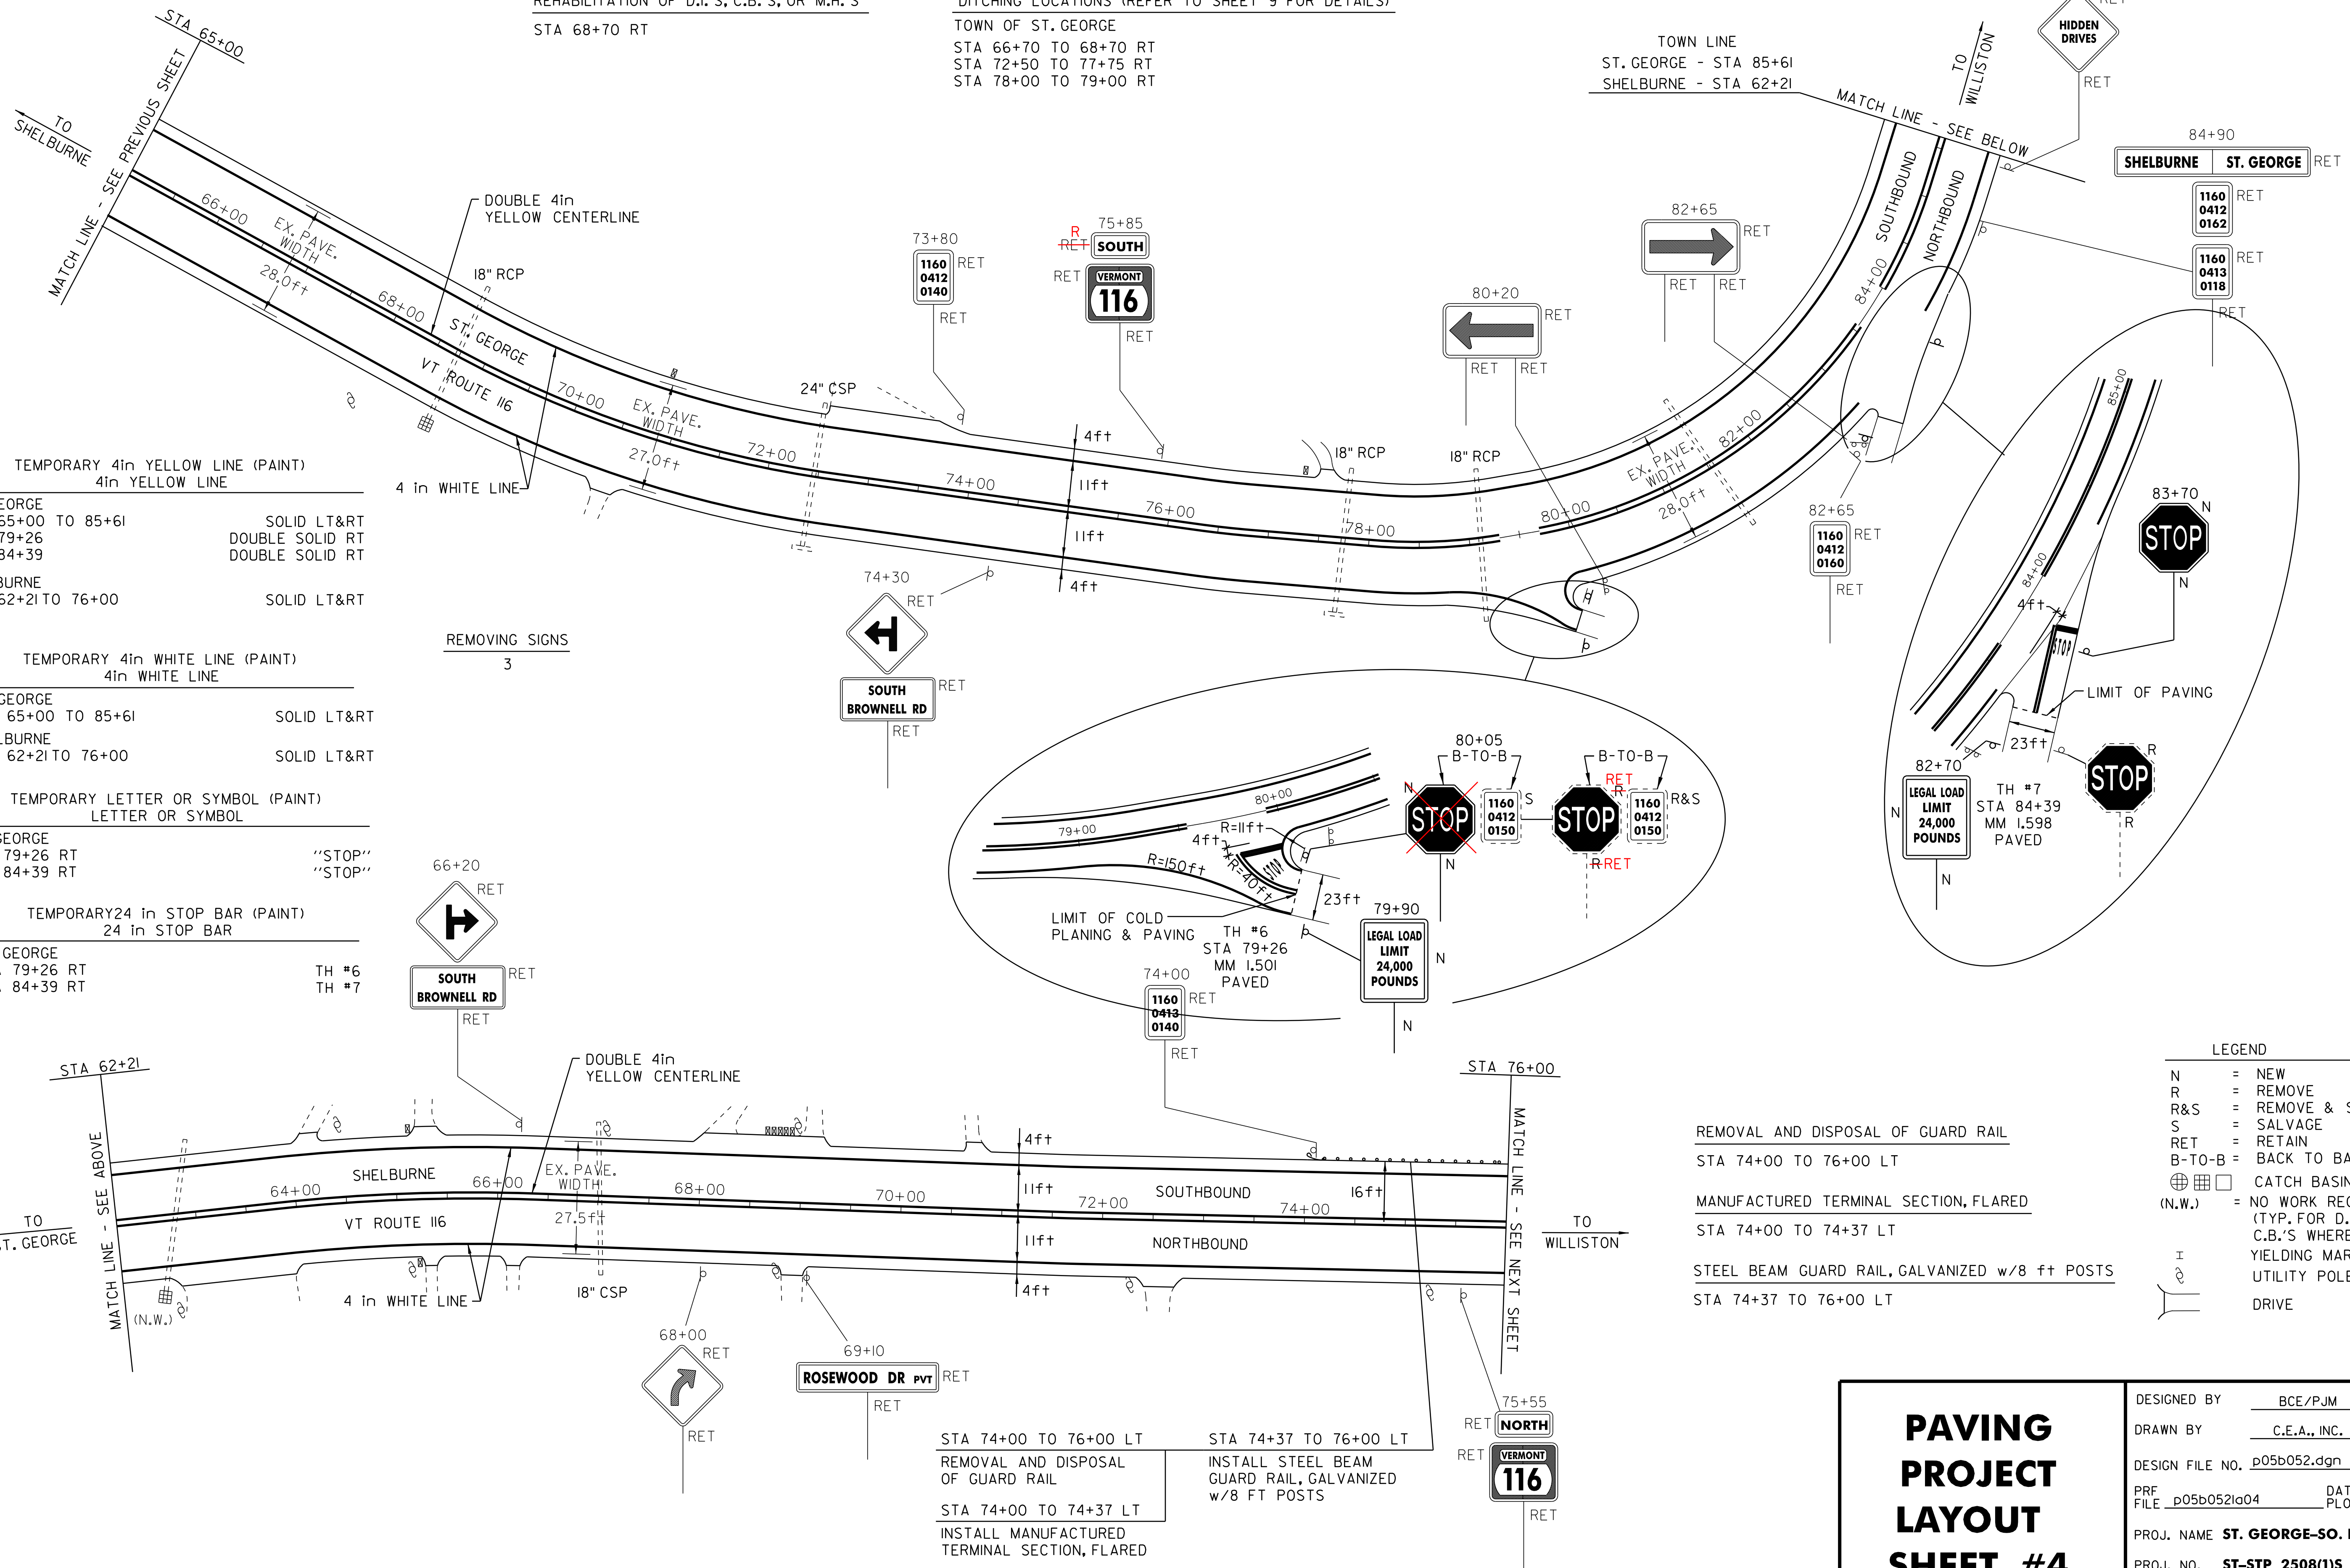

TEMPORARY 4in YELLOW LINE (PAINT)
4in YELLOW LINE

ST. GEORGE
STA 65+00 TO 85+61 SOLID LT&RT
STA 79+26 DOUBLE SOLID RT
STA 84+39 DOUBLE SOLID RT

SHELBURNE
STA 62+21 TO 76+00 SOLID LT&RT

TEMPORARY 4in WHITE LINE (PAINT)
4in WHITE LINE

ST. GEORGE
STA 65+00 TO 85+61 SOLID LT&RT
SHELBURNE
STA 62+21 TO 76+00 SOLID LT&RT










TEMPORARY LETTER OR SYMBOL (PAINT)
LETTER OR SYMBOL

ST. GEORGE
STA 79+26 RT "STOP"
STA 84+39 RT "STOP"

TEMPORARY 24 in STOP BAR (PAINT)
24 in STOP BAR

ST. GEORGE
STA 79+26 RT TH #6
STA 84+39 RT TH #7

REMOVING SIGNS
3

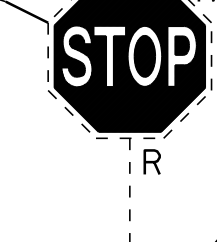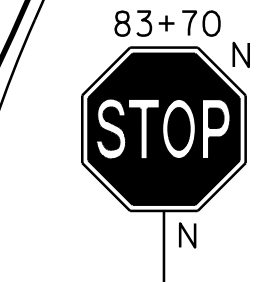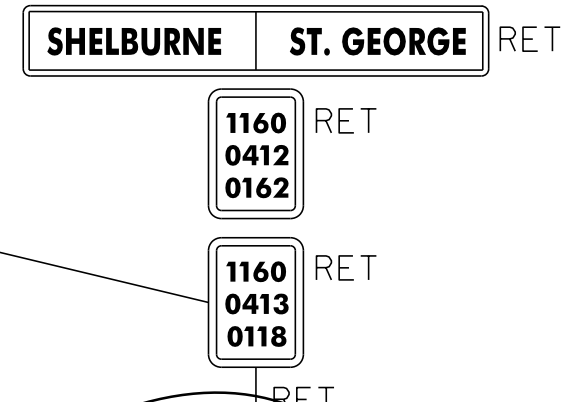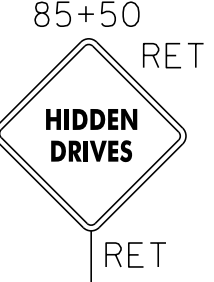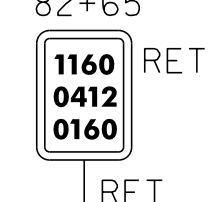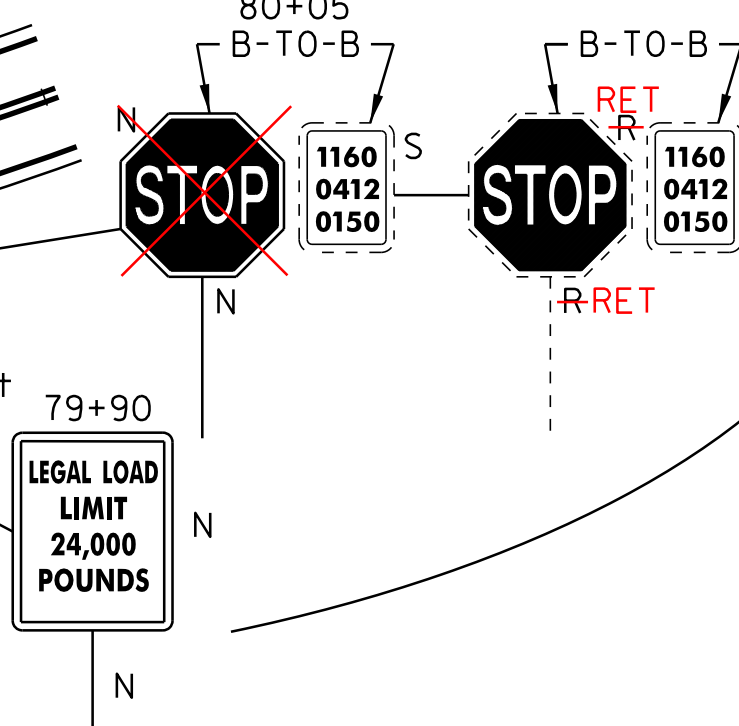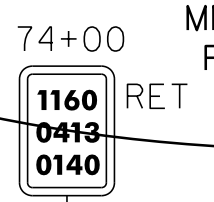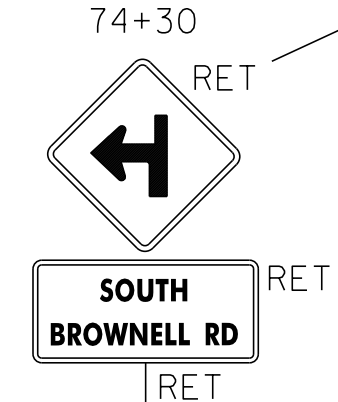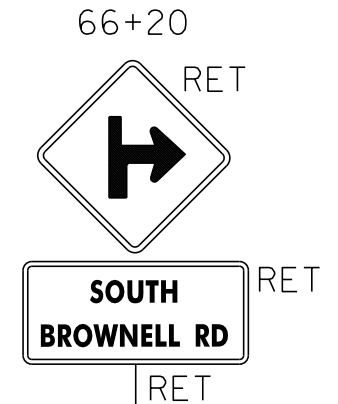

LEGEND

N	=	NEW
R	=	REMOVE
R&S	=	REMOVE & SALVAGE
S	=	SALVAGE
RET	=	RETAIN
B-T-O-B	=	BACK TO BACK
⊕	=	CATCH BASIN/DI
(N.W.)	=	NO WORK REQUIRED (TYP. FOR D.I.'S, & C.B.'S WHERE NOTED)
⊥	=	YIELDING MARKER POST
⊥	=	UTILITY POLE
⊥	=	DRIVE

REMOVAL AND DISPOSAL OF GUARD RAIL

STA 74+00 TO 76+00 LT

MANUFACTURED TERMINAL SECTION, FLARED

STA 74+00 TO 74+37 LT

STEEL BEAM GUARD RAIL, GALVANIZED w/8 ft POSTS

STA 74+37 TO 76+00 LT

STA 74+00 TO 76+00 LT

REMOVAL AND DISPOSAL
OF GUARD RAIL

STA 74+00 TO 74+37 LT

INSTALL MANUFACTURED
TERMINAL SECTION, FLARED

STA 74+37 TO 76+00 LT

INSTALL STEEL BEAM
GUARD RAIL, GALVANIZED
w/8 FT POSTS

PAVING PROJECT LAYOUT SHEET #4

DESIGNED BY BCE/PJM DATE 10-06

DRAWN BY C.E.A., INC. DATE 10-06

DESIGN FILE NO. p05b052.dgn

PRF FILE p05b052ia04 DATE 03-MAY-2012 PLOTTED

PROJ. NAME **ST. GEORGE-SO. BURLINGTON**

PROJ. NO. **ST-STP 2508(1)S**

SHEET **13** OF **42** SHEETS