


**NON-YIELDING OBJECT APPROACH DETAIL**

**SHELBURNE**  
STA 78+25 LT

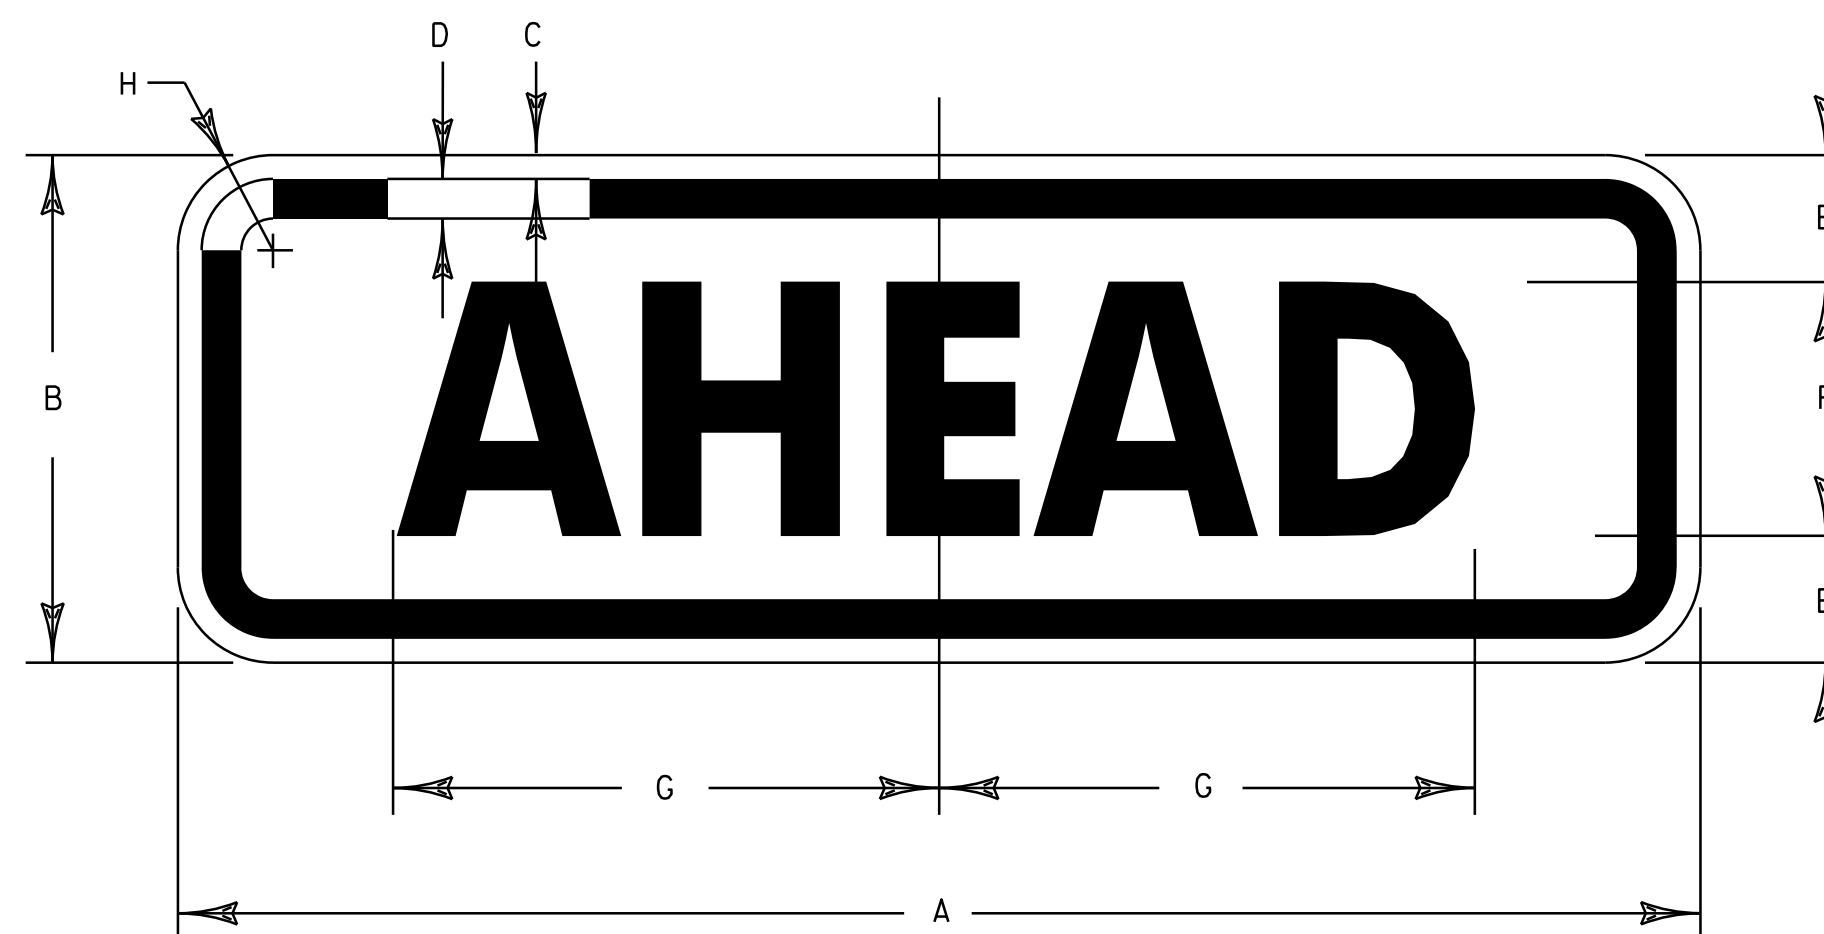

**W16-7P**  
**SO. BURLINGTON**  
STA 200+45 RT  
STA 213+20 RT

SIGN	DIMENSIONS (in)							
	A	B	C	D	E	F	G	H
	24	12	3/8	5/8	3	6D	8	1 1/2

**NON-YIELDING OBJECT  
APPROACH and  
SIGN DETAIL SHEET**

DESIGNED BY BCE/PJM DATE 8-06  
 DRAWN BY C.E.A., INC. DATE 8-06  
 DESIGN FILE NO. p05b052.dgn  
 PRF FILE p05b052d+04.i DATE 03-MAY-2012 17:00  
 PLOTTED 03-MAY-2012 17:00  
 PROJ. NAME **ST. GEORGE-SO. BURLINGTON**  
 PROJ. NO. **ST-STP 2508(1)S**  
 SHEET **40** OF **42** SHEETS