

SEE SHEET 2 FOR INDEX OF SHEETS

STATE OF VERMONT AGENCY OF TRANSPORTATION



PROPOSED IMPROVEMENT BRIDGE PROJECT


TOWN OF BRISTOL
COUNTY OF ADDISON

ROUTE NO : VT 116, MINOR ARTERIAL BRIDGE NO : 9


PROJECT LOCATION : IN THE TOWN OF BRISTOL ON VT 116 BEGINNING AT A POINT 2.00 MILES SOUTH OF IT'S INTERSECTION WITH VT 17 AND EXTENDING NORTH TOWARDS VT 17 FOR A DISTANCE OF 290 FT. (0.055 MILES).

PROJECT DESCRIPTION : REPLACE EXISTING STRUCTURE WITH A NEW REINFORCED CONCRETE BOX CULVERT ALONG WITH RELATED ROADWAY AND CHANNEL WORK.

LENGTH OF PROJECT: 290 FT
LENGTH OF ROADWAY: 290 FT
LENGTH OF STRUCTURE: N/A

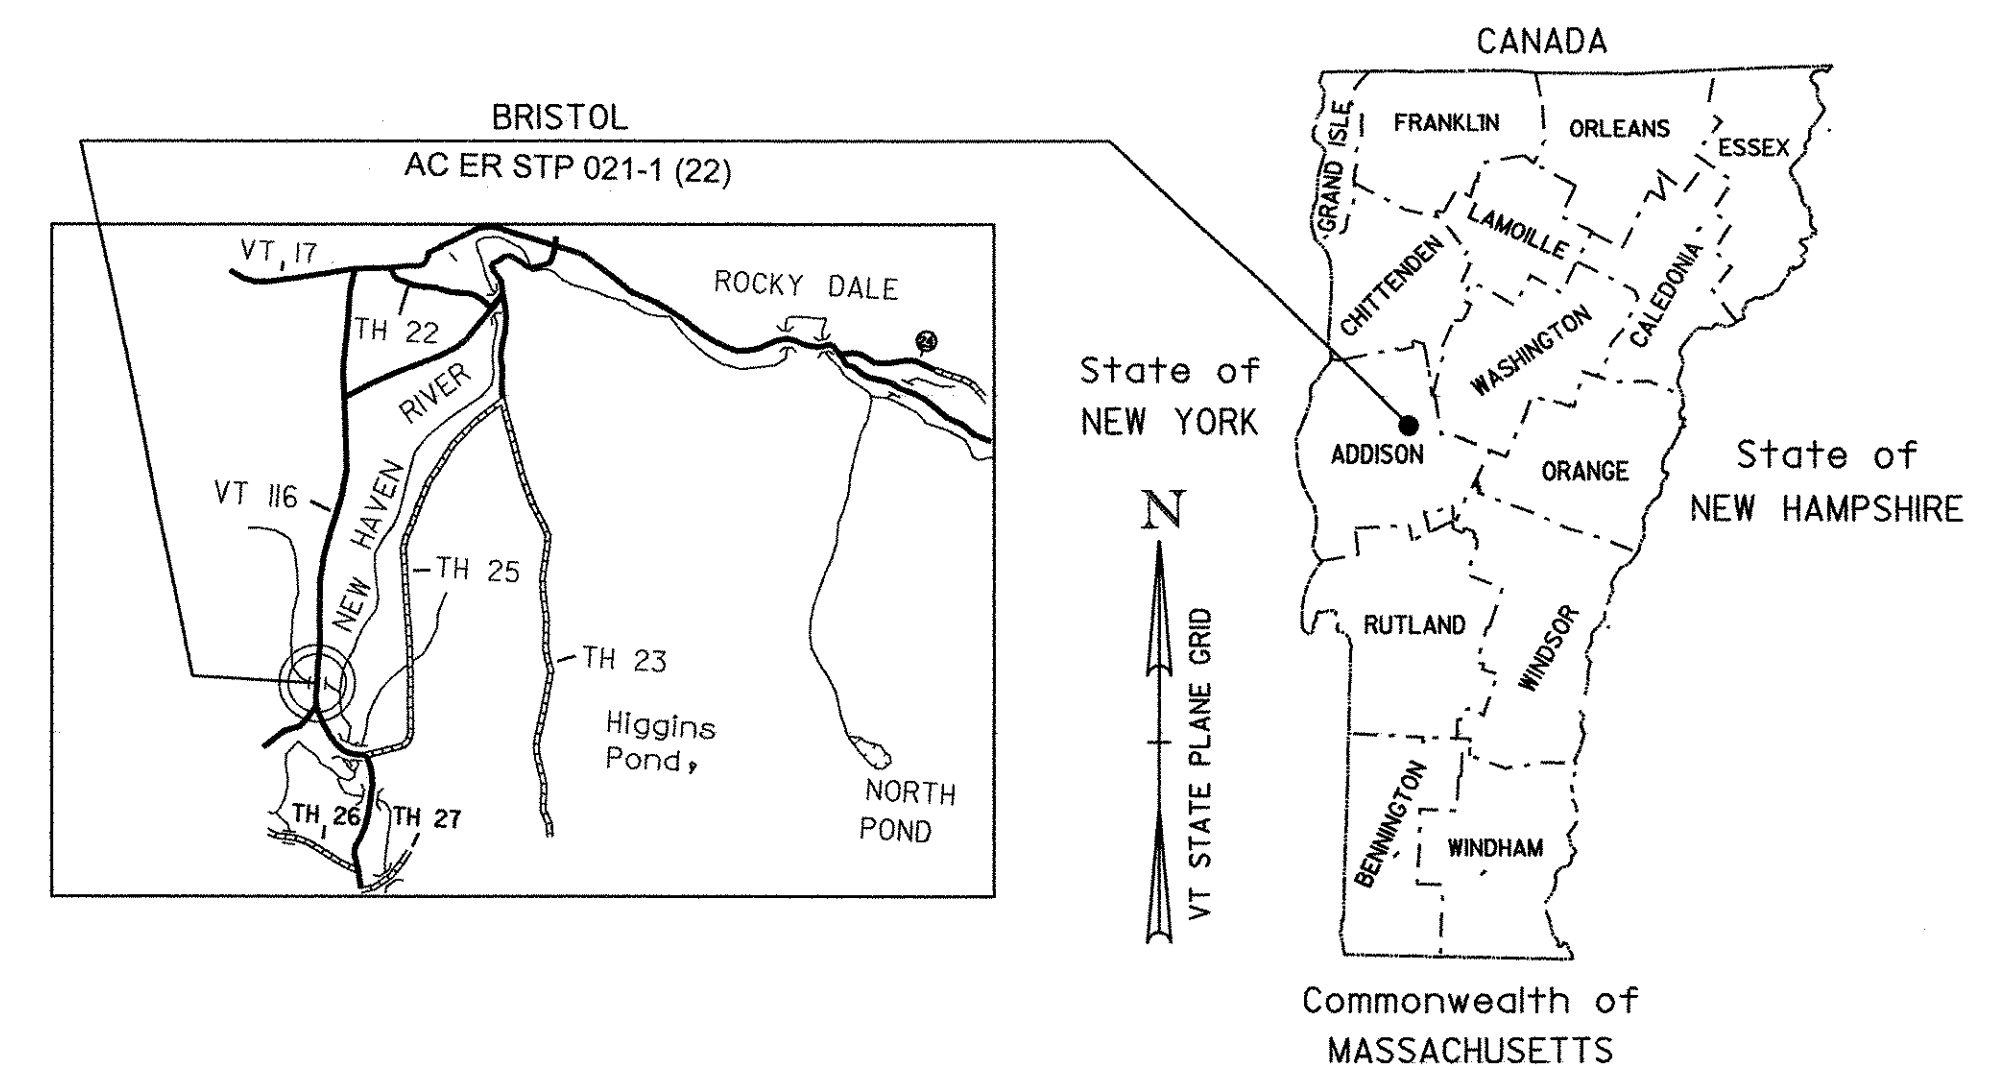


RECORD PLANS	
CONTRACTOR:	PIKE INDUSTRIES, INC. - BERLIN, VT
RESIDENT ENGINEER:	DALE NORTON
CONSTRUCTION BEGAN:	AUGUST 6, 2007
CONSTRUCTION COMPLETE:	NOVEMBER 2, 2007
RECORD PLANS BY:	DALE NORTON & N. GARBACIK
I HEREBY CERTIFY THAT ALL THE CONSTRUCTION REQUIRED BY THIS SET OF DRAWINGS HAS BEEN ACCOMPLISHED AS INDICATED HEREIN.	
BY	<i>Dale R. Norton</i> RESIDENT ENGINEER
DATE	4/29/2009
NOTE: Any further information concerning final quantities, amounts or other details relative to this project may be found at Central Files in the electronic archives.	

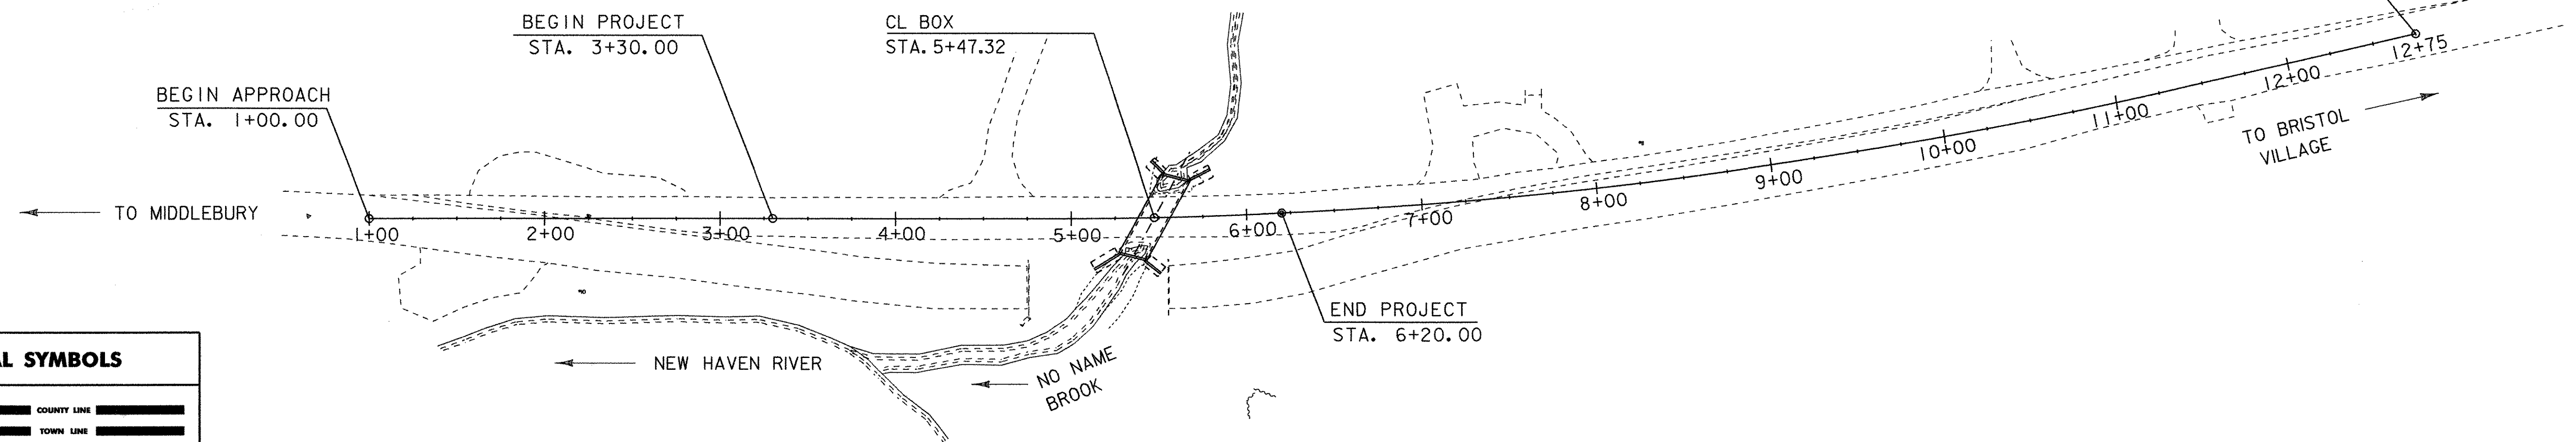

CONVENTIONAL SYMBOLS	
COUNTY LINE	
TOWN LINE	
LIMITS OF ACCESS	
POINT OF ACCESS	
FENCE LINE	
STONE WALL	
TRAVELED WAY	
GUARD RAIL	
RAILROAD	
SURVEY LINE	
CULVERT	
POWER POLE	
TELEPHONE POLE	
TREES	
CONTROL OF ACCESS	
PROPERTY LINE	
R.O.W. TAKING LINE	
SLOPE RIGHTS	
TOP OF CUT	
TOE OF SLOPE	

SURVEYED BY : L. ORVIS PC/J. HULETT
SURVEYED DATE : 05-31-2005

DATUM
VERTICAL NAVD 88
HORIZONTAL NAD 83 (96)

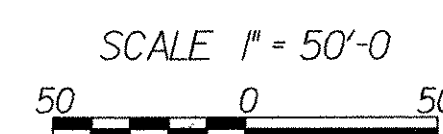

THESE PLANS ARE SUBJECT TO SUCH ENGINEERING CHANGES AS MAY BE REQUIRED BY THE FEDERAL HIGHWAY ADMINISTRATION OR THE DIRECTOR OF PROGRAM DEVELOPMENT.
CONSTRUCTION IS TO BE CARRIED ON IN ACCORDANCE WITH THESE PLANS AND THE STANDARD SPECIFICATIONS FOR CONSTRUCTION DATED 2006, AS APPROVED BY THE FEDERAL HIGHWAY ADMINISTRATION ON JUNE 15, 2006 FOR USE ON THIS PROJECT, INCLUDING ALL SUBSEQUENT REVISIONS AND SUCH REVISED SPECIFICATIONS AND SPECIAL PROVISIONS AS ARE INCORPORATED IN THESE PLANS.

DIRECTOR OF PROGRAM DEVELOPMENT	
APPROVED <i>[Signature]</i>	DATE 3-1-07
PROJECT MANAGER : M. EVANS-MONGEON	
PROJECT NAME : BRISTOL	
PROJECT NUMBER : AC ER STP 021-1 (22)	
SHEET 1 OF 66 SHEETS	