

ANCHOR FOR STEEL BEAM RAIL
 STA. 4+70 RT
 STA. 5+01 LT 4+90
 STA. 6+05 RT
 STA. 6+12 LT 6+25

CONSTRUCT PAVED DRIVE
 STA. 4+55.00 LT
 STA. 7+25.00 RT @ 43.5°

ERECTING SALVAGED SIGNS
 STA. 6+00.00 LT 21.01 FT
 STA. 6+00.00 LT 21.01 FT

CURVE DATA:
 Delta = 12°58'58.17"
 D = 1°58'32.58"
 R = 2900.00'
 T = 329.97'
 L = 657.12'
 E = 18.71'


CONSTRUCT DRIVE (PAVED COMMERCIAL)
 STA. 7+75.00 LT (20' PAVED APRON)

DURABLE 4 INCH WHITE LINE PAINT
 STA. 2+00 LT - STA. 8+00 LT
 STA. 2+00 RT - STA. 8+00 RT

HD STEEL BEAM GUARDRAIL, GALVANIZED
 STA. 4+64.46 RT - STA. 5+25.55 RT
 STA. 5+50.43 RT - STA. 6+11.28 RT
 STA. 4+95.74 LT - STA. 5+44.35 LT 5+05
 STA. 5+69.47 LT - STA. 6+18.03 LT 6+30

HD STEEL BEAM GUARDRAIL GALVANIZED/ NESTED
 STA. 5+25.55 RT - STA. 5+50.43 RT
 STA. 5+44.35 LT - STA. 5+69.47 LT 5+10
 COLD PLANING BITUMINOUS PAYMENT
 STA. 2+00 - STA. 3+30
 STA. 6+20 - STA. 8+00

EXISTING BRIDGE INFORMATION
 14 FOOT CORRUGATED STEEL ARCH
 ON CAST-IN-PLACE CONCRETE FOOTING
TOWN OF BRISTOL

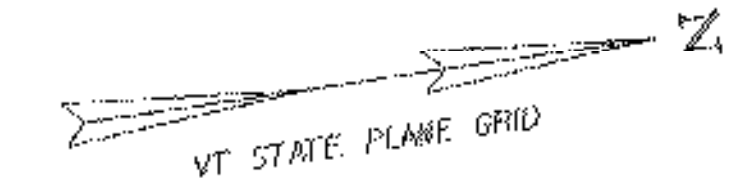

DURABLE 4 INCH YELLOW LINE PAINT
 STA. 2+00 - STA. 8+00 LT and RT 13+80

RELOCATE MAIL BOX, SINGLE SUPPORT
 STA. 4+37.52 LT 18.75 FT



SETTING SALVAGED POSTS
 STA. 6+00.00 LT 21.00 FT

**ADAMS-ROSE, J. REBECCA &
 ROSE, DAVID M.**

RETAIN 15" CPEP PIPE

RELOCATE MAIL BOX AND POST

ML VT 116 STA. 5+75.00
 CHANNEL STA. 51+00.00
 ANGLE 58.00° P.O.T.

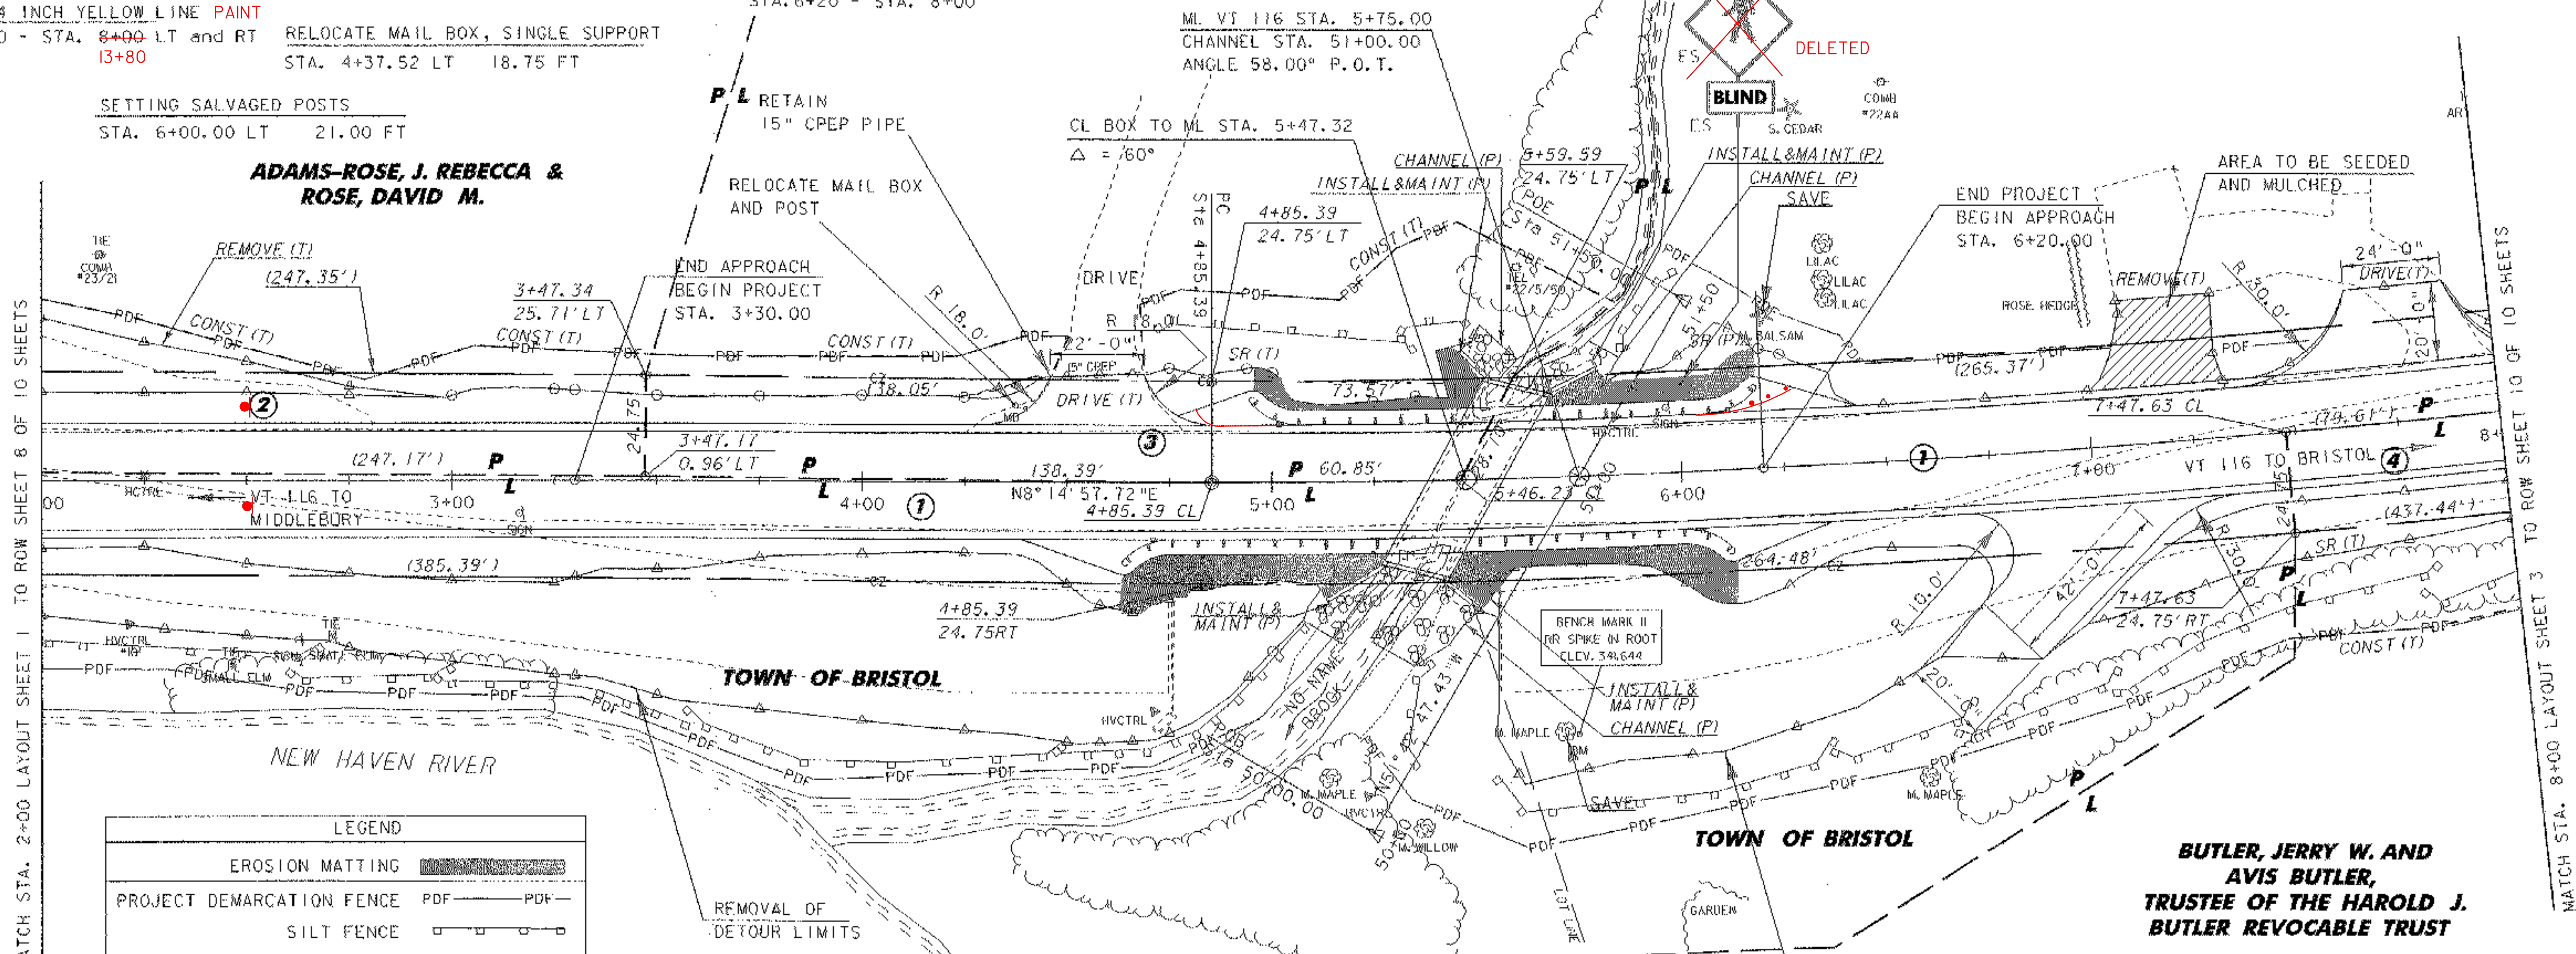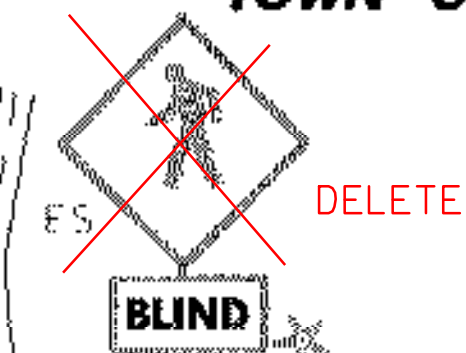

LEGEND	
EROSION MATTING	
PROJECT DEMARCATION FENCE	PDF — PDF
SILT FENCE	

REMOVAL OF DETOUR LIMITS


REMOVAL OF DETOUR LIMITS

**BUTLER, JERRY W. AND
 AVIS BUTLER,
 TRUSTEE OF THE HAROLD J.
 BUTLER REVOCABLE TRUST**

LINES SHOWN ON THIS PLAN AS EXISTING PROPERTY LINES P/L ARE BELIEVED TO BE ACCURATE BUT SHOULD NOT BE RELIED UPON FOR PURPOSES UNRELATED TO THE STATE OF VERMONT'S ACQUISITION OF LAND AND RIGHTS FOR THIS PROJECT.

**FOR R.O.W.
 USE ONLY**

ALL DRIVES AS INDICATED ON PLANS ARE SUBJECT TO PERMITS PURSUANT TO TITLE 19 SECTION III, V.S.A.

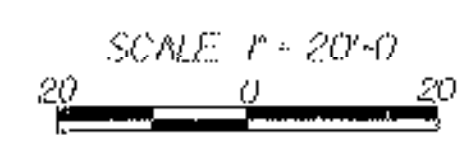

LAYOUT SHEET 2

PROJECT: BRISTOL	PROJECT NO. 1 ER ST 021-1 (22)
DESIGN FILE NAME: 05b126\51r\05b126ldr.dgn	PILOT DATE: 27-MAR-2007
IPARM FILE NAME: s05b126ly2.1	CHECKED BY: G. ROKES
DESIGNED BY: M. EVANS-MONGEON	DRAWN BY: G. ROKES
SQUAD LEADER: M. EVANS-MONGEON	
ROW SHEET: 9 OF 10 SHEETS	SHEET 9 OF 66

DATUM	
VERTICAL	NAVD 88
HORIZONTAL	NAVD 83 (96)

MATCH STA. 2+00 LAYOUT SHEET 1 TO ROW SHEET 8 OF 10 SHEETS

MATCH STA. 8+00 LAYOUT SHEET 3 TO ROW SHEET 10 OF 10 SHEETS