



~~DURABLE 4 INCH WHITE LINE PAINT~~
 STA. 1+00 LT - STA. 2+00 LT
 STA. 1+00 RT - STA. 2+00 RT


~~DURABLE 4 INCH YELLOW LINE PAINT~~
 STA. 1+00 - STA. 2+00 LT and RT

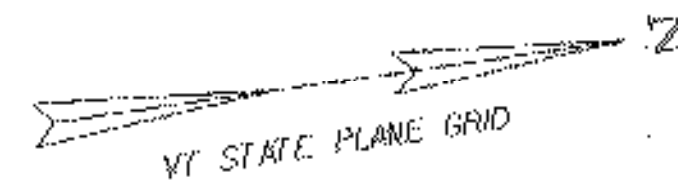

COLD PLANING, BITUMINOUS PAVEMENT
 STA. 1+00 - STA. 2+00

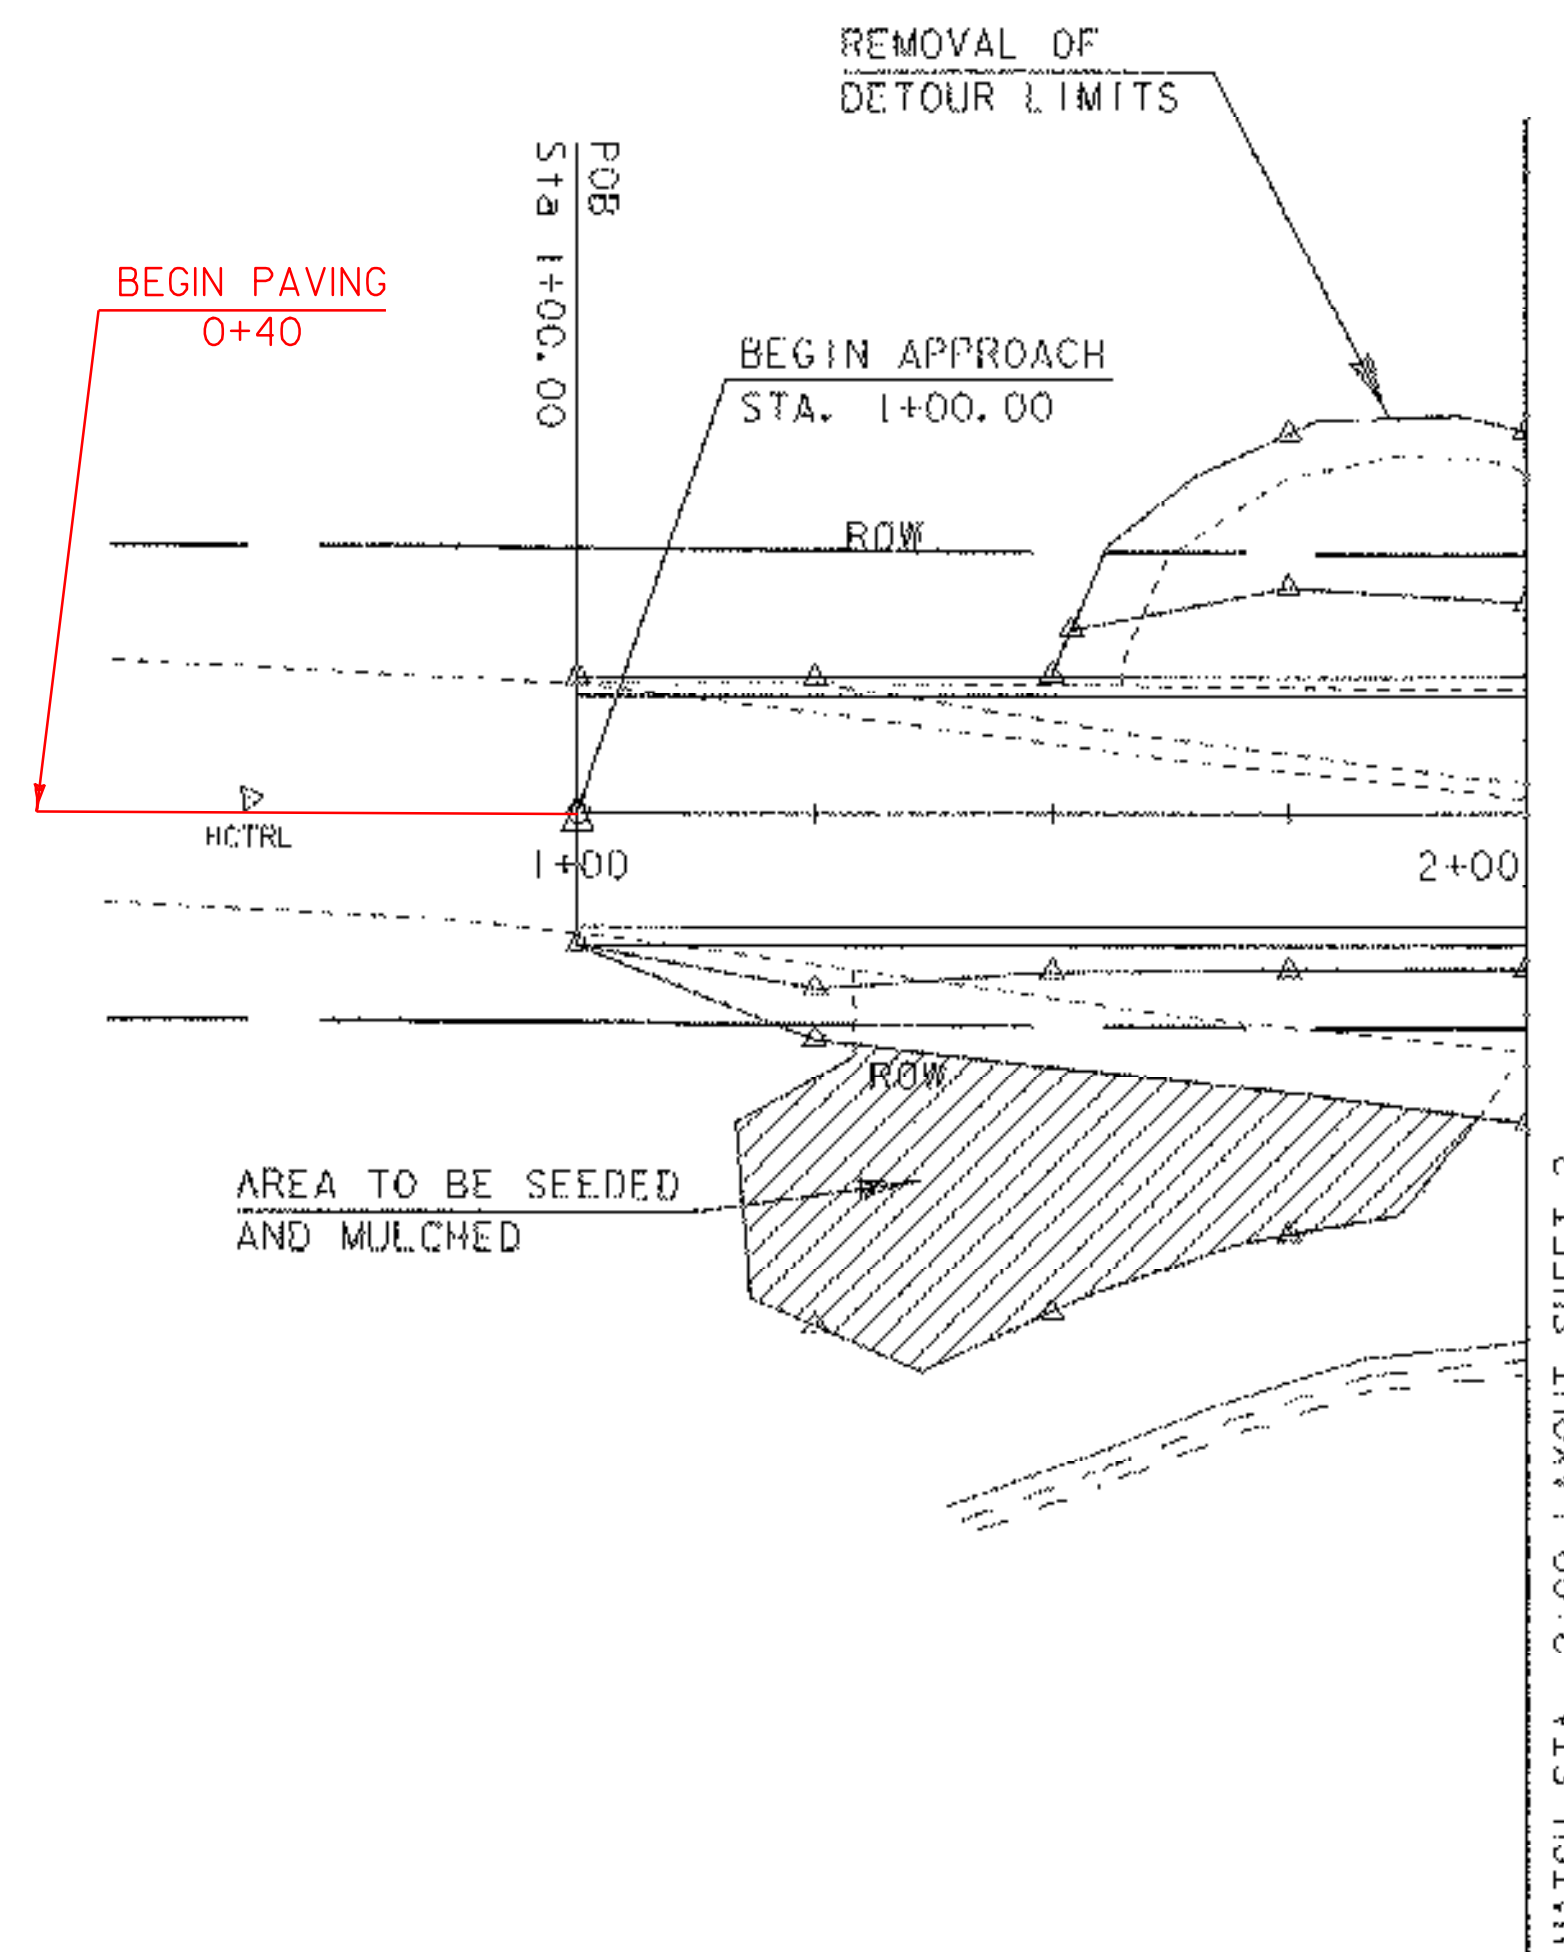

DATUM
 VERTICAL NAVD 88
 HORIZONTAL NAD 83 (96)

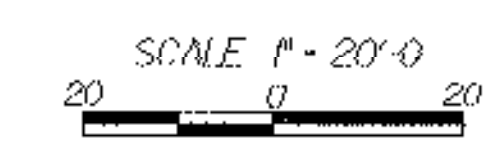

LAYOUT SHEET 1

PROJECT: BRISTOL	PROJECT NO.: ER ST 021-1 (22)
DESIGN FILE NAME: 05b126\str\805b126bdr.dgn	PLOT DATE: 20-MAR-2007
IPARM FILE NAME: s05b1261y1.i	CHECKED BY: G. ROKES
DESIGNED BY: M. EVANS-MONGEON	DRAWN BY: G. ROKES
SQUAD LEADER: M. EVANS-MONGEON	SHEET: 13 OF 66