


~~DURABLE 4 INCH WHITE LINE PAINT~~
 STA. 8+00 LT - STA. 12+75 LT 13+80
 STA. 8+00 RT - STA. 12+75 RT 13+80


~~DURABLE 4 INCH YELLOW LINE PAINT~~
 STA. 8+00 - STA. 12+75 LT and RT
 13+80

COLD PLANING, BITUMINOUS PAVEMENT
 STA. 8+00 - STA. 12+75

CONSTRUCT DRIVE (PAVED)
 STA. 10+43.00 LT (24' PAVED APRON)
 STA. 11+56.00 LT (24' PAVED APRON)

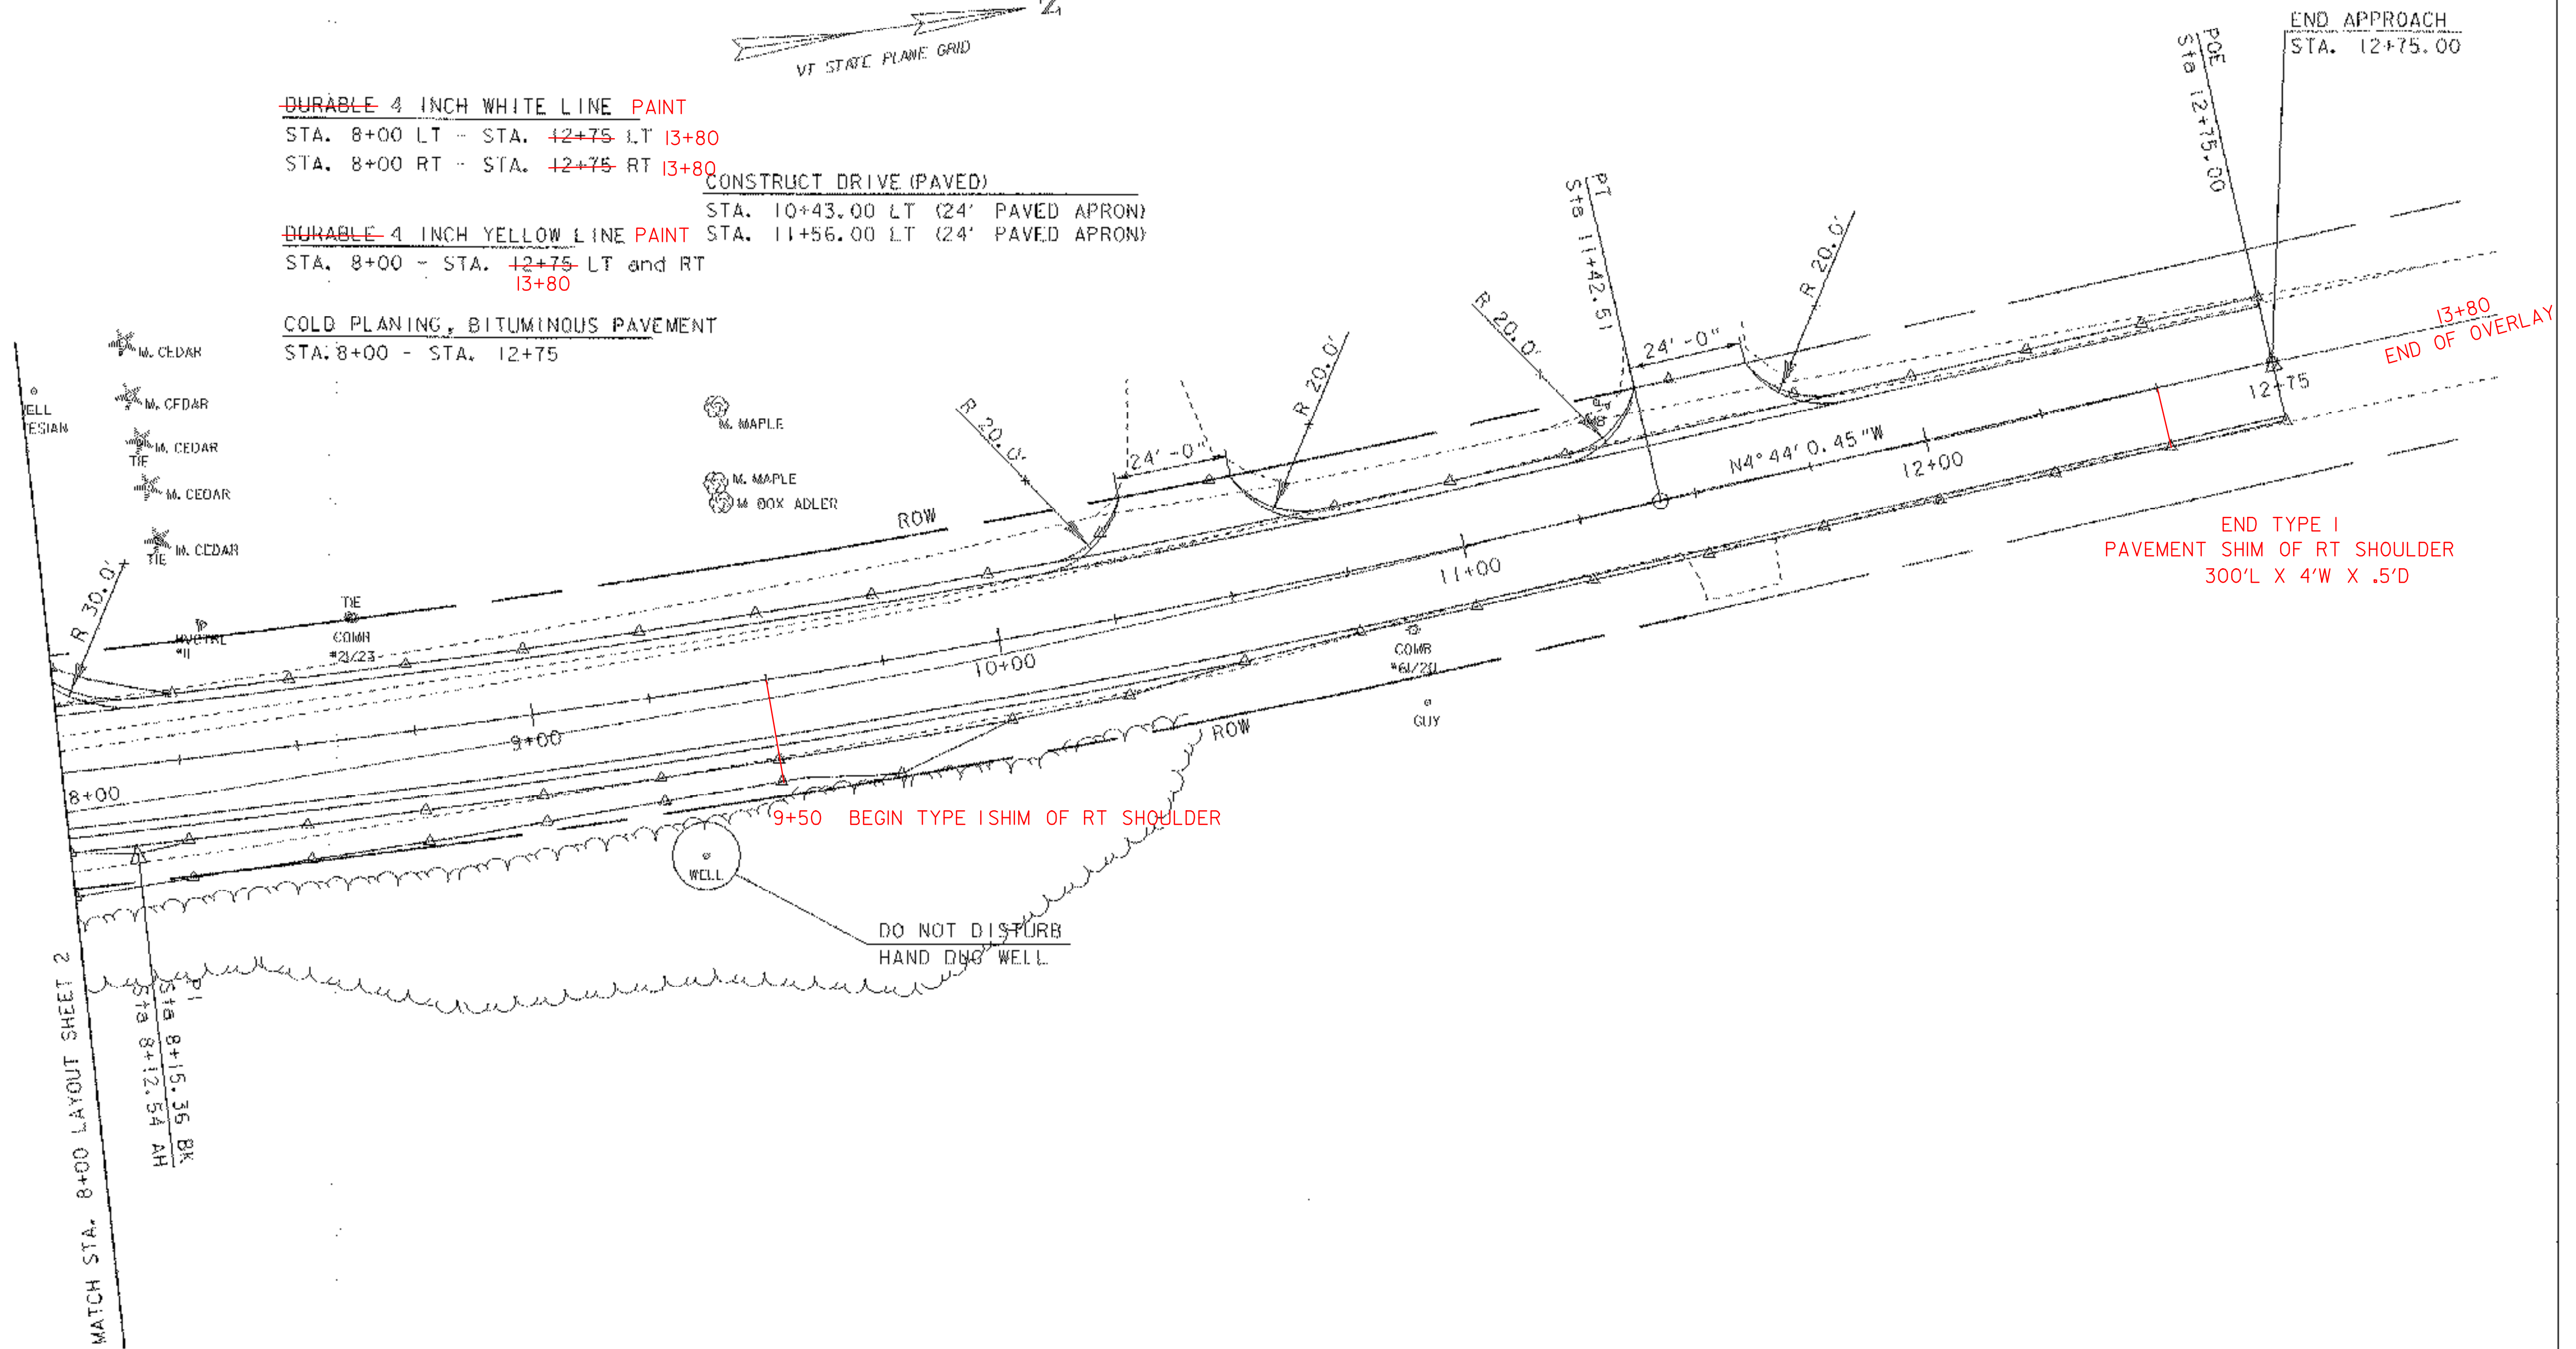

DATUM	
VERTICAL	NAV83
HORIZONTAL	NAV83 (1983)

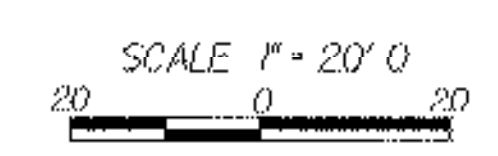

LAYOUT SHEET 3

PROJECT: BRISTOL	PROJECT NO.: ER ST 021-1 (22)
DESIGN FILE NAME: s05b126\str\s05b126bdr.dgn	PLOT DATE: 20-MAR-2007
IPARM FILE NAME: s05b126\ty3.i	CHECKED BY: G. ROKES
DESIGNED BY: M. EVANS-MONGEON	DRAWN BY: G. ROKES
SQUAD LEADER: M. EVANS-MONGEON	SHEET: 15 OF 66