

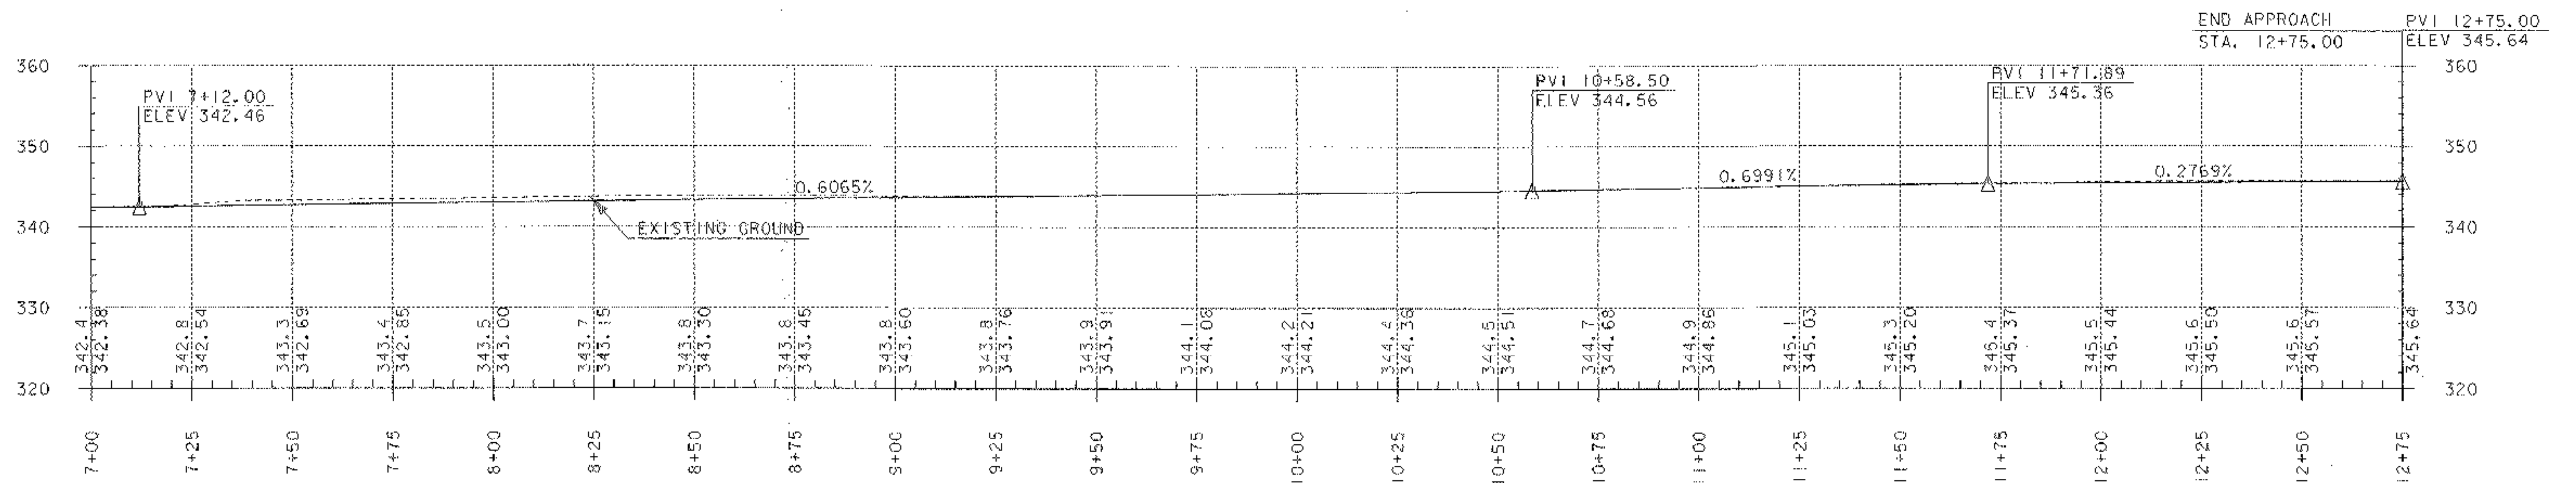


VT 116

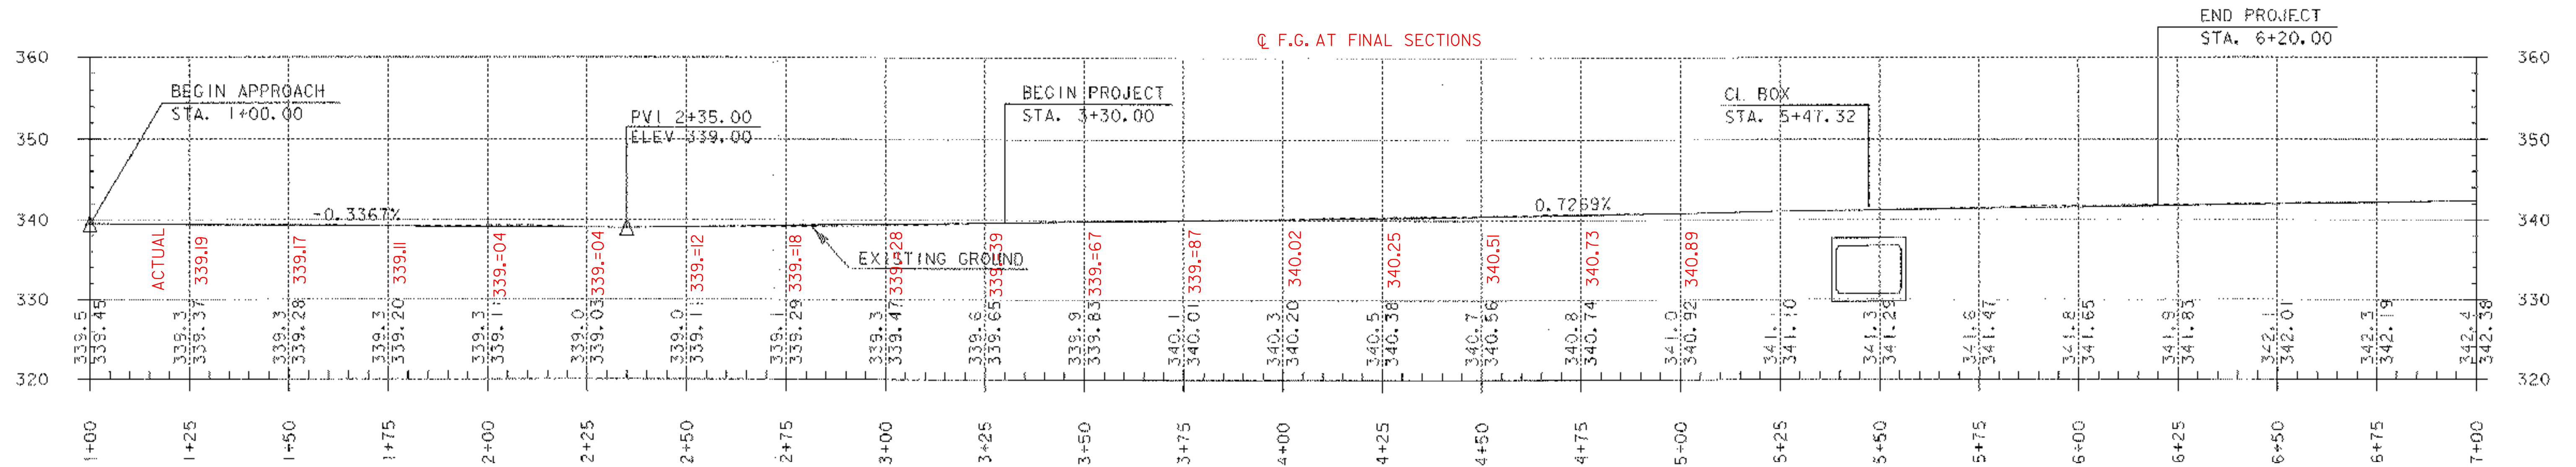

NOTE:
 GRADES SHOWN TO THE NEAREST TENTH
 ARE EXISTING GROUND ALONG CENTERLINE.
 GRADES SHOWN TO THE NEAREST HUNDREDTH
 ARE PROPOSED GROUND ALONG CENTERLINE.

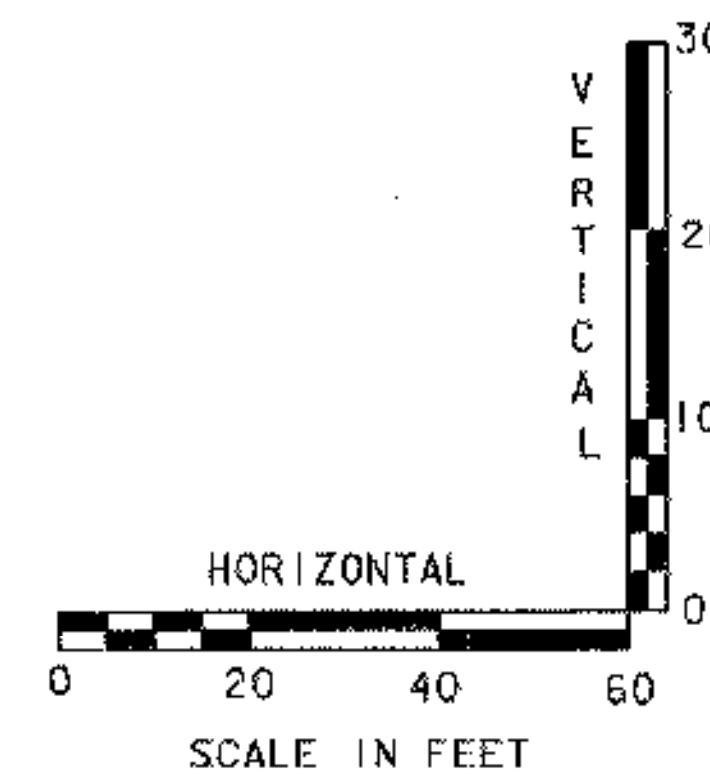

PROFILE SHEET

PROJECT: BRISTOL	PROJECT NO.: ER ST 021-1 (22)
DESIGN FILE NAME: 05b126\5tr\505b126wrk.dgn	PLOT DATE: 20-MAR-2007
IPARM FILE NAME: s05b126pr.f.1	SURVEY DATE:
SQUAD LEADER: M. EVANS-MONGON	DRAWN BY: G. ROKES
	SHEET: 16 OF 66