

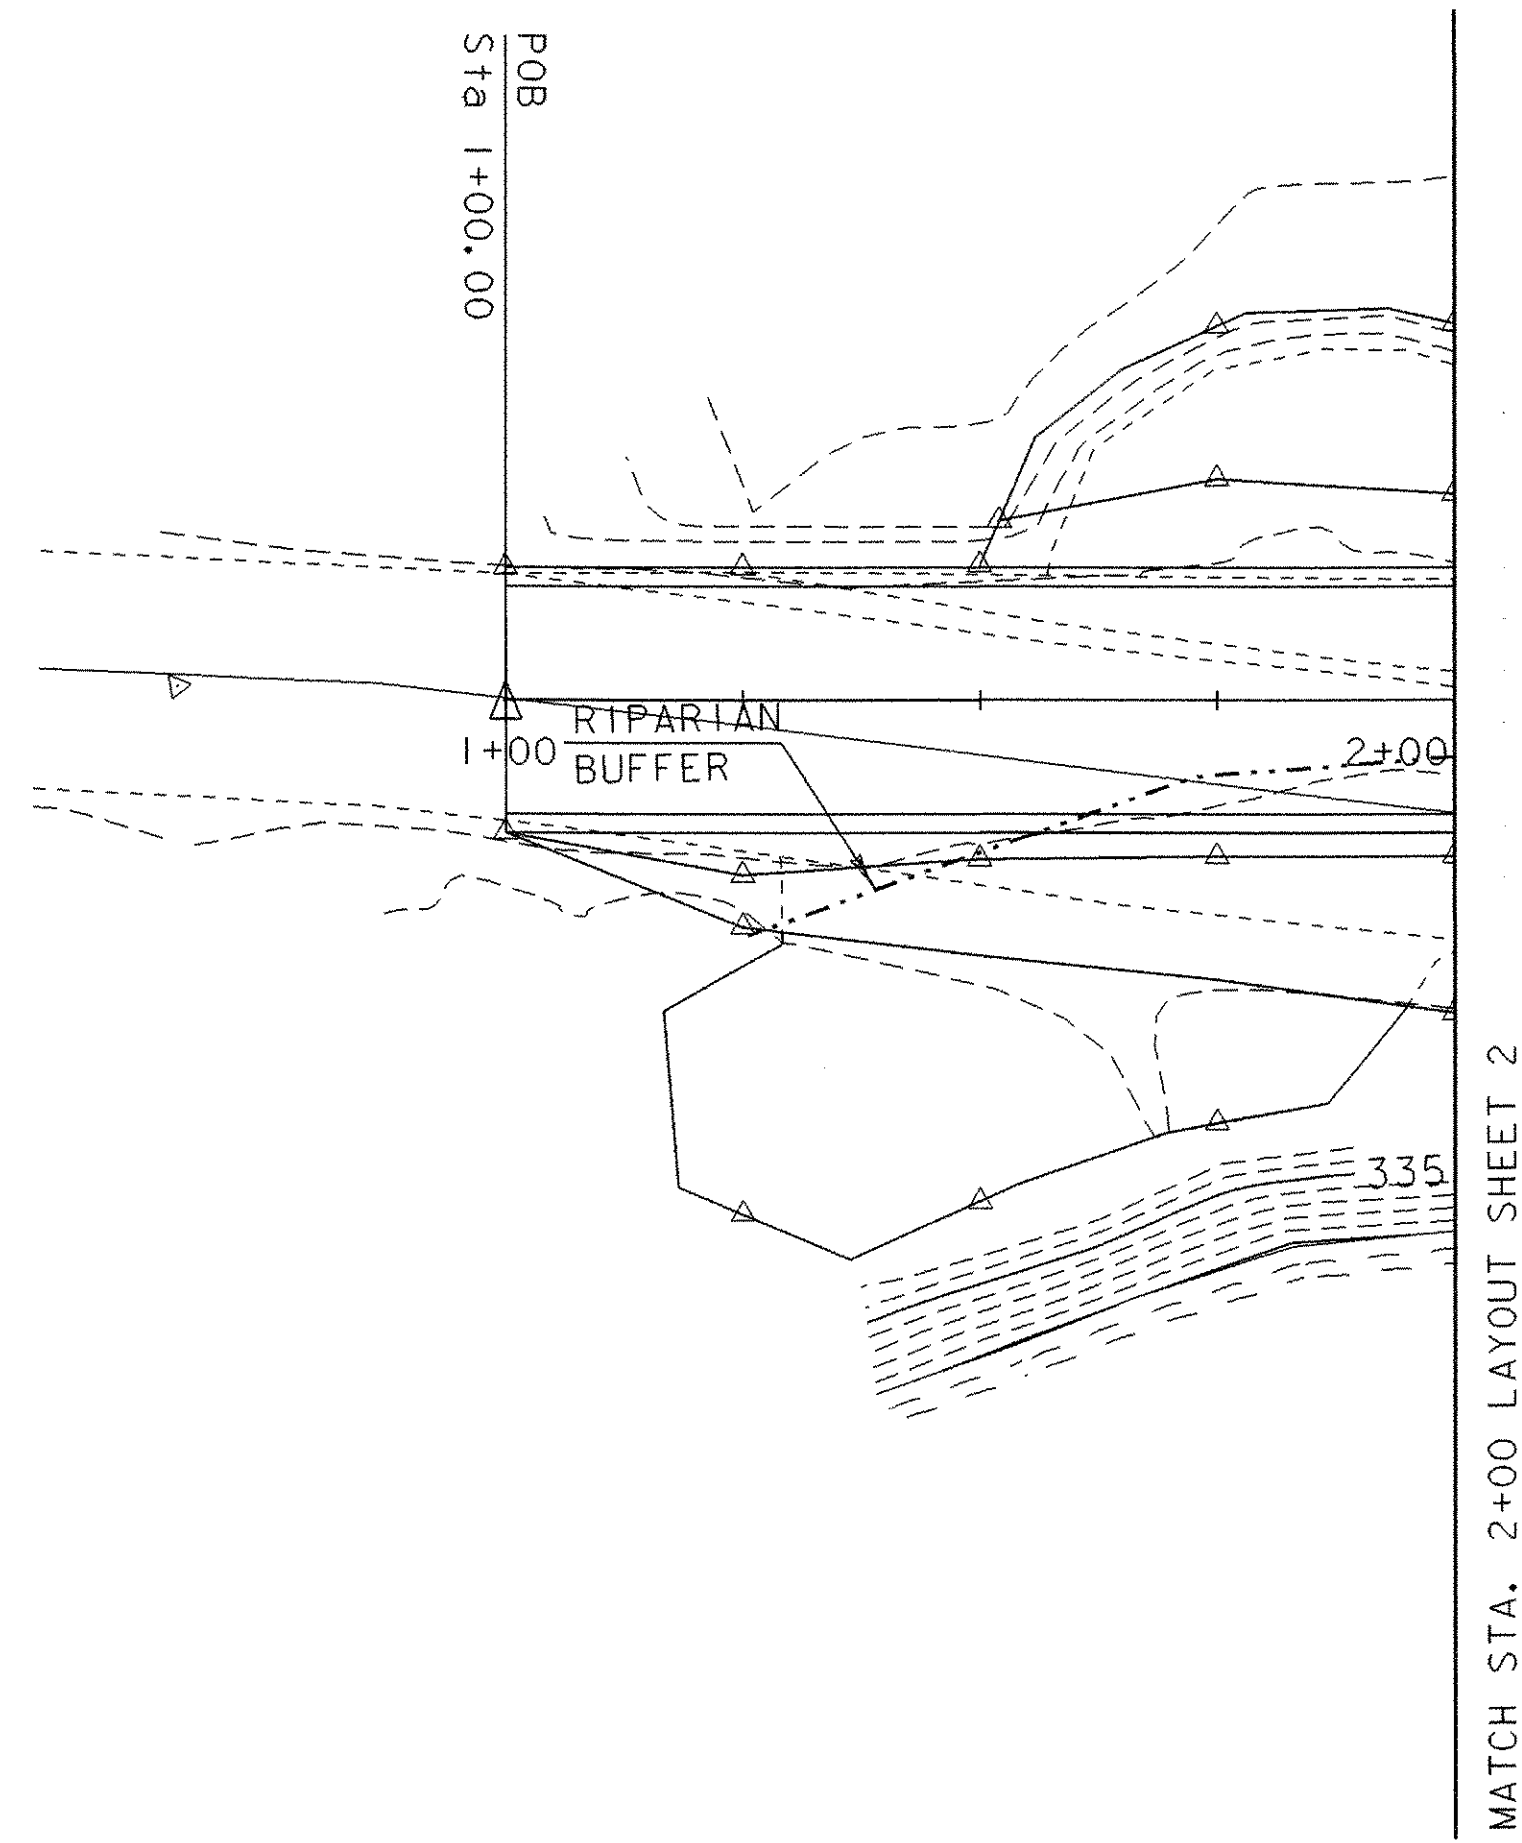


SOIL INFORMATION	
Le	- LIMRICK SILTY LOAM
	HIGH ERODIBILITY
	HYDRAULIC GROUP C
	RAPID SURFACE WATER RUNOFF
	ERODIBILITY COEFFICIENT (K) = 0.49

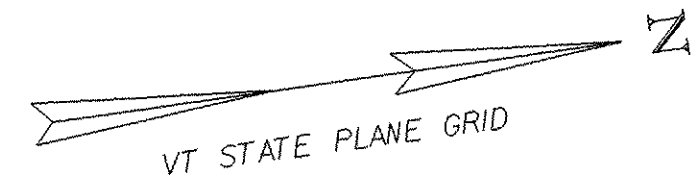

DATUM	
VERTICAL	NAVD 88
HORIZONTAL	NAD 83 (96)

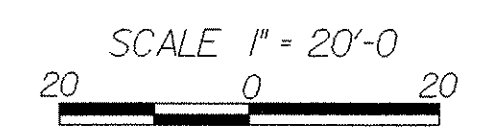

**FINAL CONDITIONS SITE PLAN 1**

PROJECT: BRISTOL	PROJECT NO.: ER ST 021-1 (22)
DESIGN FILE NAME: 05b126\str\s05b126bdr.dgn	PLOT DATE: 20-MAR-2007
IPARM FILE NAME: s05b1261y1.i	CHECKED BY: M. EVANS-MONGEON
DESIGNED BY: G. ROKES	DRAWN BY: G. ROKES
SQUAD LEADER: M. EVANS-MONGEON	SHEET: 25 OF 66