


DATUM	
VERTICAL	NAVD 88
HORIZONTAL	NAD 83 (96)

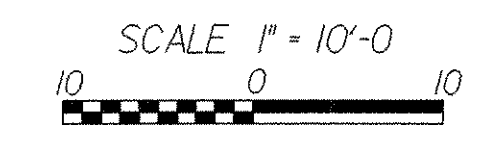

PLAN AND ELEVATION	
PROJECT: BRISTOL	PROJECT NO.: ER ST 021-1 (22)
DESIGN FILE NAME: 05b126\str\s05b126pe.dgn	PLT DATE: 27-MAR-2007
IPARM FILE NAME: s05b126pe.i	CHECKED BY: G.ROKES
DESIGNED BY: M. EVANS-MONGEON	DRAWN BY: G.ROKES
SQUAD LEADER: M. EVANS-MONGEON	SHEET: 35 OF 66