




1+00
BEGIN APPROACH

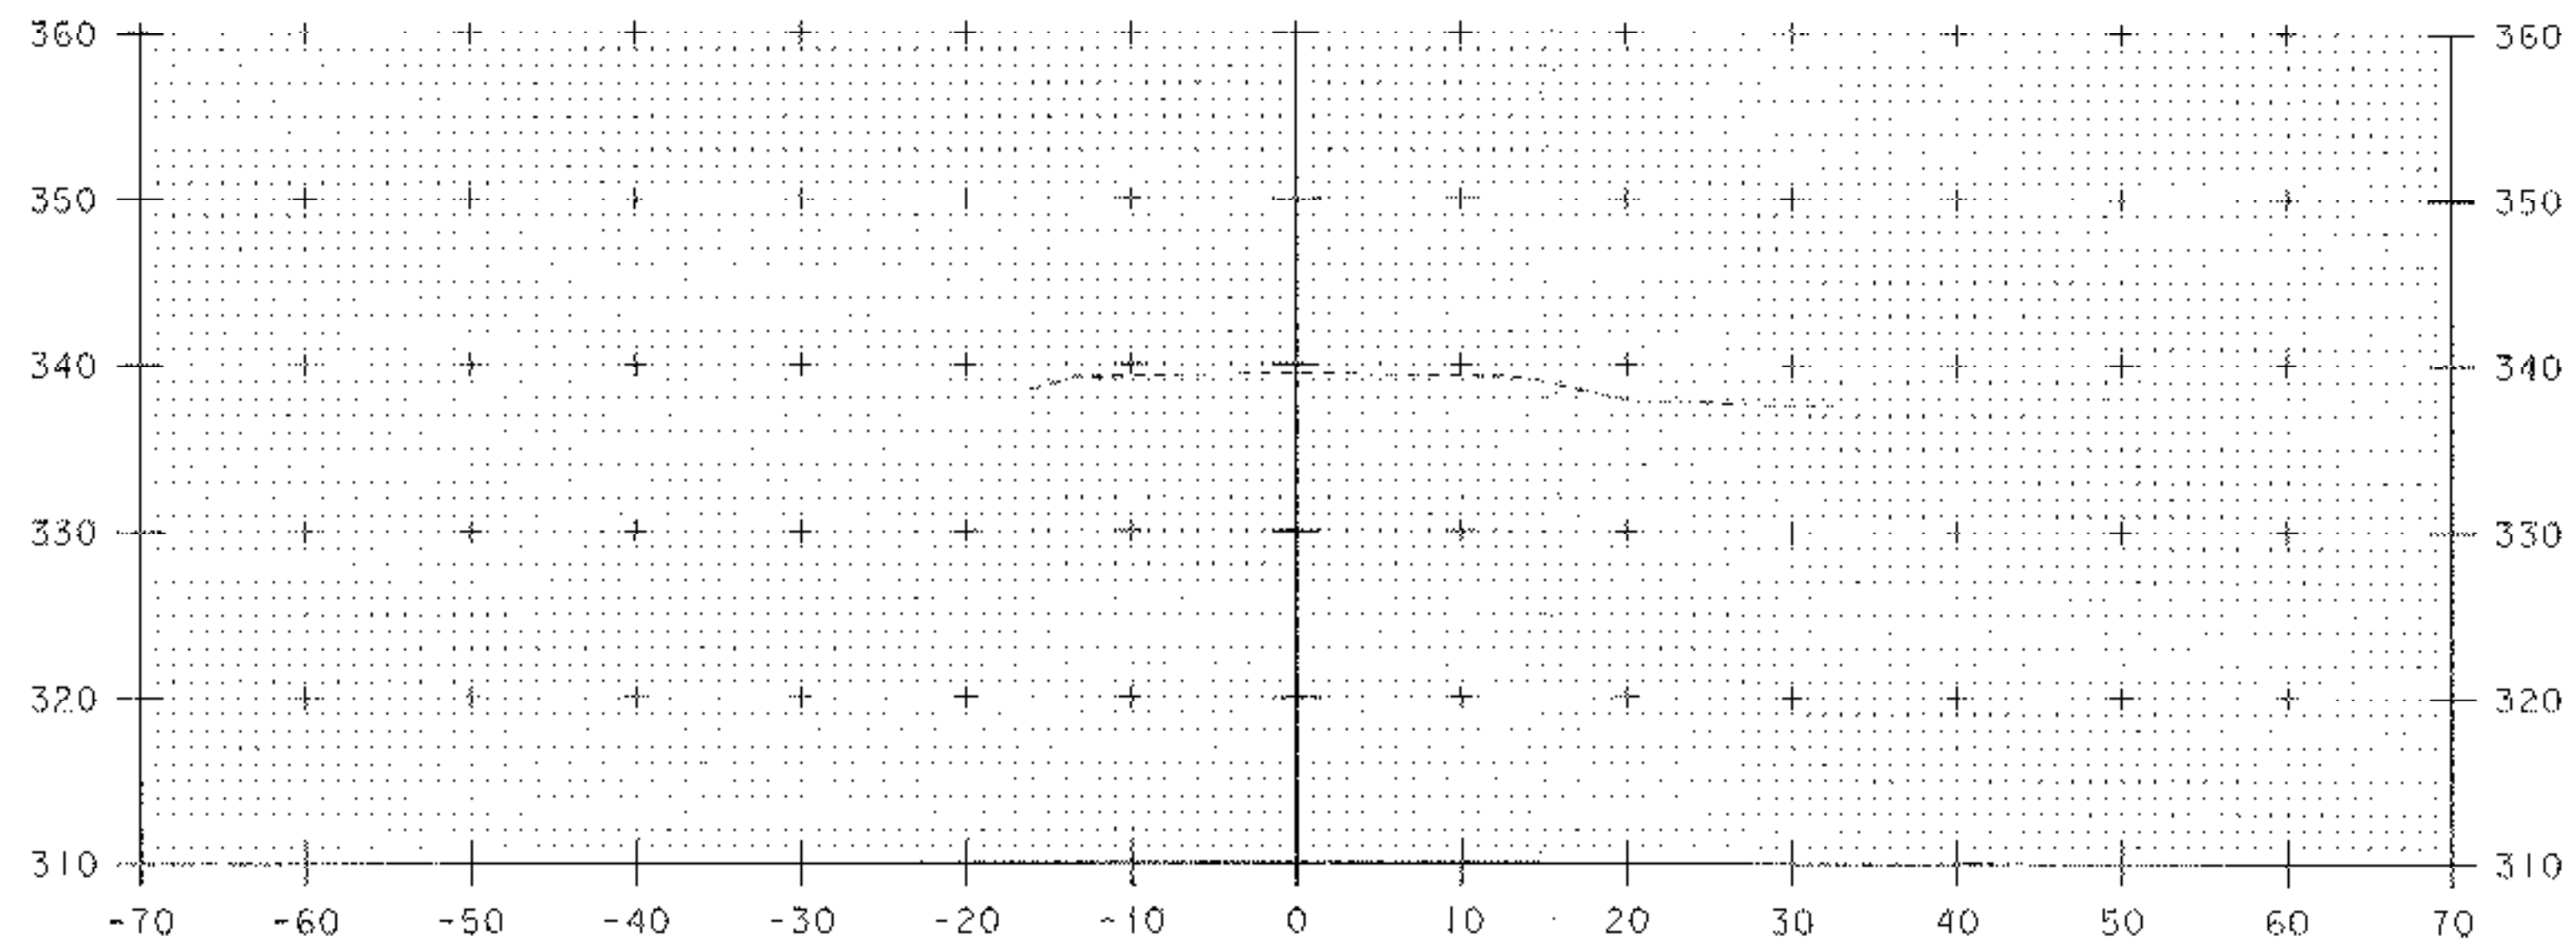

1+00

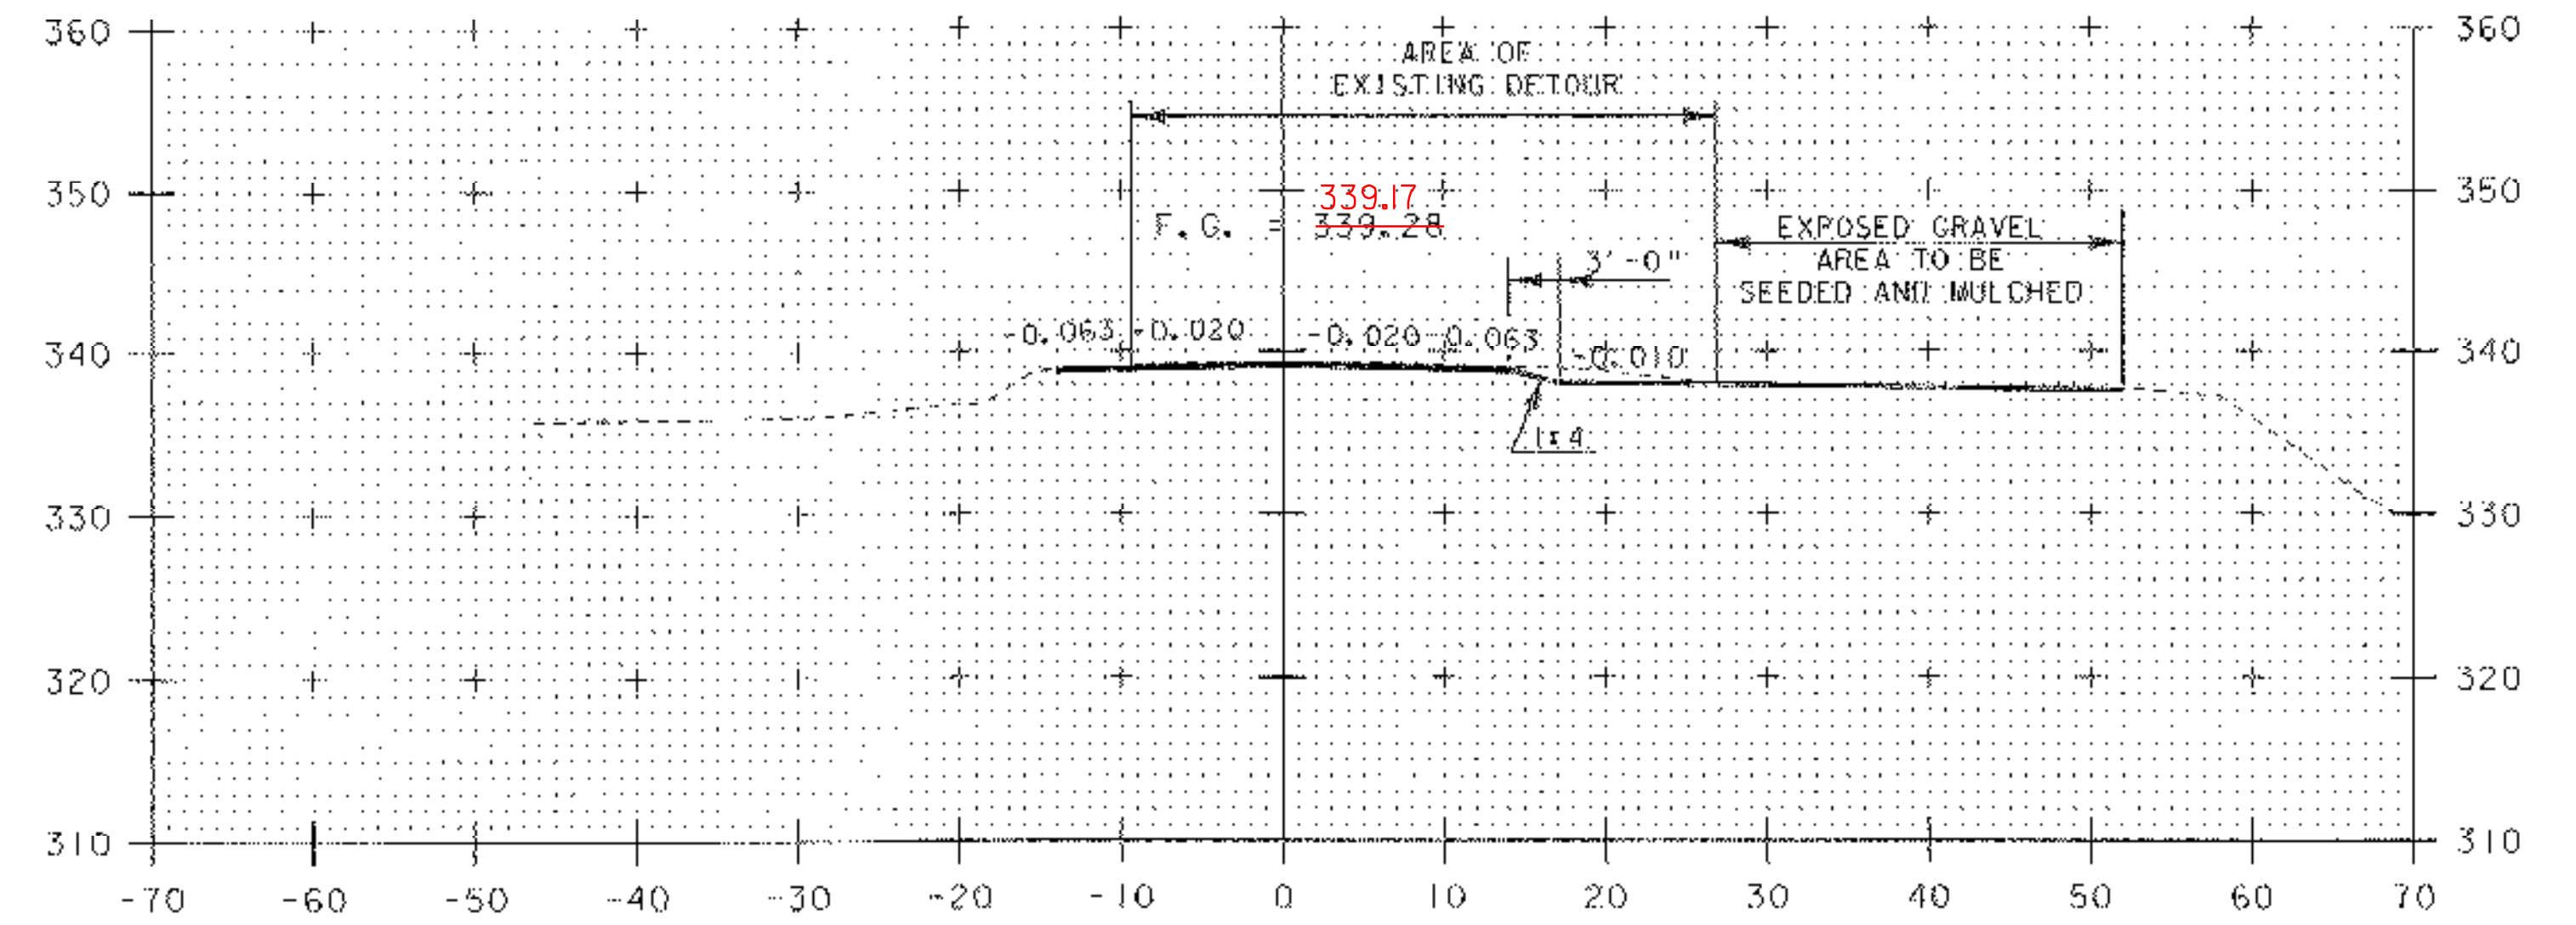

1+50

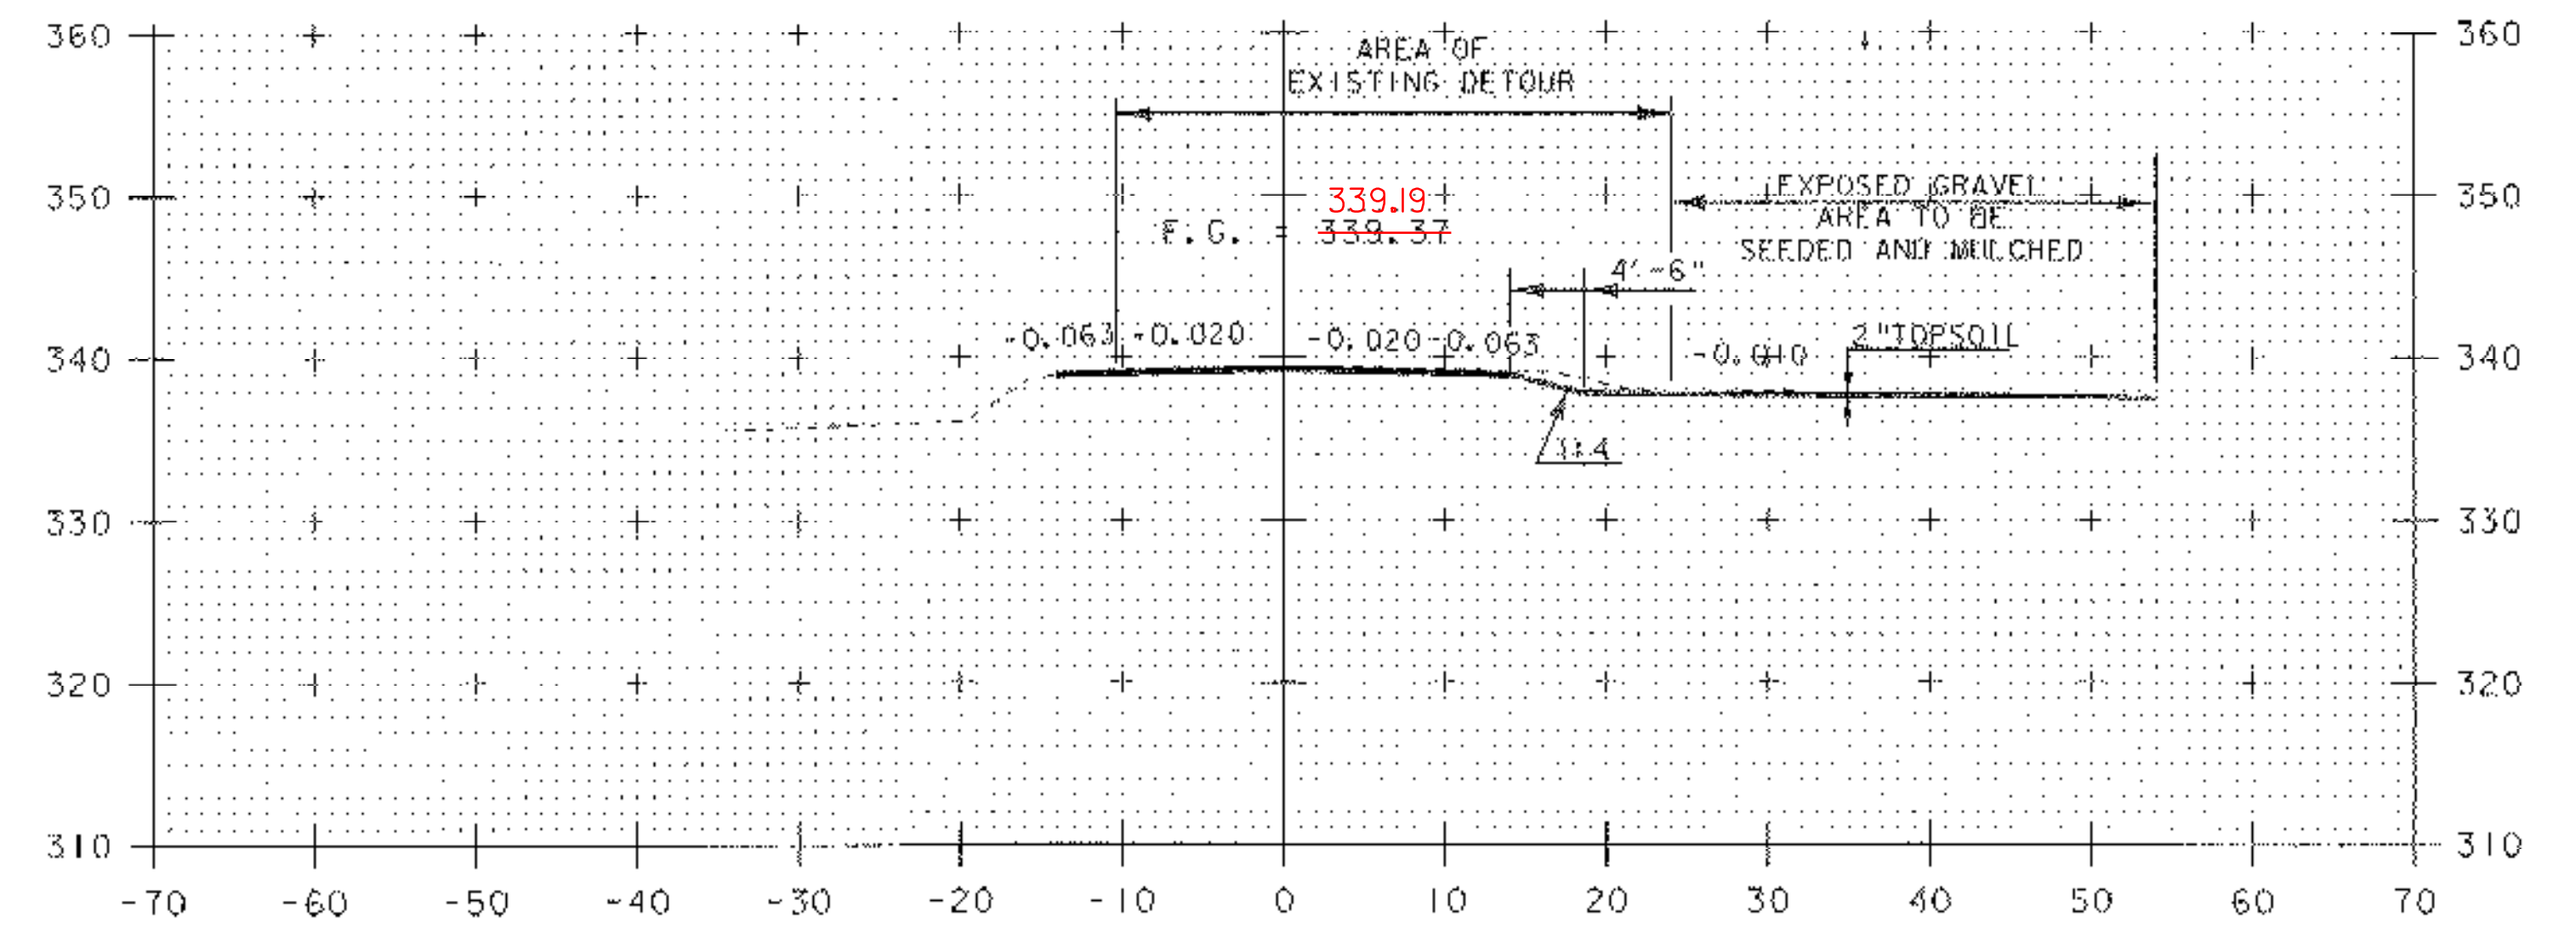

1+25

VT 116 SECTIONS 1

PROJECT NAME:	BRISTOL
PROJECT NUMBER:	ER ST 021-1(22)
FILE NAME:	05b126\STR\05b126.xls.dgn
PROJECT LEADER:	M. EVANS-MONGEON
DESIGNED BY:	M. EVANS-MONGEON
IPARM:	05b126.xls.1
PLOT DATE:	20-MAR-2007
DRAWN BY:	G. ROKES
CHECKED BY:	G. ROKES
SHEET:	47 OF 66