




2+00

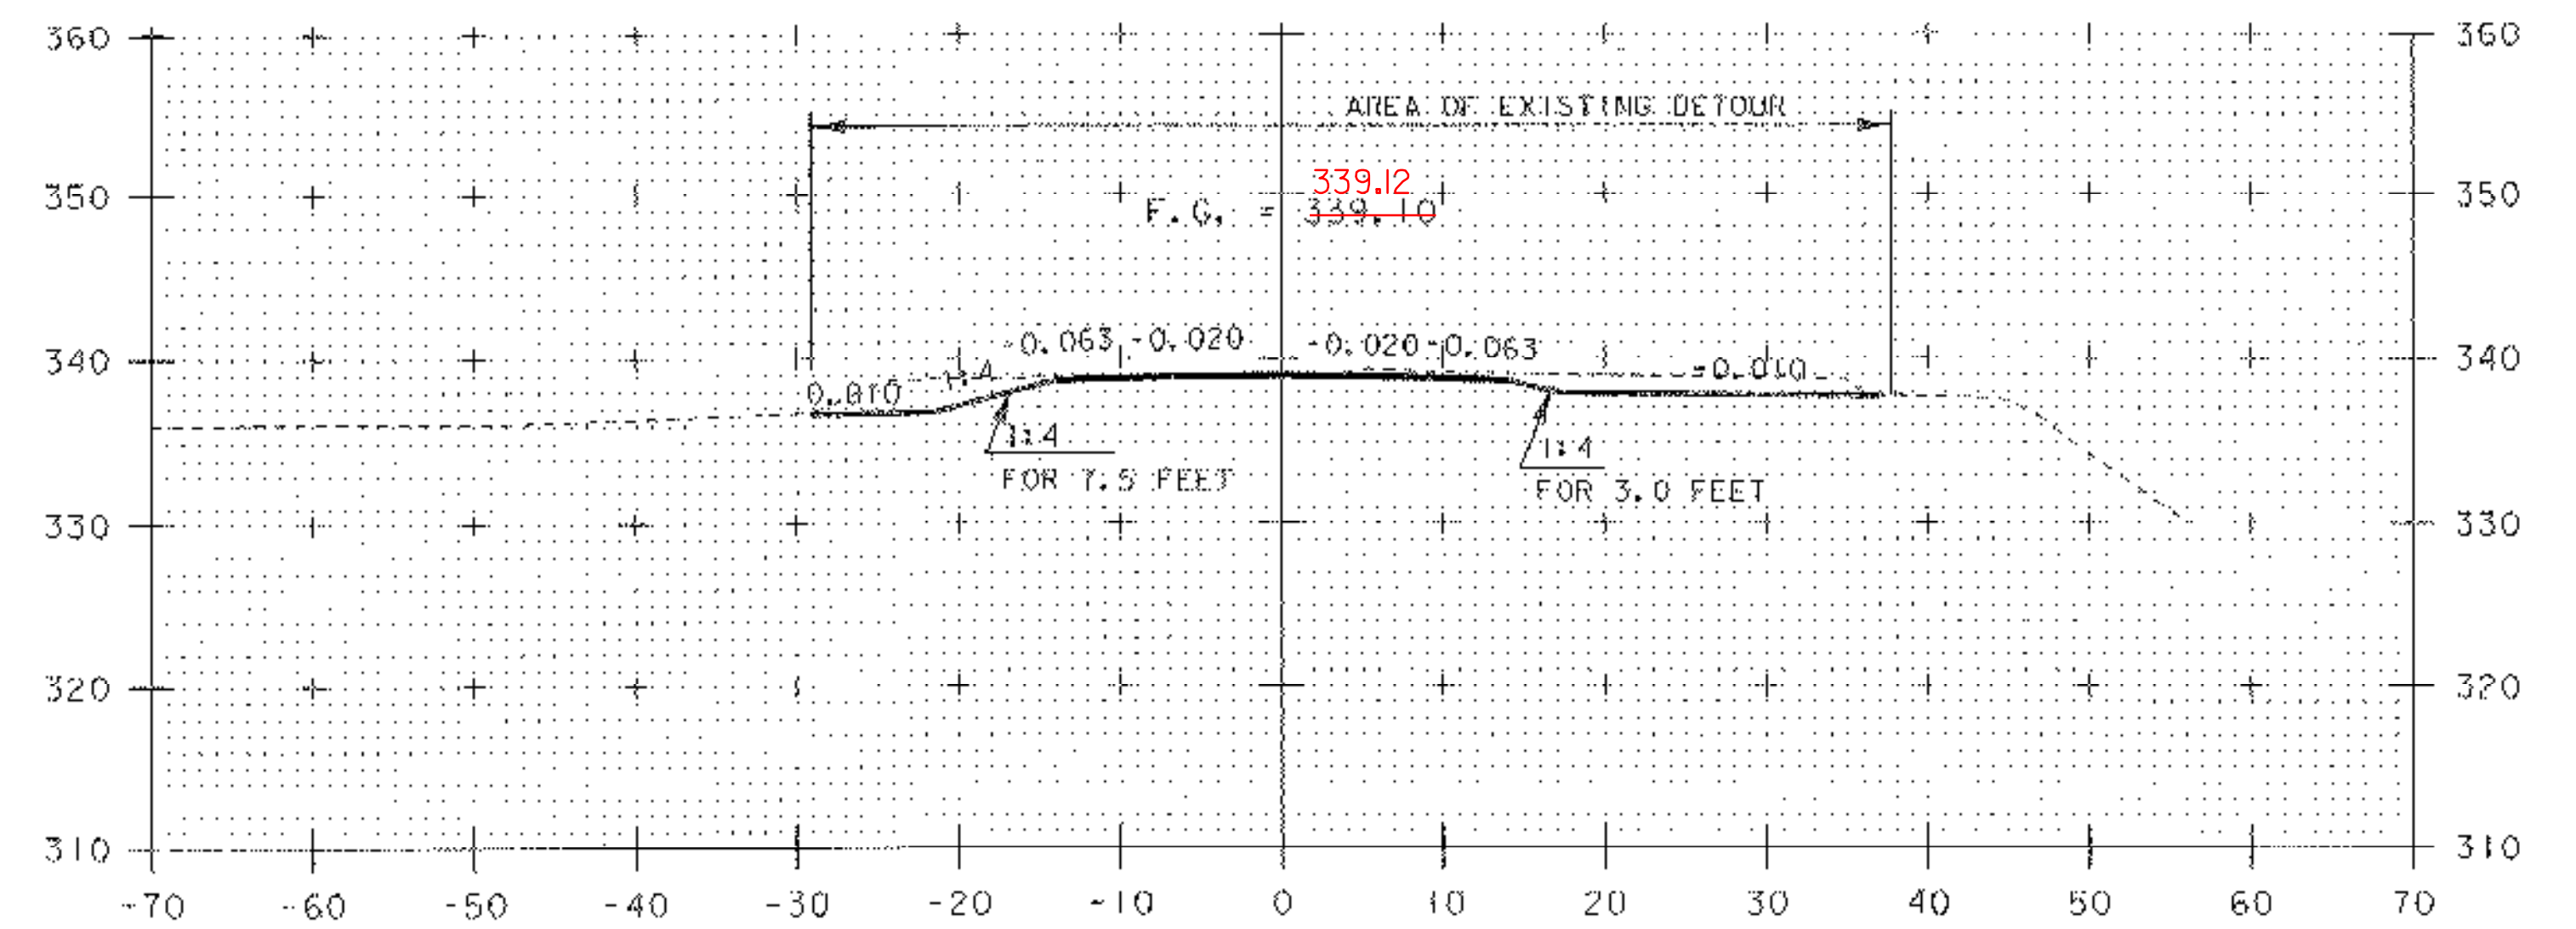

2+50

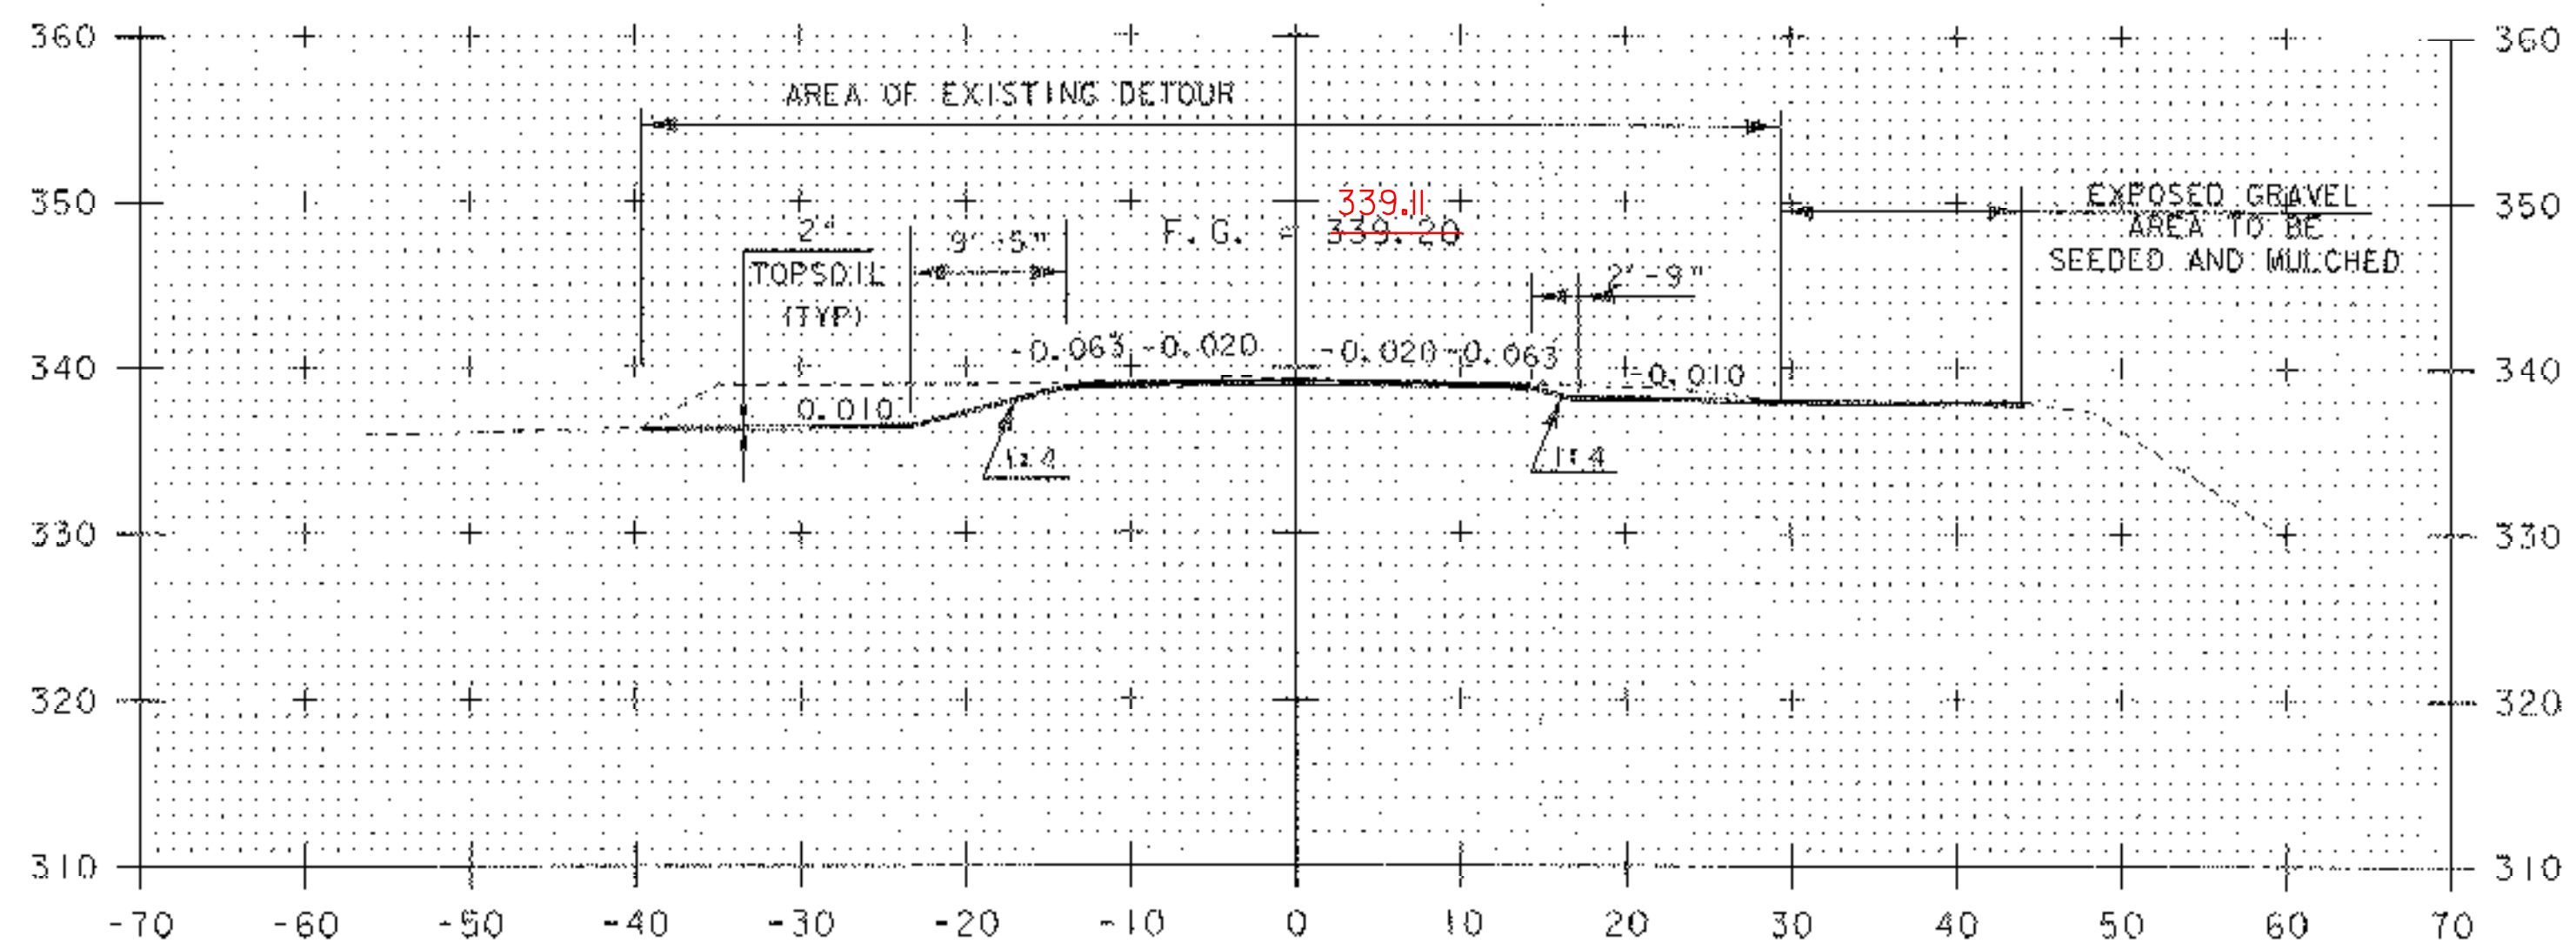

1+75

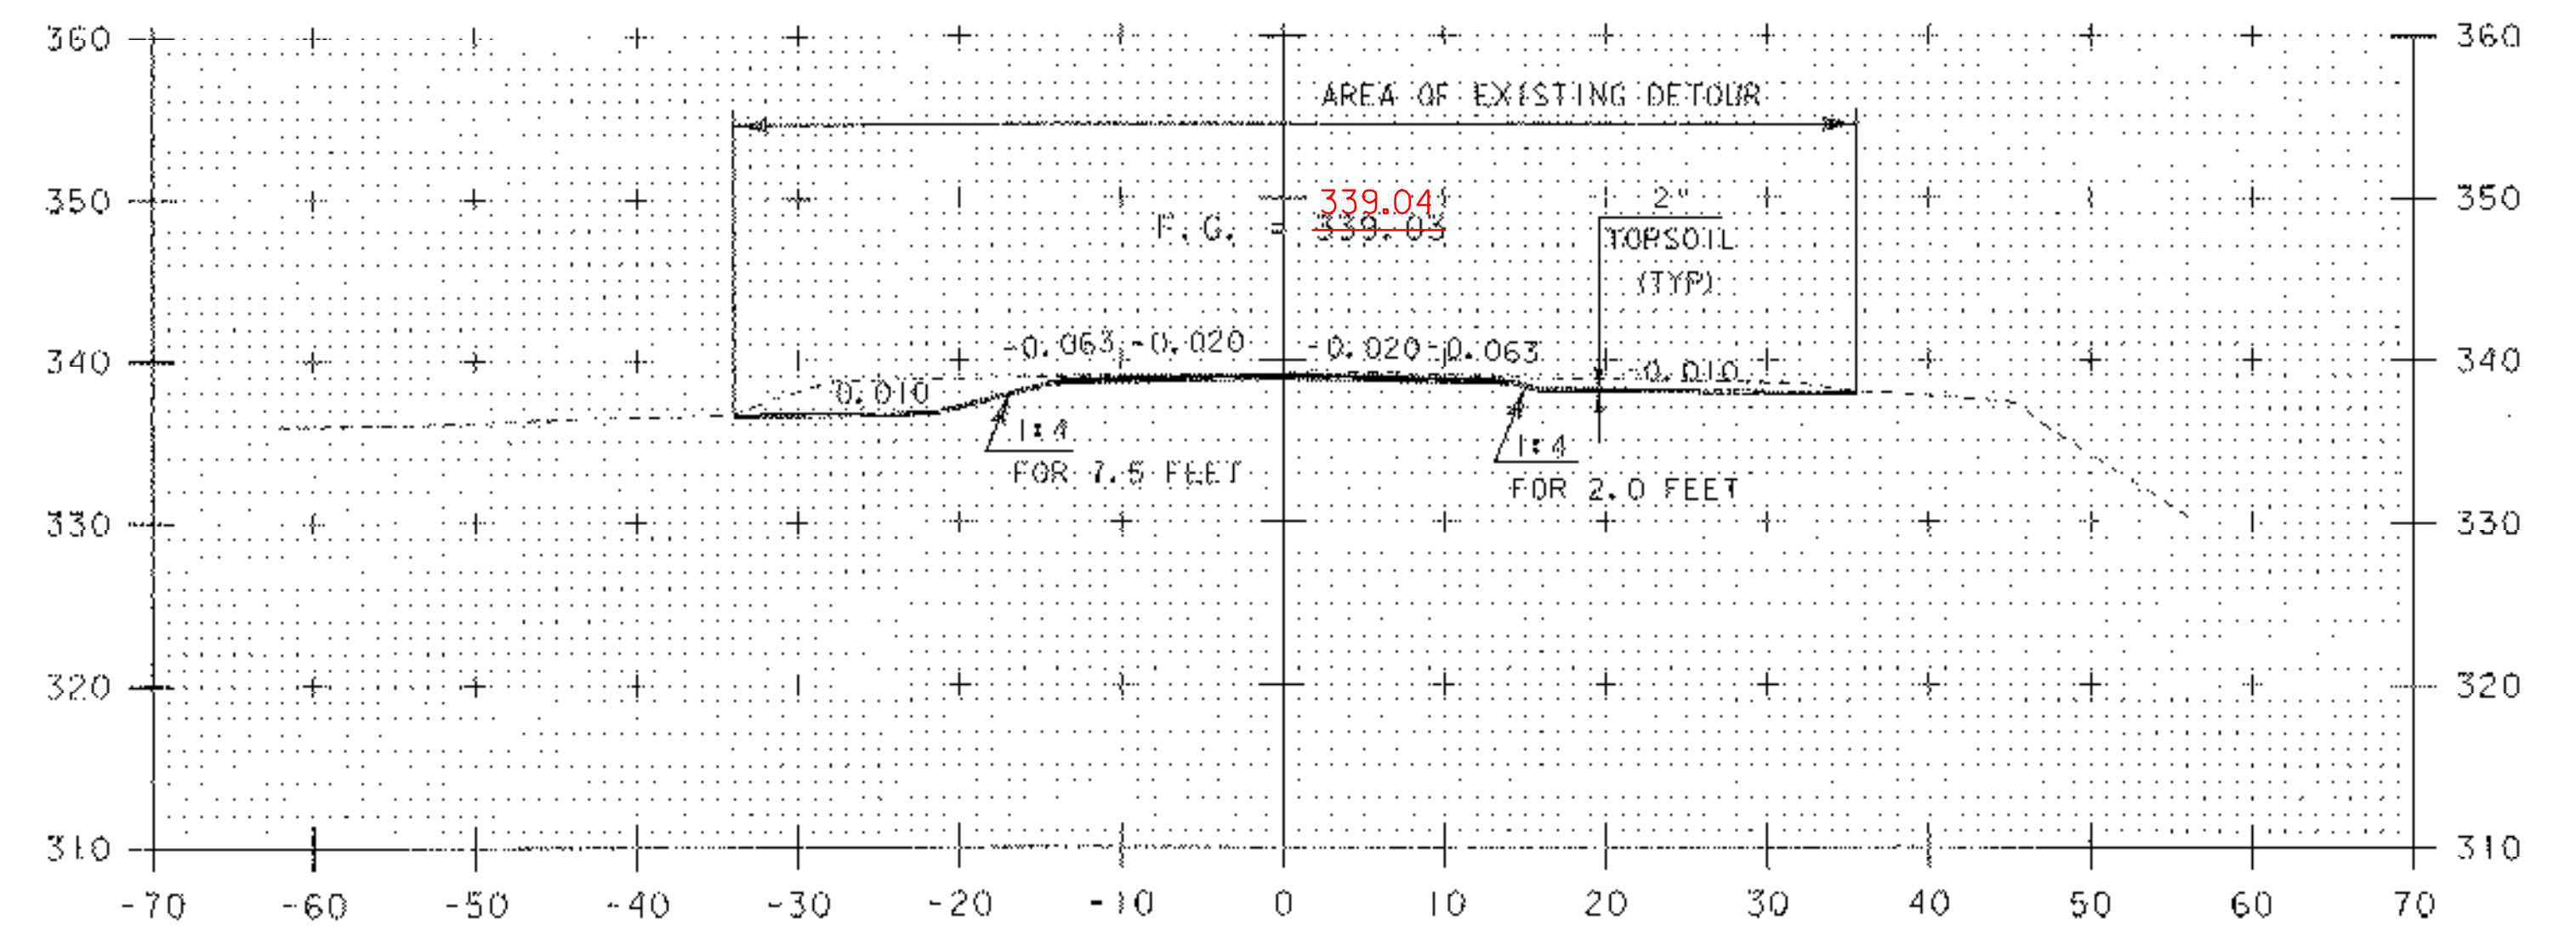

2+25

VT 116 SECTIONS 2

PROJECT NAME:	BRISTOL	PILOT DATE:	20-MAR-2007
PROJECT NUMBER:	ER ST 021-1(22)	DRAWN BY:	G. ROKES
FILE NAME:	05b126\STR\s05b126xs.dgn	CHECKED BY:	G. ROKES
PROJECT LEADER:	M. EVANS-MONGEON	SHEET	48 OF 66
DESIGNED BY:	M. EVANS-MONGEON		
IPARM	s05b126x21j		