




3+75

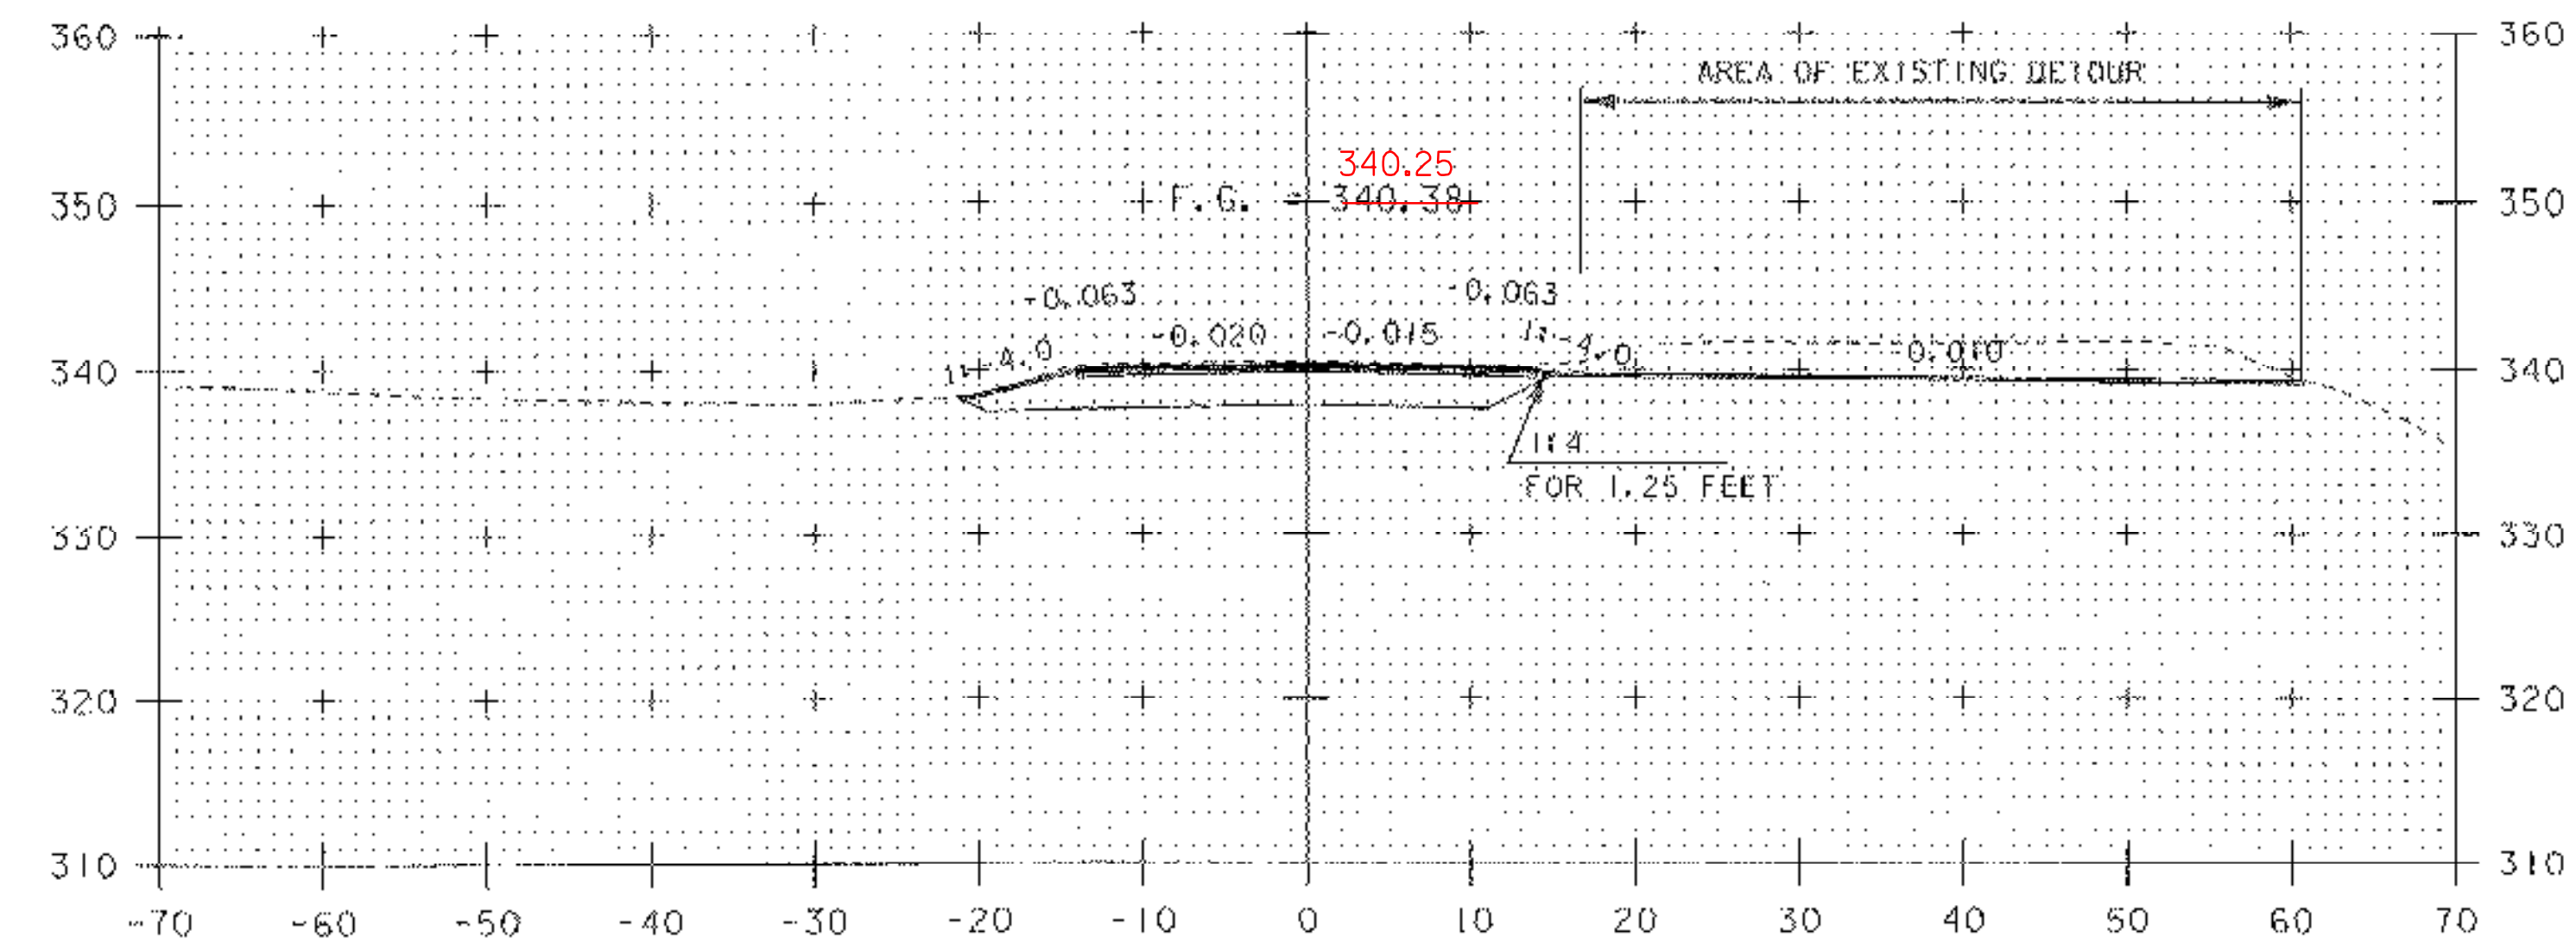

4+25

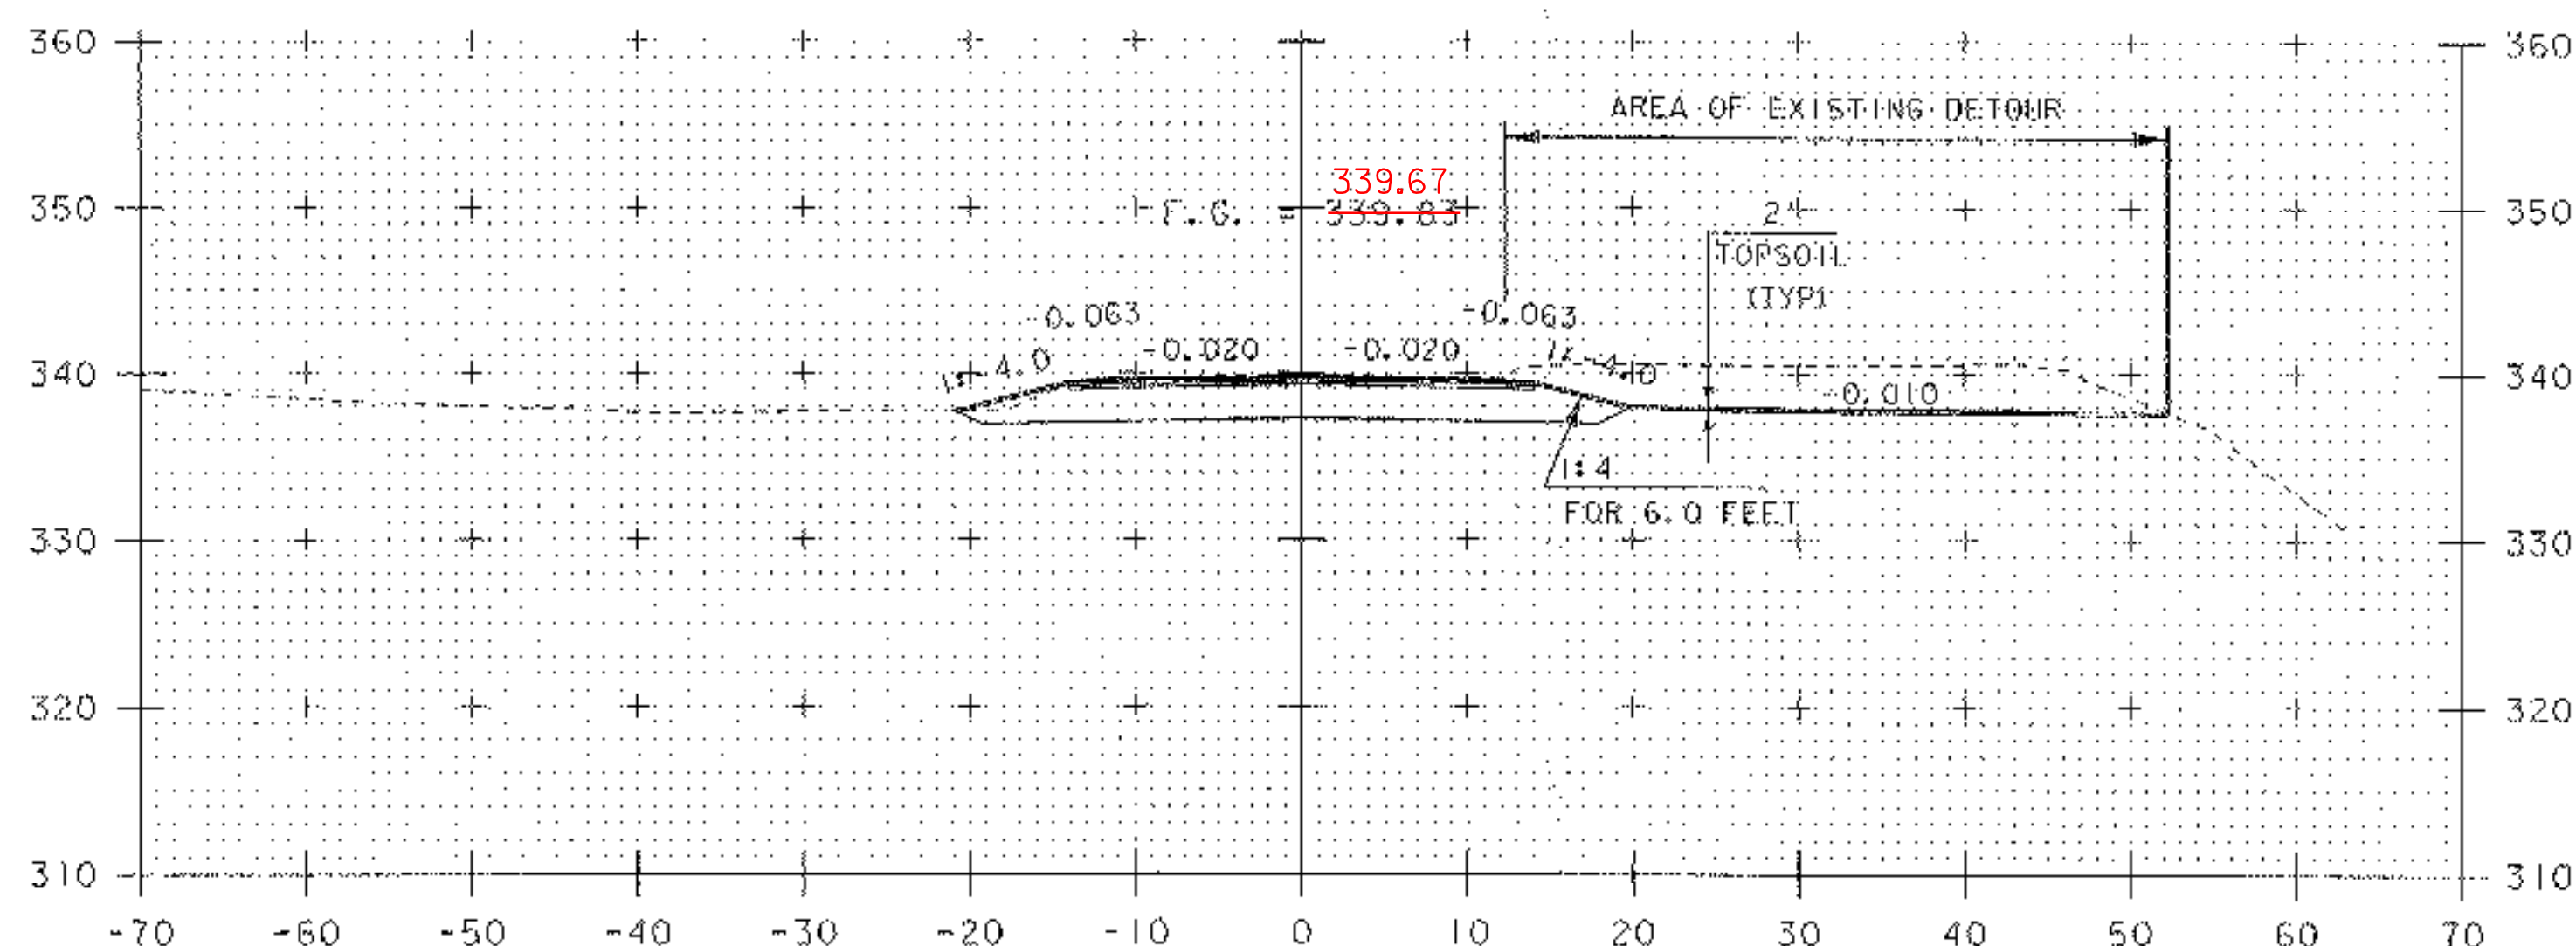

3+50

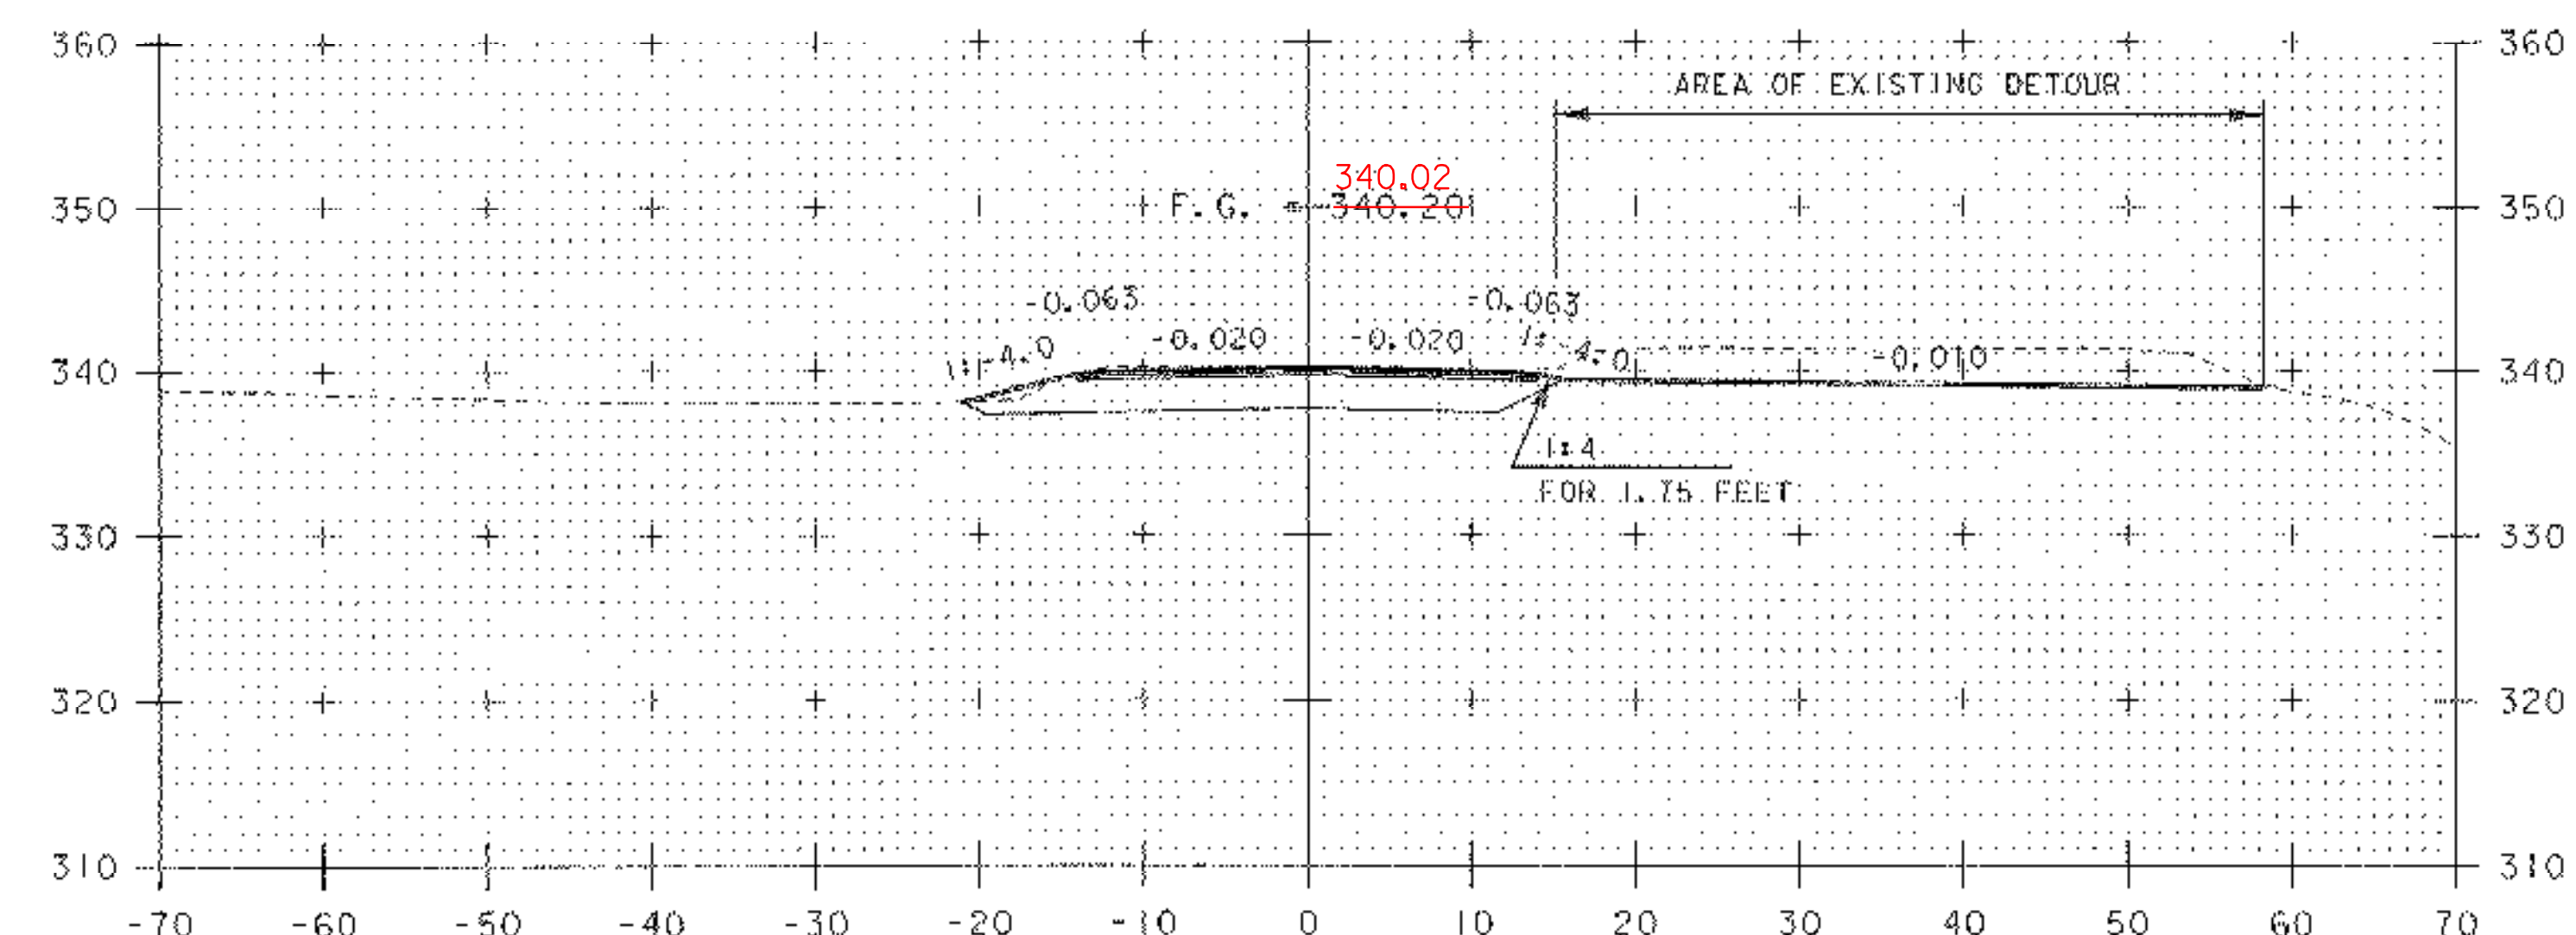

4+00

**VT 116 SECTIONS 4**

PROJECT NAME:	BRISTOL
PROJECT NUMBER:	ER ST 021-1(22)
FILE NAME:	05b126\STR\s05b126xs.dgn
PROJECT LEADER:	M. EVANS-MONGEON
DESIGNED BY:	M. EVANS-MONGEON
IPARM:	s05b126xs4.l
PLOT DATE:	20-MAR-2007
DRAWN BY:	G. ROKES
CHECKED BY:	G. ROKES
SHEET:	50 OF 66