




4+58  
CENTER DRIVE (LEFT)

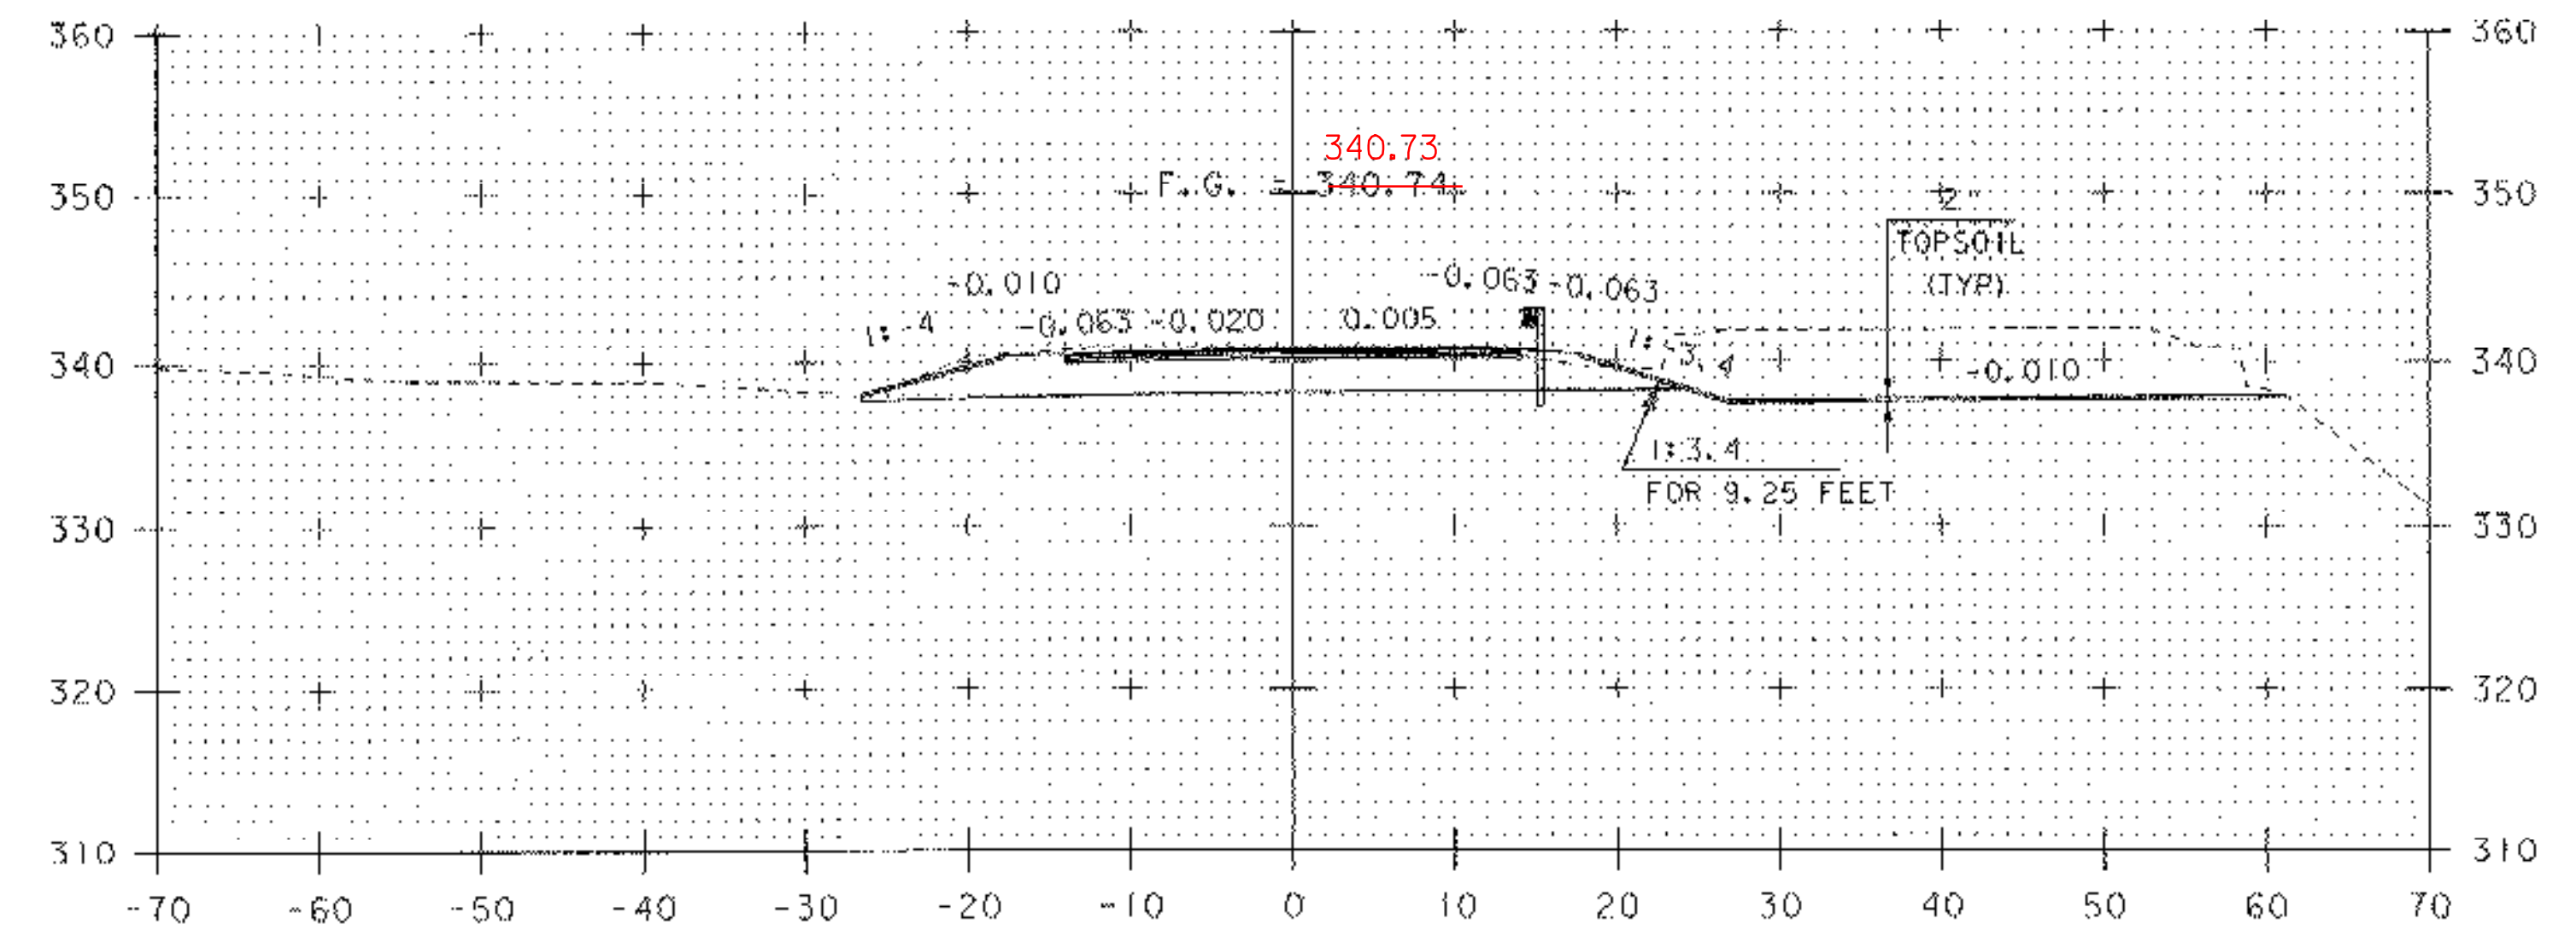

4+75

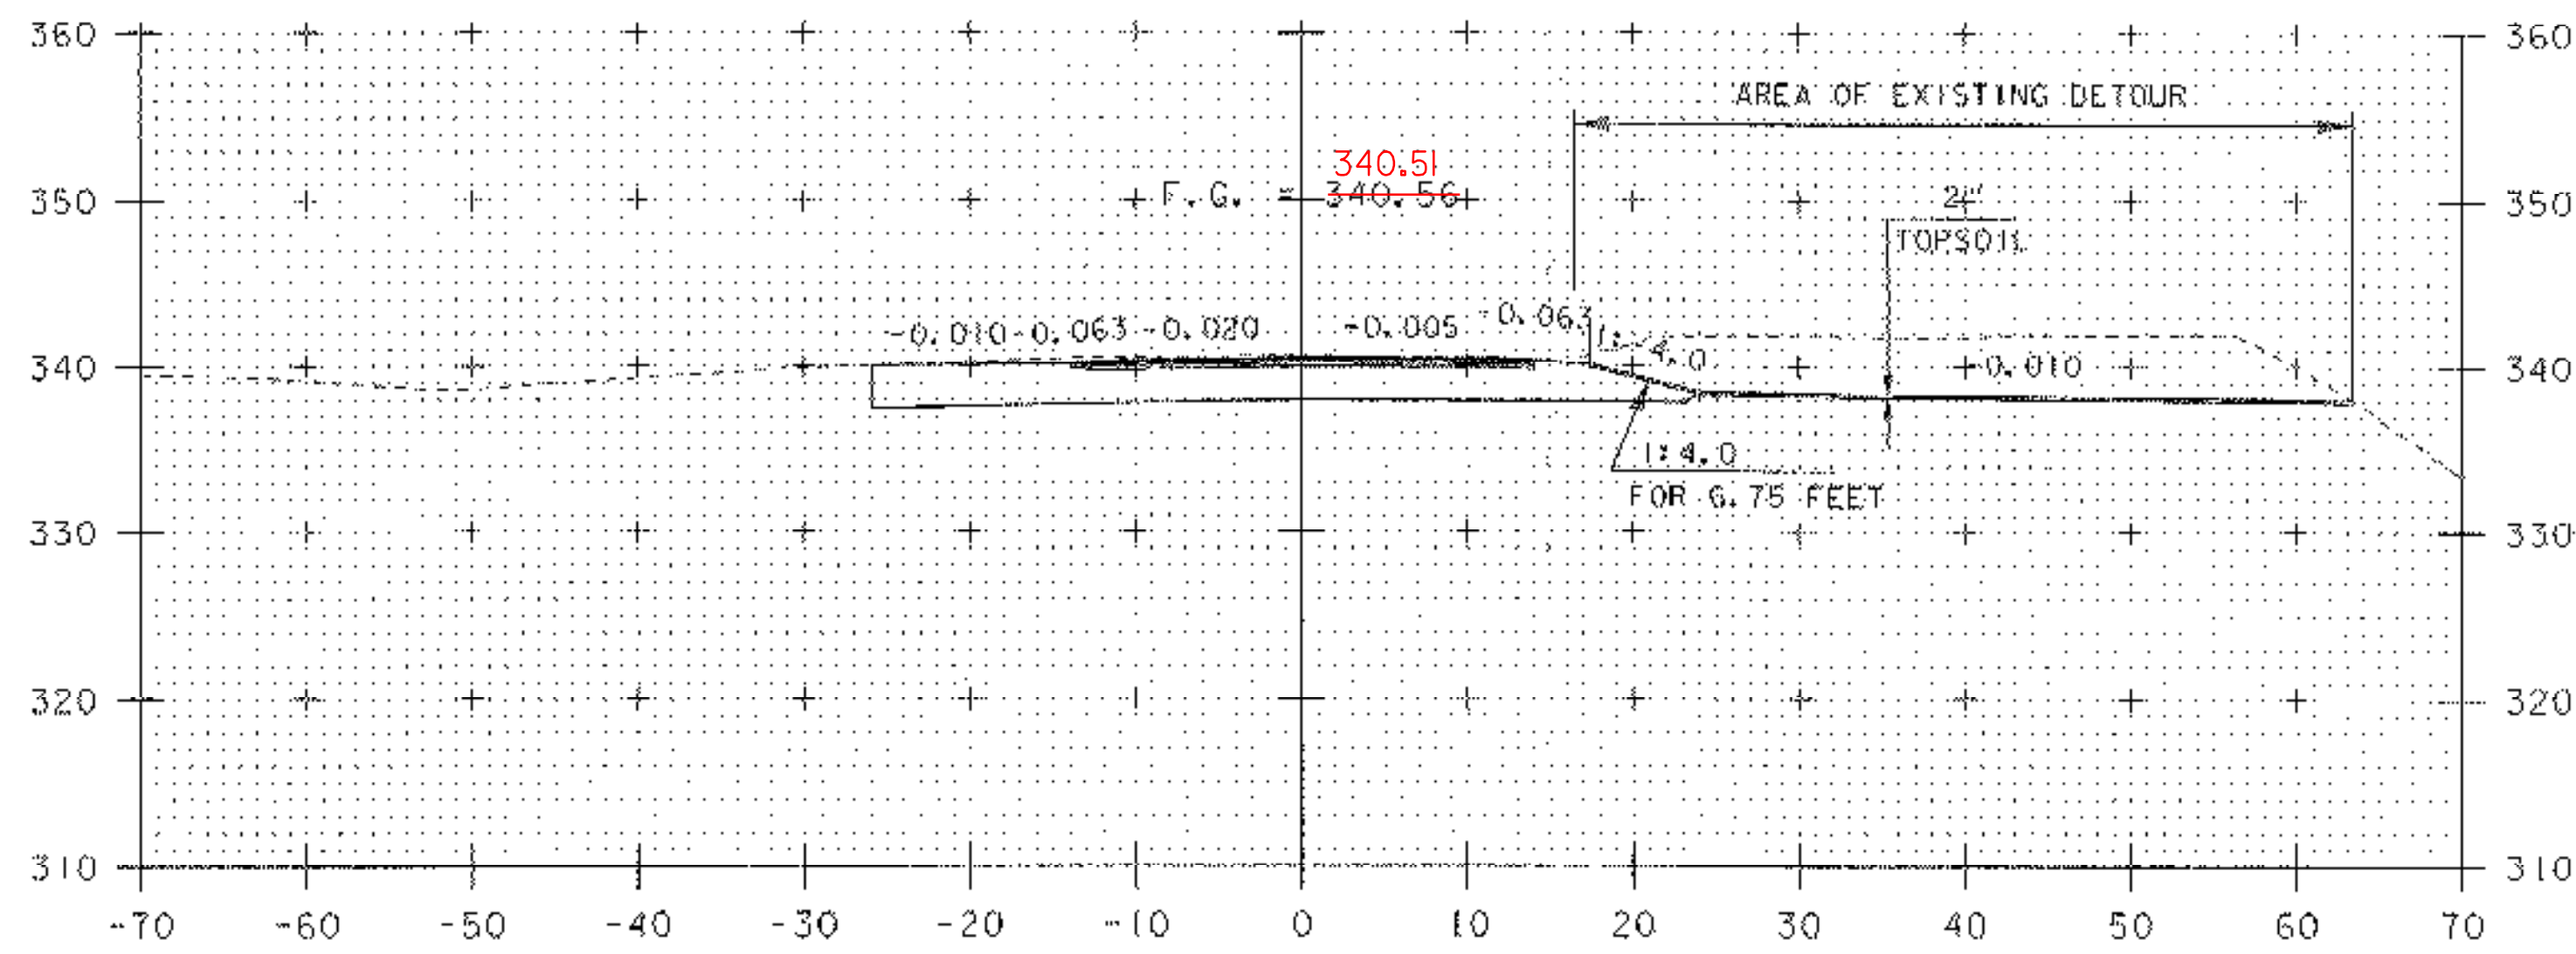

4+50

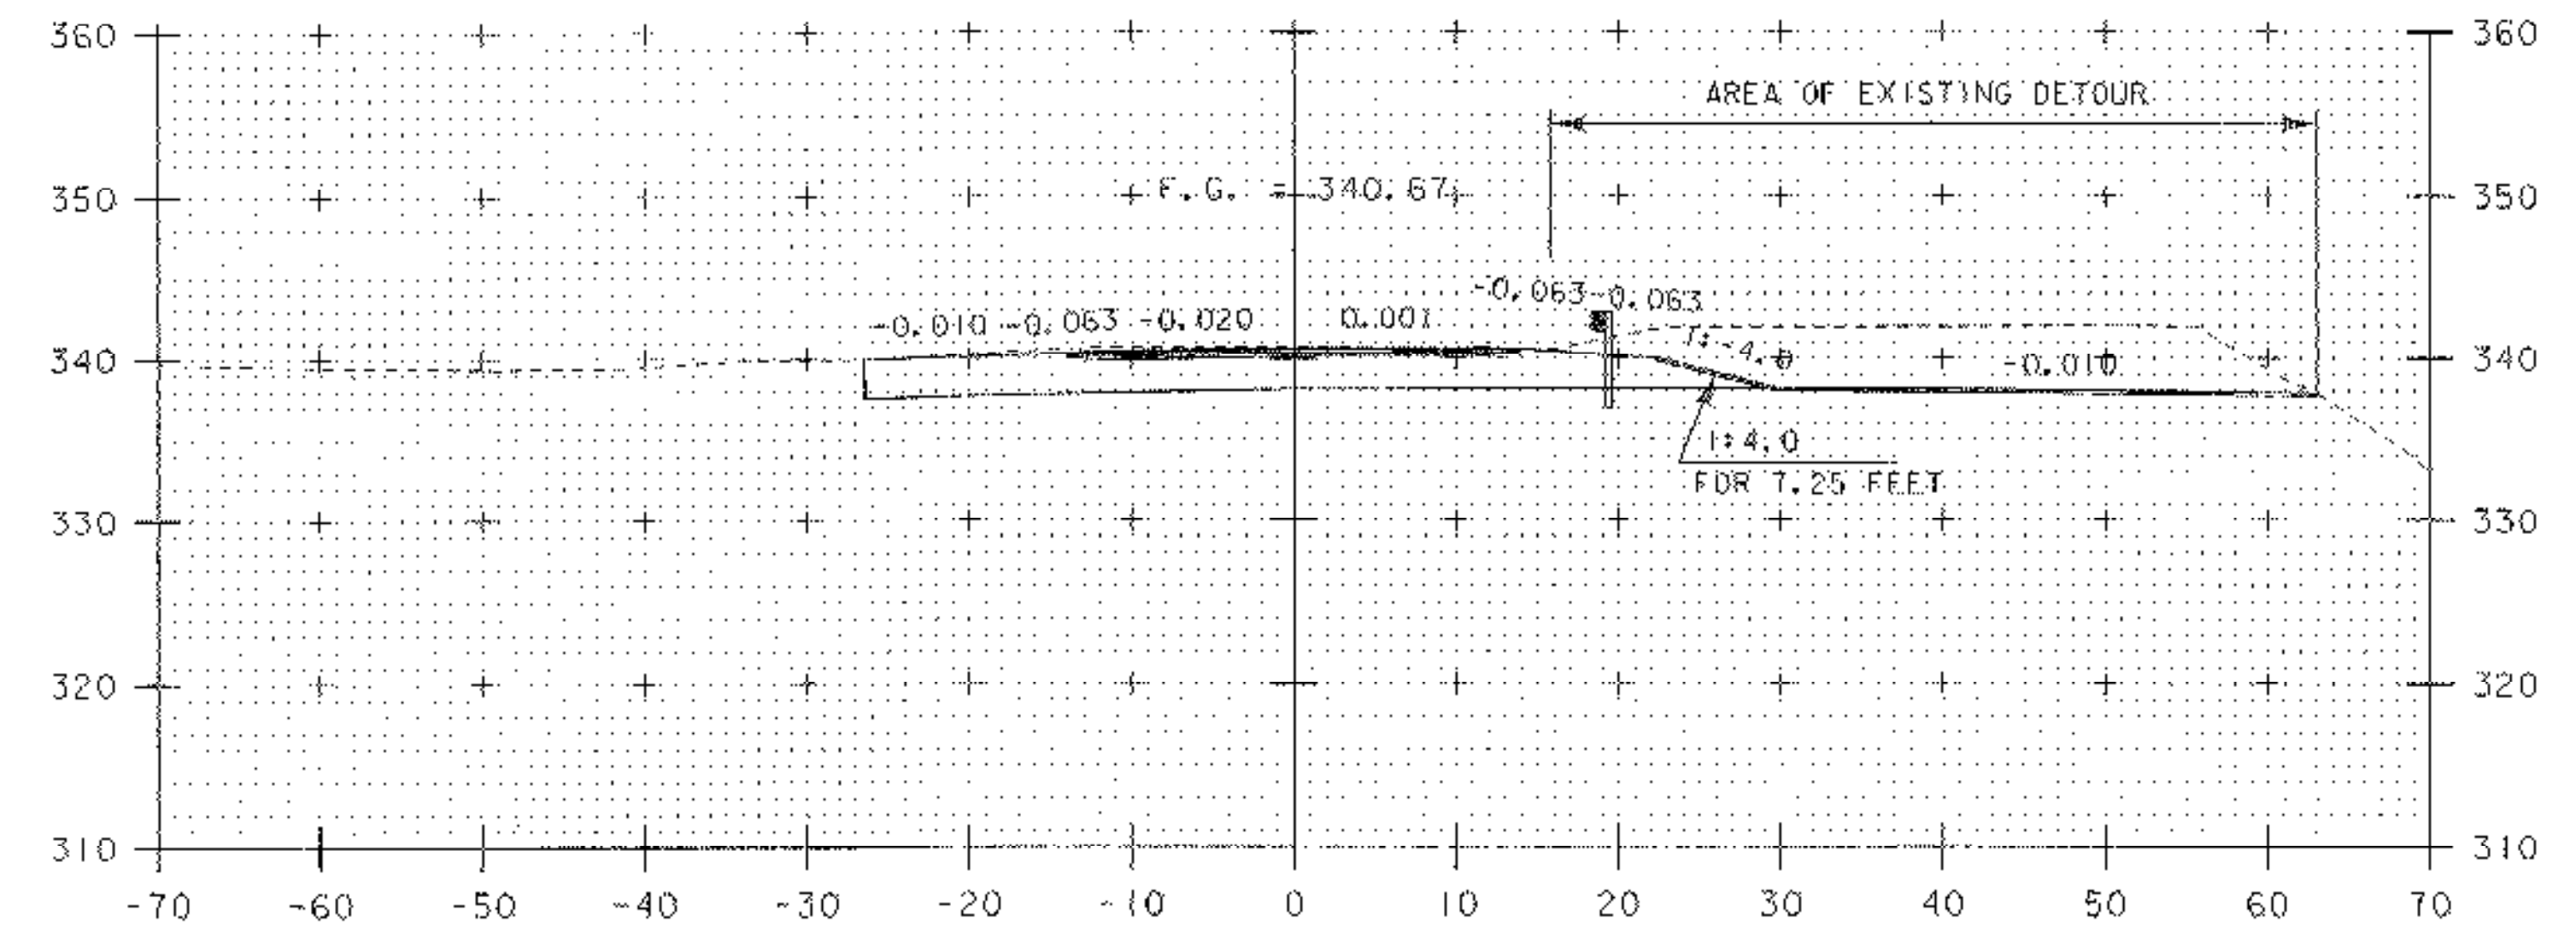

4+66  
GUARDRAIL FLARE (RIGHT)

**VT 116 SECTIONS 5**

PROJECT NAME:	BRISTOL	PLOT DATE:	20-MAR-2007
PROJECT NUMBER:	ER ST 021-1(22)	DRAWN BY:	G.ROKES
FILE NAME:	05b126\STR\05b126xs.dgn	DESIGNED BY:	M.EVANS-MONGEON
PROJECT LEADER:	M.EVANS-MONGEON	CHECKED BY:	G.ROKES
IPARM:	05b126fx5.i	SHEET:	51 OF 66