




6+17
GUARDRAIL FLARE (LEFT)

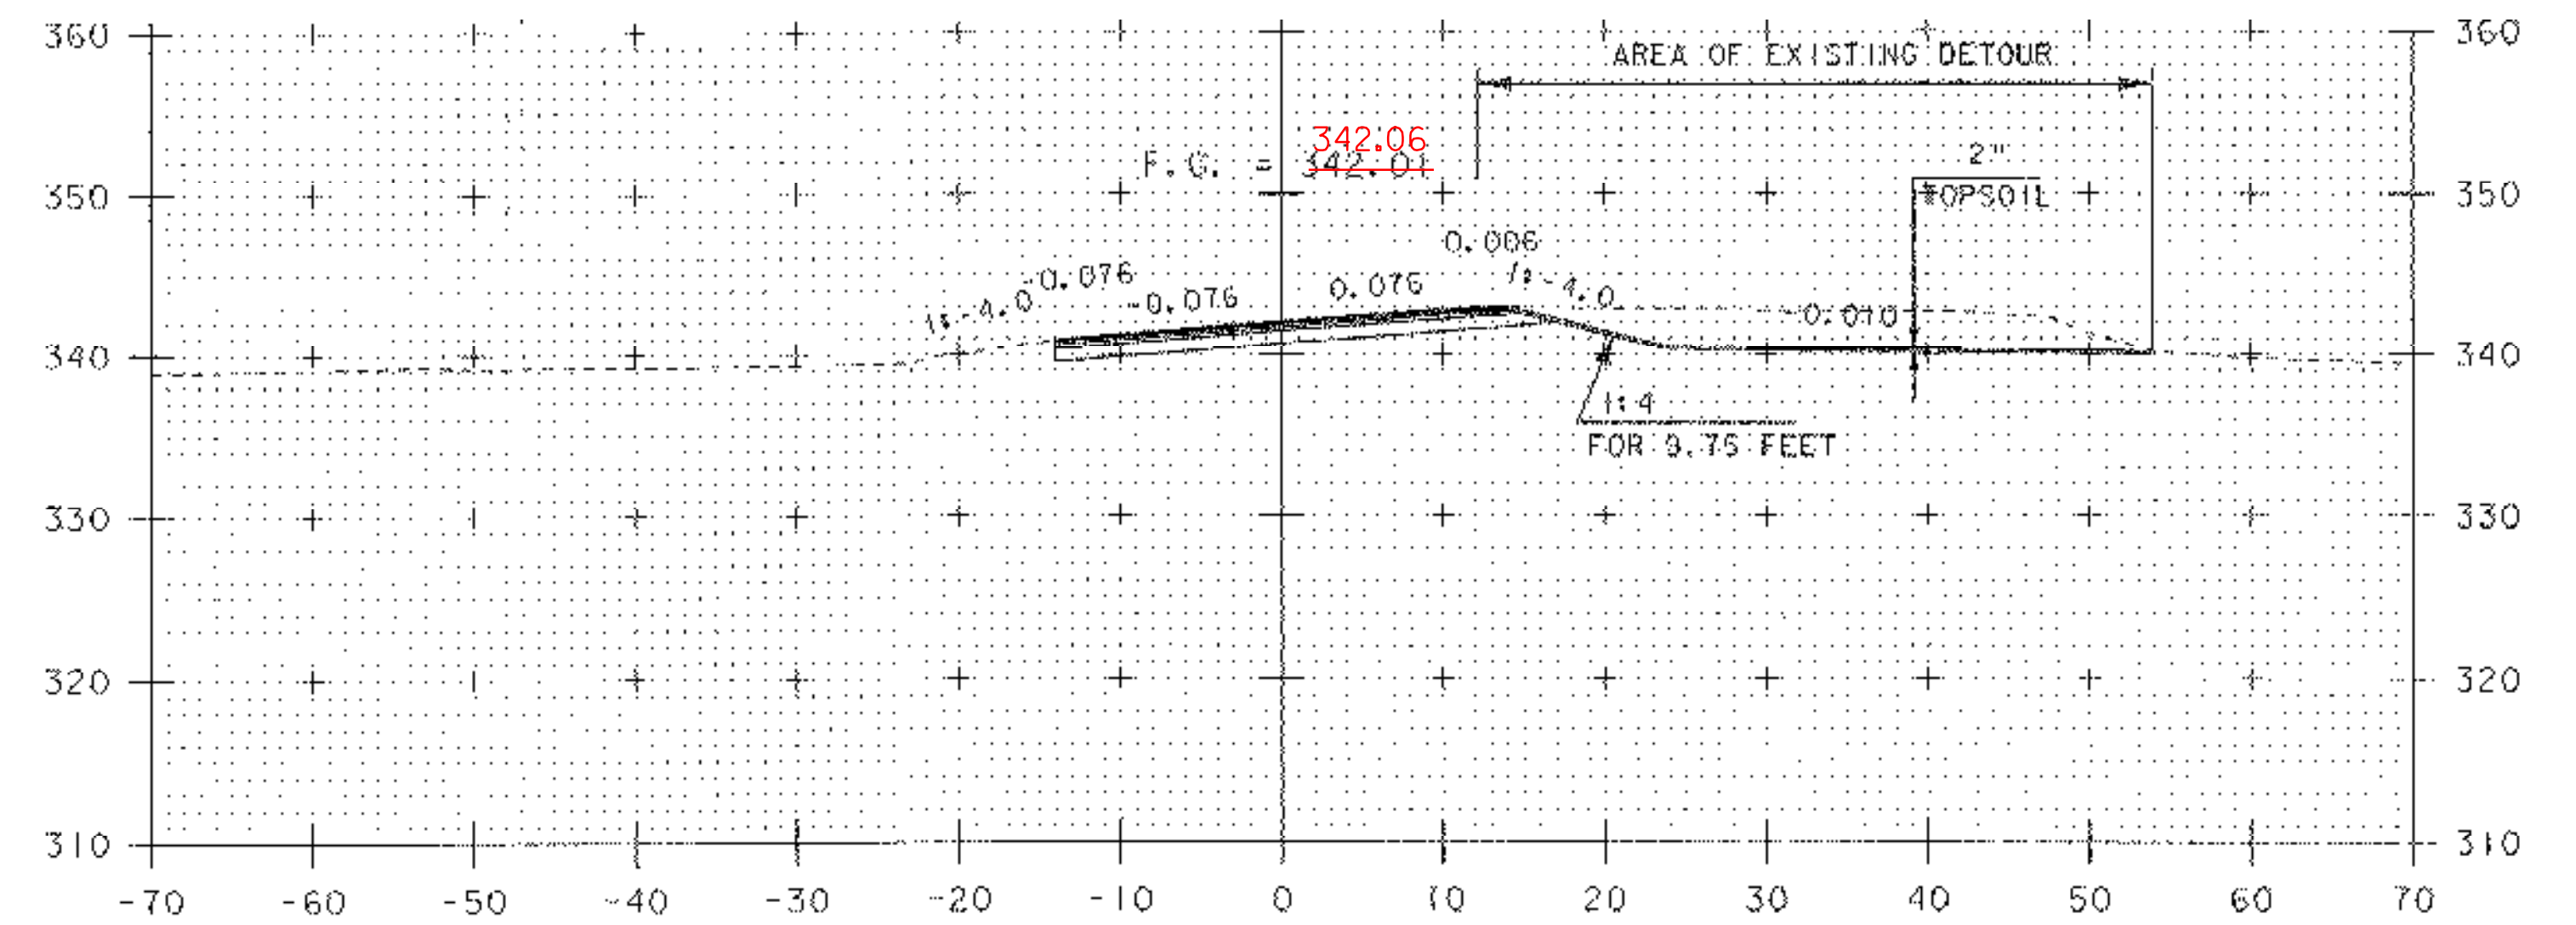

6+50

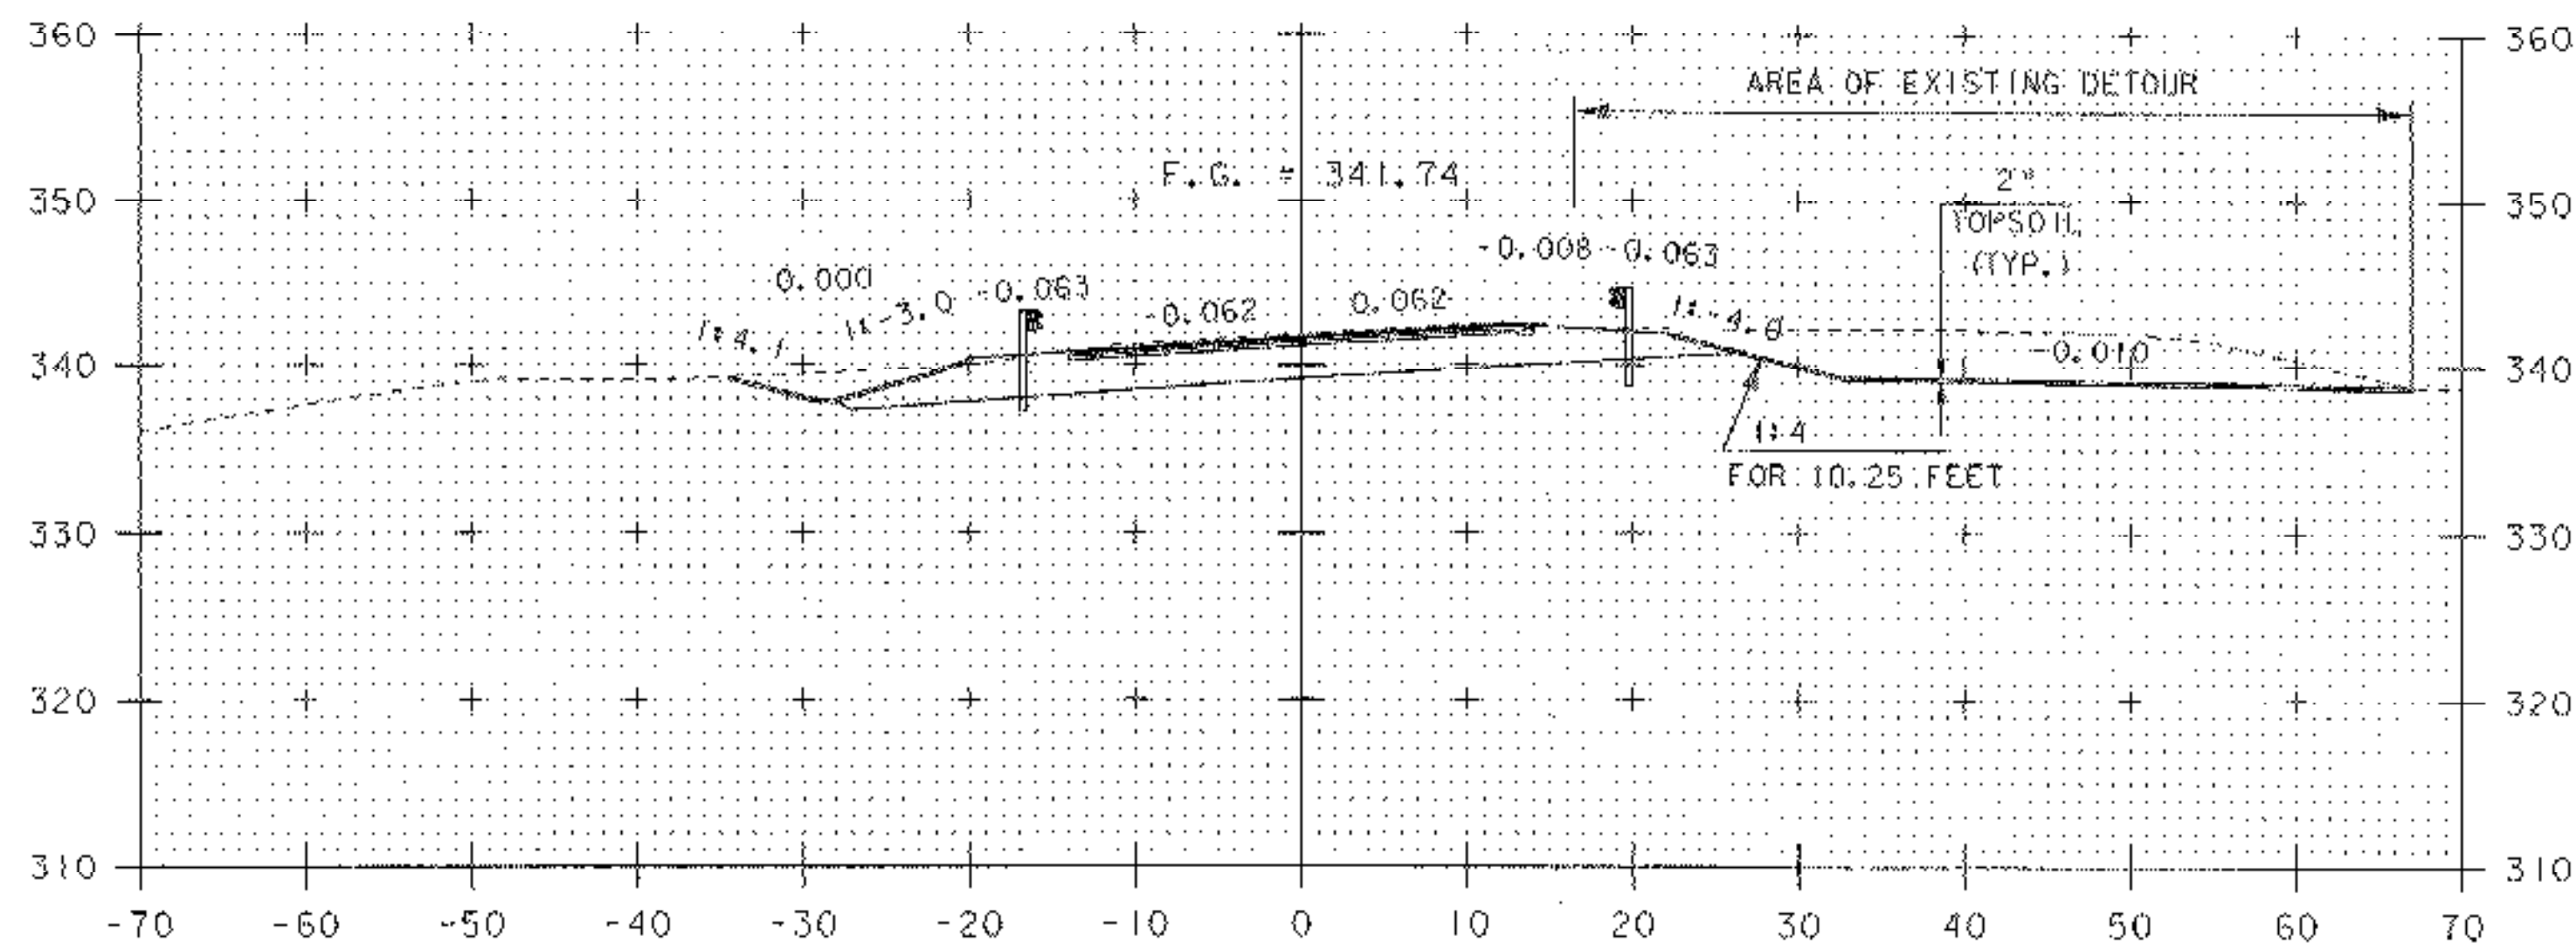

6+13
GUARDRAIL FLARE (RIGHT)

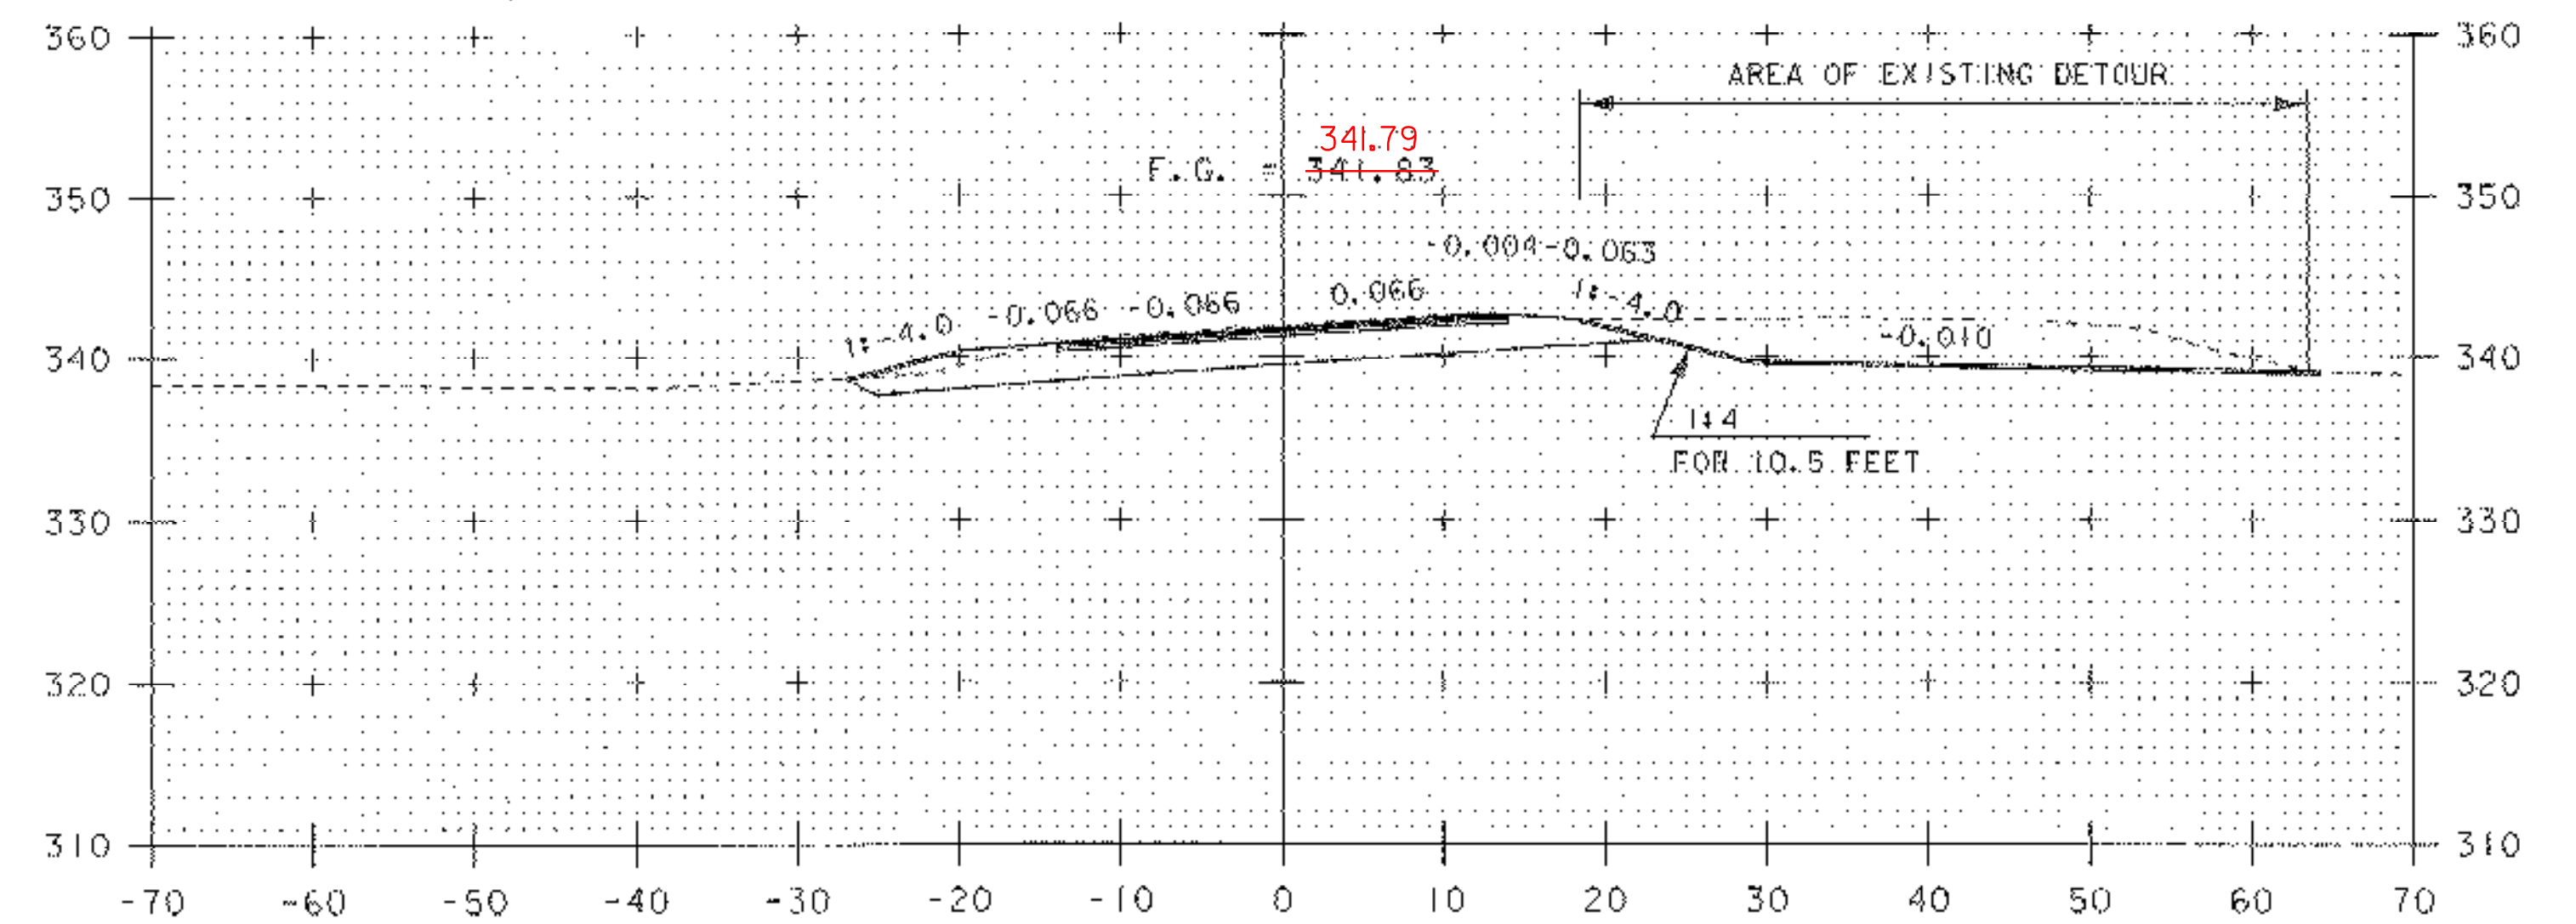

6+25
(END PROJECT STA. 6+20.00)

VT 116 SECTIONS 8

PROJECT NAME:	BRISTOL	PLOT DATE:	20-MAR-2007
PROJECT NUMBER:	ER ST 021-1(22)	DRAWN BY:	G.ROKES
FILE NAME:	05b126\STR\05b126xs.dgn	CHECKED BY:	G.ROKES
PROJECT LEADER:	M.EVANS-MONGEON	SHEET	54 OF 66
DESIGNED BY:	M.EVANS-MONGEON		
IPARM	05b126\05b8.i		