




7+00

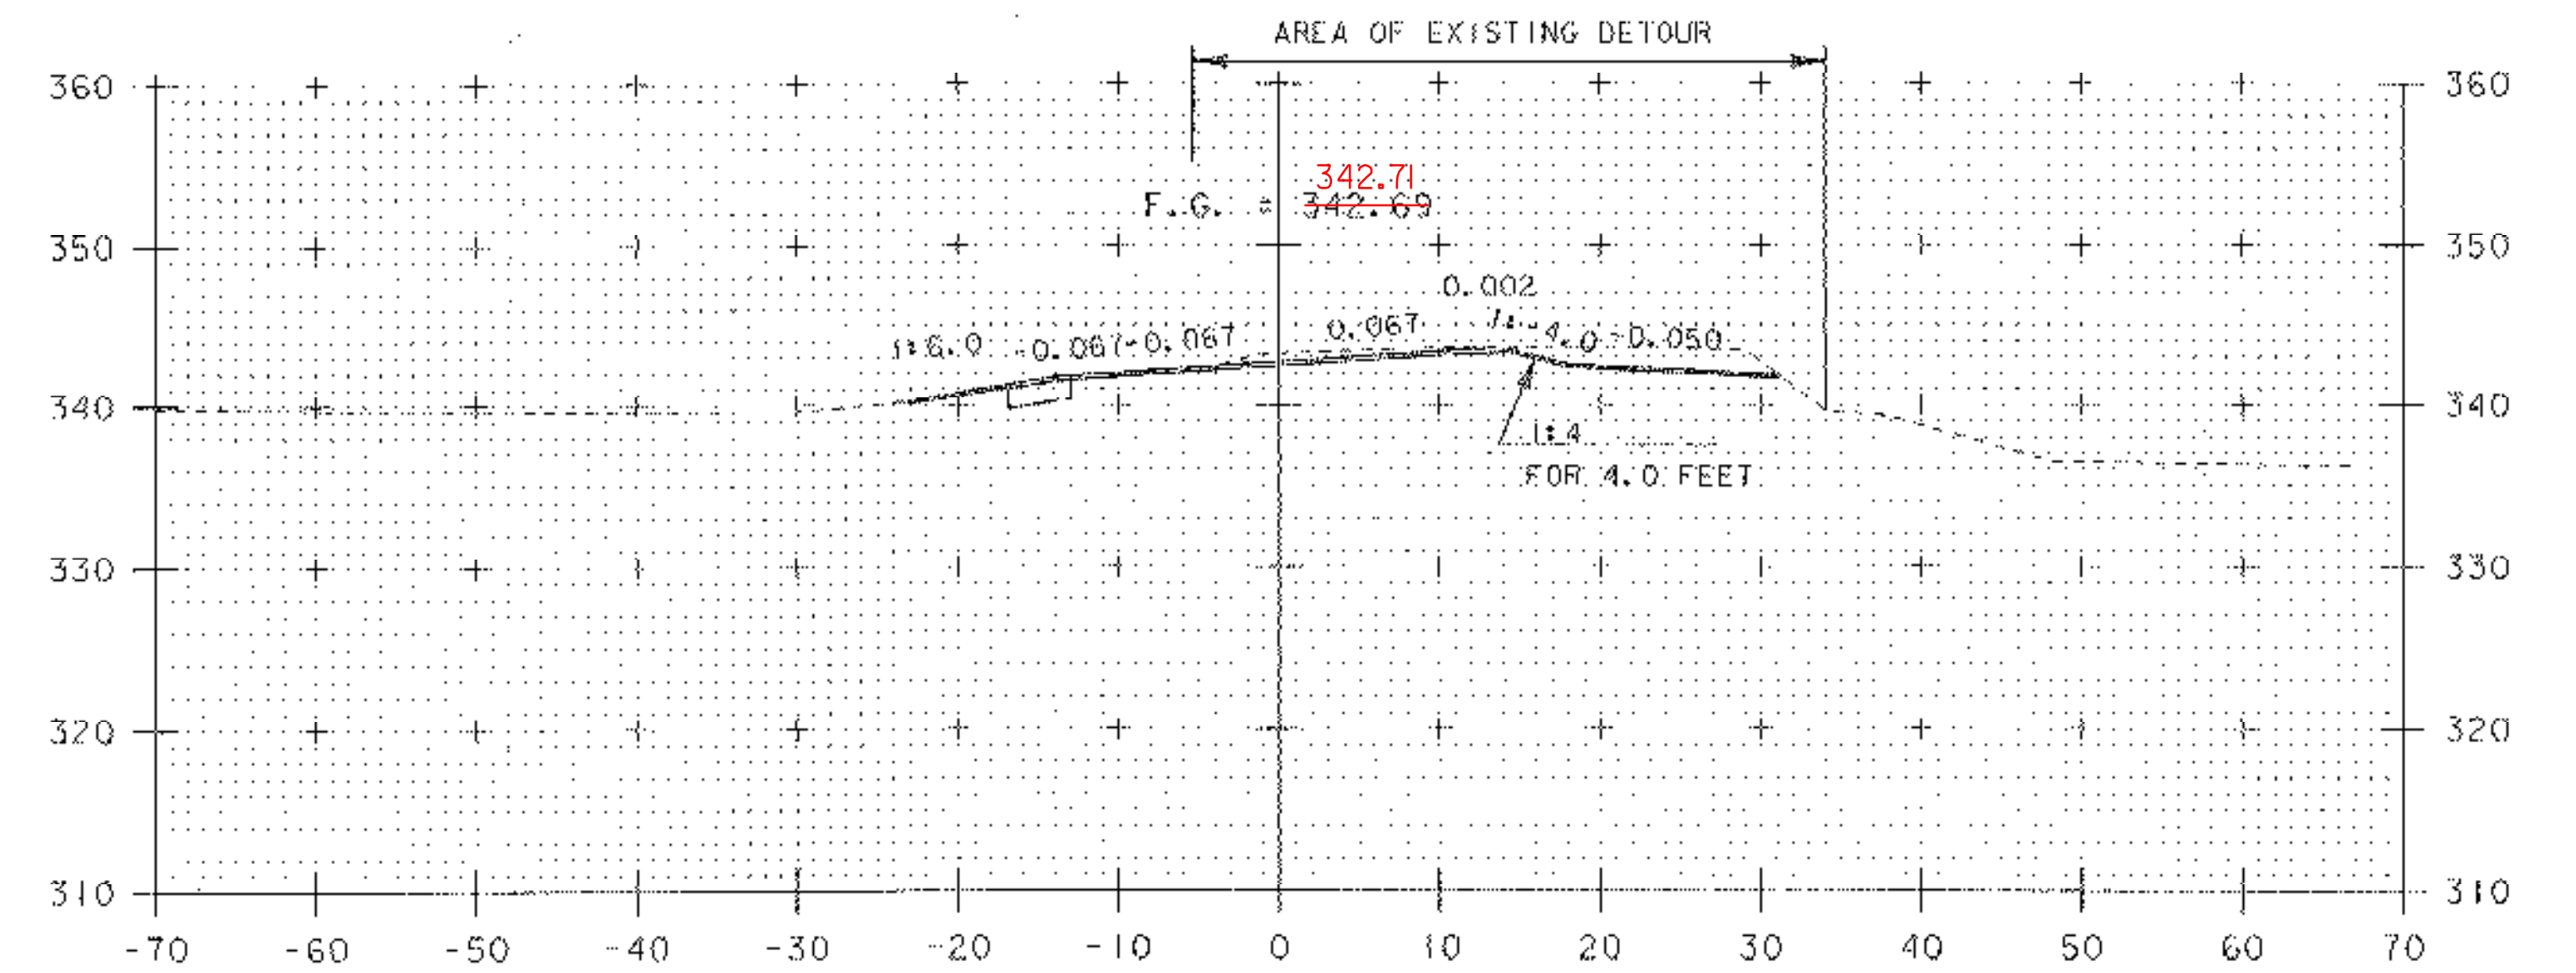

7+50

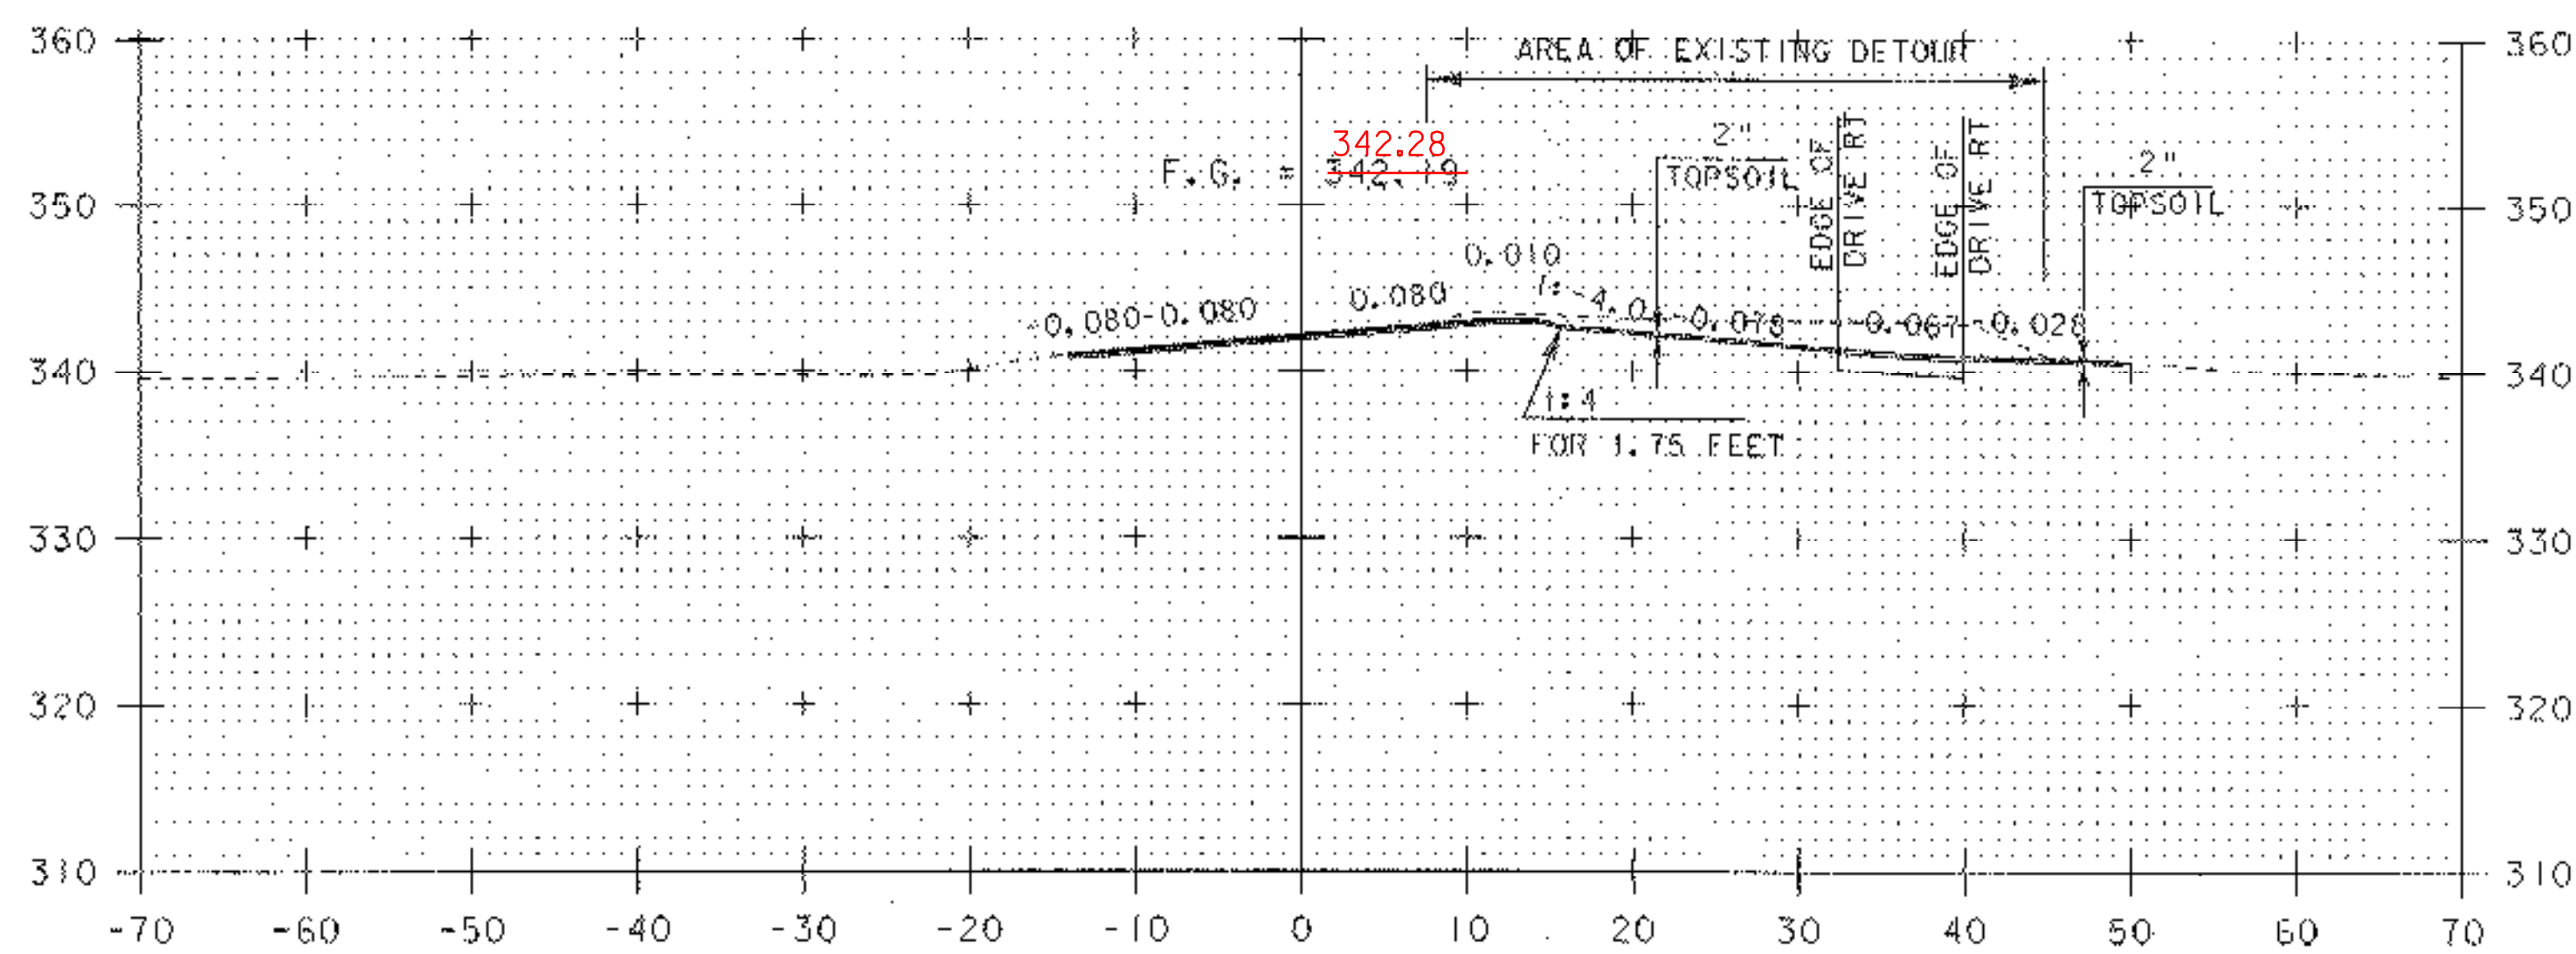

6+75

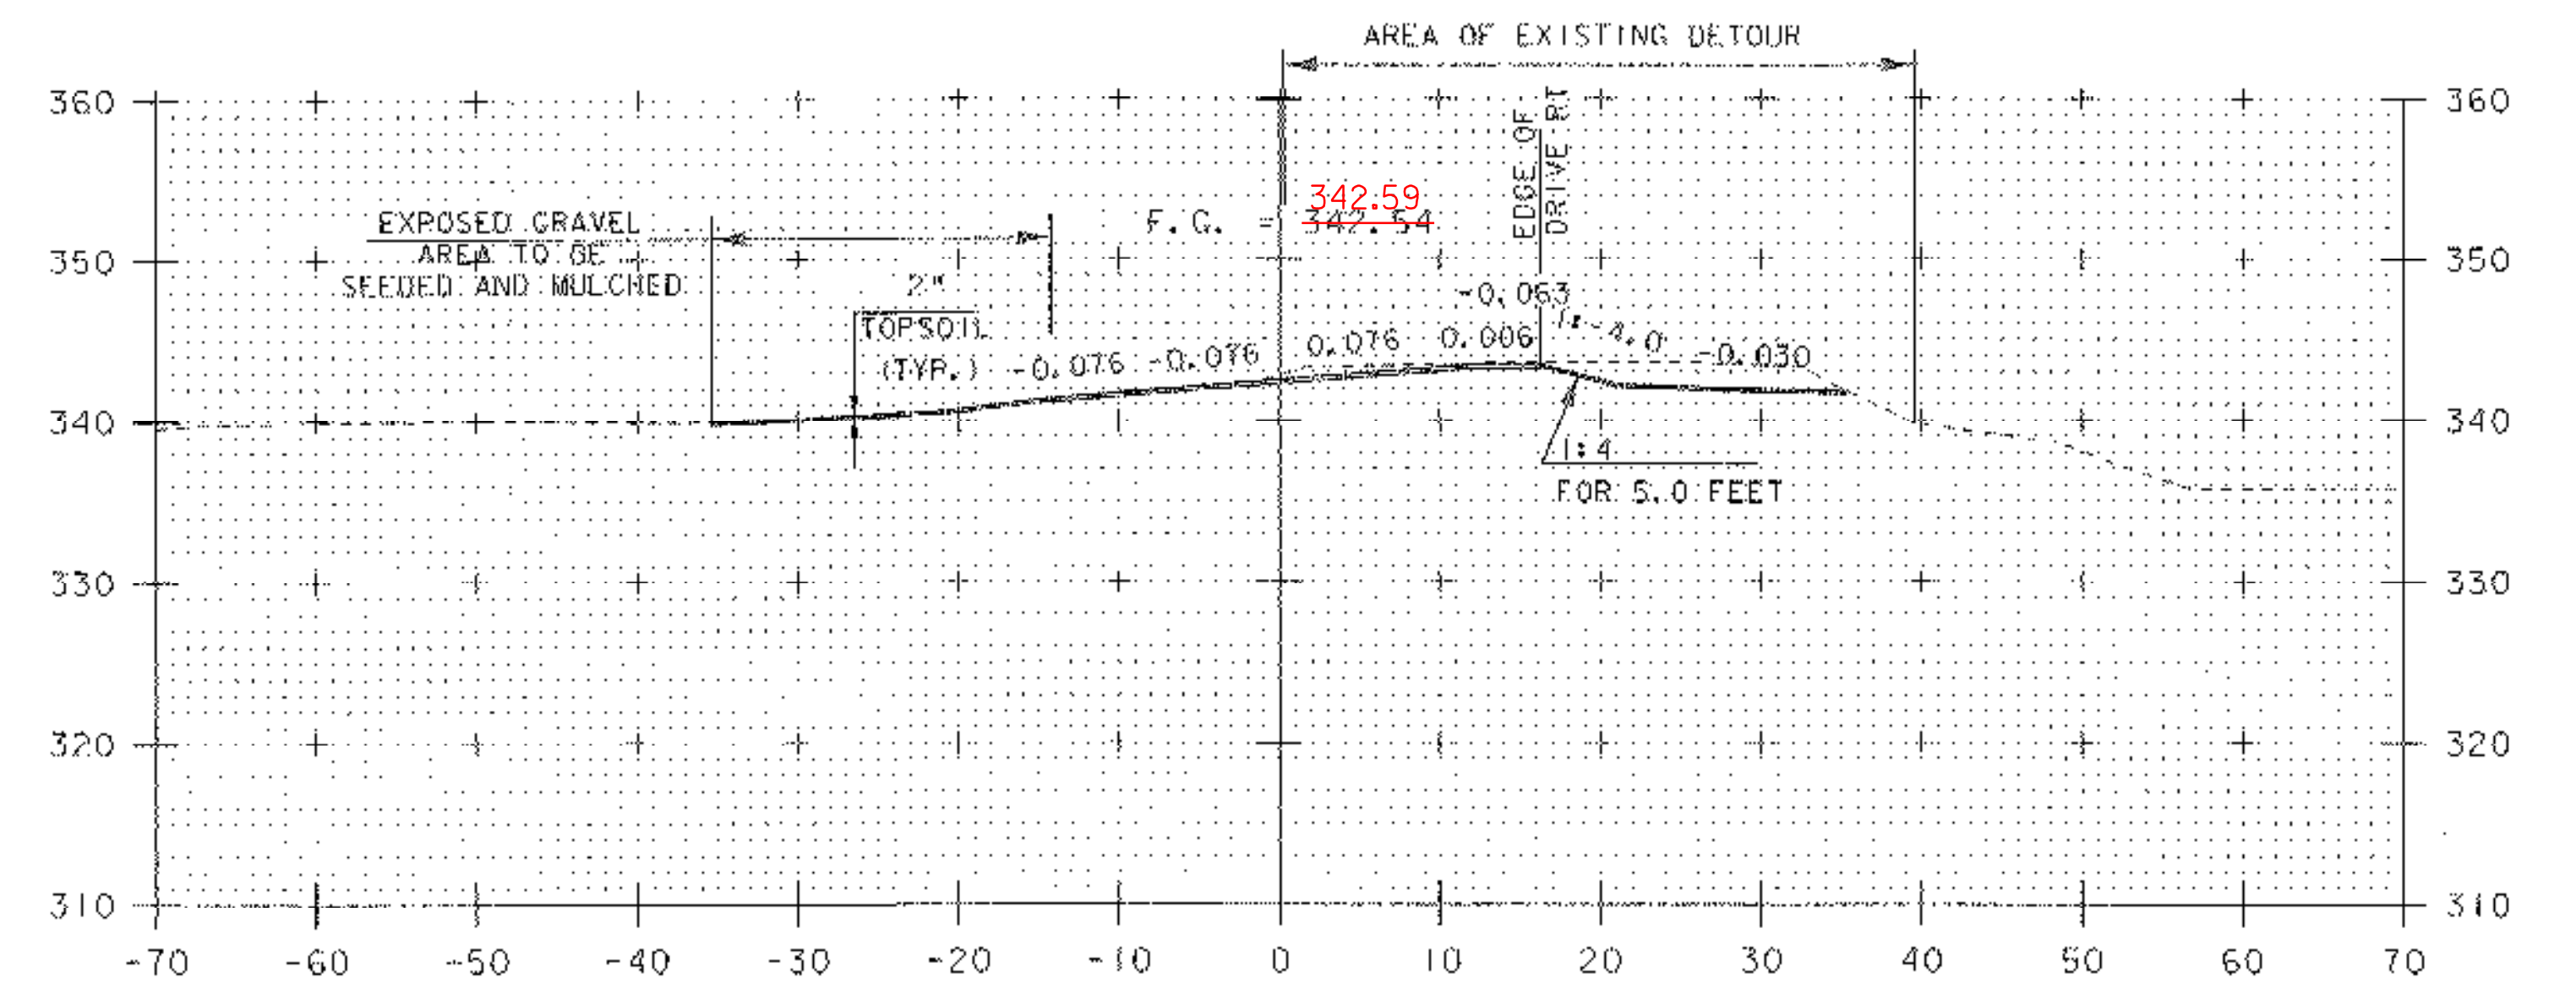

7+25

**VT 116 SECTIONS 9**

PROJECT NAME: BRISTOL  
 PROJECT NUMBER: ER ST 021-I(22)

FILE NAME: 05b126\STR\s05b126xs.dgn PLOT DATE: 20-MAR-2007  
 PROJECT LEADER: M. EVANS-MONGEON DRAWN BY: G. ROKES  
 DESIGNED BY: M. EVANS-MONGEON CHECKED BY: G. ROKES  
 IPARM: s05b126xs9.i SHEET 55 OF 66