



8+00

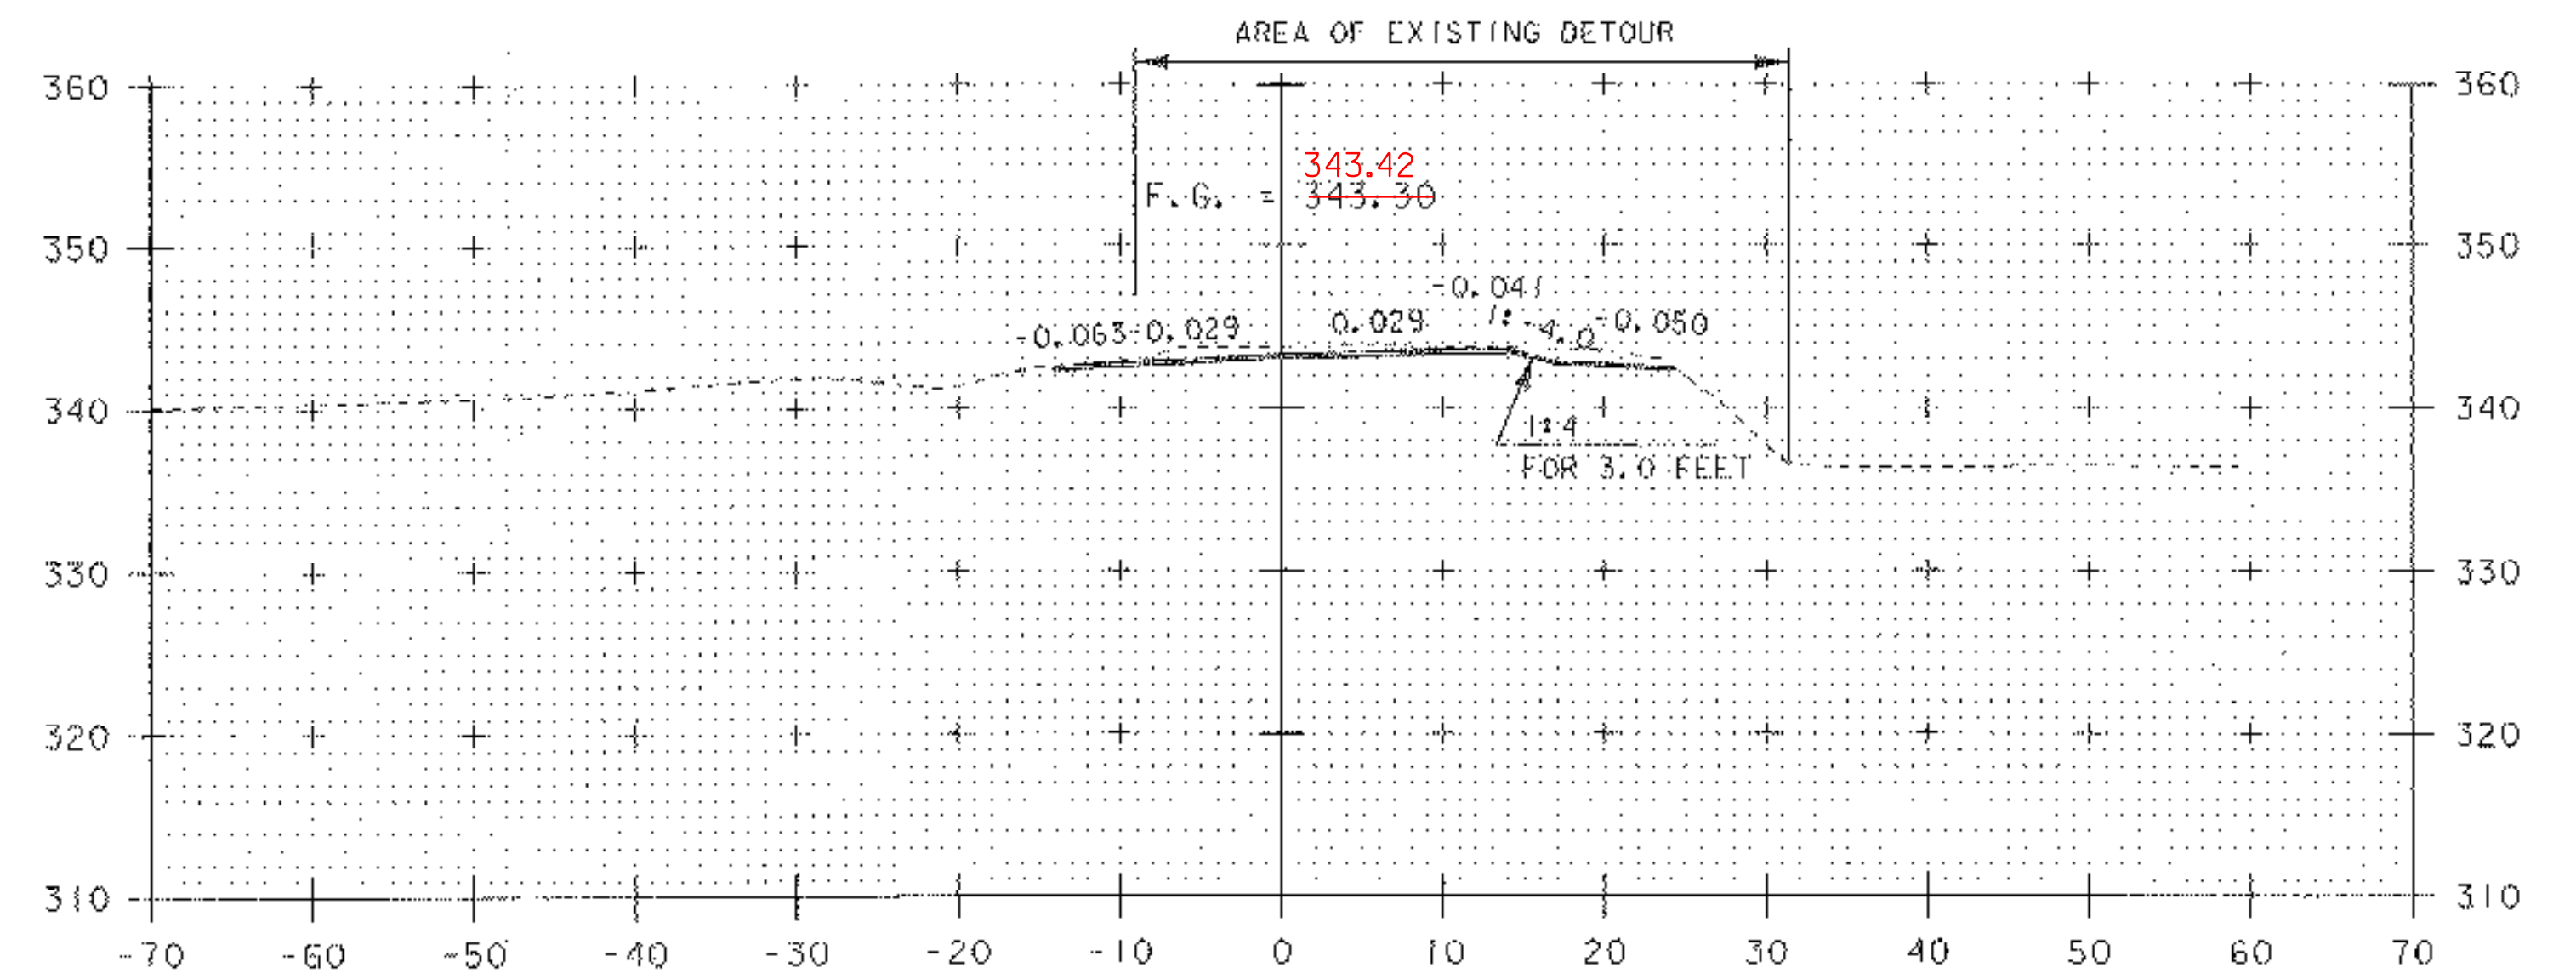


8+50

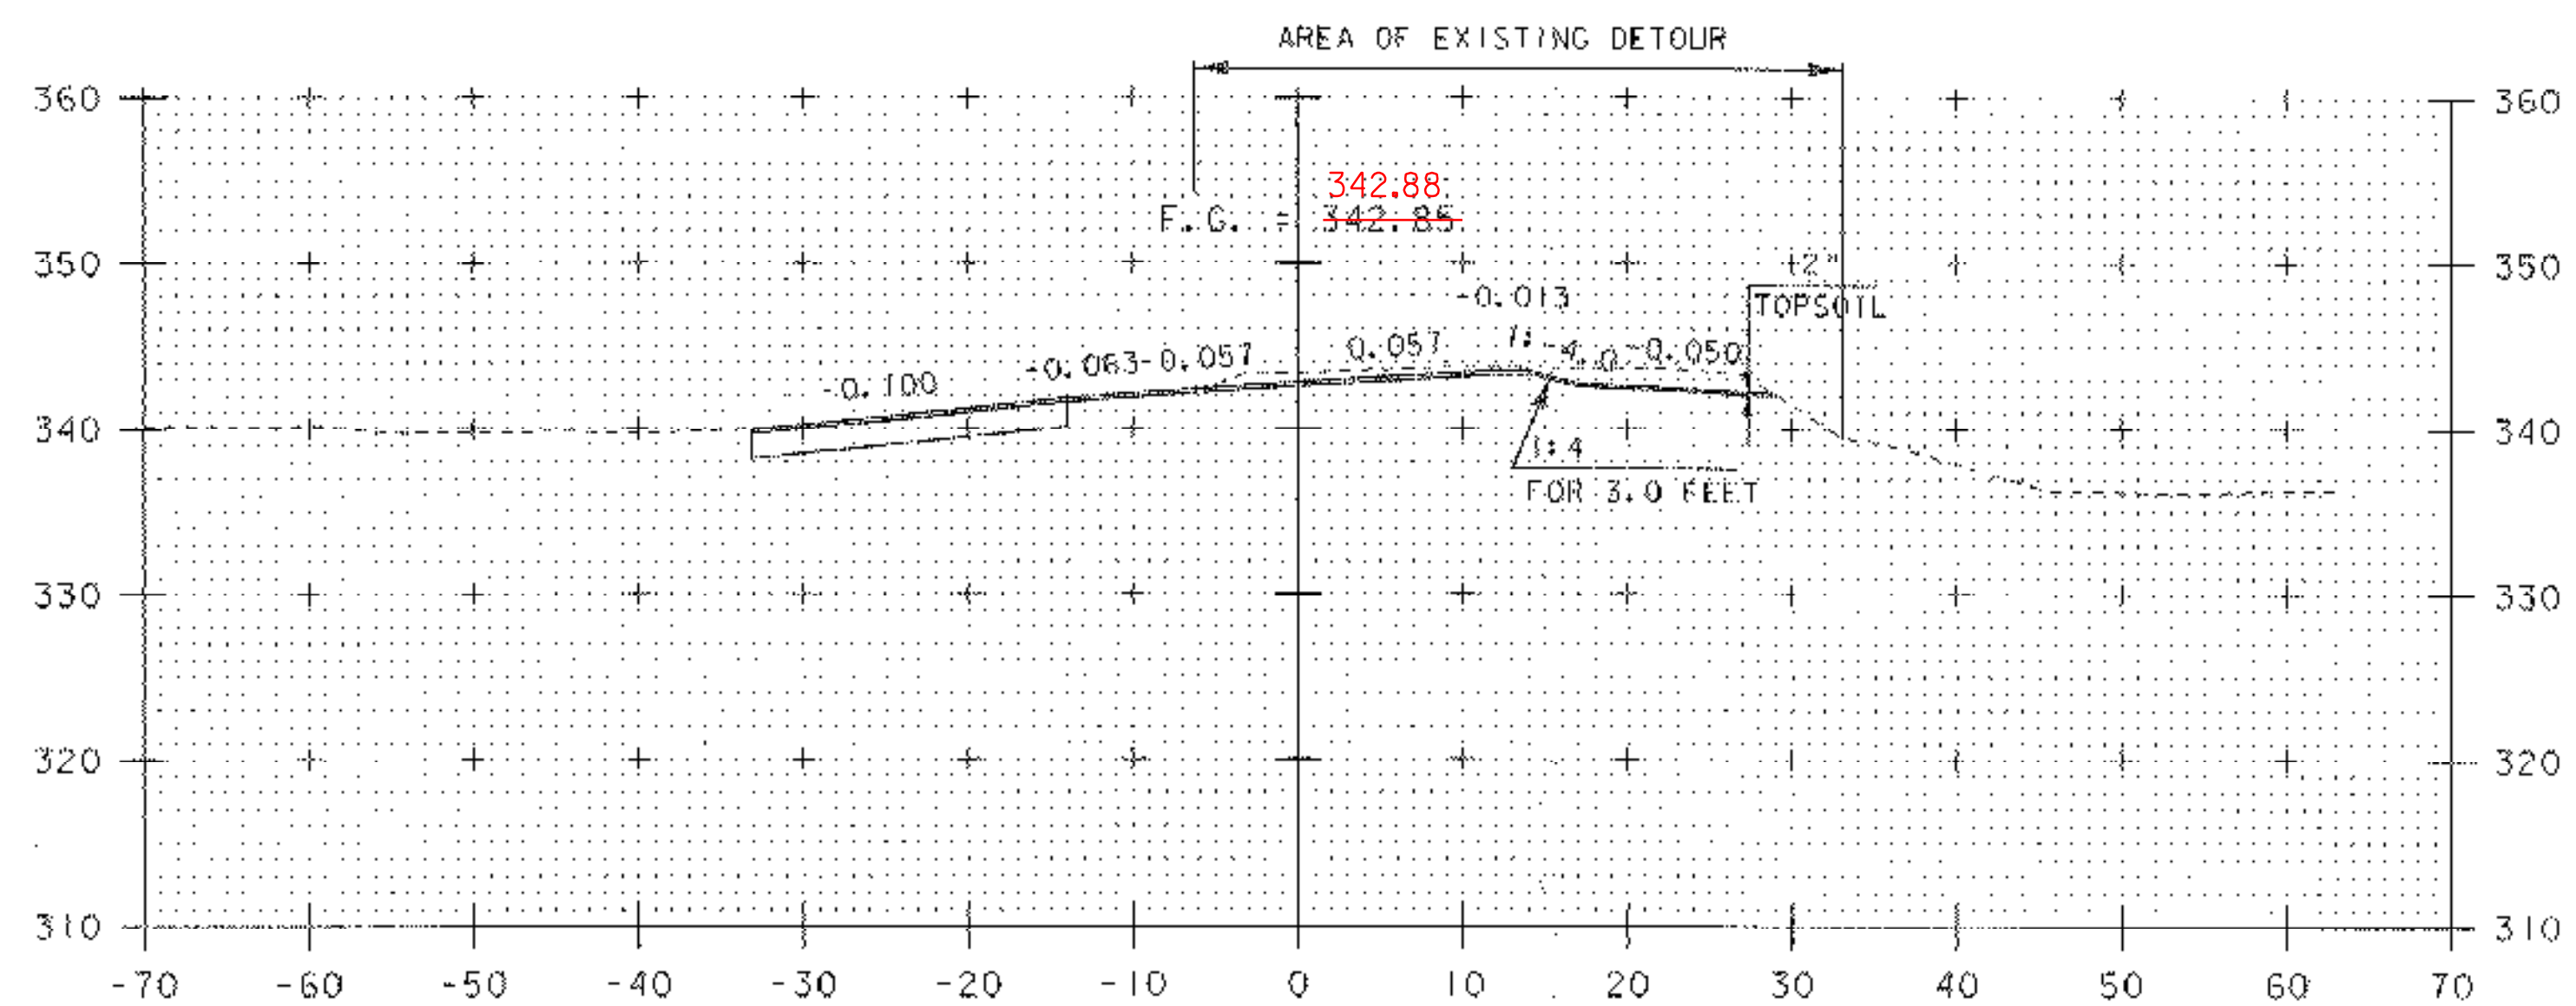

7+75

COMMERCIAL DRIVE (LEFT)

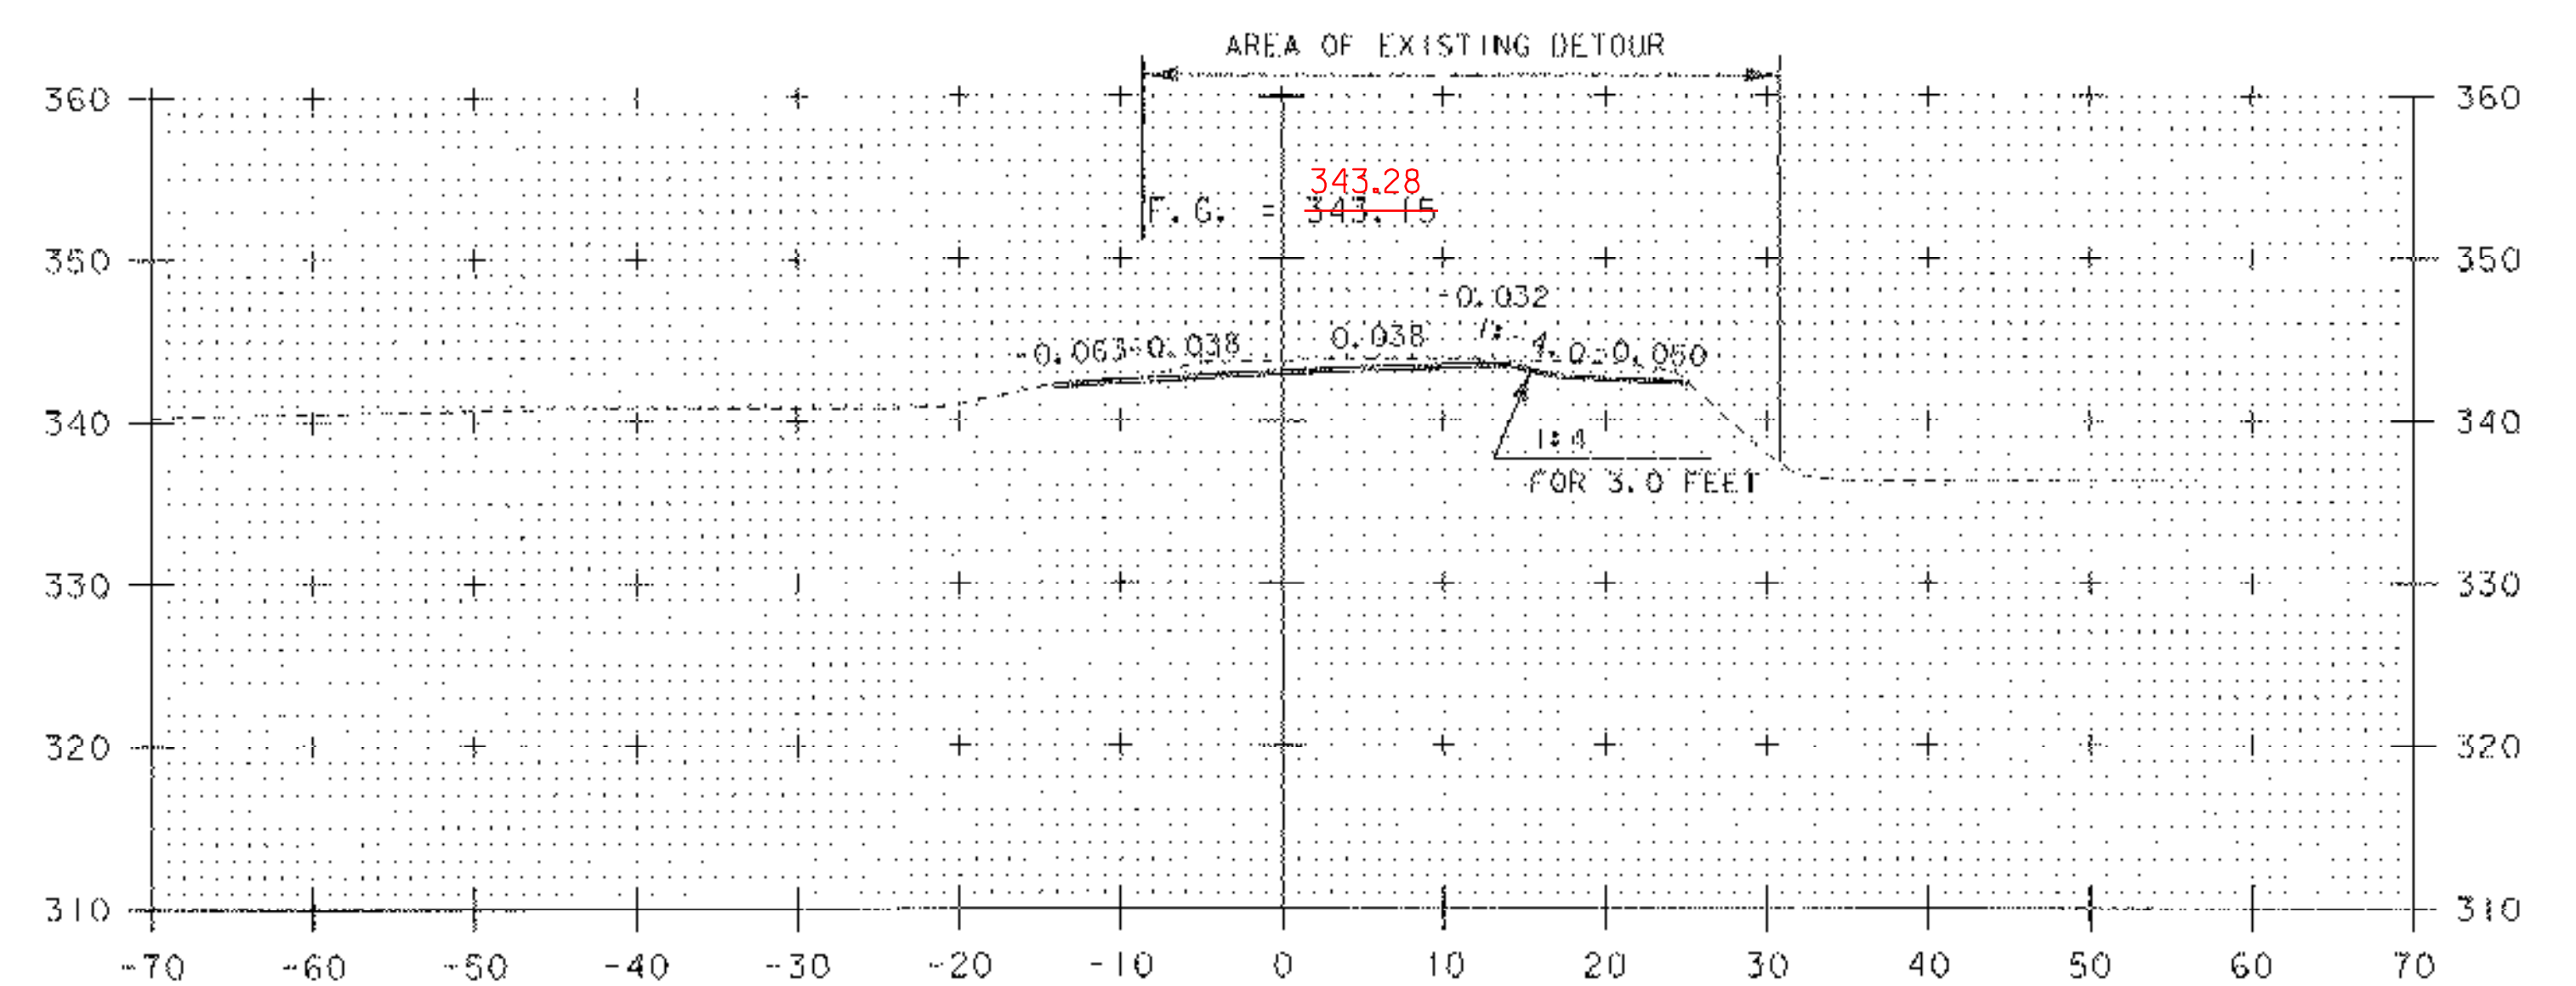

8+25

**VT 116 SECTIONS 10**

|                 |                            |
|-----------------|----------------------------|
| PROJECT NAME:   | BRISTOL                    |
| PROJECT NUMBER: | ER ST 021-1(22)            |
| FILE NAME:      | Q5b126\STR\805b126\8.s.dgn |
| PROJECT LEADER: | M. EVANS-MONGEON           |
| DESIGNED BY:    | M. EVANS-MONGEON           |
| IPARM:          | 805b126\8.s10.1            |
| PLOT DATE:      | 20-MAR-2007                |
| DRAWN BY:       | G. ROKES                   |
| CHECKED BY:     | G. ROKES                   |
| SHEET:          | 56 OF 66                   |