




11+00

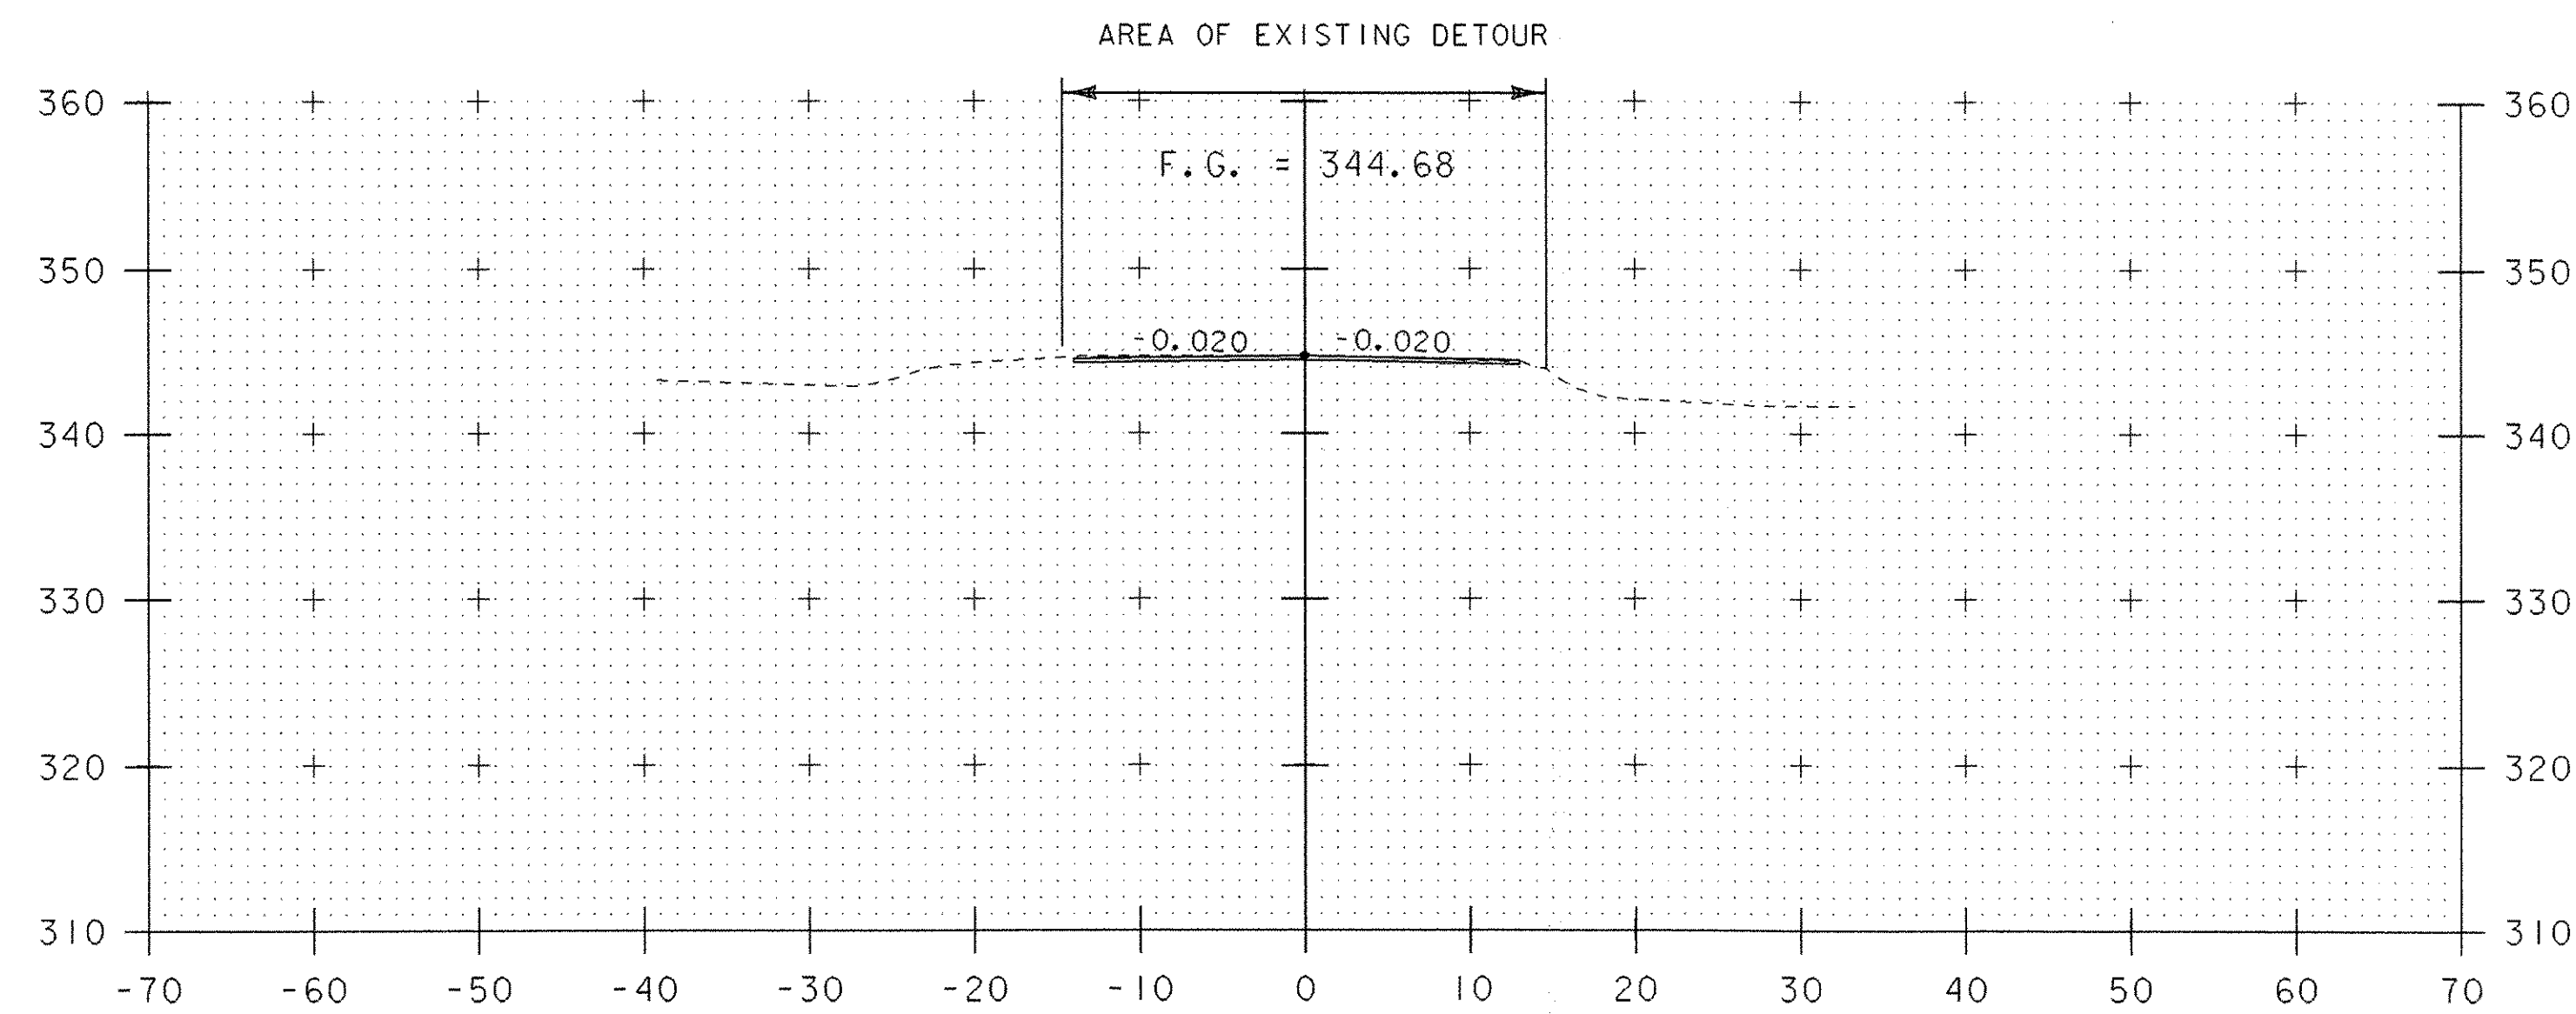

10+75

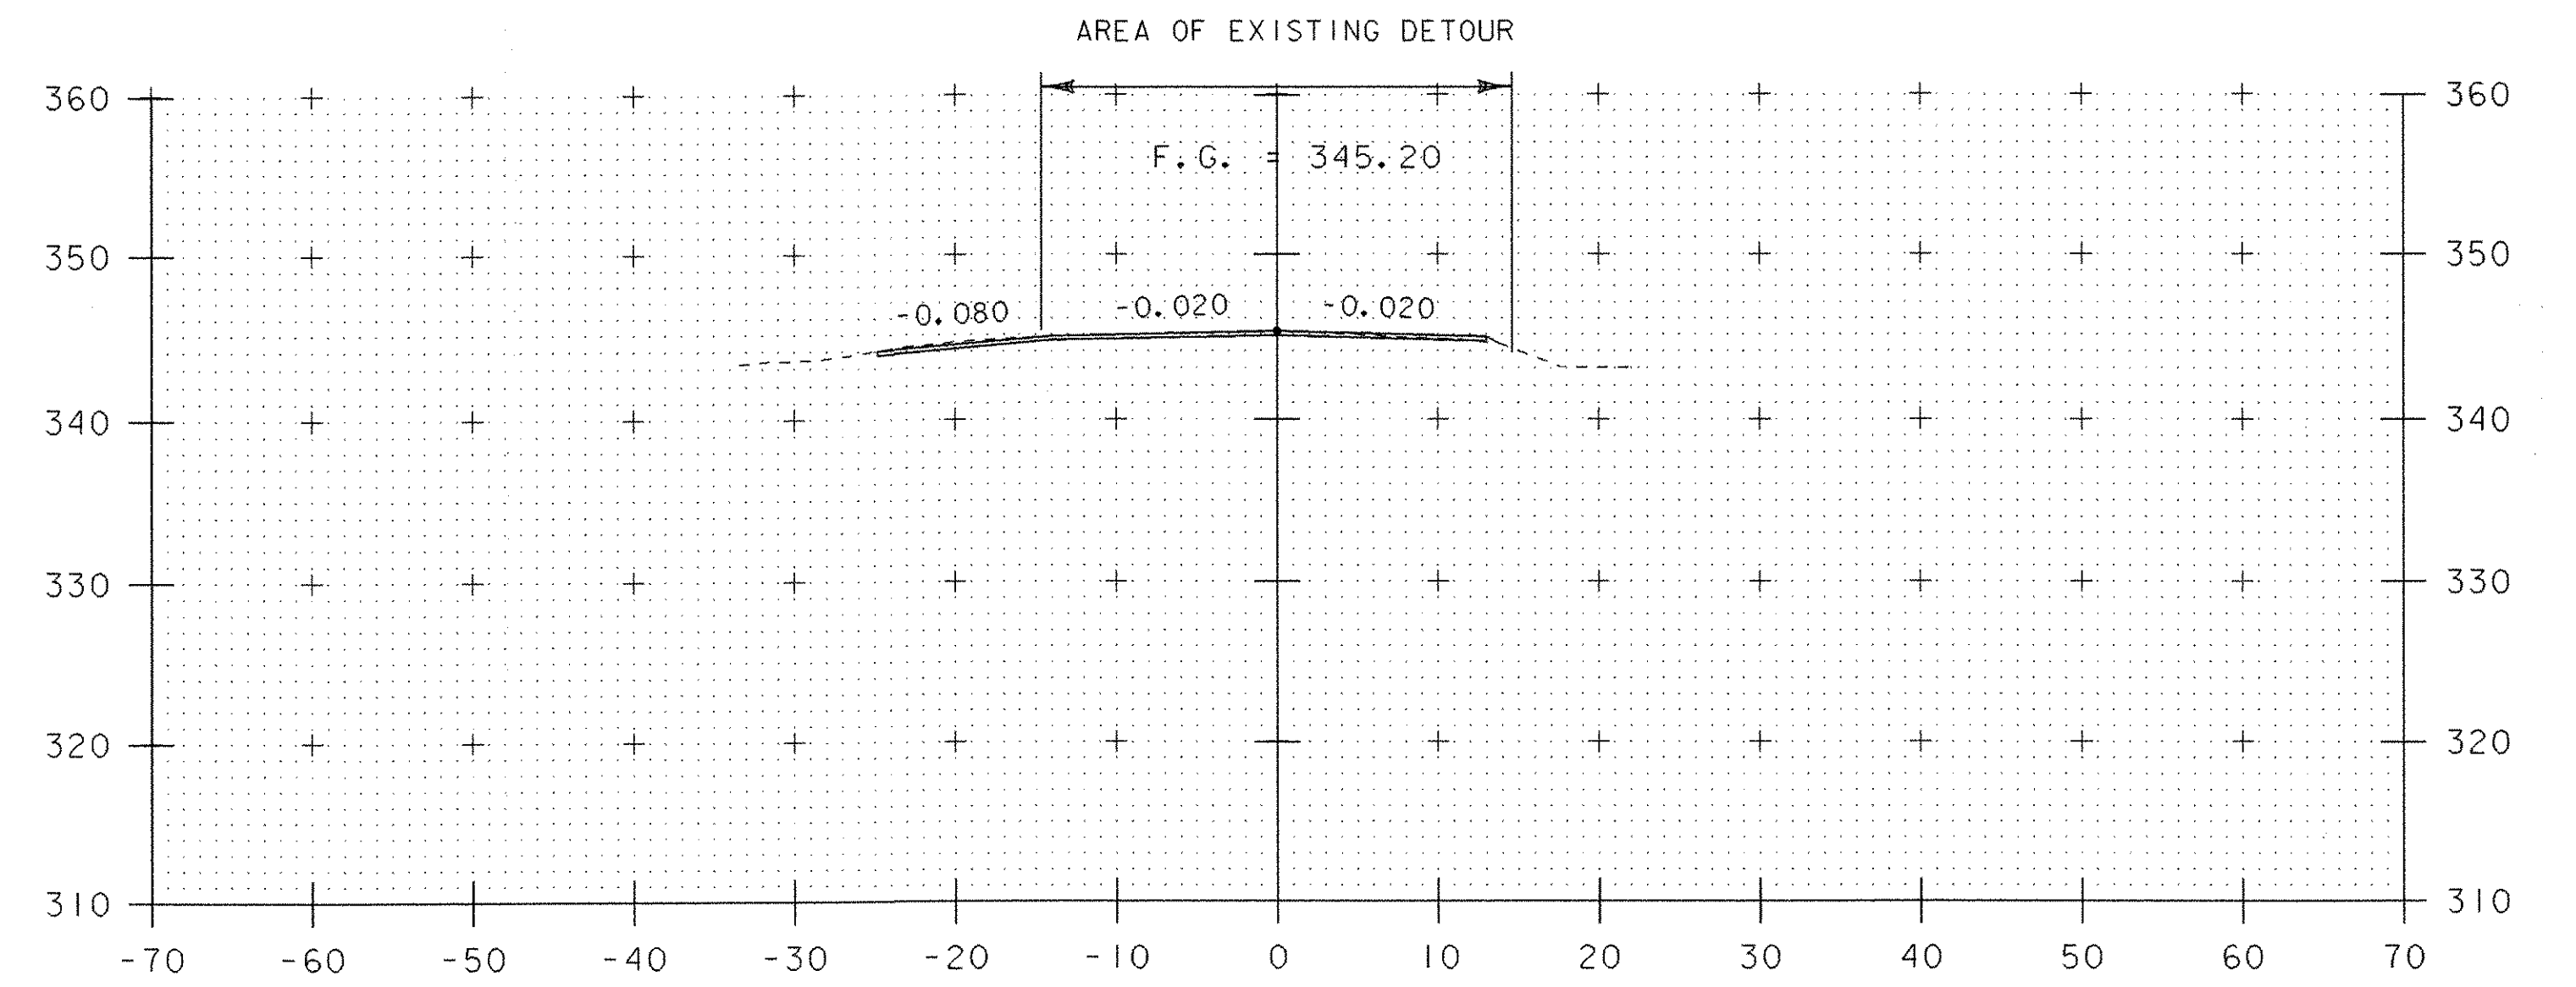

11+50  
DRIVE (LEFT)

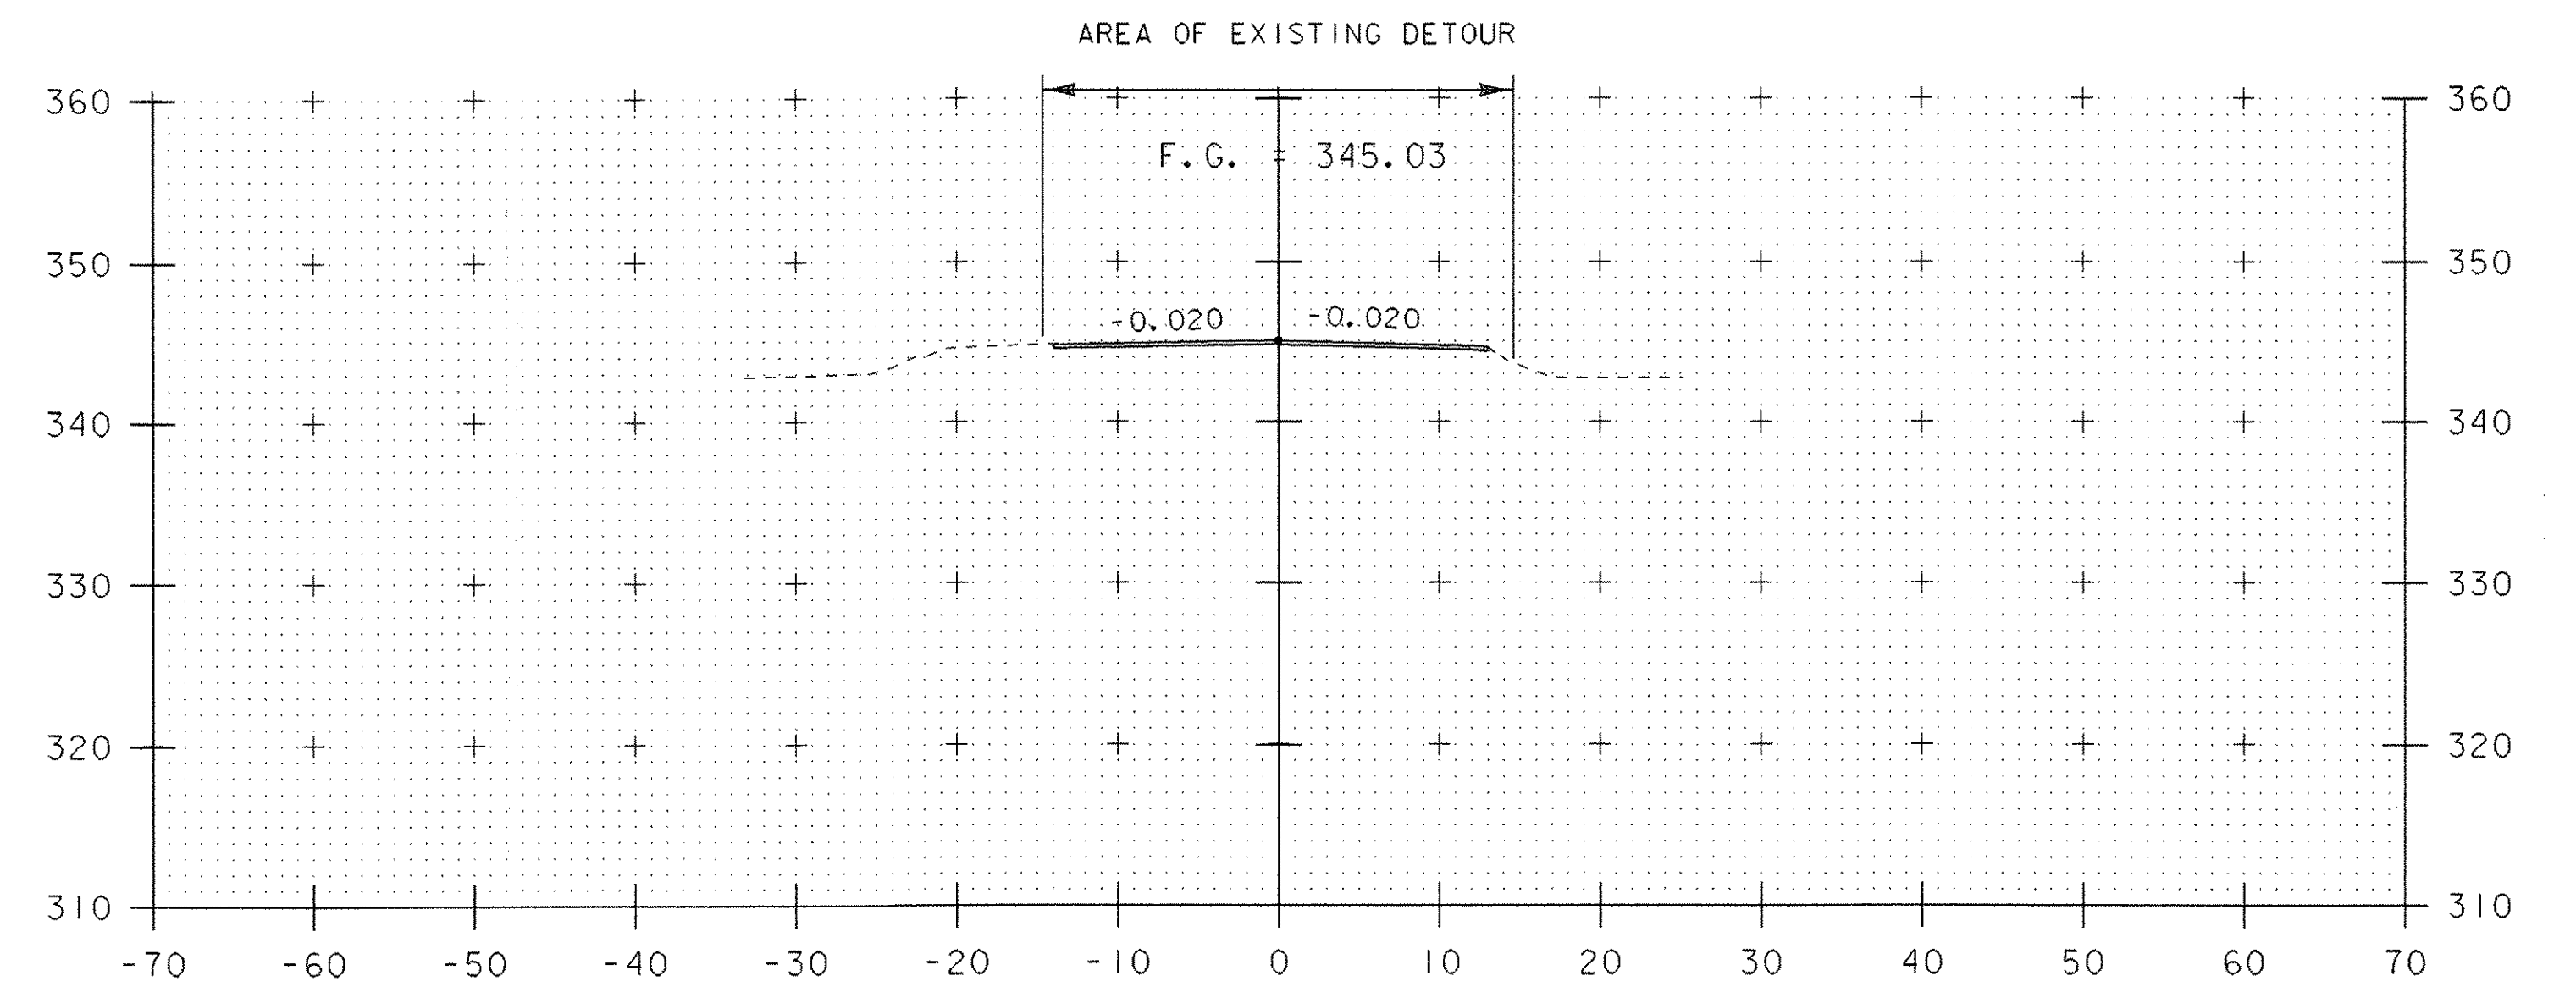

11+25

**VT 116 SECTIONS 13**

PROJECT NAME: BRISTOL  
PROJECT NUMBER: ER ST 021-1(22)

FILE NAME: s05bl26\STR\s05bl26xs.dgn PLOT DATE: 20-MAR-2007  
PROJECT LEADER: M. EVANS-MONGEON DRAWN BY: G. ROKES  
DESIGNED BY: M. EVANS-MONGEON CHECKED BY: G. ROKES  
IPARM s05bl26\sl3.1 SHEET 59 OF 66