




12+00

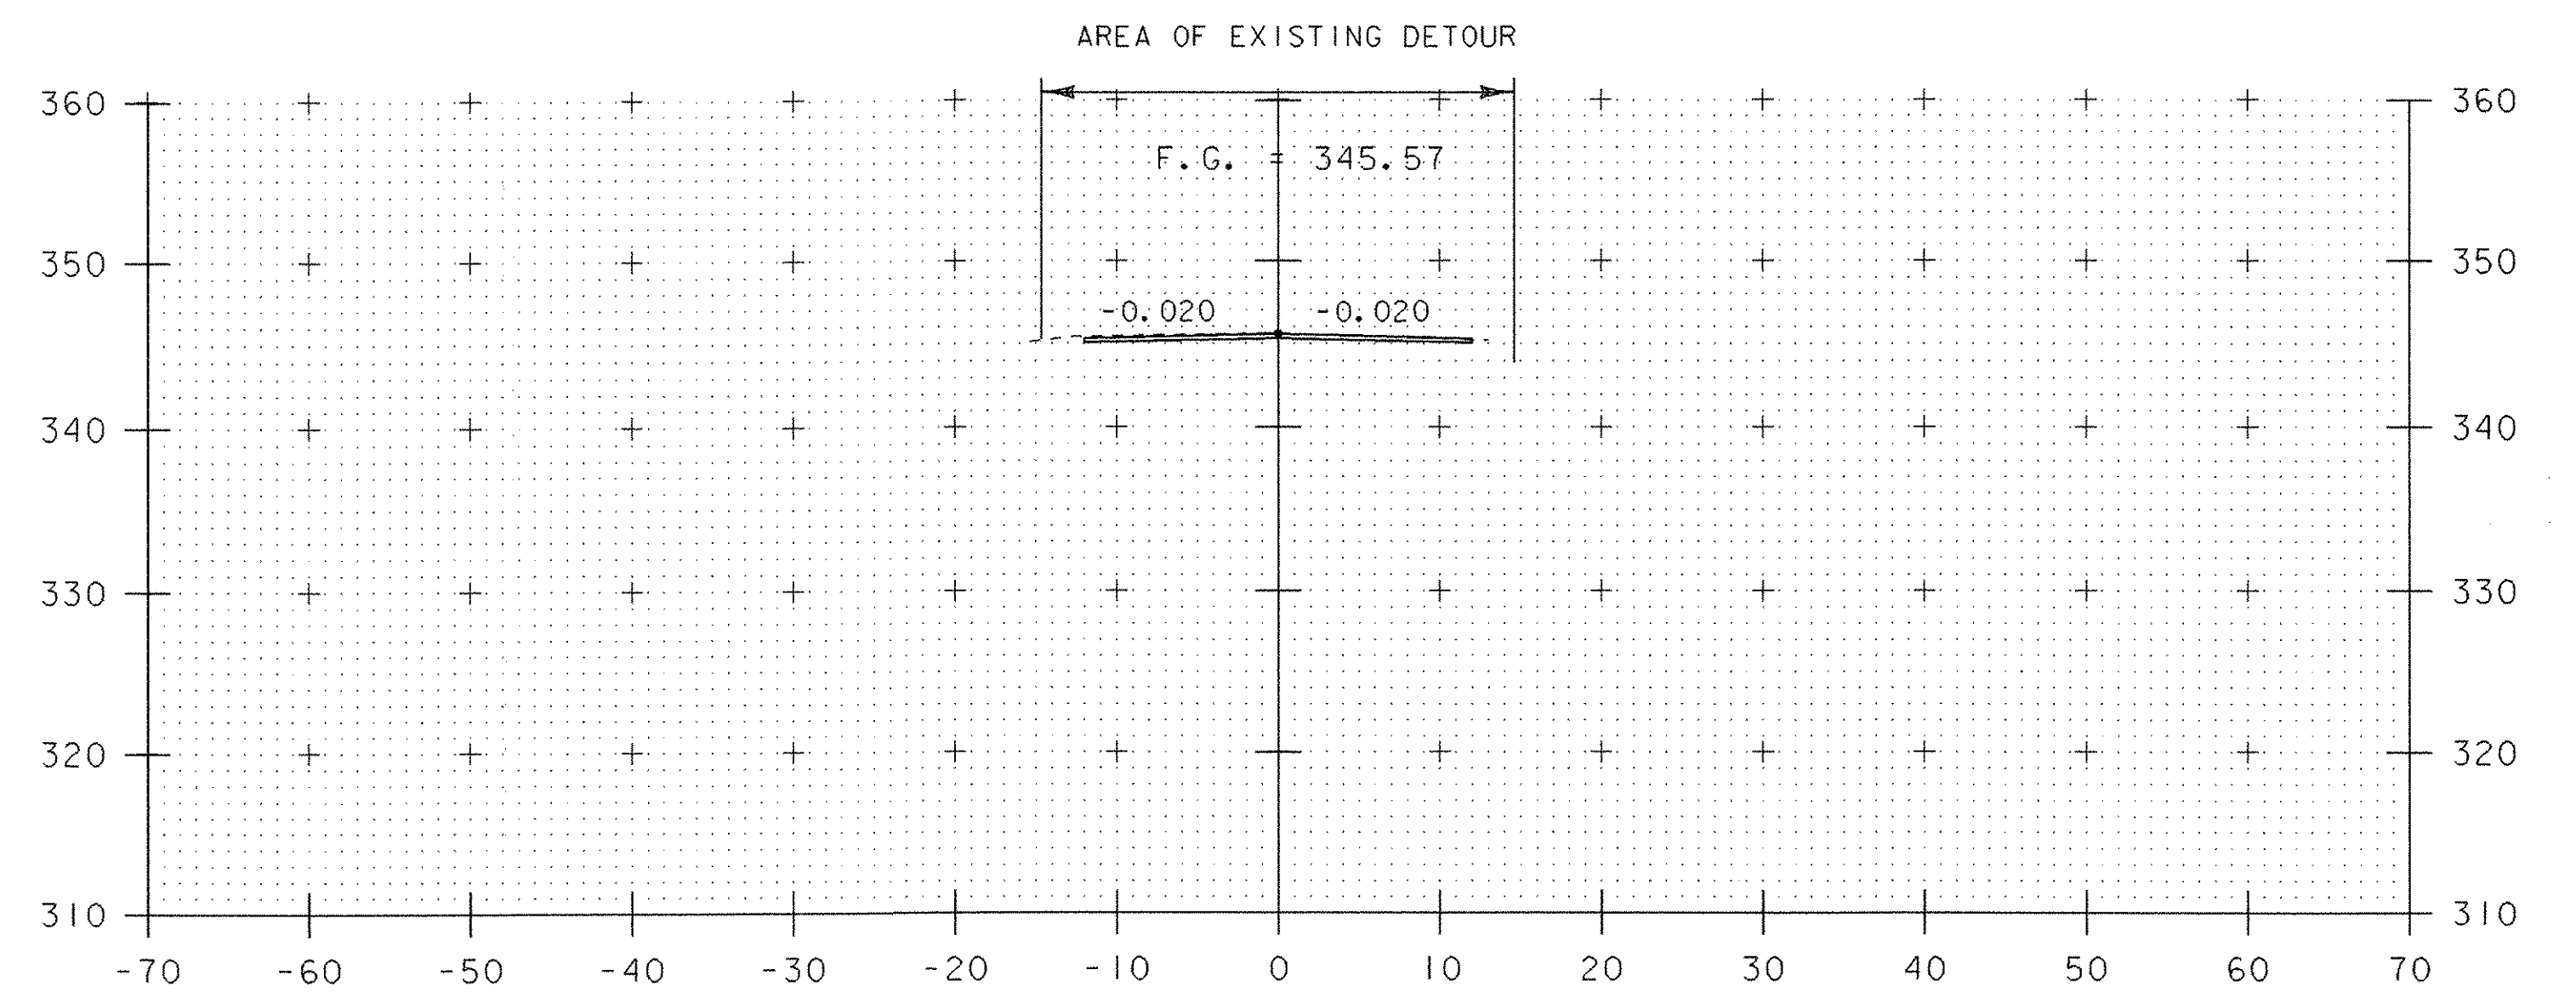

12+50

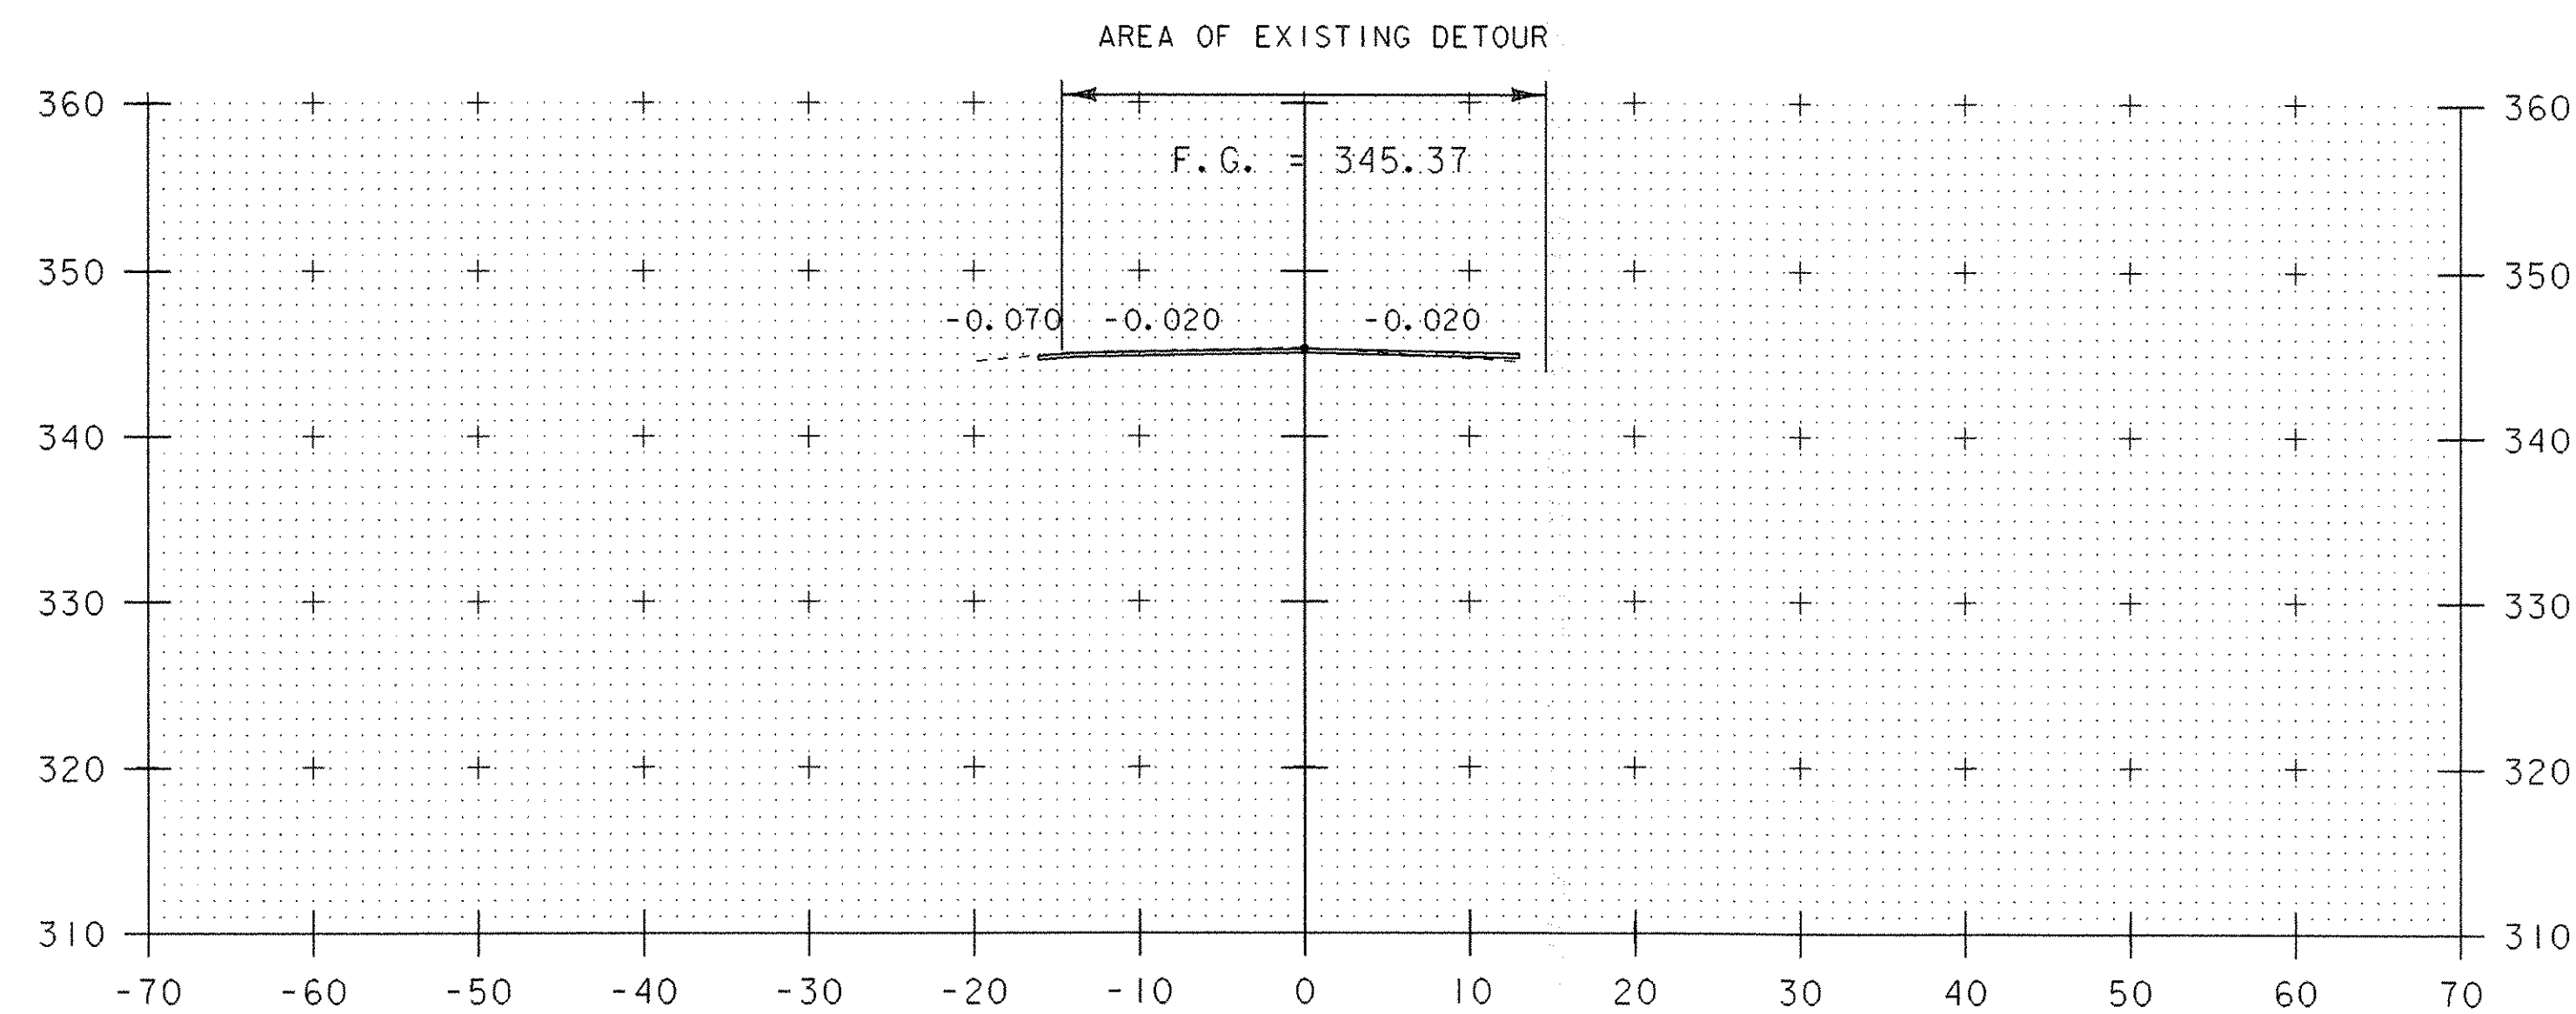

11+75

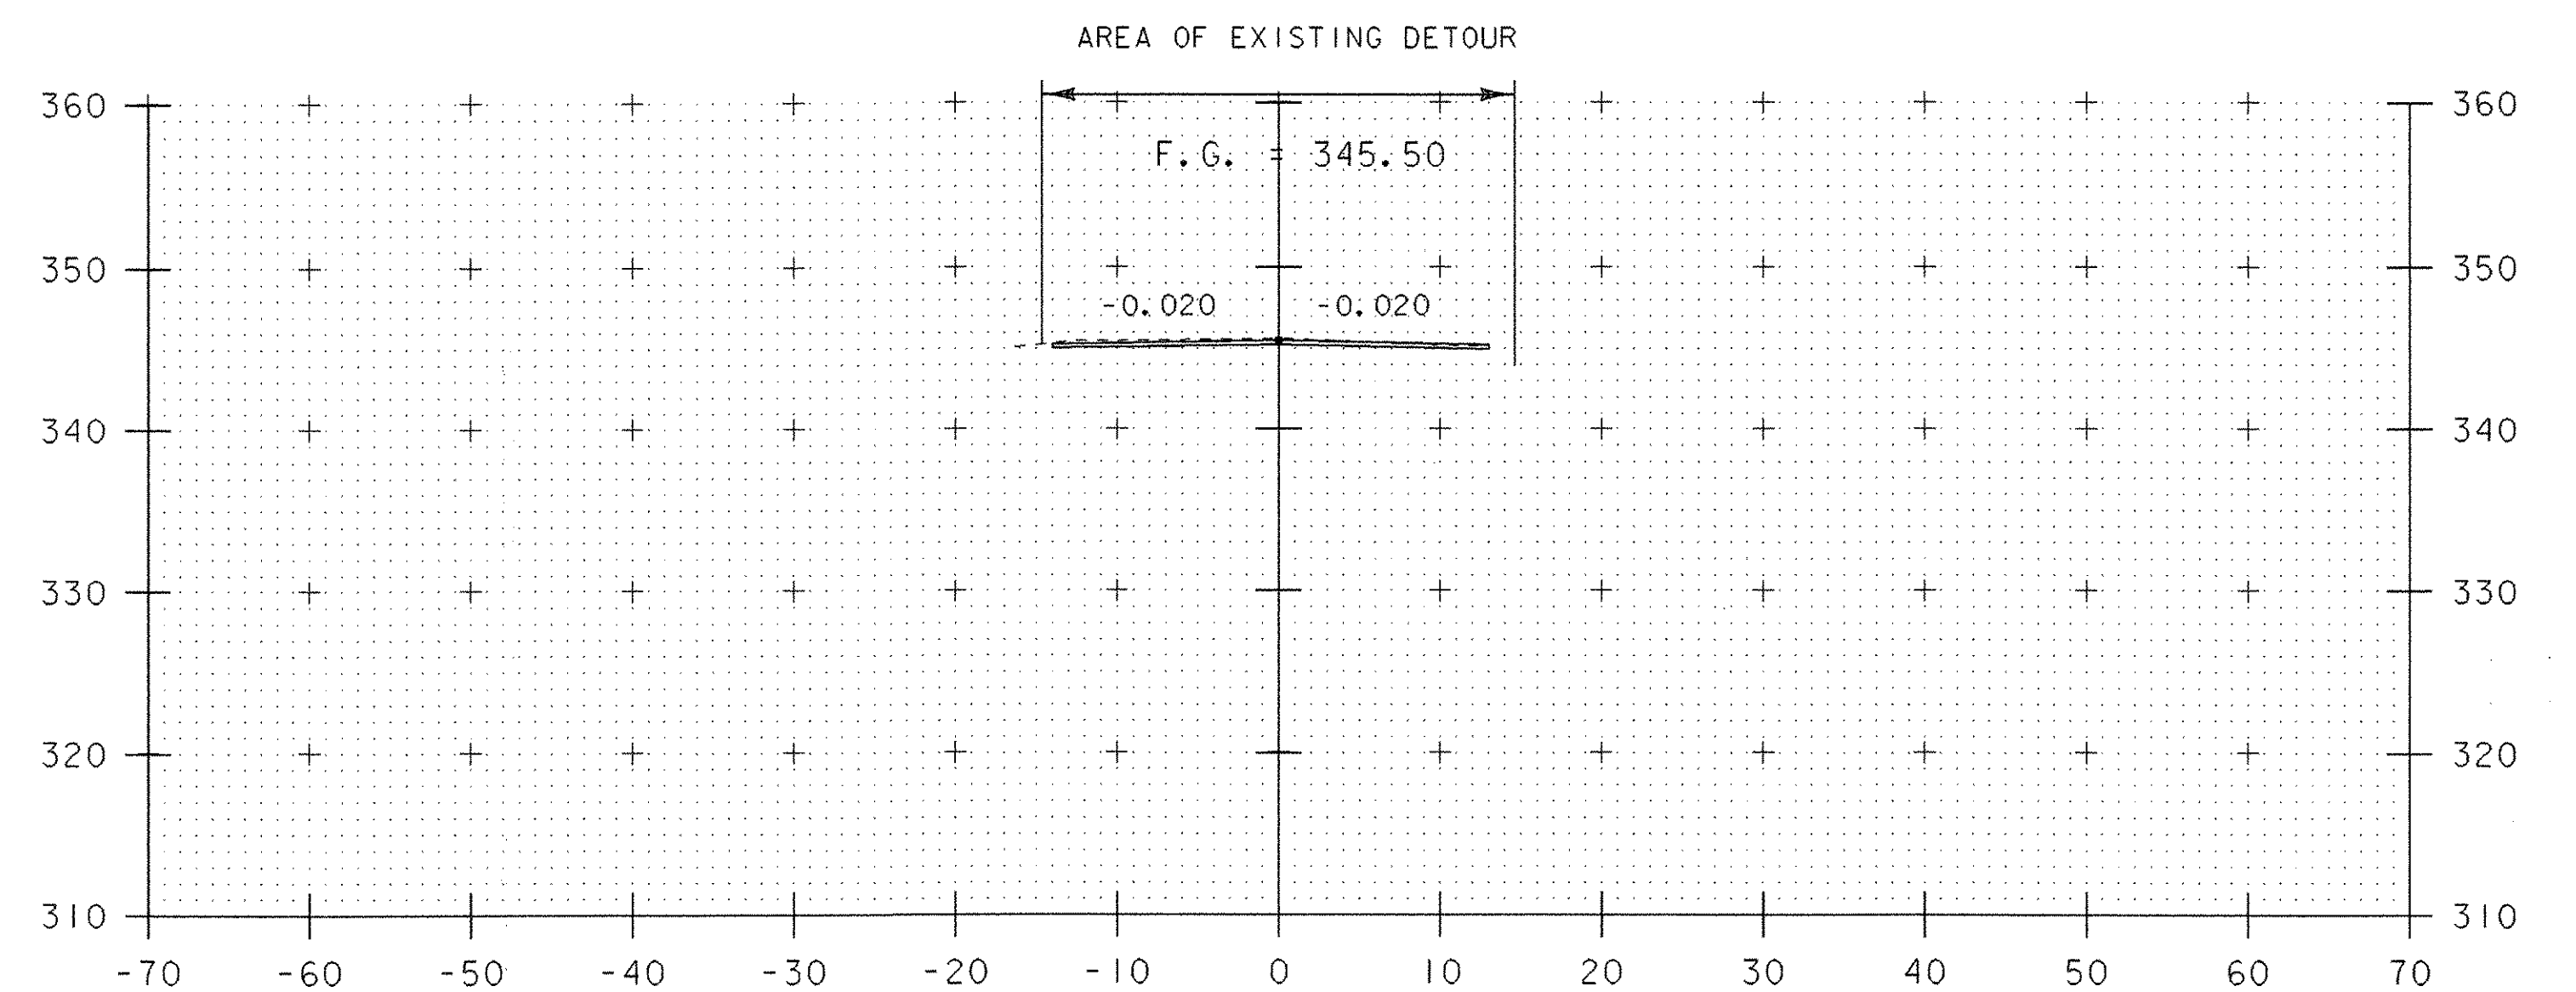

12+25

**VT 116 SECTIONS 14**

PROJECT NAME: BRISTOL  
 PROJECT NUMBER: ER ST 021-1(22)

FILE NAME: 05bl26\STR\s05bl26xs.dgn PLOT DATE: 20-MAR-2007  
 PROJECT LEADER: M.EVANS-MONGEON DRAWN BY: G.ROKES  
 DESIGNED BY: M.EVANS-MONGEON CHECKED BY: G.ROKES  
 IPARM s05bl26\sl4.1 SHEET 60 OF 66