




50+58
WW#2 CONNECTION TO BOX

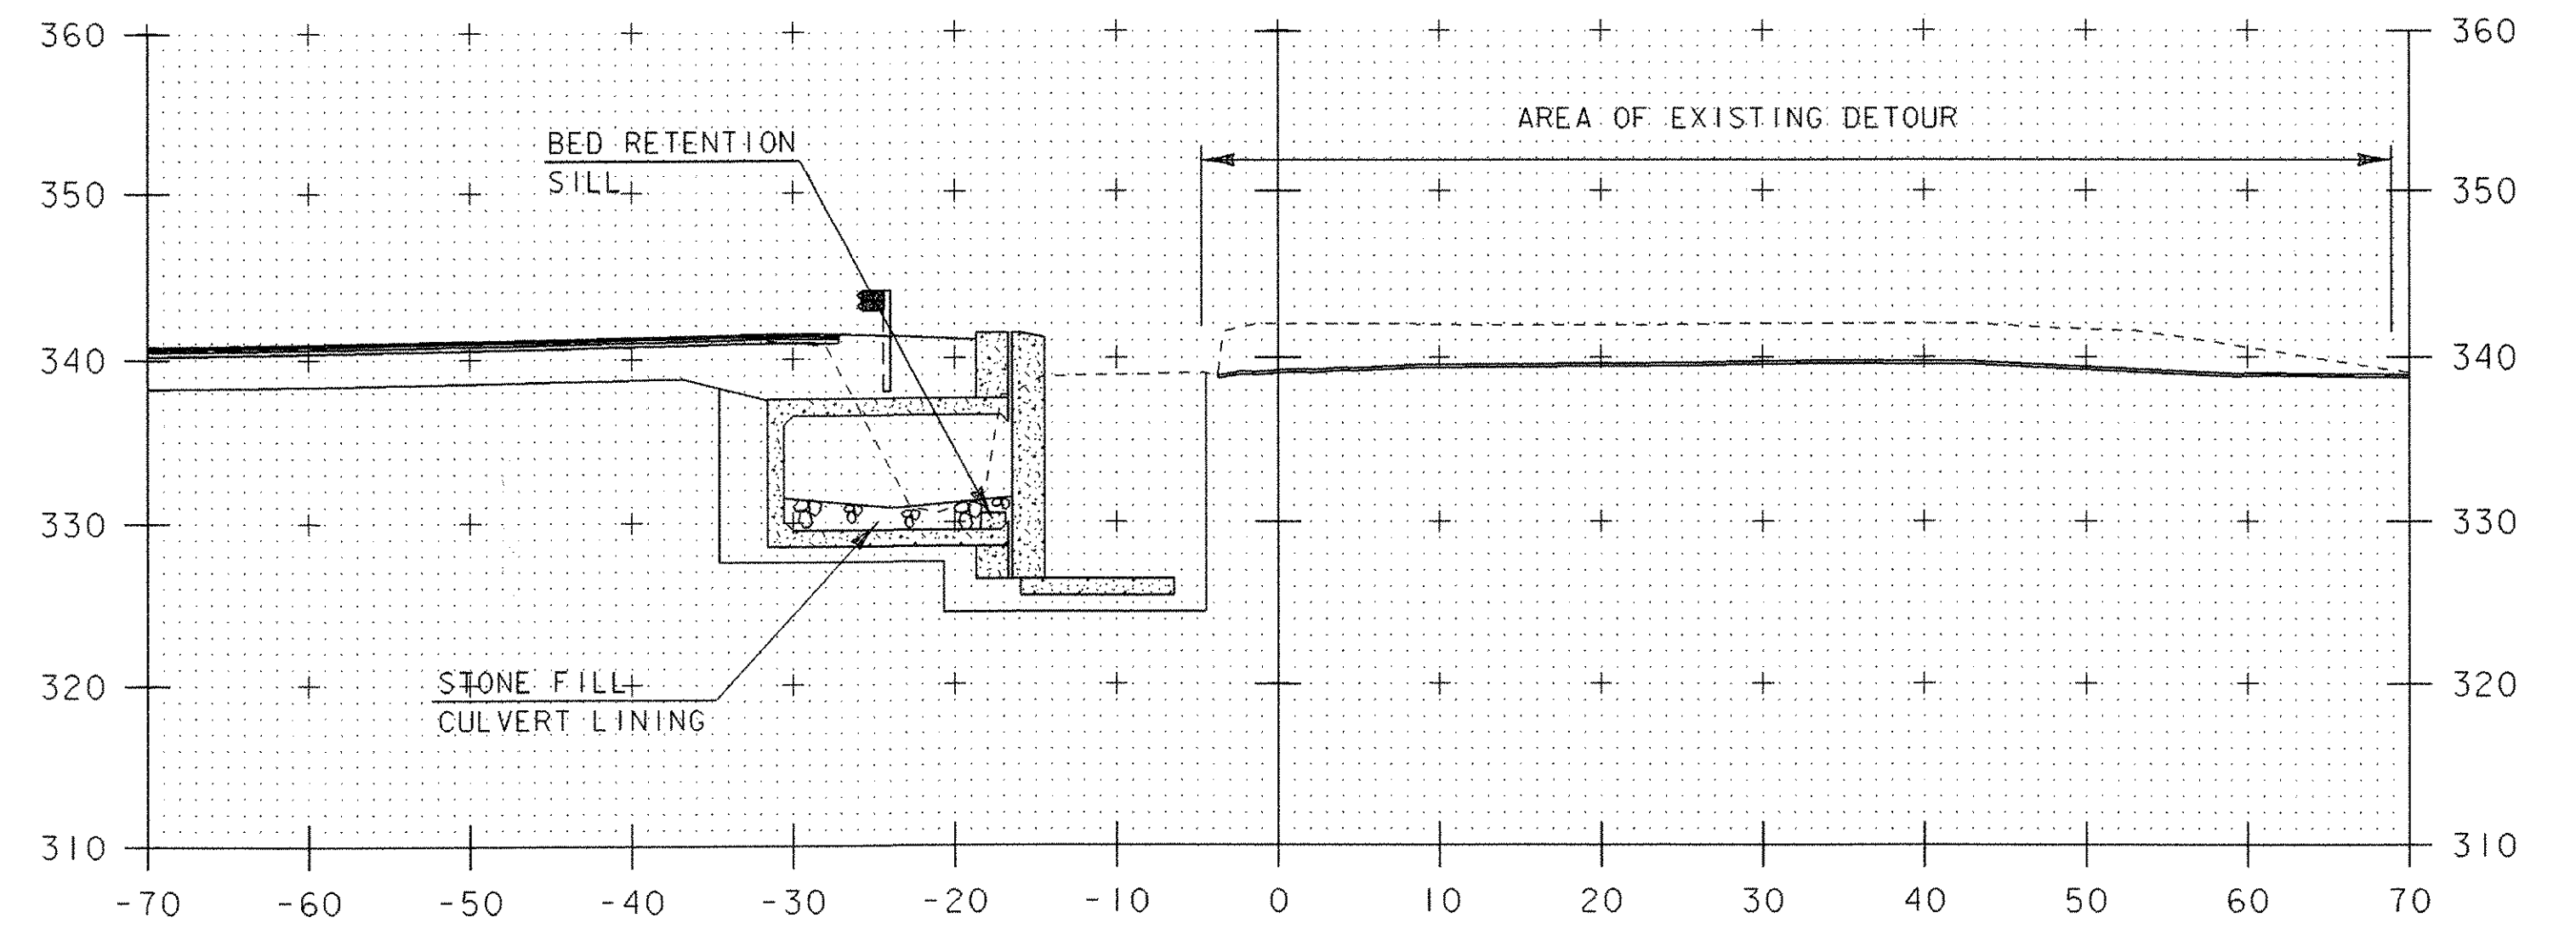

50+67
WW#4 CONNECTION TO BOX

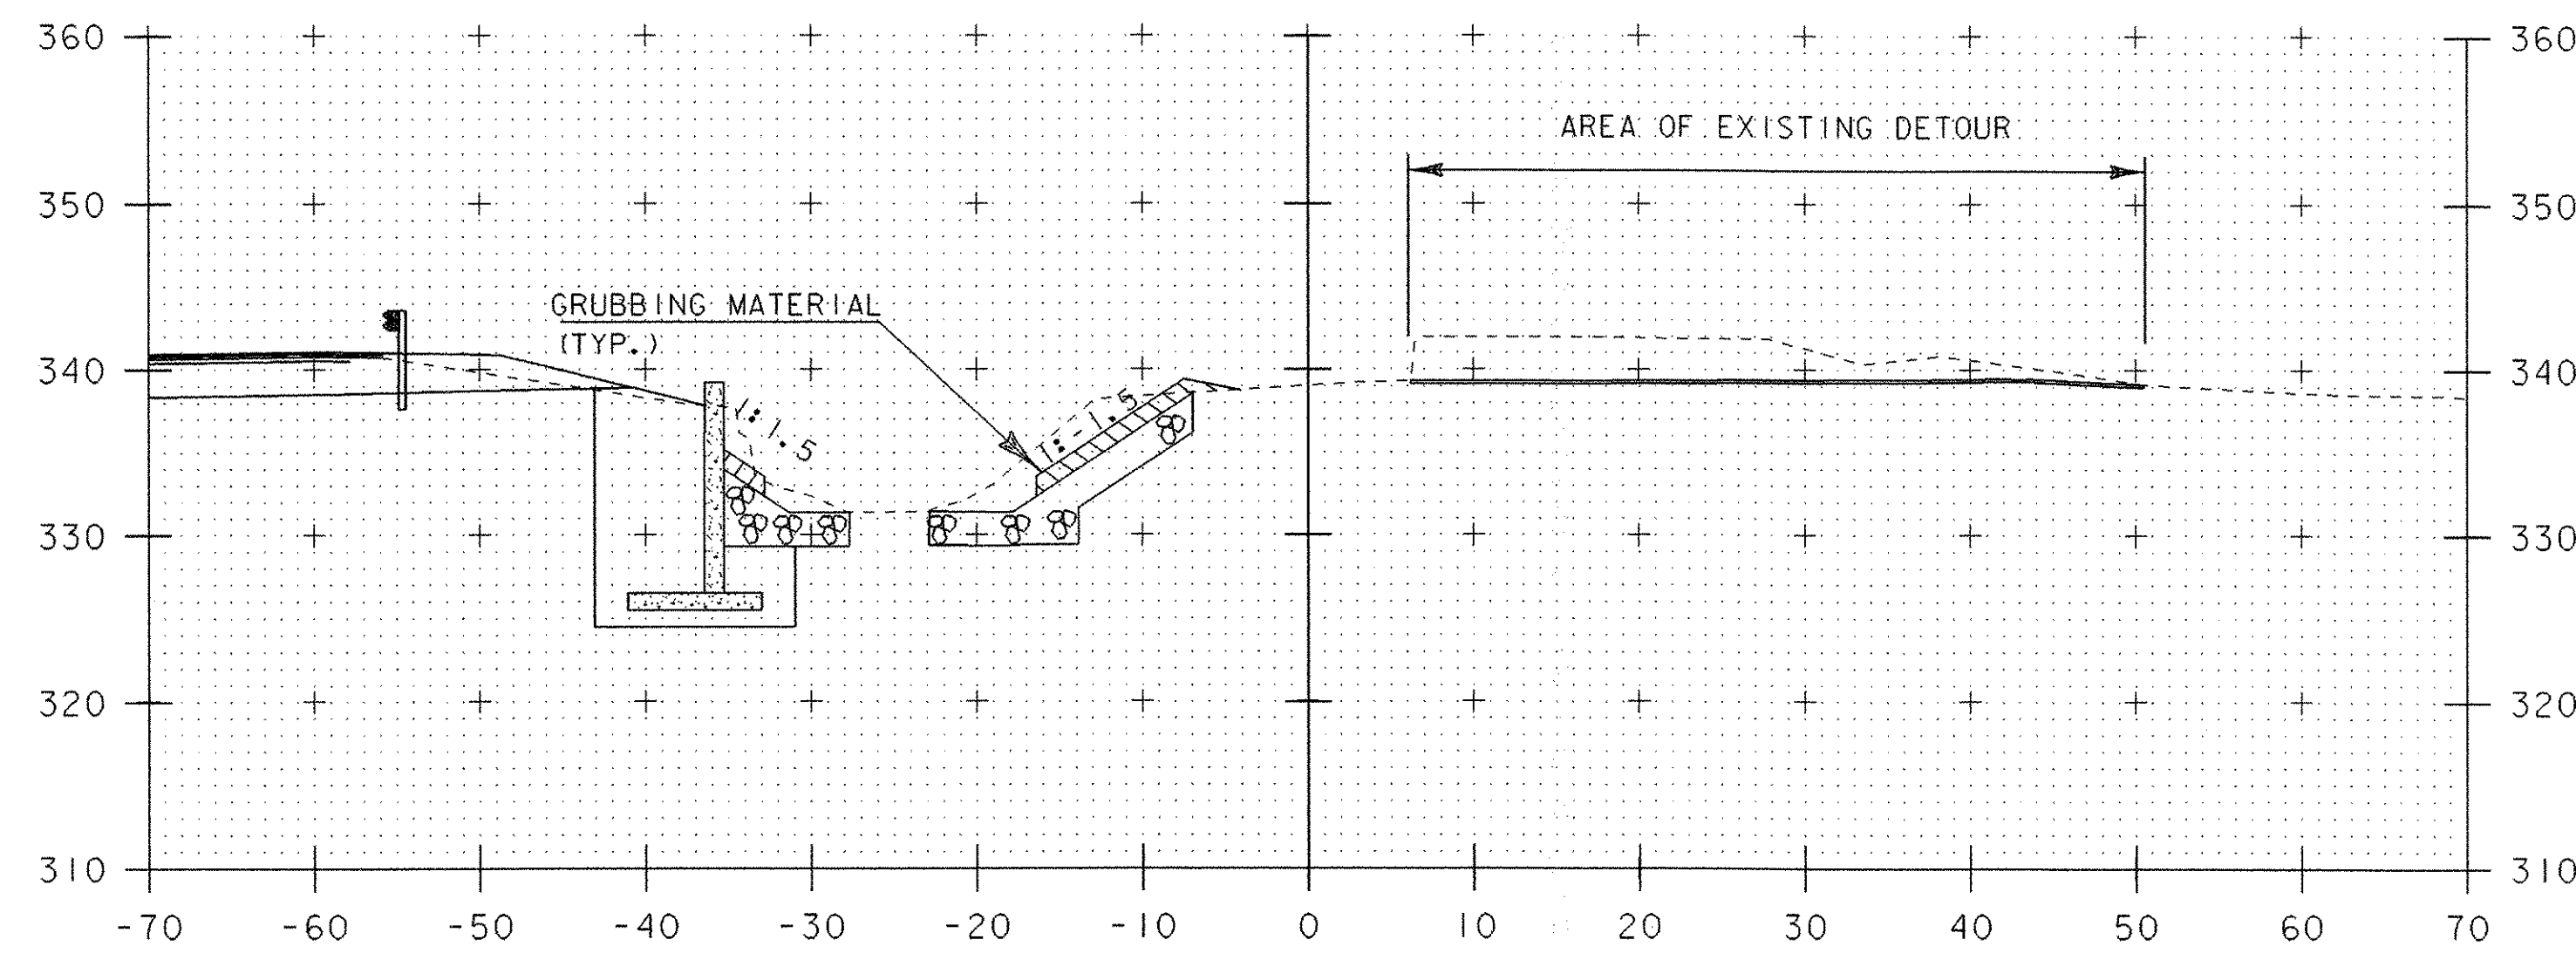

50+50

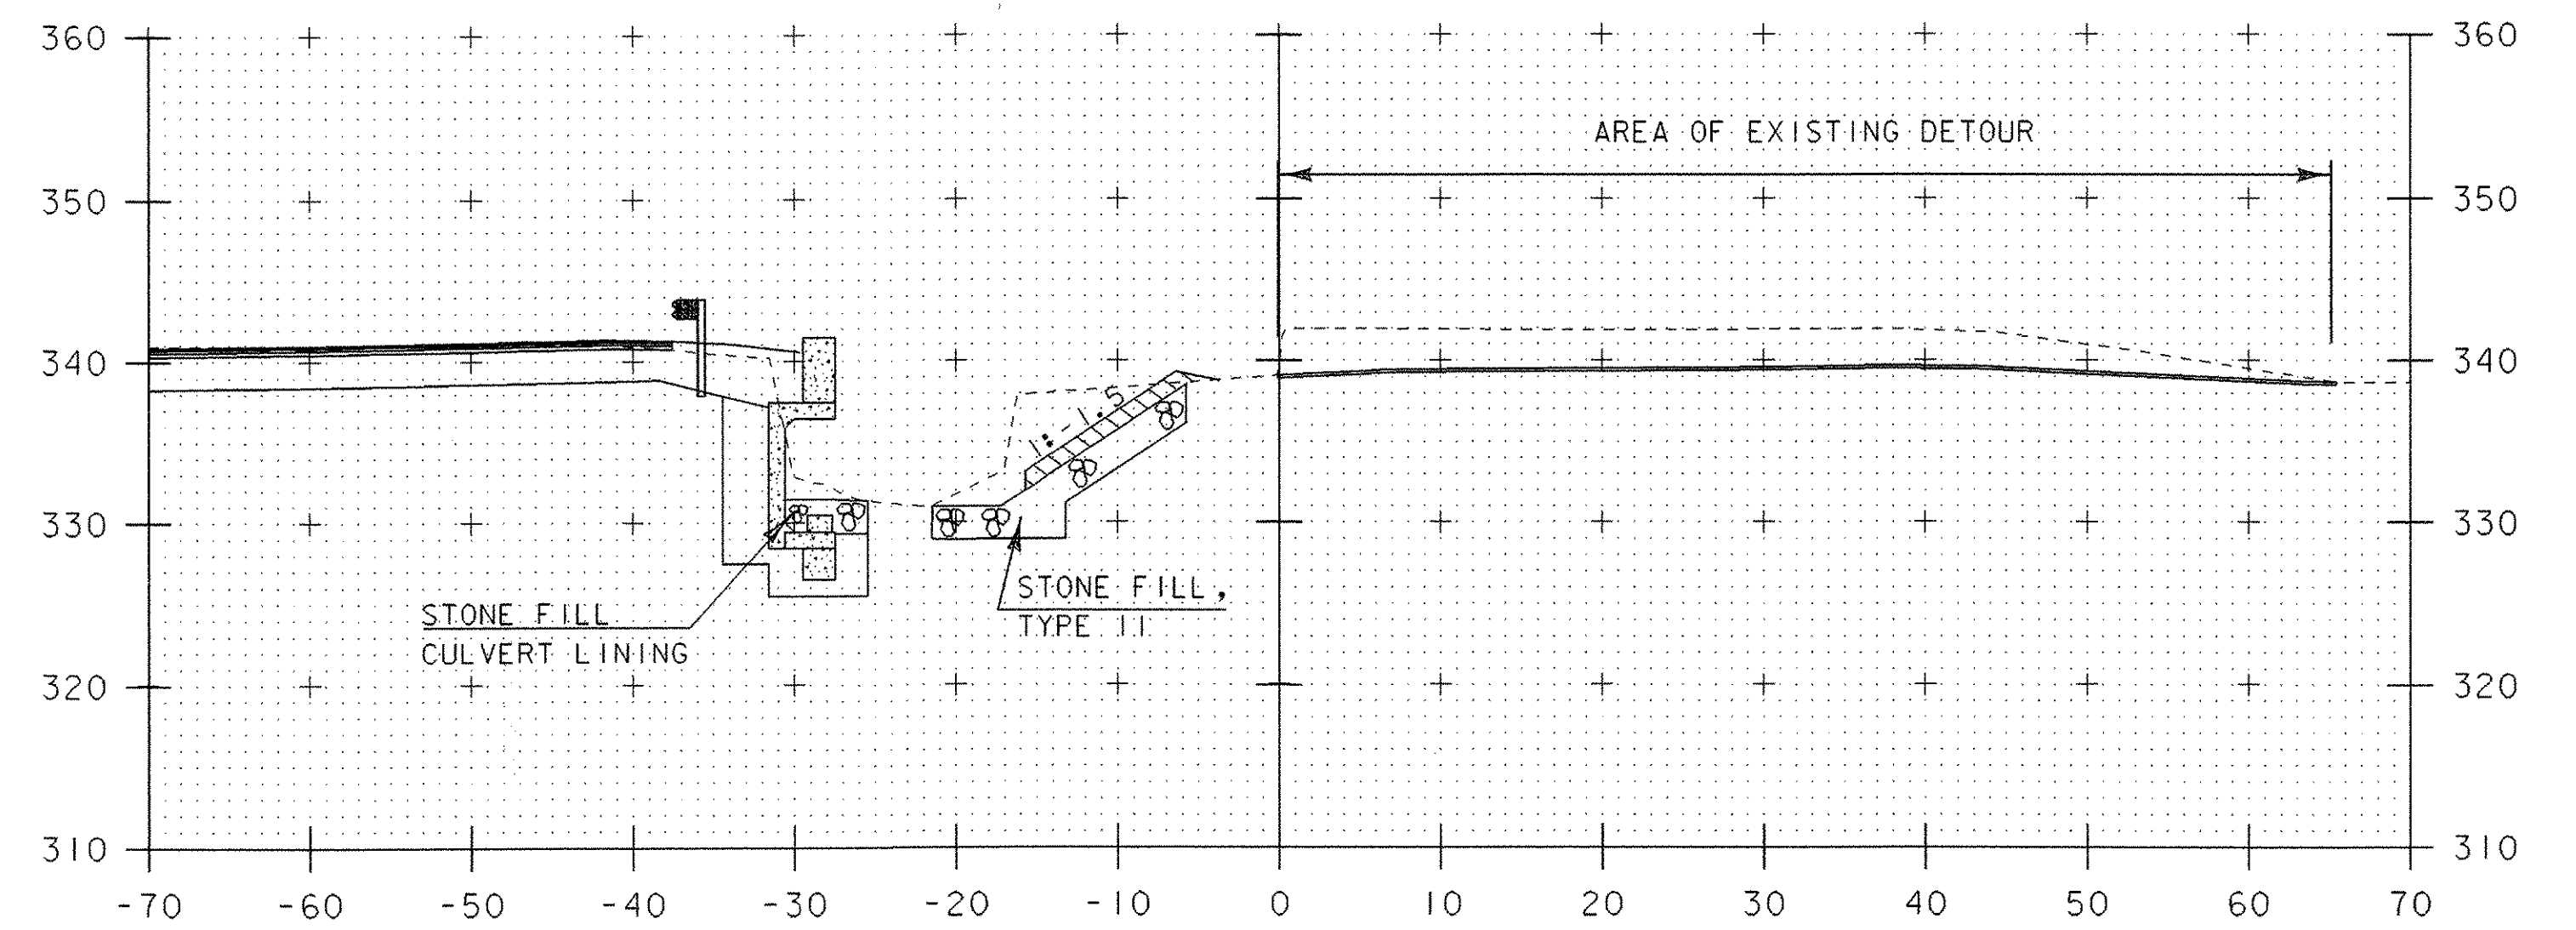

50+61
CHANNEL SLOPE AT END OF WW#4

STA. 50+65 RT AND 50+61 LT
 END STONE FILL, CULVERT LINING
 END GEOTEXTILE UNDER STONE FILL
 END GRUBBING MATERIAL
 END UNCLASSIFIED CHANNEL EXCAVATION

CHANNEL SECTIONS 2

PROJECT NAME: BRISTOL
 PROJECT NUMBER: ER ST 021-1(22)

FILE NAME: 05bl26\STR\s05bl26xs.dgn PLOT DATE: 20-MAR-2007
 PROJECT LEADER: M. EVANS-MONGEON DRAWN BY: G.ROKES
 DESIGNED BY: M. EVANS-MONGEON CHECKED BY: G.ROKES
 IPARM s05bl26cx2.1 SHEET 63 OF 66