



MAST ARM #3
 LOOKING SOUTH ON
 I-89 SB EXIT RAMP

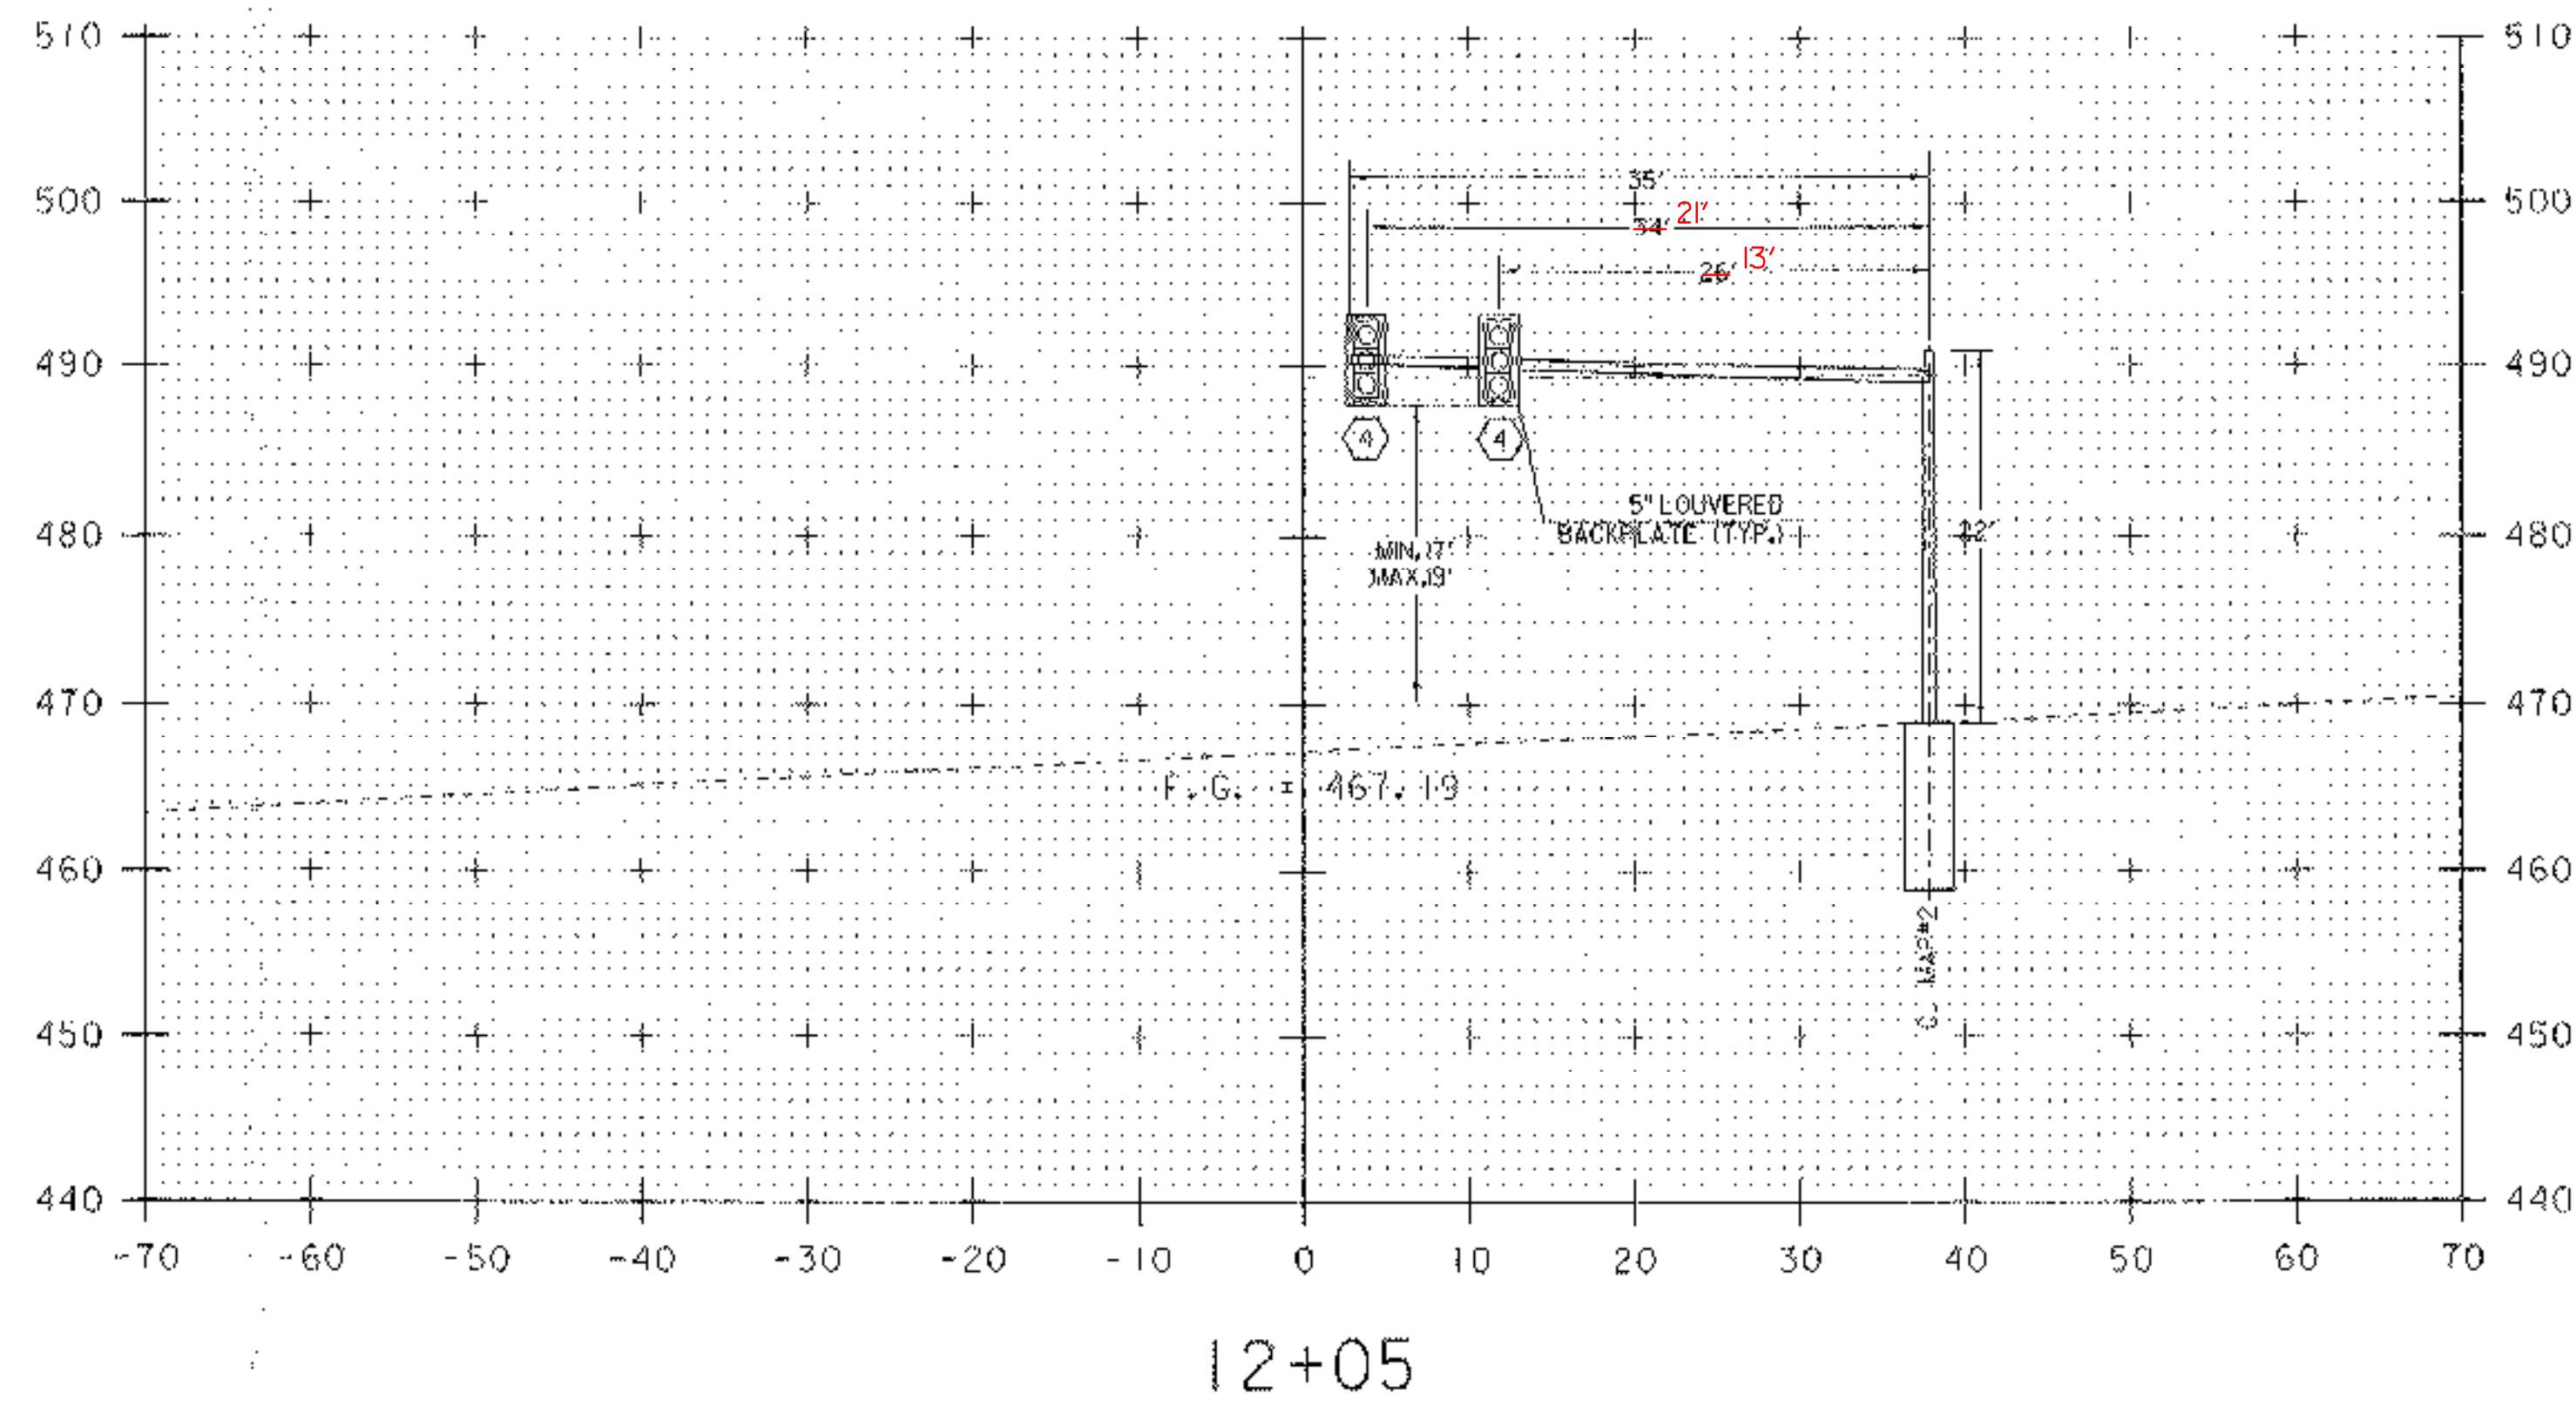

• ARM SHOULD BE ON RIGHT
 SIDE OF POLE

NOTE: THE FOUNDATION DEPTHS
 ARE NOT TO SCALE (TYP).

MAST ARM #2
 LOOKING EAST ON
 VT 100

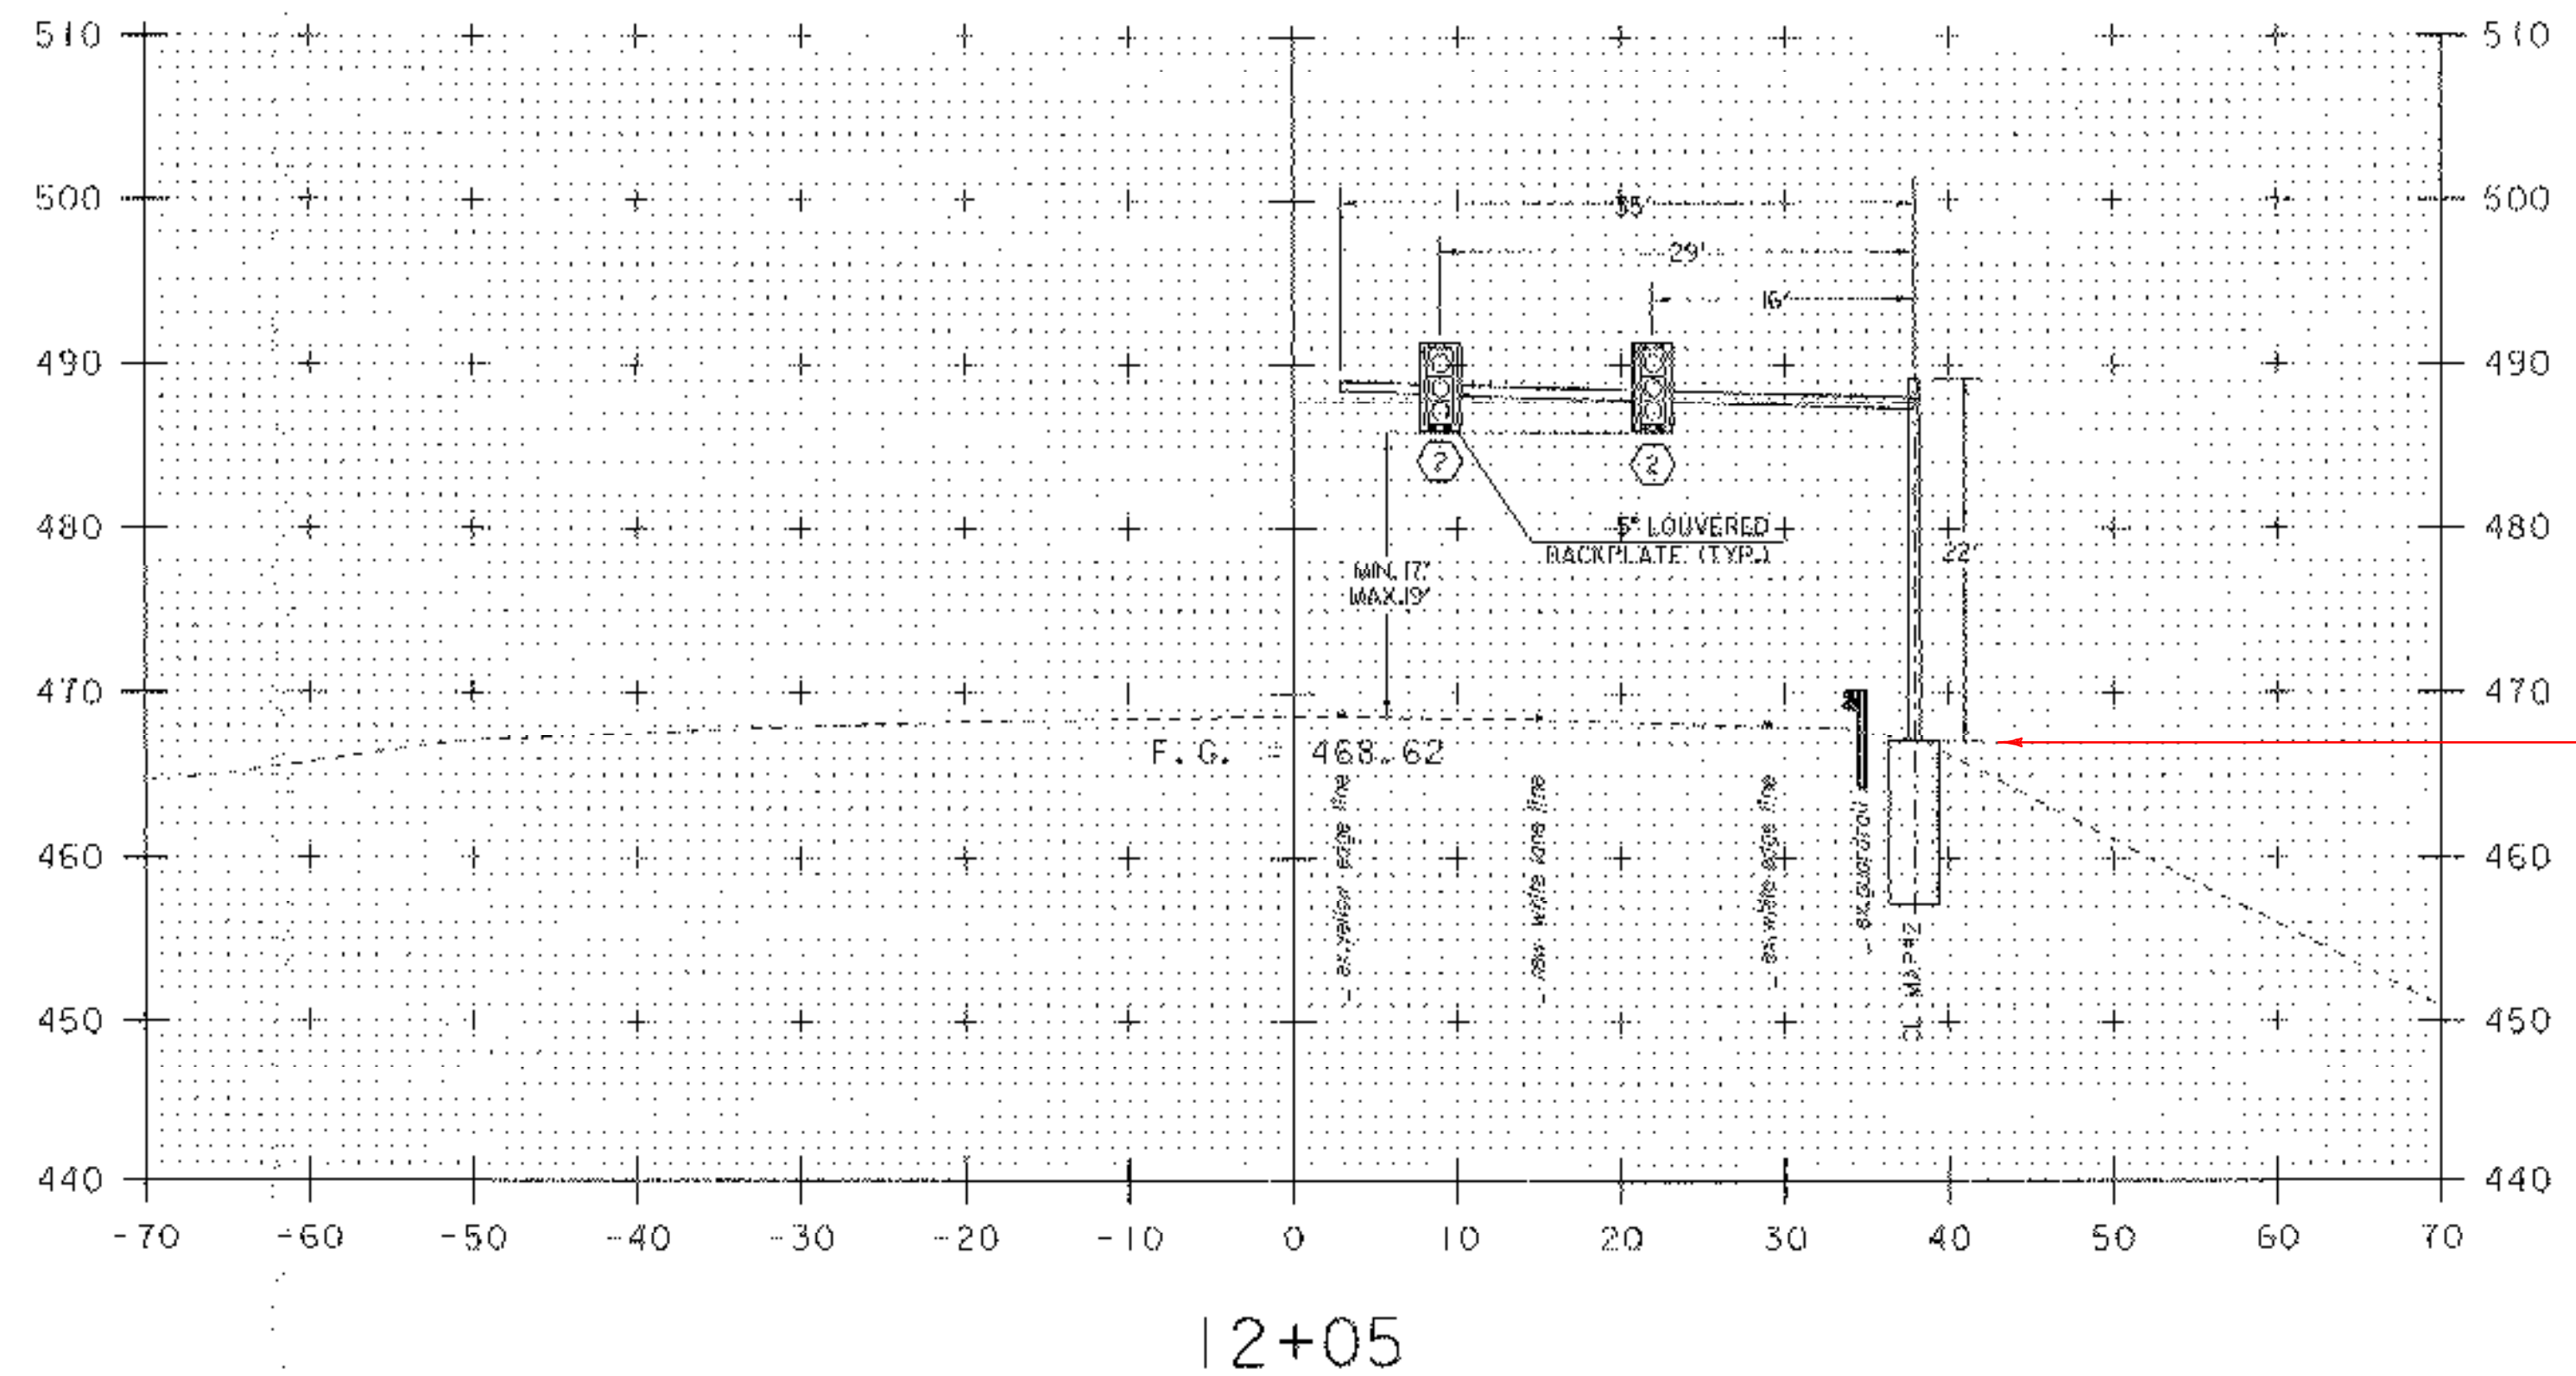

467.685 THEORETICAL
 467.98 ACTUAL

MAST ARM CROSS SECTION SHEET 1

PROJECT NAME:	WATERBURY	PLOT DATE:	13-NOV-2007
PROJECT NUMBER:	NHG SGNL(27)	DRAWN BY:	B. MCAVOY
FILE NAME:	traf/05bl40/tbl40wrk.dgn	DESIGNED BY:	B. MCAVOY
PROJECT LEADER:	J. SCHULTZ	CHECKED BY:	J. SCHULTZ
tbl40xsl1		SHEET	12 OF 13