


MAST ARM #1
LOOKING WEST ON
VT 100

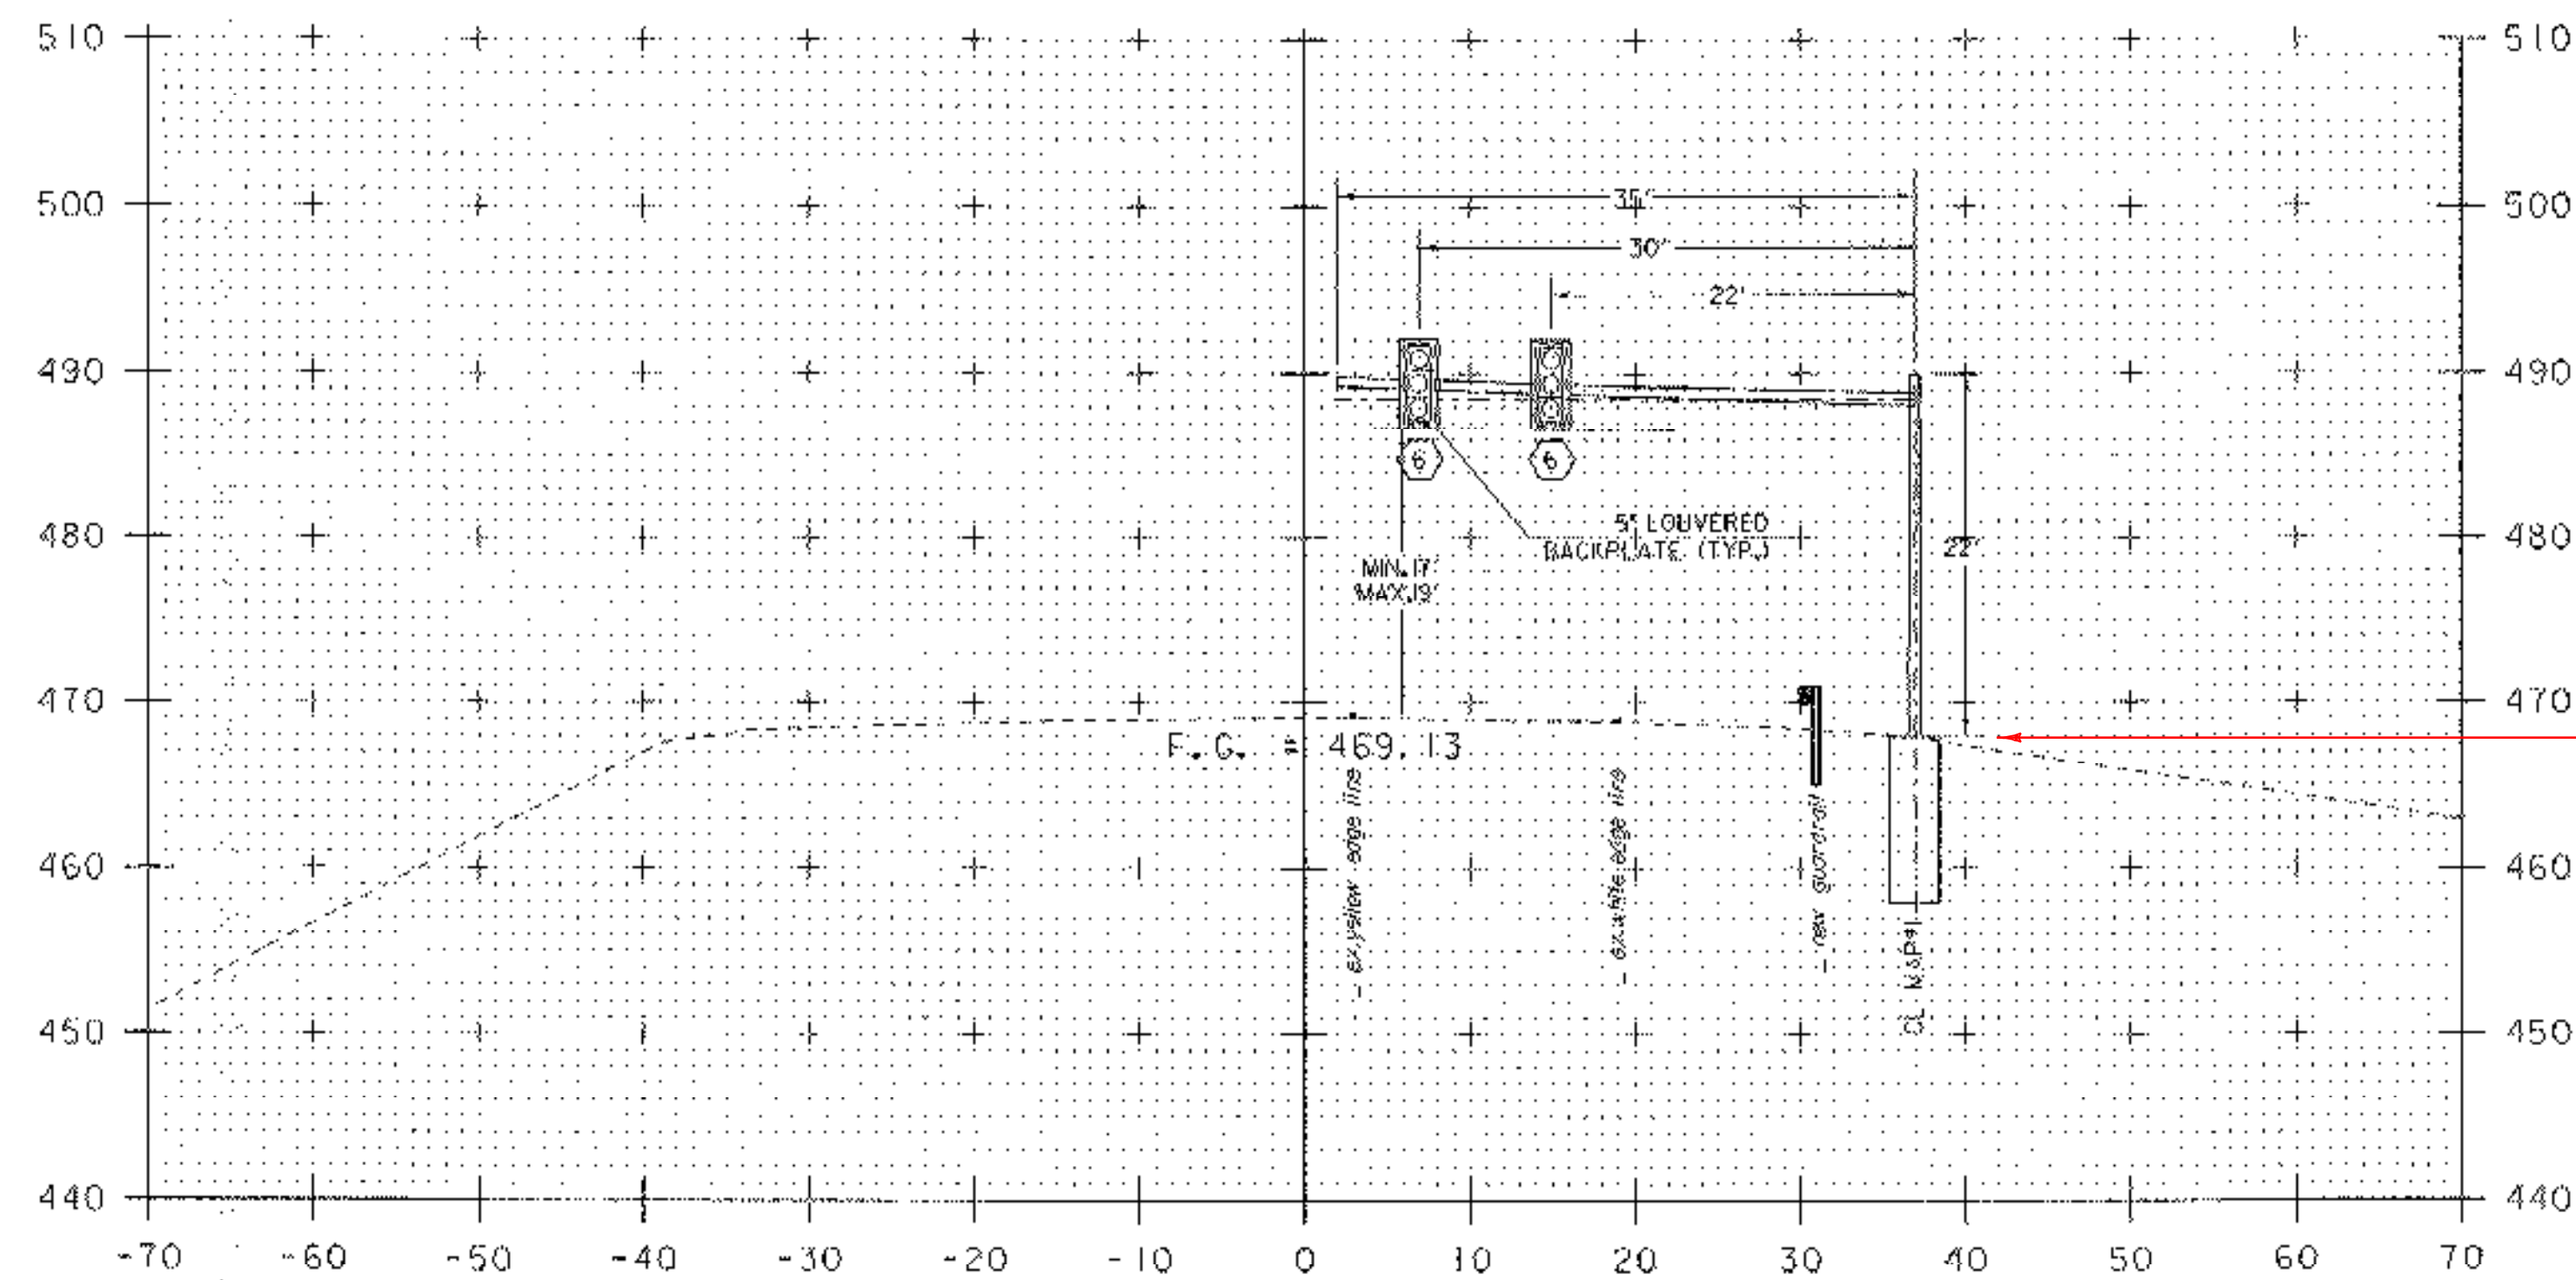

12+16

NOTE: THE FOUNDATION DEPTHS
ARE NOT TO SCALE (TYP).

467.9681 THEORETICAL
467.41 ACTUAL

MAST ARM CROSS SECTION SHEET 2

PROJECT NAME: WATERBURY
PROJECT NUMBER: NHG SGNL(27)

| | |
|-------------------------------------|------------------------|
| FILE NAME: traf/05b140/tb140wrk.dgn | PLOT DATE: 13-NOV-2007 |
| PROJECT LEADER: J. SCHULTZ | DRAWN BY: B. MCAVOY |
| DESIGNED BY: B. MCAVOY | CHECKED BY: J. SCHULTZ |
| tbM0xs2.J | SHEET 13 OF 13 |