



APPROACH AREA DETAIL

VT. ROUTE 73 ROCHESTER STA. 0+00.00 - BEGIN PROJECT

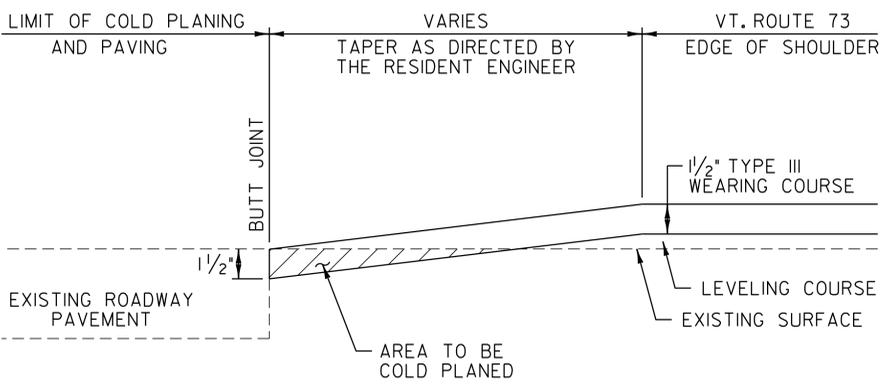

APPROACH AREA DETAIL


- ROCHESTER:
- TH-37 STA. 190+44.96
 - TH-22 STA. 259+35.36
 - TH-40 STA. 340+82.40
 - TH-31 STA. 386+17.92
 - TH-33 STA. 397+00.32

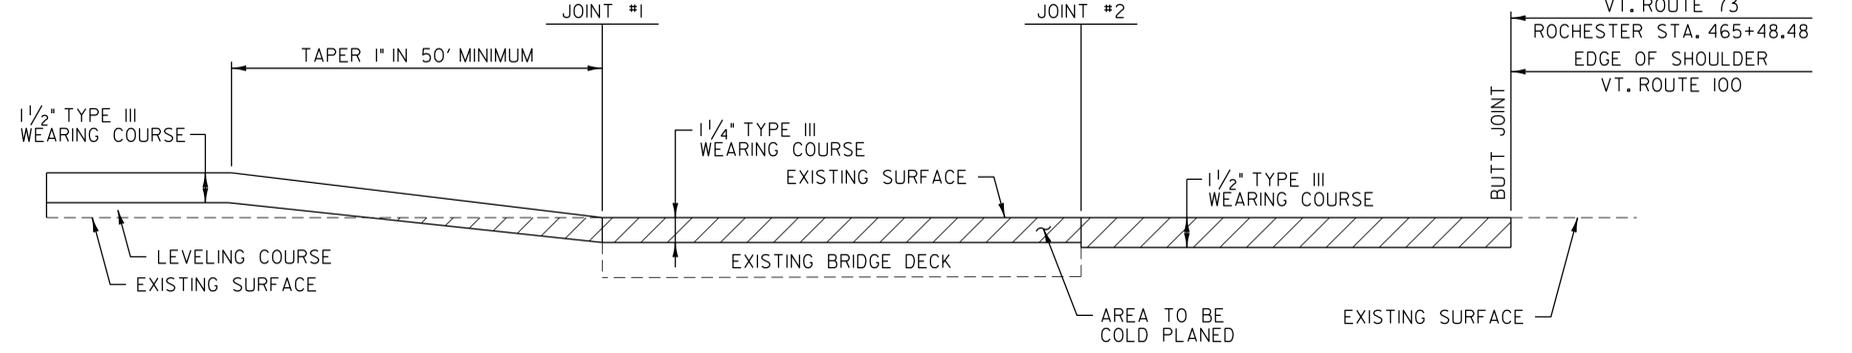

BRIDGE 19 TRANSITION AREA DETAIL

BR 19 VT. ROUTE 73 ROCHESTER STA. 464+51.00 TO STA. 465+26.00


NOTE:
THE CONTRACTOR MUST USE CARE WHEN COLD PLANING BR 19 AS NOT TO DAMAGE THE BRIDGE MEMBRANE. IF DAMAGE TO THIS MEMBRANE SHOULD OCCUR DURING COLD PLANING, THE CONTRACTOR SHALL REPAIR THE BRIDGE MEMBRANE AT NO COST TO THE STATE.

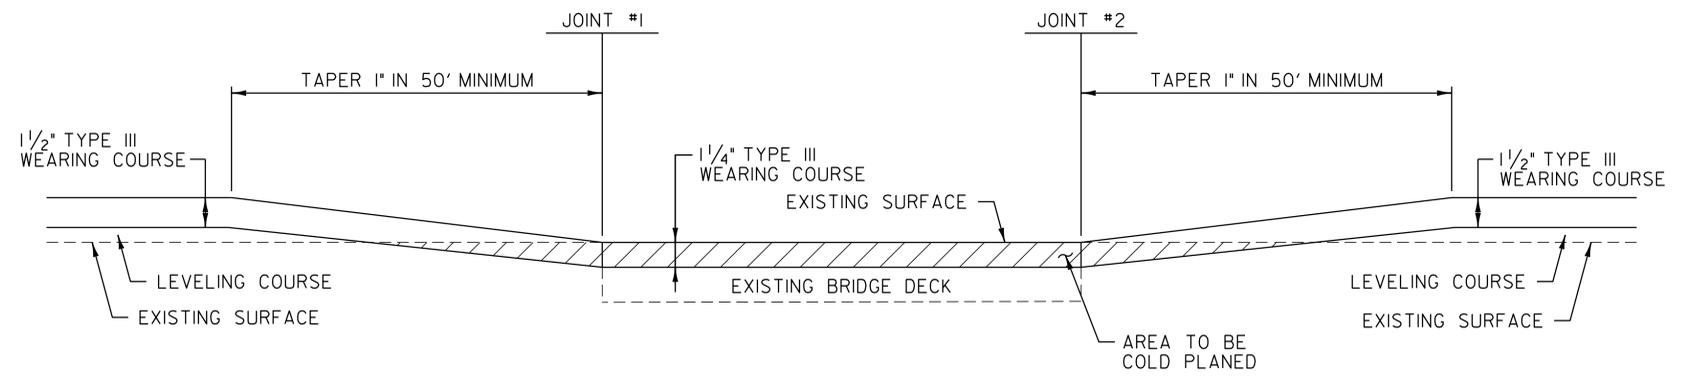


BRIDGE TRANSITION AREA DETAIL

- BR 14 VT. ROUTE 73 ROCHESTER STA. 193+65.00 TO STA. 194+18.00
- BR 15 VT. ROUTE 73 ROCHESTER STA. 259+93.00 TO STA. 260+37.00
- BR 16 VT. ROUTE 73 ROCHESTER STA. 336+05.00 TO STA. 336+38.00
- BR 17 VT. ROUTE 73 ROCHESTER STA. 368+04.00 TO STA. 369+06.00

NOTE:
THE CONTRACTOR MUST USE CARE WHEN COLD PLANING BR 17 AS NOT TO DAMAGE THE BRIDGE MEMBRANE. IF DAMAGE TO THIS MEMBRANE SHOULD OCCUR DURING COLD PLANING, THE CONTRACTOR SHALL REPAIR THE BRIDGE MEMBRANE AT NO COST TO THE STATE.

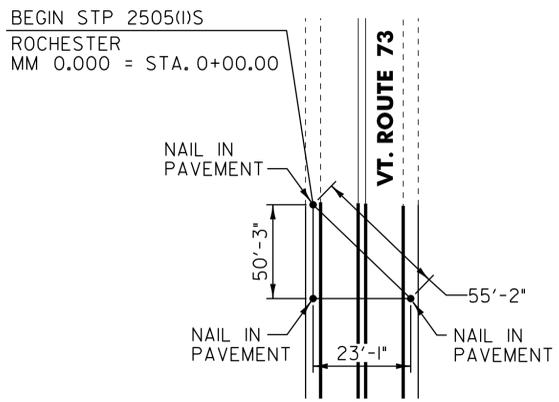

BEGIN PROJECT LOCATION TIES

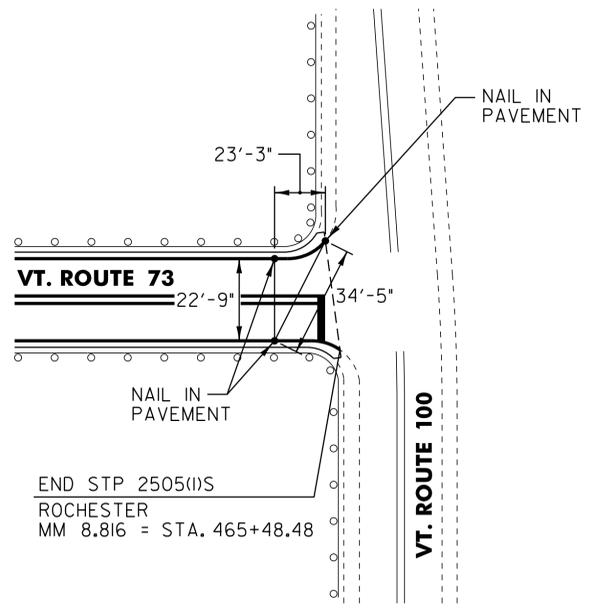

END PROJECT LOCATION TIES

NOT TO SCALE

PAVING DETAILS AND TIE SHEET

PROJECT NAME: ROCHESTER-CHILINDEN-ROCHESTER
PROJECT NUMBER: SIP_2505(IIS)

FILE NAME: p05c046.dgn
PROJECT LEADER: D.E.G.
DESIGNED BY: J.S.P.
IPARM FILE: p05c046pdsl.i

PLOT DATE: \$DATE\$
DRAWN BY: C.A.K.
CHECKED BY: D.E.G.
SHEET 4 OF 56