

646.402 DURABLE 4 INCH WHITE LINE, THERMOPLASTIC
 (ALL LINES WILL INCLUDE EDGE LINE BREAKS AND
 RADIUS FOR TOWN HIGHWAYS)

ROCHESTER:
 STA. 0+00.00 - STA. 16+00.00 LT & RT

646.412 DURABLE 4 INCH YELLOW LINE, THERMOPLASTIC
 (ALL LINES WILL INCLUDE C/L BREAKS FOR
 TOWN HIGHWAYS) S=SOLID, D=DASHED


ROCHESTER: LT Q RT
 STA. 0+00.00 - STA. 16+00.00 S - S

646.602 TEMPORARY 4 INCH WHITE LINE, PAINT
 (ALL LINES WILL INCLUDE EDGE LINE BREAKS AND
 RADIUS FOR TOWN HIGHWAYS)

ROCHESTER:
 STA. 0+00.00 - STA. 16+00.00 LT & RT

646.612 TEMPORARY 4 INCH YELLOW LINE, PAINT
 (ALL LINES WILL INCLUDE C/L BREAKS FOR
 TOWN HIGHWAYS) S=SOLID, D=DASHED

ROCHESTER: LT Q RT
 STA. 0+00.00 - STA. 16+00.00 S - S

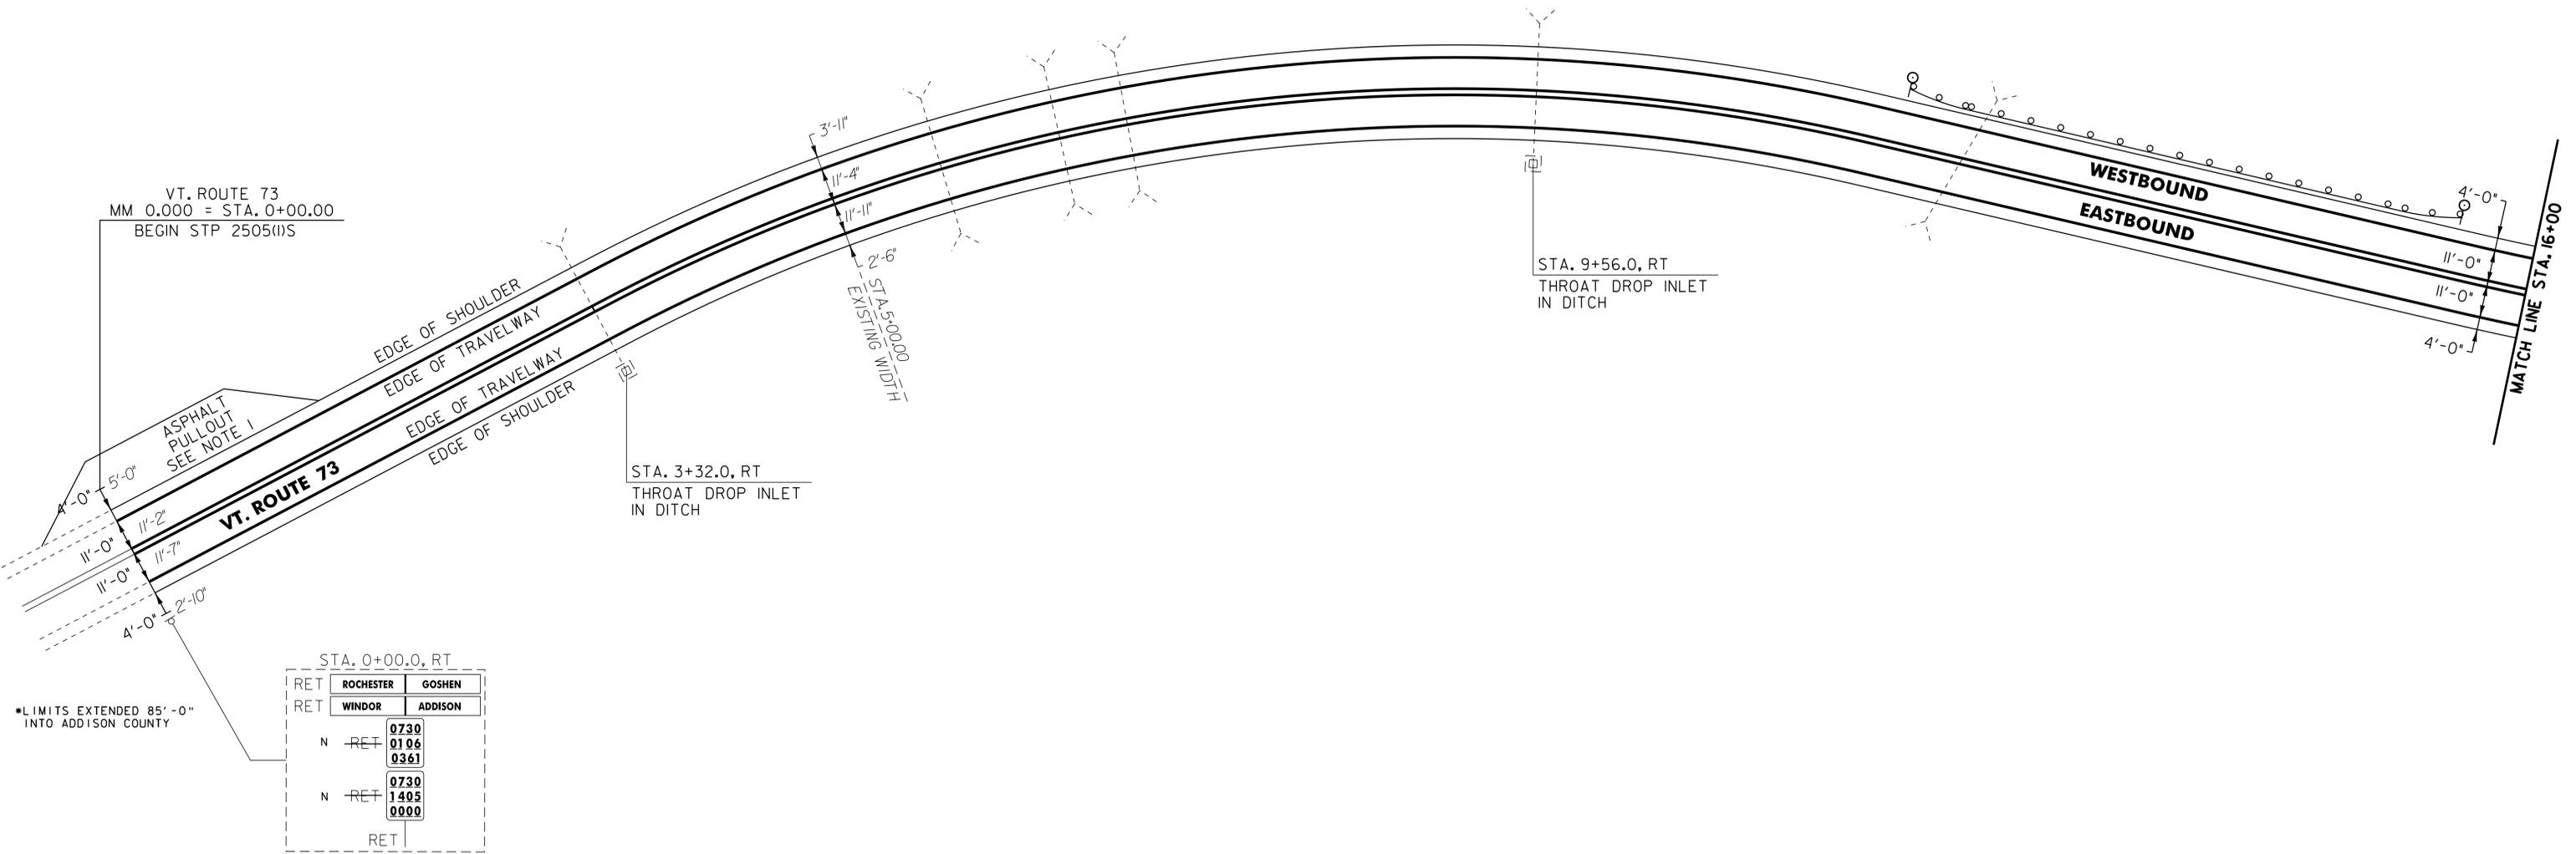

604.412 REHAB. DROP INLETS, CATCH BASINS OR MANHOLES, CLASS I

ROCHESTER:
 STA. 3+32.0 RT
 STA. 9+56.0 RT

621.80 REMOVAL AND DISPOSAL OF GUARDRAIL

ROCHESTER:
 STA. 12+29.0 - STA. 14+95.0 LT (266.0 LF)

676.10 DELINEATOR WITH STEEL POST

Ø TYPE I WHITE

ROCHESTER:
 STA. 11+87.5 LT
 STA. 15+50.0 LT

900.620 SPECIAL PROVISION (MANUFACTURED TERMINAL SECTION, FLARED/WEATHERING)

ROCHESTER:
 STA. 11+87.5 - STA. 12+25.0 LT
 STA. 15+12.5 - STA. 15+50.0 LT

900.640 SPECIAL PROVISION (STEEL BEAM GUARDRAIL, WEATHERING)

ROCHESTER:
 STA. 12+25.0 - STA. 15+12.5 LT (287.5 LF)

SIGN LEGEND

R = REMOVE
 S = SALVAGE
 N = NEW
 RET = RETAIN
 B-B = BACK TO BACK
 EXISTING = - - - - -
 NEW = _____

NOTE:

1. PROVIDE A 5 FT WIDE, 1 1/2" TYPE III APRON FOR THE EXISTING ASPHALT PULLOUT.

NOT TO SCALE

PROJECT LAYOUT SHEET #1

PROJECT NAME: ROCHESTER-CHILIENDEN-ROCHESTER

PROJECT NUMBER: SIP_2505(1)S

FILE NAME: p05c046.dgn

PROJECT LEADER: D.E.G.

DESIGNED BY: J.S.P.

IPARM FILE: p05c046i.i

PLOT DATE: \$DATE\$

DRAWN BY: C.A.K.

CHECKED BY: D.E.G.

SHEET 13 OF 56