

646.402 DURABLE 4 INCH WHITE LINE, THERMOPLASTIC  
 (ALL LINES WILL INCLUDE EDGE LINE BREAKS AND  
 RADIUS FOR TOWN HIGHWAYS)

ROCHESTER:  
 STA. 112+00.00 - STA. 128+00.00 LT & RT

646.412 DURABLE 4 INCH YELLOW LINE, THERMOPLASTIC  
 (ALL LINES WILL INCLUDE C/L BREAKS FOR  
 TOWN HIGHWAYS) S=SOLID, D=DASHED


ROCHESTER: LT C RT  
 STA. 112+00.00 - STA. 128+00.00 S - S

646.602 TEMPORARY 4 INCH WHITE LINE, PAINT  
 (ALL LINES WILL INCLUDE EDGE LINE BREAKS AND  
 RADIUS FOR TOWN HIGHWAYS)

ROCHESTER:  
 STA. 112+00.00 - STA. 128+00.00 LT & RT

646.612 TEMPORARY 4 INCH YELLOW LINE, PAINT  
 (ALL LINES WILL INCLUDE C/L BREAKS FOR  
 TOWN HIGHWAYS) S=SOLID, D=DASHED

ROCHESTER: LT C RT  
 STA. 112+00.00 - STA. 128+00.00 S - S

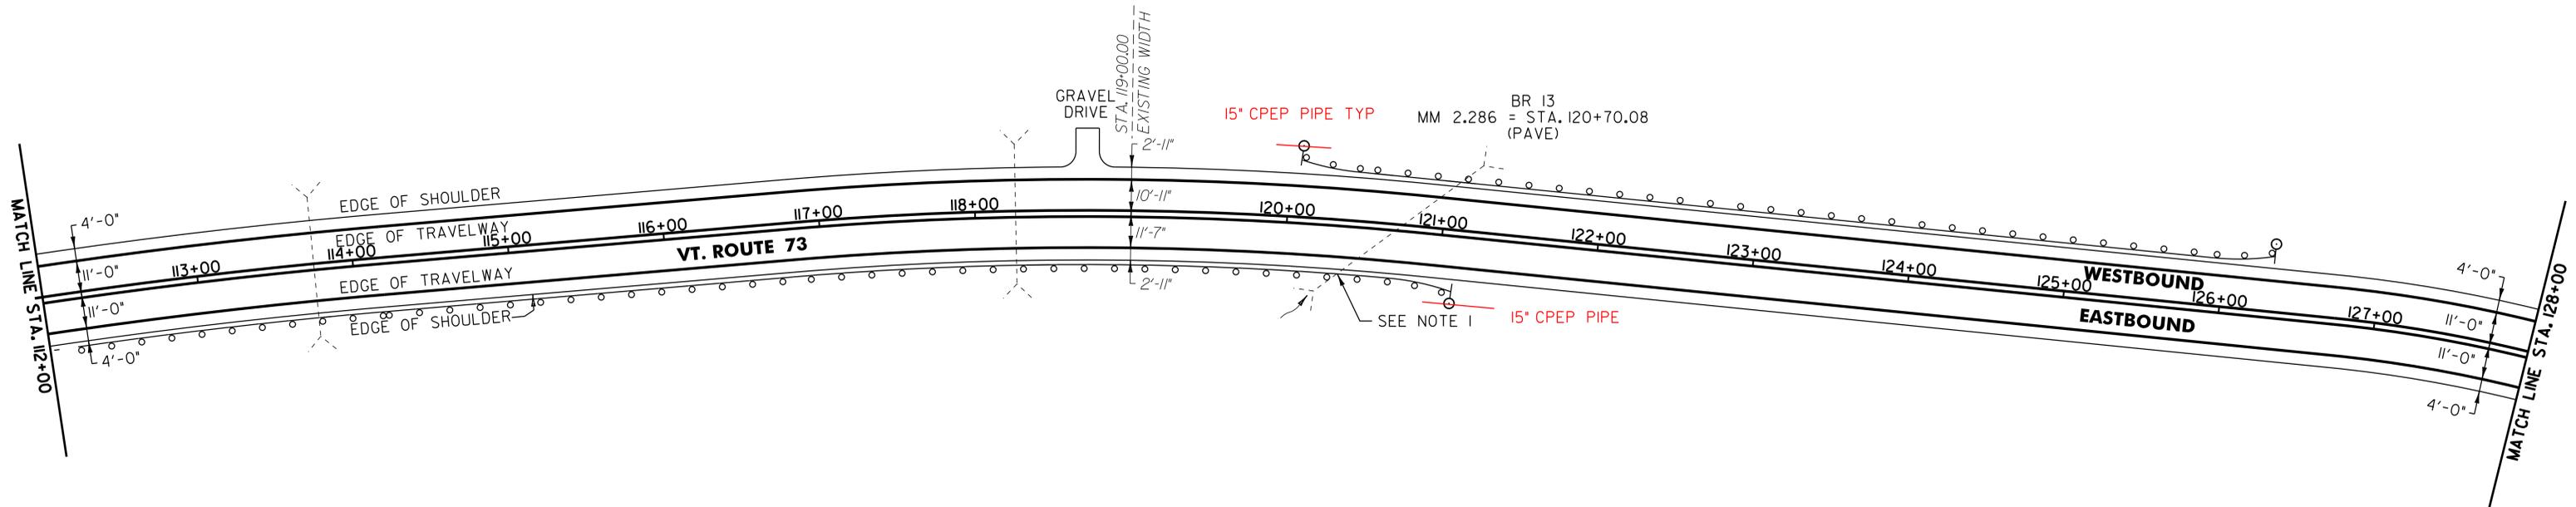

621.80 REMOVAL AND DISPOSAL OF GUARDRAIL

ROCHESTER:  
 STA. 112+00.0 - STA. 120+65.0 RT (865.0 LF)  
 STA. 120+60.0 - STA. 125+88.0 LT (528.0 LF)

676.10 DELINEATOR WITH STEEL POST

♀ TYPE 1 WHITE

ROCHESTER:  
 STA. 120+07.5 LT  
 STA. 121+09.0 RT  
 STA. 126+32.5 LT

900.620 SPECIAL PROVISION (MANUFACTURED TERMINAL SECTION, FLARED/WEATHERING)

ROCHESTER:  
 STA. 120+07.5 - STA. 120+45.0 LT  
 STA. 120+71.5 - STA. 121+09.0 RT  
 STA. 125+95.0 - STA. 126+32.5 LT

900.640 SPECIAL PROVISION (STEEL BEAM GUARDRAIL, WEATHERING)

ROCHESTER:  
 STA. 112+00.0 - STA. 120+71.5 RT (871.5 LF)

900.640 SPECIAL PROVISION (STEEL BEAM GUARDRAIL, WEATHERING W/8 FEET POSTS)

ROCHESTER:  
 STA. 120+45.0 - STA. 125+95.0 LT (550.0 LF)

NOTE:

1. SEE SHEET 55 FOR STEEL BEAM GUARDRAIL  
 AT SMALL CULVERTS DETAIL.

NOT TO SCALE

**PROJECT  
 LAYOUT  
 SHEET #8**

PROJECT NAME: ROCHESTER-CHITTENDEN-ROCHESTER

PROJECT NUMBER: SIP\_2505(1)S

FILE NAME: p05c046.dgn

PROJECT LEADER: D.E.G.

DESIGNED BY: J.S.P.

IPARM FILE: p05c046i08.i

PLOT DATE: \$DATE\$

DRAWN BY: C.A.K.

CHECKED BY: D.E.G.

SHEET 20 OF 56