


646.402 DURABLE 4 INCH WHITE LINE, THERMOPLASTIC
 (ALL LINES WILL INCLUDE EDGE LINE BREAKS AND
 RADIUS FOR TOWN HIGHWAYS)
 ROCHESTER:
 STA. 128+00.00 - STA. 144+00.00 LT & RT

646.602 TEMPORARY 4 INCH WHITE LINE, PAINT
 (ALL LINES WILL INCLUDE EDGE LINE BREAKS AND
 RADIUS FOR TOWN HIGHWAYS)
 ROCHESTER:
 STA. 128+00.00 - STA. 144+00.00 LT & RT

646.412 DURABLE 4 INCH YELLOW LINE, THERMOPLASTIC
 (ALL LINES WILL INCLUDE C/L BREAKS FOR
 TOWN HIGHWAYS) S=SOLID, D=DASHED
 ROCHESTER:
 STA. 128+00.00 - STA. 144+00.00 LT QL RT
 S - S

646.612 TEMPORARY 4 INCH YELLOW LINE, PAINT
 (ALL LINES WILL INCLUDE C/L BREAKS FOR
 TOWN HIGHWAYS) S=SOLID, D=DASHED
 ROCHESTER:
 STA. 128+00.00 - STA. 144+00.00 LT QL RT
 S - S

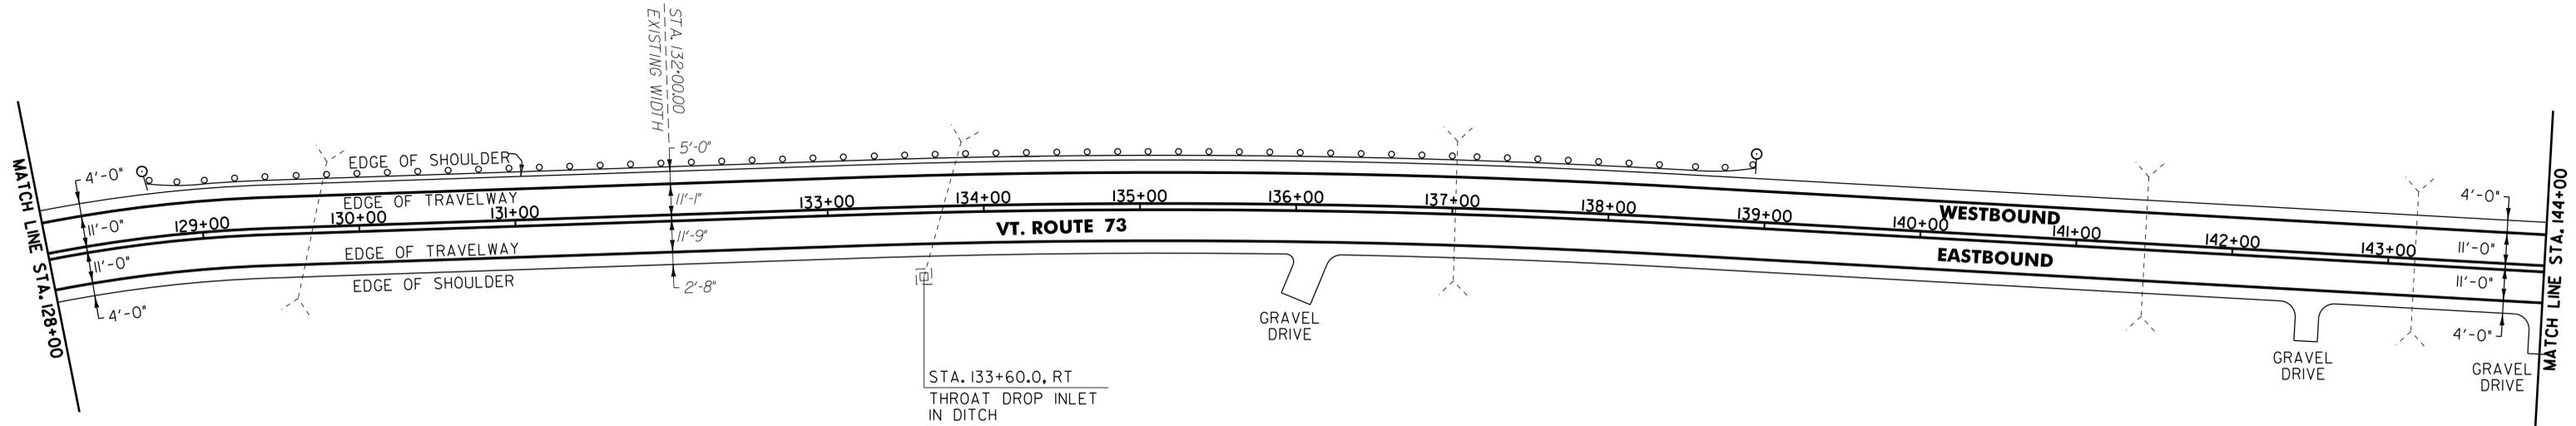

604.412 REHAB. DROP INLETS, CATCH BASINS OR MANHOLES, CLASS I
 ROCHESTER:
 STA. 133+60.0, RT

621.80 REMOVAL AND DISPOSAL OF GUARDRAIL
 ROCHESTER:
 STA. 129+07.0 - STA. 131+62.0 LT (255.0 LF)
 STA. 133+78.0 - STA. 137+19.0 LT (341.0 LF)

676.10 DELINEATOR WITH STEEL POST
 ♀ TYPE I WHITE

ROCHESTER:
 STA. 128+67.5 LT
 STA. 138+92.5 LT

900.620 SPECIAL PROVISION (MANUFACTURED TERMINAL SECTION, FLARED/WEATHERING)

ROCHESTER:
 STA. 128+67.5 - STA. 129+05.0 LT
 STA. 138+55.0 - STA. 138+92.5 LT

900.640 SPECIAL PROVISION (STEEL BEAM GUARDRAIL, WEATHERING W/8 FEET POSTS)

ROCHESTER:
 STA. 129+05.0 - STA. 138+55.0 LT (950.0 LF)

NOT TO SCALE

**PROJECT
 LAYOUT
 SHEET #9**

PROJECT NAME: ROCHESTER-CHITTENDEN-ROCHESTER
 PROJECT NUMBER: SIP_2505(1)S

FILE NAME: p05c046.dgn
 PROJECT LEADER: D.E.G.
 DESIGNED BY: J.S.P.
 IPARM FILE: p05c046i09.i
 PLOT DATE: \$DATE\$
 DRAWN BY: C.A.K.
 CHECKED BY: D.E.G.
 SHEET 21 OF 56