

646.402 DURABLE 4 INCH WHITE LINE, THERMOPLASTIC
 (ALL LINES WILL INCLUDE EDGE LINE BREAKS AND
 RADIUS FOR TOWN HIGHWAYS)

ROCHESTER:
 STA. 160+00.00 - STA. 176+00.00 LT & RT

646.412 DURABLE 4 INCH YELLOW LINE, THERMOPLASTIC
 (ALL LINES WILL INCLUDE C/L BREAKS FOR
 TOWN HIGHWAYS) S=SOLID, D=DASHED


ROCHESTER: LT QL RT
 STA. 160+00.00 - STA. 176+00.00 S - S

646.602 TEMPORARY 4 INCH WHITE LINE, PAINT
 (ALL LINES WILL INCLUDE EDGE LINE BREAKS AND
 RADIUS FOR TOWN HIGHWAYS)

ROCHESTER:
 STA. 160+00.00 - STA. 176+00.00 LT & RT

646.612 TEMPORARY 4 INCH YELLOW LINE, PAINT
 (ALL LINES WILL INCLUDE C/L BREAKS FOR
 TOWN HIGHWAYS) S=SOLID, D=DASHED

ROCHESTER: LT QL RT
 STA. 160+00.00 - STA. 176+00.00 S - S

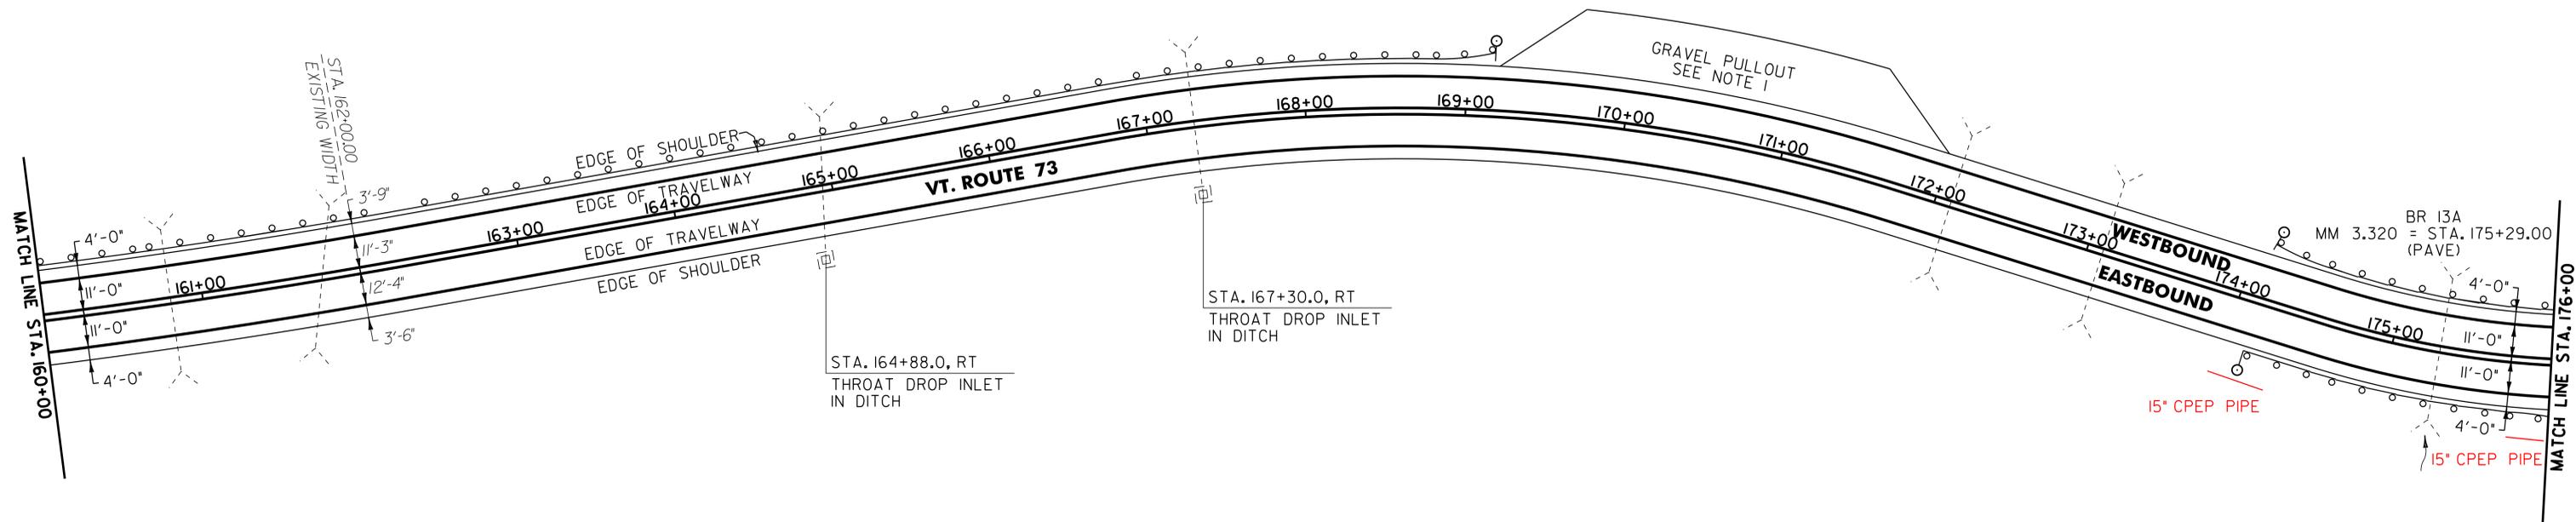

604.412 REHAB. DROP INLETS, CATCH BASINS OR MANHOLES, CLASS I

ROCHESTER:
 STA. 164+88.0 RT
 STA. 167+30.0 RT

616.35 TREATED TIMBER CURB

ROCHESTER:
 STA. 175+60.0 - STA. 176+00.0 LT (40.0 LF)

621.80 REMOVAL AND DISPOSAL OF GUARDRAIL

ROCHESTER:
 STA. 160+00.0 - STA. 169+17.0 LT (917.0 LF)
 STA. 174+95.0 - STA. 176+00.0 LT (105.0 LF)
 STA. 175+02.0 - STA. 175+63.0 RT (61.0 LF)

676.10 DELINEATOR WITH STEEL POST

TYPE I WHITE
 ROCHESTER:
 STA. 169+20.0 LT
 STA. 174+12.5 RT
 STA. 174+12.5 LT

900.620 SPECIAL PROVISION (MANUFACTURED TERMINAL SECTION, TANGENT/WEATHERING)

ROCHESTER:
 STA. 174+00.0 - STA. 174+50.0 RT

900.620 SPECIAL PROVISION (MANUFACTURED TERMINAL SECTION, FLARED/WEATHERING)

ROCHESTER:
 STA. 168+82.5 - STA. 169+20.0 LT
 STA. 174+12.5 - STA. 174+50.0 LT
 STA. 175+75.0 - STA. 176+00.0 RT

900.640 SPECIAL PROVISION (STEEL BEAM GUARDRAIL, WEATHERING)

ROCHESTER:
 STA. 160+00.0 - STA. 168+82.5 LT (882.5 LF)
 STA. 174+50.0 - STA. 175+75.0 RT (125.0 LF)

900.640 SPECIAL PROVISION (STEEL BEAM GUARDRAIL, WEATHERING W/8 FEET POSTS)

ROCHESTER:
 STA. 174+50.0 - STA. 176+00.0 LT (150.0 LF)

FLARED/

NOTE:

1. PROVIDE A 5 FT WIDE, 1 1/2" TYPE III APRON FOR THE EXISTING GRAVEL PULLOUT. ANY REQUIRED EXCAVATION AND GRADING SHALL BE PERFORMED AS DIRECTED BY THE RESIDENT ENGINEER AND PAID FOR UNDER THE APPLICABLE RENTAL ITEM(S)

NOT TO SCALE

PROJECT LAYOUT SHEET #11

PROJECT NAME: ROCHESTER-CHILIENDEN-ROCHESTER

PROJECT NUMBER: SIP_2505(1)S

FILE NAME: p05c046.dgn

PROJECT LEADER: D.E.G.

DESIGNED BY: J.S.P.

IPARM FILE: p05c04611.i

PLOT DATE: \$DATE\$

DRAWN BY: C.A.K.

CHECKED BY: D.E.G.

SHEET 23 OF 56