

646.402 DURABLE 4 INCH WHITE LINE, THERMOPLASTIC
 (ALL LINES WILL INCLUDE EDGE LINE BREAKS AND
 RADIUS FOR TOWN HIGHWAYS)

ROCHESTER:
 STA. 192+00.00 - STA. 208+00.00 LT & RT

646.412 DURABLE 4 INCH YELLOW LINE, THERMOPLASTIC
 (ALL LINES WILL INCLUDE C/L BREAKS FOR
 TOWN HIGHWAYS) S=SOLID, D=DASHED


ROCHESTER:
 STA. 192+00.00 - STA. 203+80.00 LT Q RT
 STA. 192+00.00 - STA. 203+80.00 S - S
 STA. 203+80.00 - STA. 208+00.00 S - D

646.602 TEMPORARY 4 INCH WHITE LINE, PAINT
 (ALL LINES WILL INCLUDE EDGE LINE BREAKS AND
 RADIUS FOR TOWN HIGHWAYS)

ROCHESTER:
 STA. 192+00.00 - STA. 208+00.00 LT & RT

646.612 TEMPORARY 4 INCH YELLOW LINE, PAINT
 (ALL LINES WILL INCLUDE C/L BREAKS FOR
 TOWN HIGHWAYS) S=SOLID, D=DASHED

ROCHESTER:
 STA. 192+00.00 - STA. 203+80.00 LT Q RT
 STA. 192+00.00 - STA. 203+80.00 S - S
 STA. 203+80.00 - STA. 208+00.00 S - D

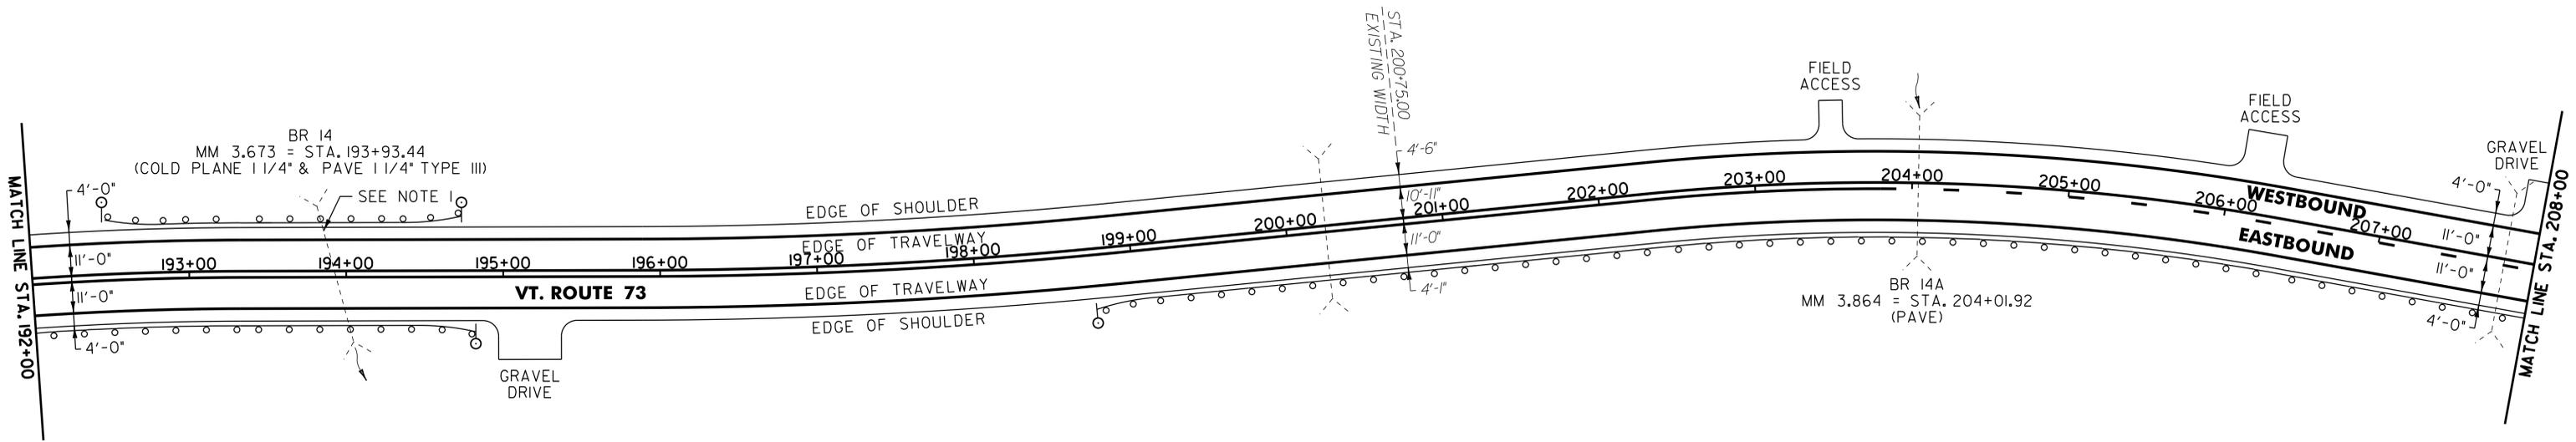

621.60 ANCHOR FOR STEEL BEAM RAIL

ROCHESTER:
 STA. 194+28.5 LT

621.80 REMOVAL AND DISPOSAL OF GUARDRAIL

ROCHESTER:
 STA. 192+93.0 - STA. 193+77.8 RT (84.8 LF)
 STA. 193+47.0 - STA. 193+61.0 LT (14.0 LF)
 STA. 194+21.5 - STA. 194+43.0 RT (21.5 LF)
 STA. 200+69.0 - STA. 208+00.0 RT (731.0 LF)

676.10 DELINEATOR WITH STEEL POST

Q TYPE 1 WHITE

ROCHESTER:
 STA. 192+48.5 LT
 STA. 194+73.5 LT
 STA. 194+83.0 RT
 STA. 198+75.0 LT

900.620 SPECIAL PROVISION (MANUFACTURED TERMINAL SECTION, FLARED/WEATHERING)

ROCHESTER:
 STA. 192+00.0 - STA. 192+09.0 RT
 STA. 192+48.5 - STA. 192+86.0 LT
~~STA. 194+36.0 - STA. 194+73.5 LT~~
 STA. 194+46.5 - STA. 194+83.0 RT
 STA. 198+75.0 - STA. 199+12.5 RT

900.640 SPECIAL PROVISION (STEEL BEAM GUARDRAIL, WEATHERING)

ROCHESTER:
 STA. 192+09.0 - STA. 193+46.5 RT (137.5 LF)
 STA. 192+86.0 - STA. 193+36.0 LT (50 LF)
 STA. 199+12.5 - STA. 208+00.0 RT (887.5 LF)

900.640 SPECIAL PROVISION (HD STEEL BEAM GUARDRAIL, WEATHERING) /CURB MOUNTED

ROCHESTER:
 STA. 193+36.0 - STA. 193+61.0 LT (25.0 LF)
 STA. 193+46.5 - STA. 193+77.8 RT (31.3 LF)
 STA. 194+04.8 - STA. 194+36.0 LT (31.2 LF)
 STA. 194+21.5 - STA. 194+46.5 RT (25.0 LF)

NOTE:

1. SEE SHEETS 48 AND 49 FOR BR 14 DETAILS.

NOT TO SCALE

PROJECT
 LAYOUT
 SHEET #13

PROJECT NAME: ROCHESTER-CHITTENDEN-ROCHESTER

PROJECT NUMBER: SIP_2505(1)S

FILE NAME: p05c046.dgn

PROJECT LEADER: D.E.G.

DESIGNED BY: J.S.P.

IPARM FILE: p05c046i13.i

PLOT DATE: \$DATE\$

DRAWN BY: C.A.K.

CHECKED BY: D.E.G.

SHEET 25 OF 56