

646.402 DURABLE 4 INCH WHITE LINE, THERMOPLASTIC  
 (ALL LINES WILL INCLUDE EDGE LINE BREAKS AND  
 RADIUS FOR TOWN HIGHWAYS)

ROCHESTER:  
 STA. 208+00.00 - STA. 224+00.00 LT & RT

646.412 DURABLE 4 INCH YELLOW LINE, THERMOPLASTIC  
 (ALL LINES WILL INCLUDE C/L BREAKS FOR  
 TOWN HIGHWAYS) S=SOLID, D=DASHED


ROCHESTER:	LT	CL	RT
STA. 208+00.00 - STA. 211+20.00	S	-	D
STA. 211+20.00 - STA. 213+85.00	-	D	-
STA. 213+85.00 - STA. 221+25.00	D	-	S
STA. 221+25.00 - STA. 224+00.00	S	-	S

646.602 TEMPORARY 4 INCH WHITE LINE, PAINT  
 (ALL LINES WILL INCLUDE EDGE LINE BREAKS AND  
 RADIUS FOR TOWN HIGHWAYS)

ROCHESTER:  
 STA. 208+00.00 - STA. 224+00.00 LT & RT

646.612 TEMPORARY 4 INCH YELLOW LINE, PAINT  
 (ALL LINES WILL INCLUDE C/L BREAKS FOR  
 TOWN HIGHWAYS) S=SOLID, D=DASHED

ROCHESTER:	LT	CL	RT
STA. 208+00.00 - STA. 211+20.00	S	-	D
STA. 211+20.00 - STA. 213+85.00	-	D	-
STA. 213+85.00 - STA. 221+25.00	D	-	S
STA. 221+25.00 - STA. 224+00.00	S	-	S

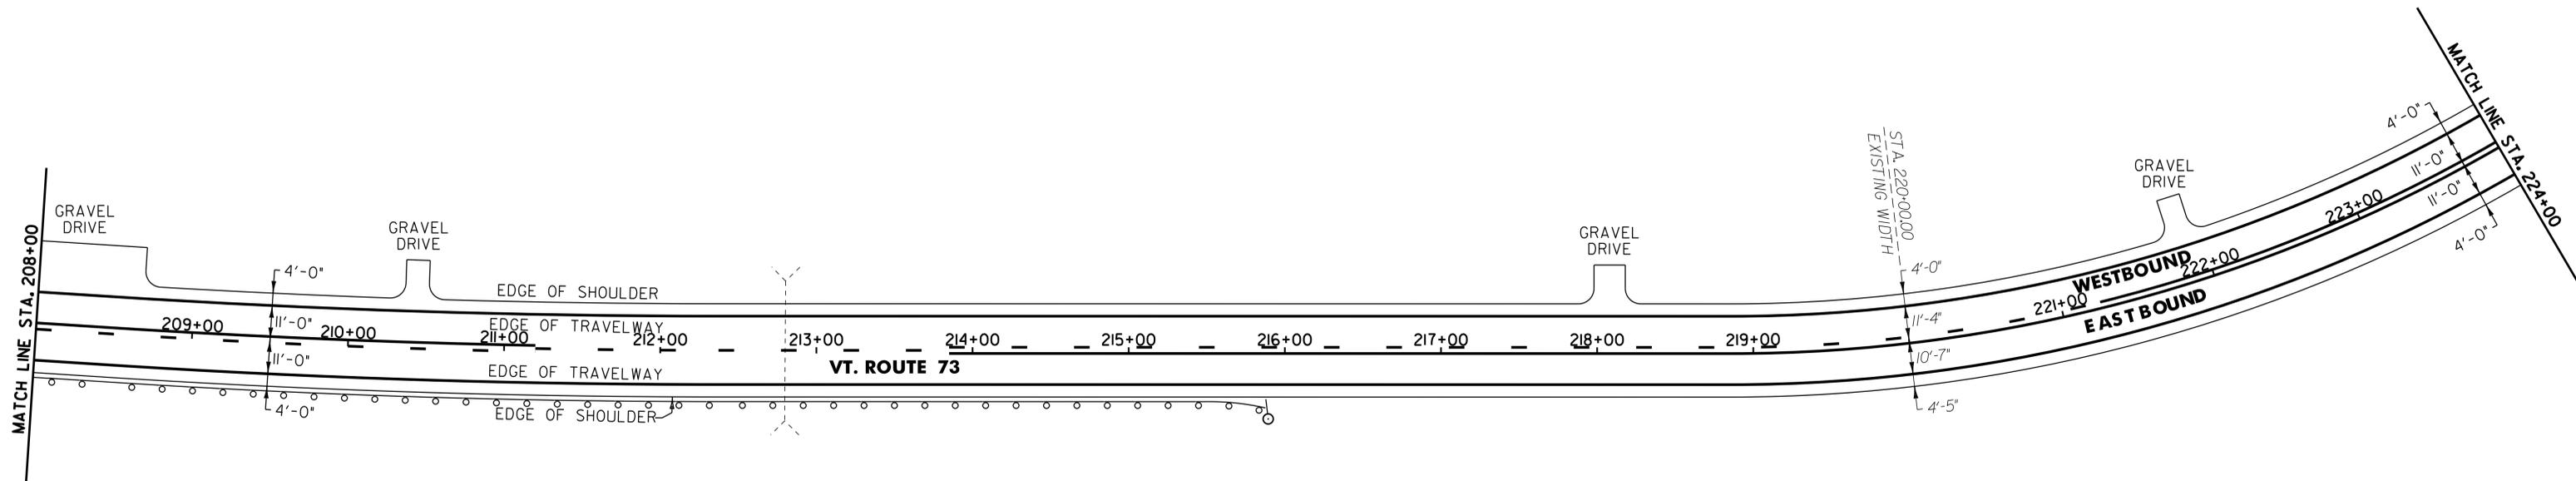

621.80 REMOVAL AND DISPOSAL OF GUARDRAIL

ROCHESTER:  
 STA. 208+00.0 - STA. 214+91.0 RT (691.0 LF)

676.10 DELINEATOR WITH STEEL POST

↑ TYPE 1 WHITE

ROCHESTER:  
 STA. 215+87.5 RT

900.620 SPECIAL PROVISION (MANUFACTURED TERMINAL SECTION, FLARED/WEATHERING)

ROCHESTER:  
 STA. 215+50.0 - STA. 215+87.5 RT

900.640 SPECIAL PROVISION (STEEL BEAM GUARDRAIL, WEATHERING)

ROCHESTER:  
 STA. 208+00.0 - STA. 215+50.0 RT (750.0 LF)

NOT TO SCALE

**PROJECT  
 LAYOUT  
 SHEET #14**

PROJECT NAME: ROCHESTER-CHILINDEN-ROCHESTER  
 PROJECT NUMBER: SIP\_2505(1)S

FILE NAME: p05c046.dgn	PLOT DATE: \$DATE\$
PROJECT LEADER: D.E.G.	DRAWN BY: C.A.K.
DESIGNED BY: J.S.P.	CHECKED BY: D.E.G.
IPARM FILE: p05c046114.i	SHEET 26 OF 56