

646.402 DURABLE 4 INCH WHITE LINE, THERMOPLASTIC  
 (ALL LINES WILL INCLUDE EDGE LINE BREAKS AND  
 RADIUS FOR TOWN HIGHWAYS)

ROCHESTER:  
 STA. 296+00.00 - STA. 312+00.00 LT & RT

646.412 DURABLE 4 INCH YELLOW LINE, THERMOPLASTIC  
 (ALL LINES WILL INCLUDE C/L BREAKS FOR  
 TOWN HIGHWAYS) S=SOLID, D=DASHED


ROCHESTER: LT QL RT  
 STA. 296+00.00 - STA. 299+10.00 D - S  
 STA. 299+10.00 - STA. 312+00.00 S - S

646.602 TEMPORARY 4 INCH WHITE LINE, PAINT  
 (ALL LINES WILL INCLUDE EDGE LINE BREAKS AND  
 RADIUS FOR TOWN HIGHWAYS)

ROCHESTER:  
 STA. 296+00.00 - STA. 312+00.00 LT & RT

646.612 TEMPORARY 4 INCH YELLOW LINE, PAINT  
 (ALL LINES WILL INCLUDE C/L BREAKS FOR  
 TOWN HIGHWAYS) S=SOLID, D=DASHED

ROCHESTER: LT QL RT  
 STA. 296+00.00 - STA. 299+10.00 D - S  
 STA. 299+10.00 - STA. 312+00.00 S - S

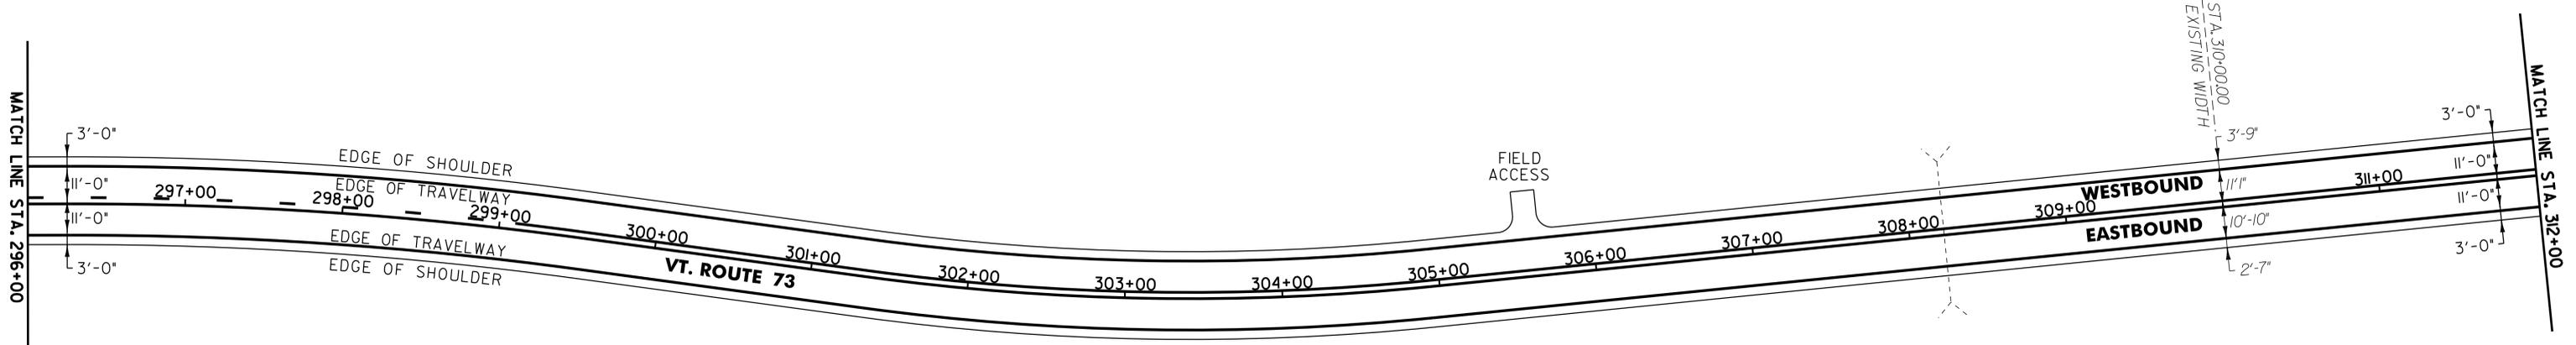

NOT TO SCALE

**PROJECT  
 LAYOUT  
 SHEET #20**

PROJECT NAME: ROCHESTER-CHILINDEN-ROCHESTER  
 PROJECT NUMBER: SIP\_2505(1)S

FILE NAME: p05c046.dgn  
 PROJECT LEADER: D.E.G.  
 DESIGNED BY: J.S.P.  
 IPARM FILE: p05c046120.i

PLOT DATE: \$DATE\$  
 DRAWN BY: C.A.K.  
 CHECKED BY: D.E.G.  
 SHEET 32 OF 56