

646.402 DURABLE 4 INCH WHITE LINE, THERMOPLASTIC
(ALL LINES WILL INCLUDE EDGE LINE BREAKS AND RADIUS FOR TOWN HIGHWAYS)

ROCHESTER:
STA. 424+00.00 - STA. 440+00.00 LT & RT

646.412 DURABLE 4 INCH YELLOW LINE, THERMOPLASTIC
(ALL LINES WILL INCLUDE C/L BREAKS FOR TOWN HIGHWAYS) S=SOLID, D=DASHED

ROCHESTER:
STA. 424+00.00 - STA. 440+00.00 S - S

646.602 TEMPORARY 4 INCH WHITE LINE, PAINT
(ALL LINES WILL INCLUDE EDGE LINE BREAKS AND RADIUS FOR TOWN HIGHWAYS)


ROCHESTER:
STA. 424+00.00 - STA. 440+00.00 LT & RT

646.612 TEMPORARY 4 INCH YELLOW LINE, PAINT
(ALL LINES WILL INCLUDE C/L BREAKS FOR TOWN HIGHWAYS) S=SOLID, D=DASHED


ROCHESTER:
STA. 424+00.00 - STA. 440+00.00 S - S

675.50 REMOVING SIGNS
AS SHOWN - I

675.60 ERECTING SALVAGED SIGNS
AS SHOWN - I

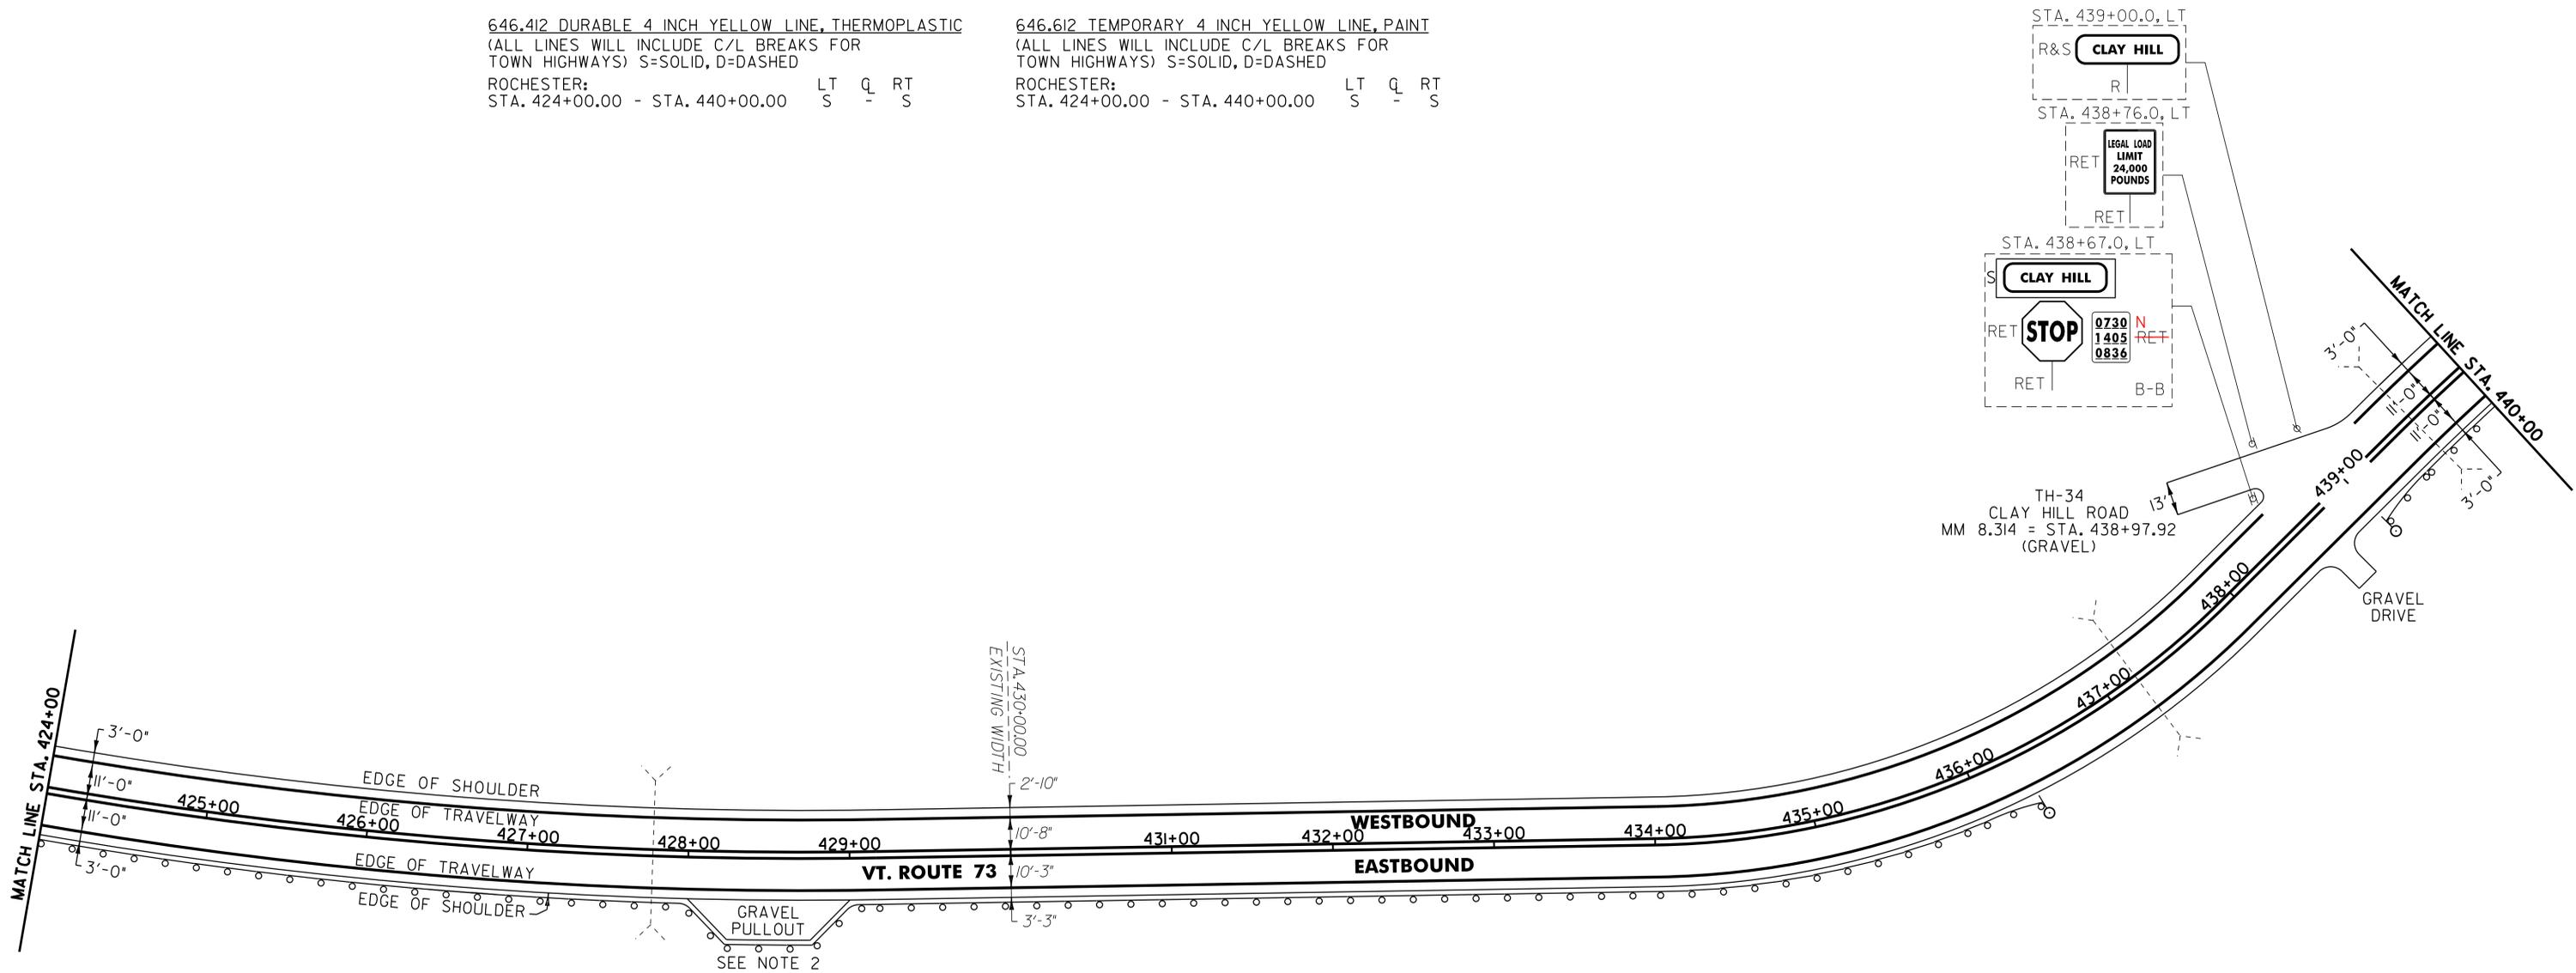

TH-34
CLAY HILL ROAD
MM 8.314 = STA. 438+97.92
(GRAVEL)

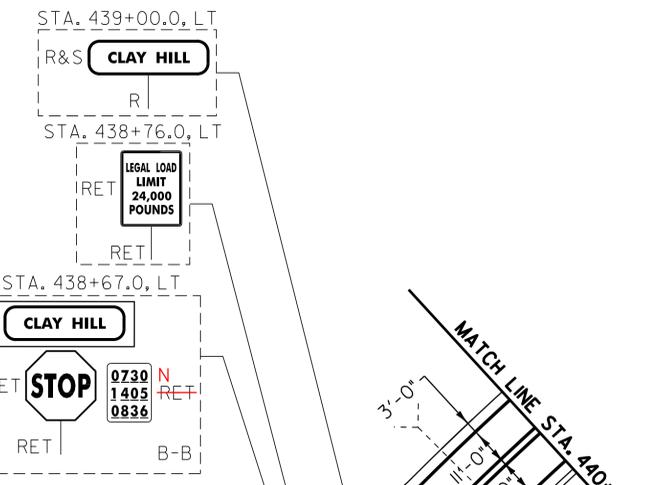

621.20 STEEL BEAM GUARDRAIL, GALVANIZED

ROCHESTER:
STA. 424+00.0 - STA. 435+96.0 RT (1196.0 LF)
STA. 439+37.5 - STA. 440+00.0 RT (62.5 LF)

621.50 MANUFACTURED TERMINAL SECTION, FLARED

ROCHESTER:
STA. 435+96.0 - STA. 436+33.5 RT
STA. 439+00.0 - STA. 439+37.5 RT

621.80 REMOVAL AND DISPOSAL OF GUARDRAIL

ROCHESTER:
STA. 424+00.0 - STA. 436+20.0 RT (1220.0 LF)
STA. 439+37.0 - STA. 440+00.0 RT (63.0 LF)

676.10 DELINEATOR WITH STEEL POST

○ TYPE I WHITE
ROCHESTER:
STA. 436+33.5 RT
STA. 439+00.0 RT

SIGN LEGEND

R = REMOVE
S = SALVAGE
N = NEW
RET = RETAIN
B-B = BACK TO BACK
EXISTING = - - - - -
NEW = _____

NOTES:

- PAVING LIMIT ON ALL TOWN HIGHWAYS SHALL BE MEASURED 25 FT BACK FROM VT. ROUTE 73 EDGE OF SHOULDER UNLESS DENOTED OTHERWISE ON THE PLANS OR AS DIRECTED BY THE RESIDENT ENGINEER.
- PROVIDE A 5 FT WIDE, 1 1/2" TYPE III APRON FOR THE EXISTING GRAVEL PULLOUT, ANY REQUIRED EXCAVATION AND GRADING SHALL BE PERFORMED AS DIRECTED BY THE RESIDENT ENGINEER AND PAID FOR UNDER THE APPLICABLE RENTAL ITEM(S).

NOT TO SCALE

PROJECT LAYOUT SHEET #28

PROJECT NAME: ROCHESTER-CHILINDEN-ROCHESTER

PROJECT NUMBER: SIP_2505(1)S

FILE NAME: p05c046.dgn

PROJECT LEADER: D.E.G.

DESIGNED BY: J.S.P.

IPARM FILE: p05c046128.i

PLOT DATE: \$DATE\$

DRAWN BY: C.A.K.

CHECKED BY: D.E.G.

SHEET 40 OF 56