



- NOTES:
- EXISTING CONCRETE BRIDGE POSTS TO BE REMOVED. SEE SHEET 54 FOR DETAILS.
  - INSTALL SEVEN NEW FASCIA MOUNTED STEEL BRIDGE POSTS ON EACH SIDE OF BRIDGE. SEE POST DETAILS THIS SHEET. SEE CURB REPAIR DETAILS ON SHEET 54.
  - INSTALL FIVE NEW SURFACE MOUNTED POSTS ON EXISTING CONCRETE PAD. SEE POST DETAILS THIS SHEET. PAYMENT SHALL BE MADE UNDER ITEM 900.640 HD STEEL BEAM GUARDRAIL, WEATHERING/CURB MOUNTED.
  - NON-SHRINKING GROUT SHALL CONFORM TO SUBSECTION 707.03 MORTAR TYPE IV OF THE STANDARD SPECIFICATIONS. PACK UNDER BASE PLATE. PAYMENT WILL BE INCIDENTAL TO ITEM 900.640 HD STEEL BEAM GUARDRAIL, WEATHERING /CURB MOUNTED.
  - NEW ASTM A-449 7/8" DIAMETER ANCHOR BOLTS FOR FASCIA MOUNTED POSTS SHALL BE FURNISHED EACH WITH TWO NUTS, ONE PLATE WASHER AND ONE STANDARD WASHER.
  - NEW ASTM A-449 7/8" DIAMETER ANCHOR BOLTS FOR SURFACE MOUNTED POSTS SHALL BE FURNISHED EACH WITH ONE NUT AND ONE WASHER.
  - REMOVAL OF EXISTING CONCRETE BARRIER SHALL BE CONSIDERED INCIDENTAL TO ITEM 621.80 REMOVAL AND DISPOSAL OF GUARDRAIL.
  - SEE STANDARD SHEET SB-R6-82 FOR ADDITIONAL DETAILS.

**BR 15 ROCHESTER MM 4.927 = STA. 260+14.56**

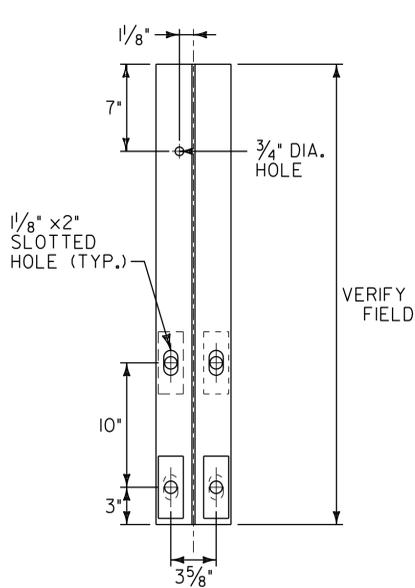


**SECTION A-A**

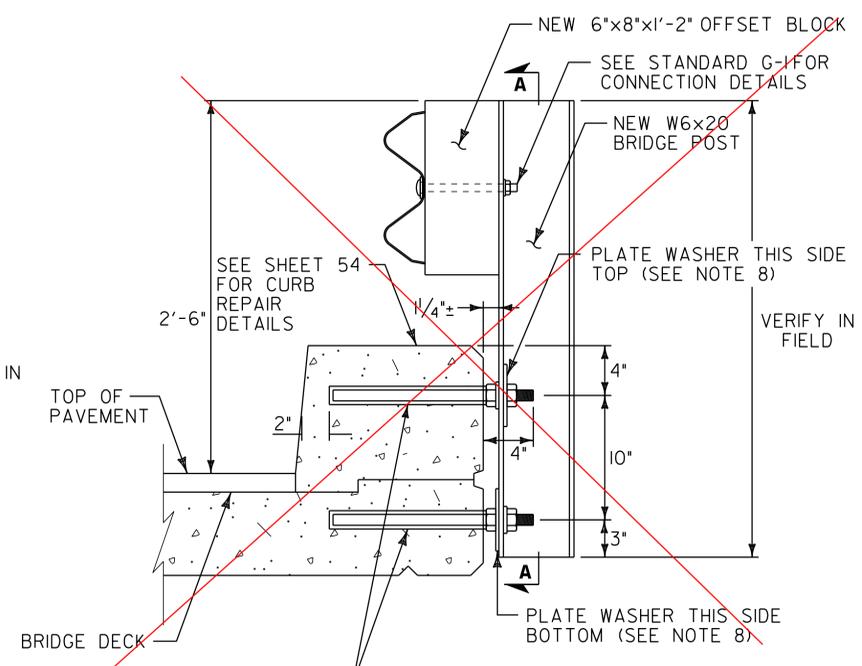


**DETAIL A  
BR 15 BRIDGE POST**


DRILL & GROUT 7/8" DIA. ANCHOR BOLTS (4 REQUIRED) SEE CHANGE ORDER #2

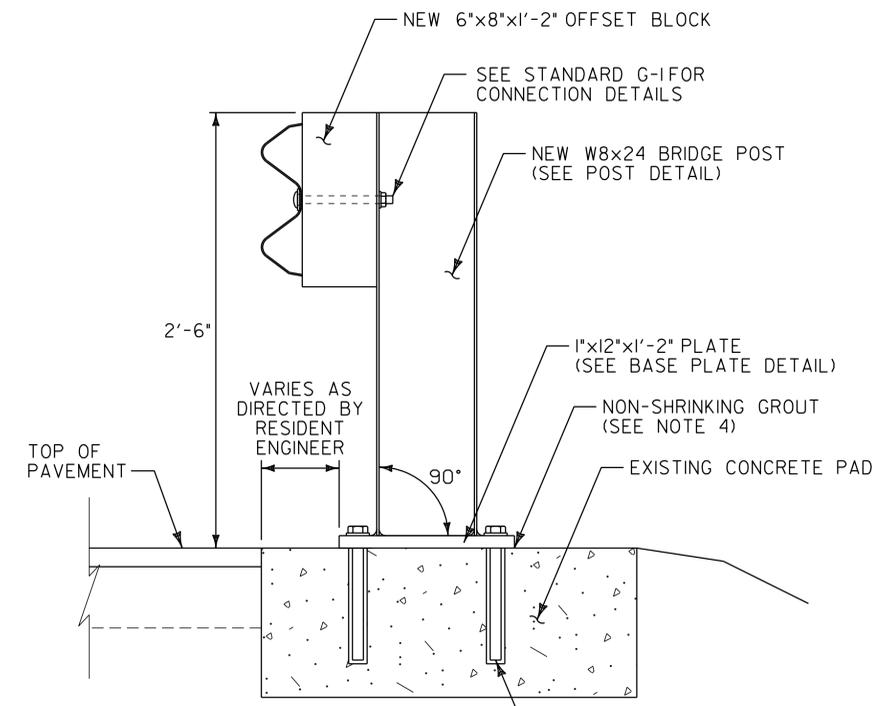

**DETAIL B  
SURFACE MOUNTED POST**

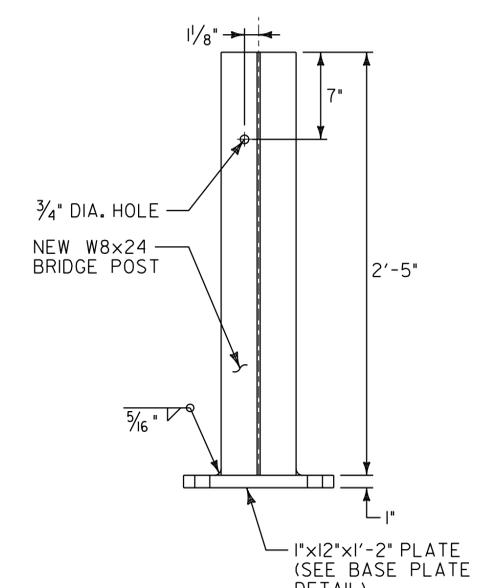

**POST DETAIL**

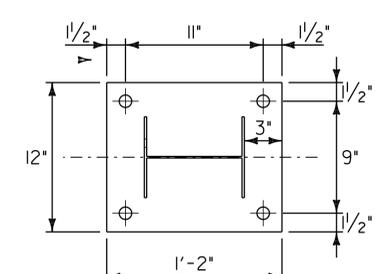

**BASE PLATE DETAIL**

<b>BRIDGE DETAIL SHEET #3</b>	NOT TO SCALE	
	PROJECT NAME: ROCHESTER-CHILINDEN-ROCHESTER	
	PROJECT NUMBER: SIP_2505(IIS)	
	FILE NAME: p05c046.dgn	PLOT DATE: \$DATE\$
PROJECT LEADER: D.E.G.	DRAWN BY: C.A.K.	
DESIGNED BY: J.S.P.	CHECKED BY: D.E.G.	
IPARM FILE: p05c046bd03.i	SHEET 50 OF 56	