


BR 16 ROCHESTER MM 6.368 = STA. 336+23.04

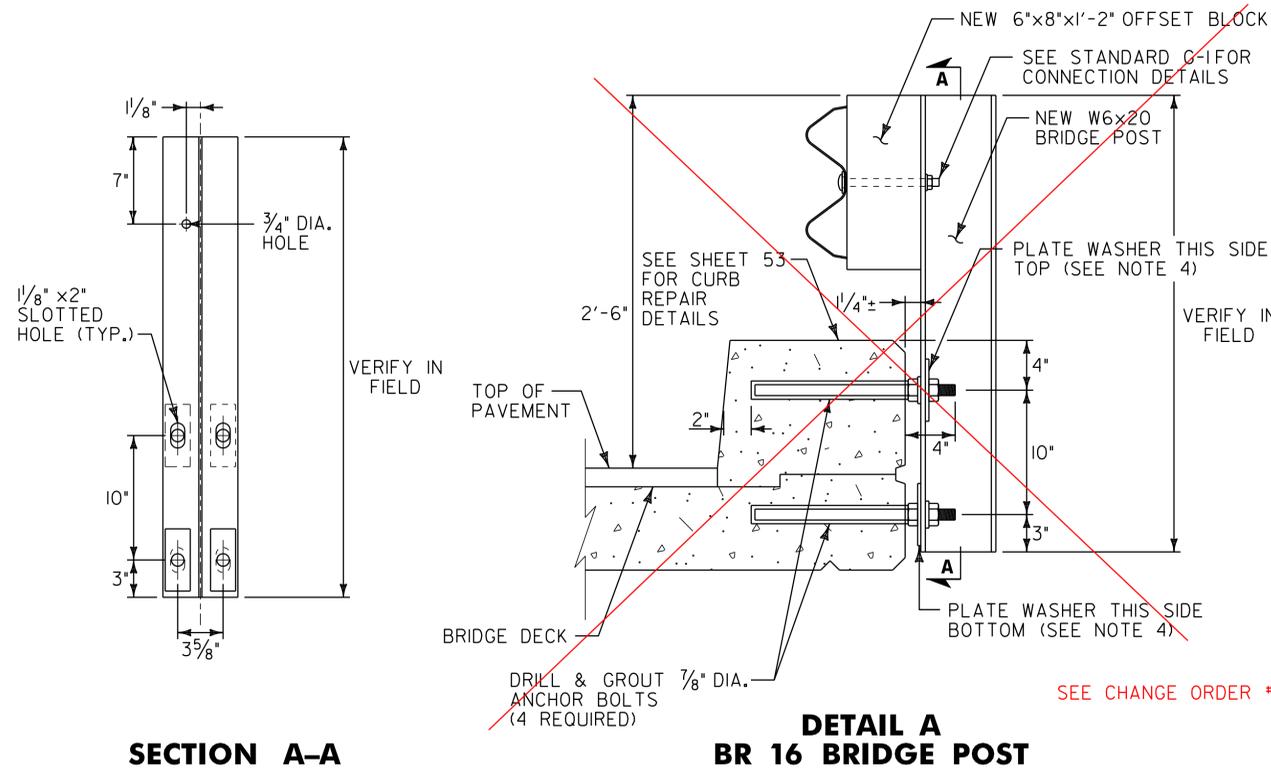

NOTES:

1. EXISTING CONCRETE BRIDGE POSTS TO BE REMOVED. SEE SHEET 54 FOR DETAILS.
2. INSTALL FOUR NEW FASCIA MOUNTED STEEL BRIDGE POSTS ON EACH SIDE OF BRIDGE. SEE POST DETAILS THIS SHEET. SEE CURB REPAIR DETAILS ON SHEET 54.
3. SEE STANDARD SHEET SB-R6-82 FOR ADDITIONAL DETAILS.
4. NEW ASTM A-449 7/8" DIAMETER ANCHOR BOLTS SHALL BE FURNISHED EACH WITH TWO NUTS, ONE PLATE WASHER, AND ONE STANDARD WASHER.

NOT TO SCALE

**BRIDGE
DETAIL
SHEET #4**

PROJECT NAME: ROCHESTER-CHILIENDEN-ROCHESTER	
PROJECT NUMBER: SIP_2505(1)S	
FILE NAME: p05c046.dgn	PLOT DATE: \$DATE\$
PROJECT LEADER: D.E.G.	DRAWN BY: C.A.K.
DESIGNED BY: J.S.P.	CHECKED BY: D.E.G.
IPARM FILE: p05c046bd04.i	SHEET 51 OF 56

SEE CHANGE ORDER #2