


VT ROUTE 100 TYPICAL ROADWAY SECTION

SCALE 1/2" = 1'-0"

MATERIAL ITEM	TOLERANCE
PAVEMENT	± 1/4" TOTAL THICKNESS
BASE COURSE	± 1/2"
SUBBASE	± 1"
SAND BORROW	± 1"
GRANULAR BORROW	± 1"

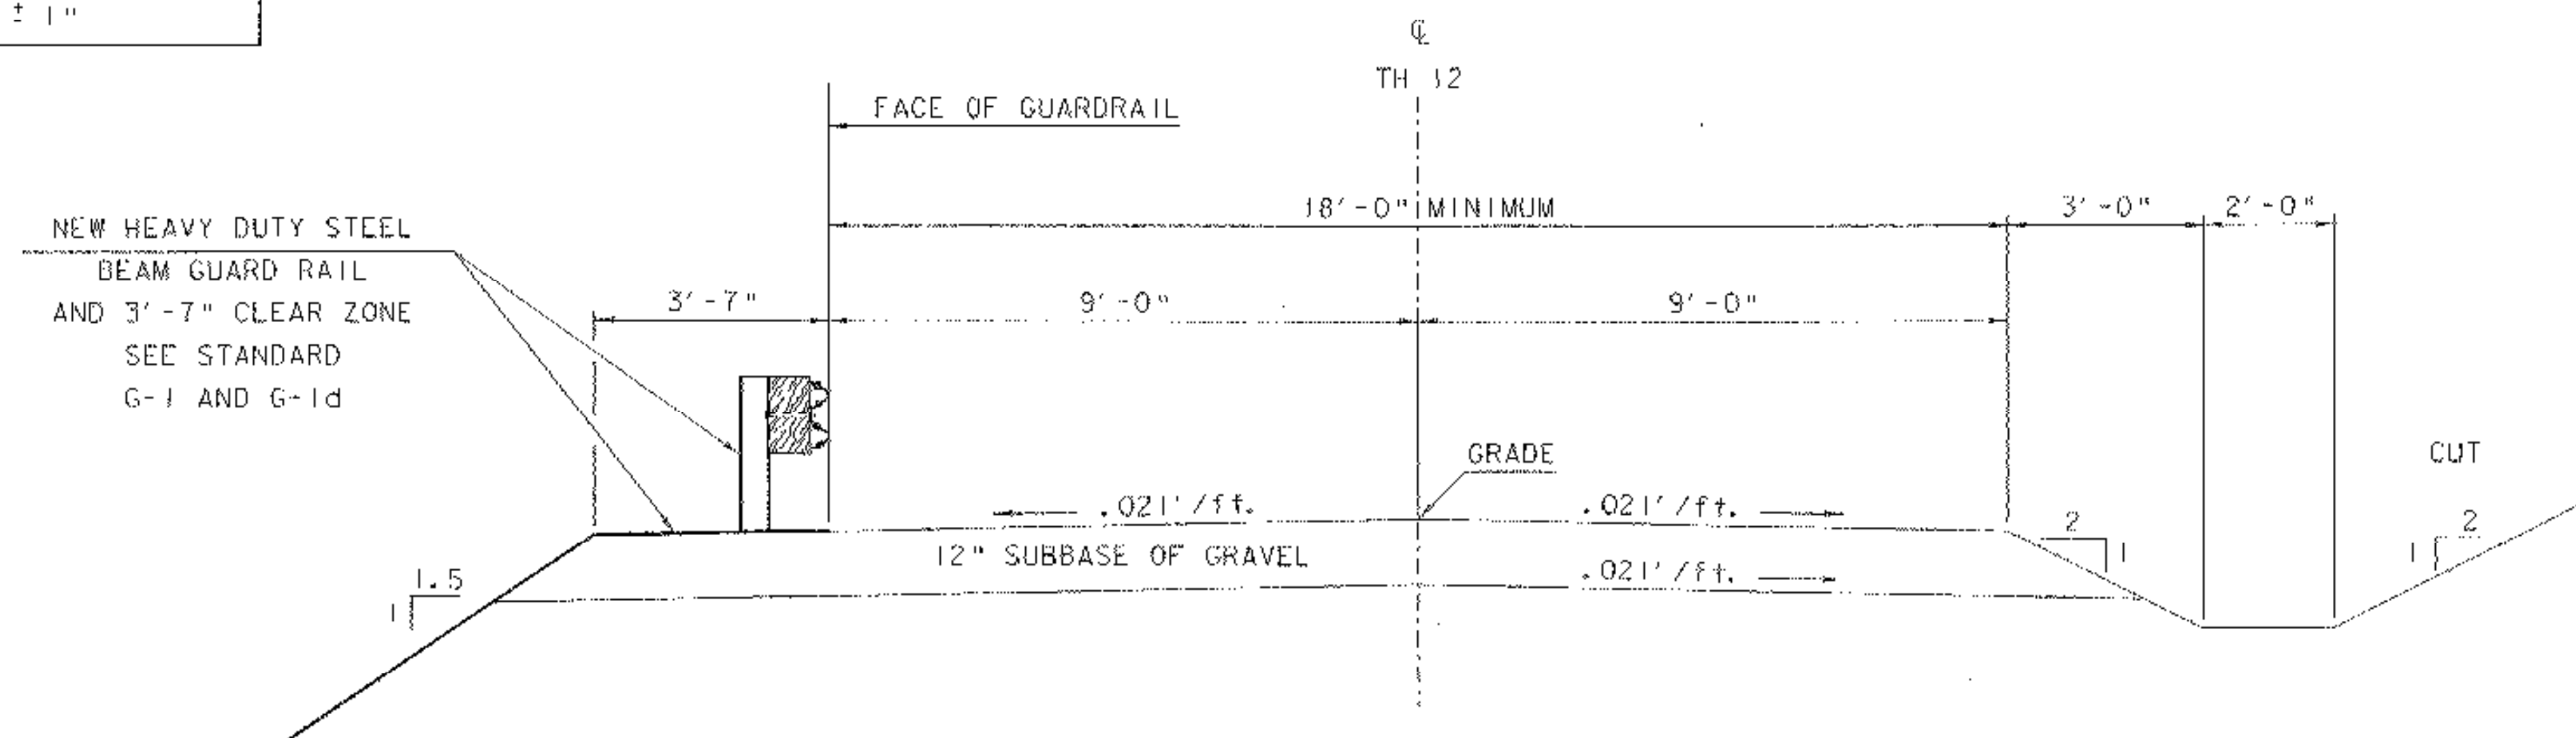

TH 12 TYPICAL ROADWAY SECTION

SCALE 1/2" = 1'-0"

SCALE 1/2" = 1'-0"

PROJECT NAME: WHITINGHAM	PLOT DATE: 08-MAR-2006
PROJECT NUMBER: ST CULV (6)	DRAWN BY: M.FESSEL
FILE NAME: 05cd28/Str/s05cd281yp.dgn	CHECKED BY: M.GAGULIC
PROJECT LEADER: C.P.WILLIAMS	TYPICAL SECTION
DESIGNED BY: E.L.RUSTAY	SHEET 5 OF 34