


PLAN

SCALE 1" = 20'-0"

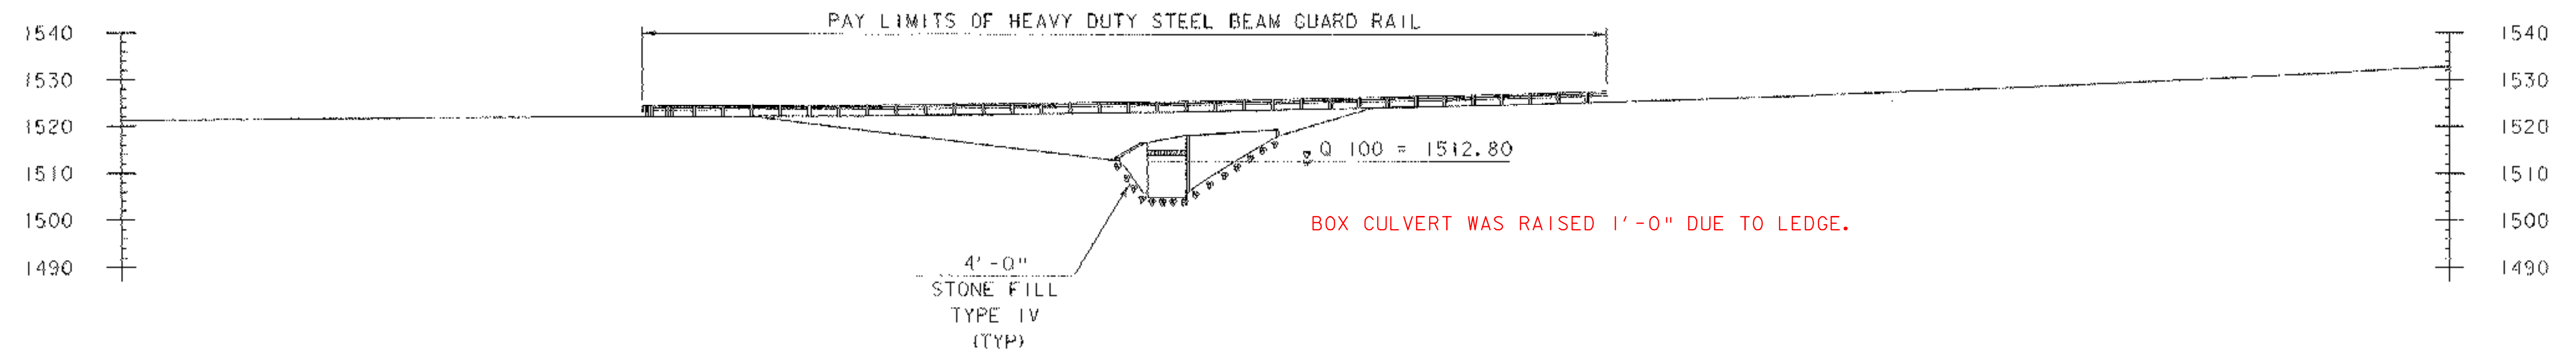

ELEVATION @ UPSTREAM FASCIA

SCALE 1" = 20'-0"

SCALE 1" = 20'-0"

PROJECT: WHITINGHAM	PROJECT NO. # ST CULV (6)
DESIGN FILE NAME: 05c128/Structures/s05c128pe.dgn	PLOT DATE: 08-MAR-2006
IPARM FILE NAME: s05c128pe.i	DRAWN BY: M. FESSEL
DESIGNED BY: E.L. RUSTAY	CHECKED BY: M. GAGULIC
SQUAD LEADER: C.P. WILLIAMS	SHEET: 13 OF 34
PLAN AND ELEVATION	